FED. ROAD DIST. NO.	STATE	FED. AID PROJ. NO.	FISCAL YEAR	SHEET NO.	TOTAL SHEETS
HAWAI'I	HAW.	ARR-050-1(036)	FY13/14	Model	50

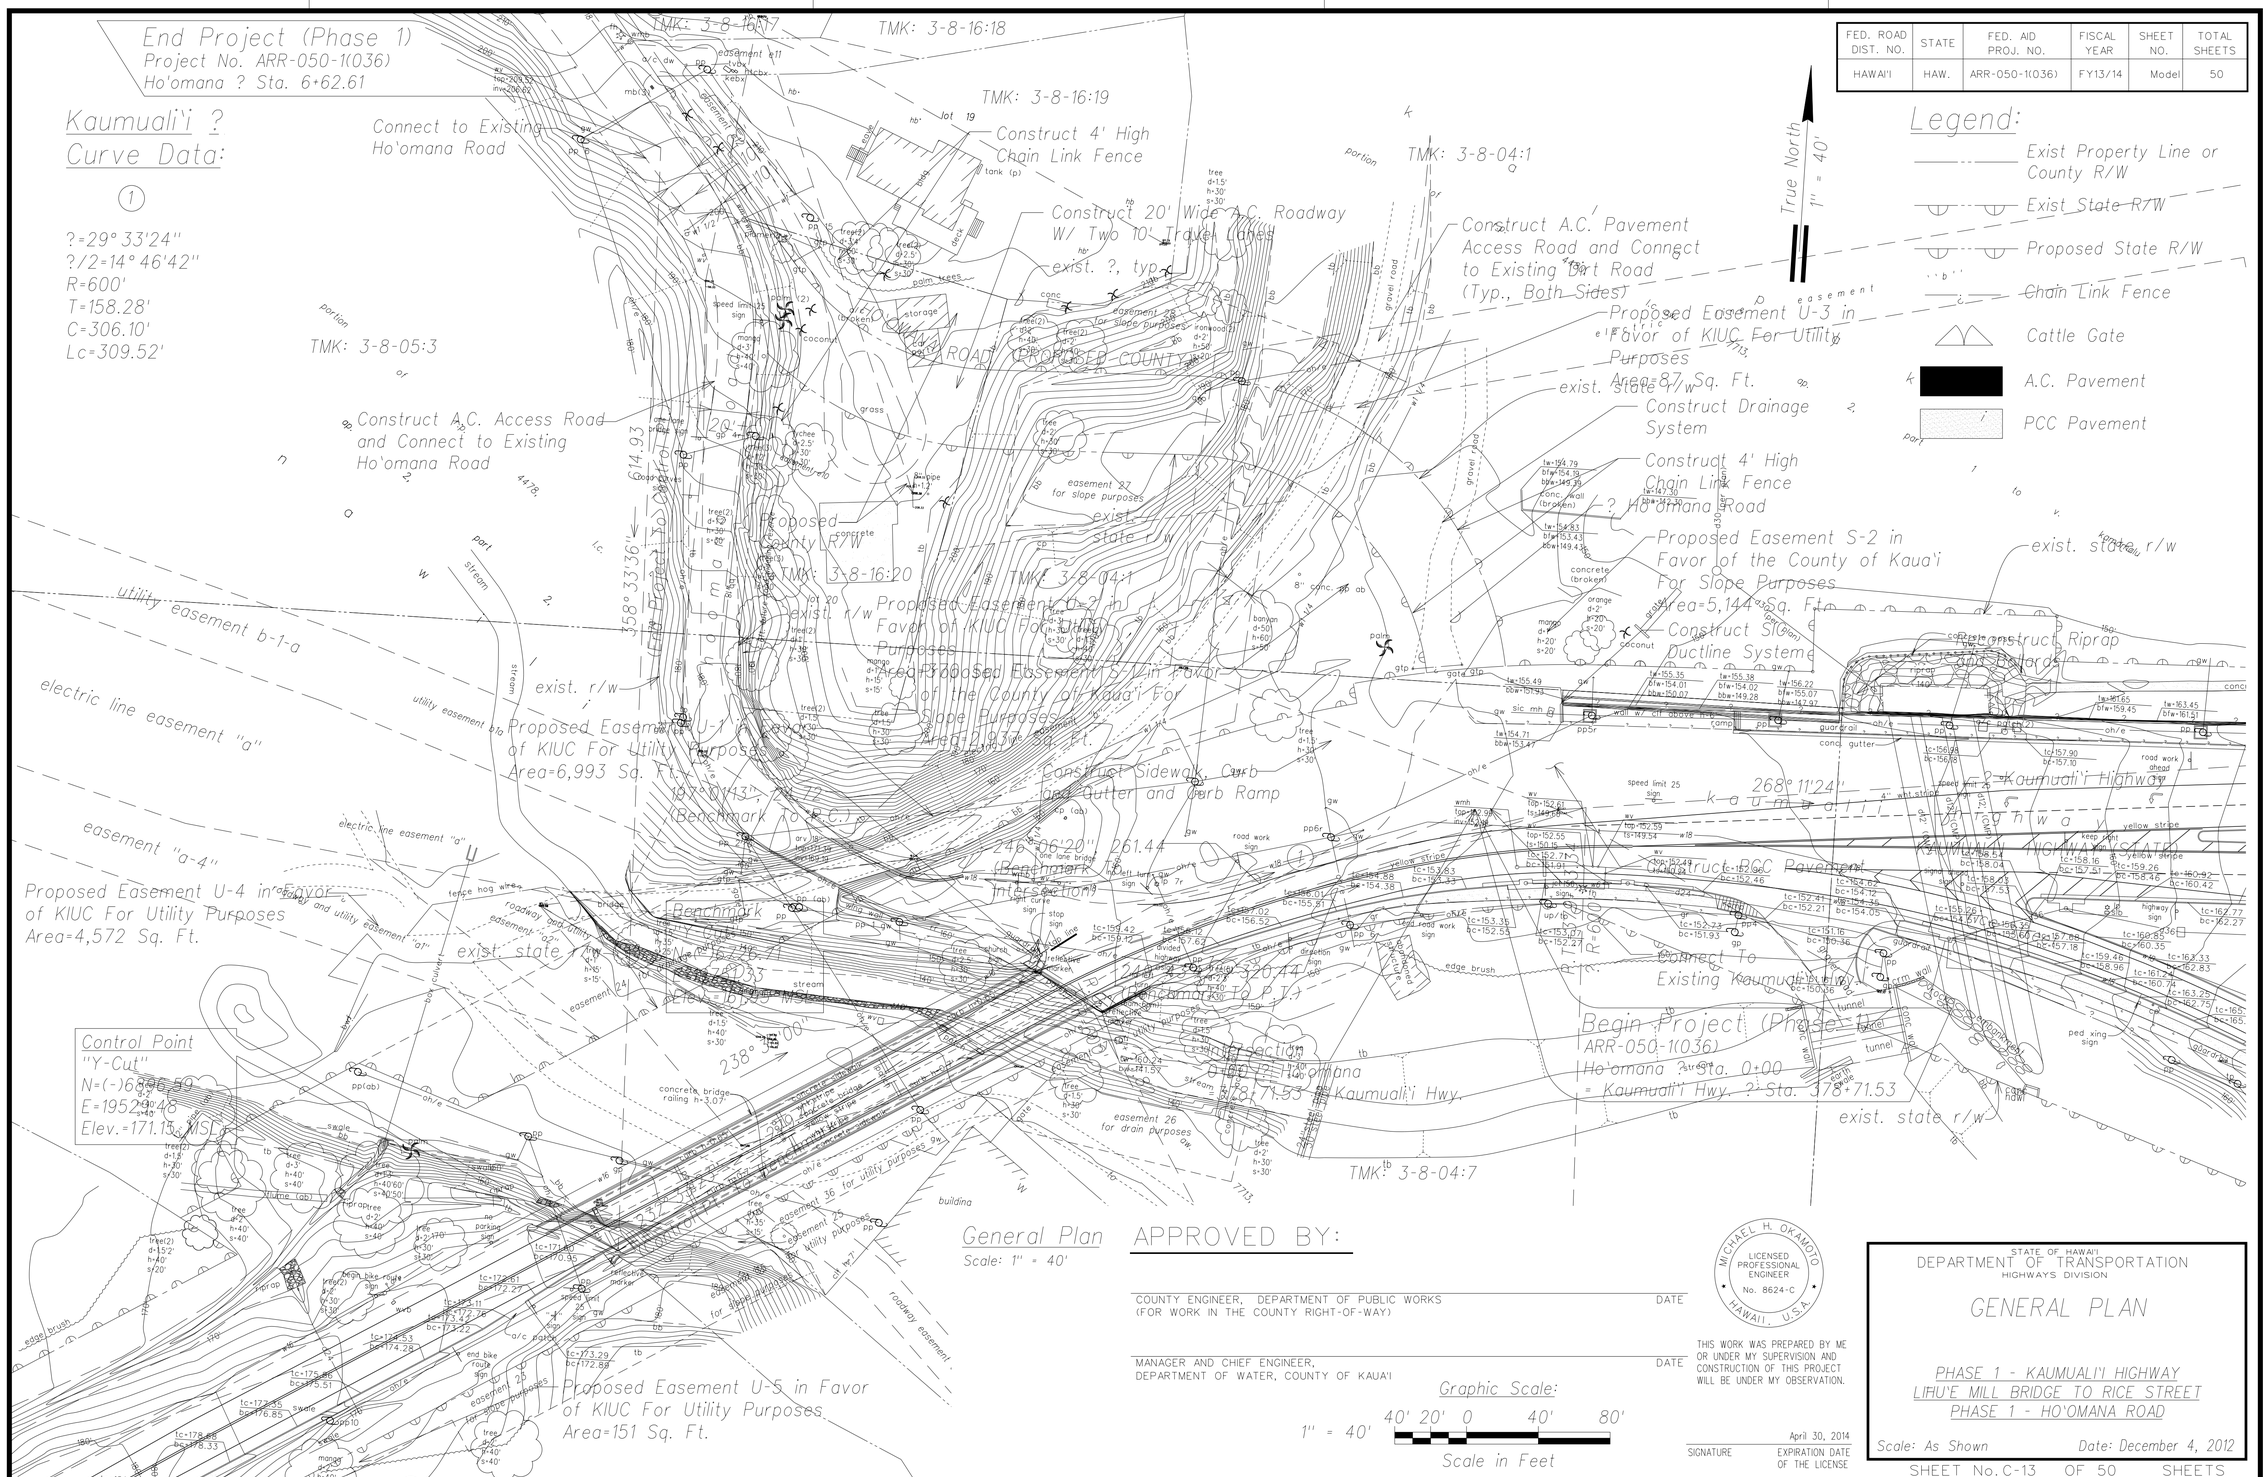

General Plan
Scale: 1" = 40'

APPROVED BY:

COUNTY ENGINEER, DEPARTMENT OF PUBLIC WORKS (FOR WORK IN THE COUNTY RIGHT-OF-WAY) — DATE

MANAGER AND CHIEF ENGINEER, DEPARTMENT OF WATER, COUNTY OF KAUA'I — DATE

Graphic Scale:
1" = 40' 40' 20' 0 40' 80'
Scale in Feet

MICHAEL H. OKAMOTO
LICENSED PROFESSIONAL ENGINEER
No. 8624-C
HAWAII, U.S.A.

THIS WORK WAS PREPARED BY ME OR UNDER MY SUPERVISION AND CONSTRUCTION OF THIS PROJECT WILL BE UNDER MY OBSERVATION.

SIGNATURE — April 30, 2014 EXPIRATION DATE OF THE LICENSE

STATE OF HAWAII
DEPARTMENT OF TRANSPORTATION
HIGHWAYS DIVISION

GENERAL PLAN

PHASE 1 - KAUMUALI'I HIGHWAY
LIHU'E MILL BRIDGE TO RICE STREET
PHASE 1 - HO'OMANA ROAD

Scale: As Shown — Date: December 4, 2012

SHEET No. C-13 OF 50 SHEETS

ORIGINAL PLAN	SURVEY PLOTTED BY	DATE
NOTE BOOK	DRAWN BY	
	TRACED BY	
	DESIGNED BY	
No.	QUANTITIES BY	
	CHECKED BY	

"AS-BUILT"

Model