FED. ROAD DIST. NO.	STATE	FED. AID PROJ. NO.	FISCAL YEAR	SHEET NO.	TOTAL SHEETS
HAWAII	HAW.	ARR-050-1(036)	FY13/14	Model	50

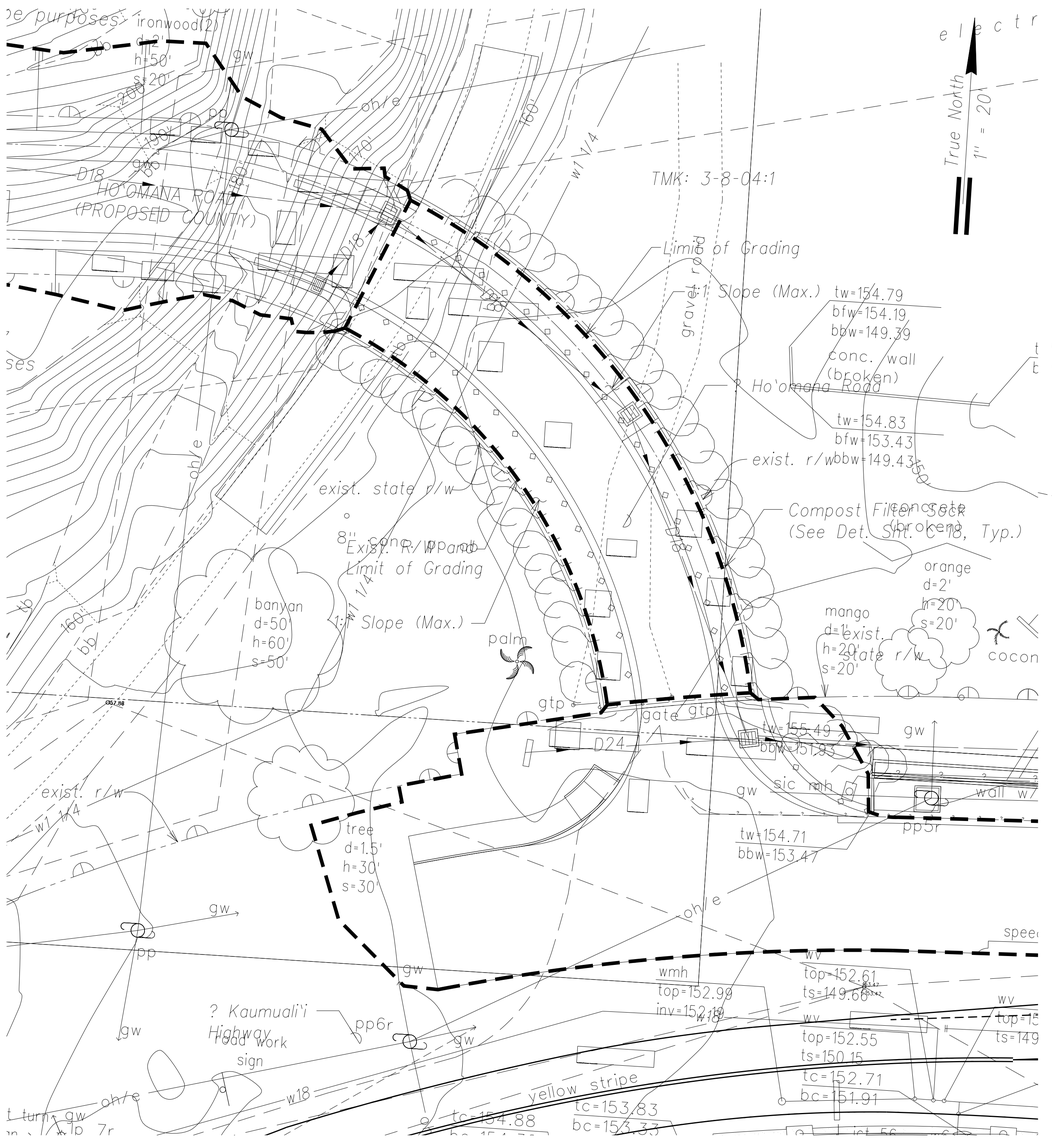

Grading Plan (Interim Condition)

Scale: 1" = 20'

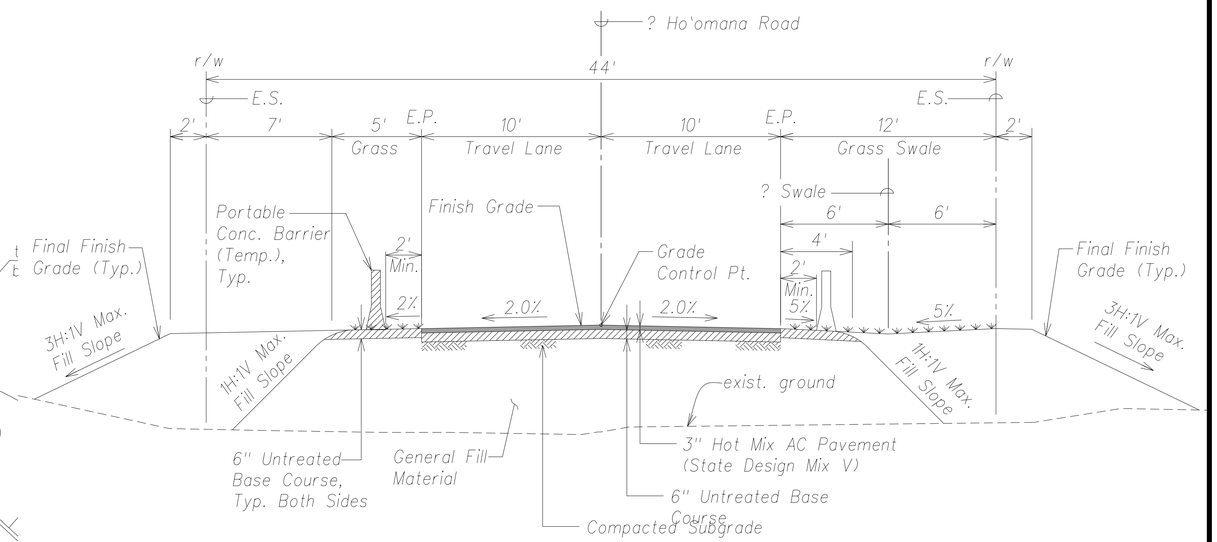

Typical Section - Ho'omana Road
(Interim Condition)
Sta. 0+78.52 To Sta. 2+35.28

Scale: 1" = 4'

Notes:

1. See sheet C-20 for the Roadway Plan (Interim Condition).
2. See sheet C-21 for drainage system details and remainder of the roadway grading information.
3. All work performed under the Interim Condition shall be contained within the existing State Right-of-Way or existing Easements in favor of the State.
4. Existing gravel access road crossing the proposed Hoomana Road will not be useable during the Interim Condition.
5. The contractor shall remove all temporary improvements installed for the Interim Condition after the State has acquired all proposed Easements in order to construct the Ultimate Phase 1 improvements.

APPROVED BY:

COUNTY ENGINEER, DEPARTMENT OF PUBLIC WORKS (FOR WORK IN THE COUNTY RIGHT-OF-WAY) — DATE

Legend:

- Exist Property Line or County Right-of-Way
- Exist State Right-of-Way
- 66 — Exist Ground Contour
- 68 — Proposed Finished Grade Contour
- Limit of Grading

Graphic Scale:

1" = 4' : 4' 2' 0 4' 8'

1" = 20' : 20' 10' 0 20' 40'

Scale in Feet

MICHAEL H. OKAMOTO — LICENSED PROFESSIONAL ENGINEER — No. 8624-C — HAWAII, U.S.A.

THIS WORK WAS PREPARED BY ME OR UNDER MY SUPERVISION AND CONSTRUCTION OF THIS PROJECT WILL BE UNDER MY OBSERVATION.

SIGNATURE — April 30, 2014 EXPIRATION DATE OF THE LICENSE

STATE OF HAWAII
DEPARTMENT OF TRANSPORTATION
HIGHWAYS DIVISION

GRADING PLAN
(INTERIM CONDITION)

PHASE 1 - KAUMUALI'I HIGHWAY
LIHU'E MILL BRIDGE TO RICE STREET
PHASE 1 - HO'OMANA ROAD

Scale: As Shown — Date: December 4, 2012

SHEET No. C-20 OF 50 SHEETS

ORIGINAL PLAN — SURVEY PLOTTED BY — DRAWN BY — TRACED BY — DESIGNED BY — QUANTITIES BY — CHECKED BY — DATE

NOTE BOOK — No.

"AS-BUILT"

Model