FED. ROAD DIST. NO.	STATE	FED. AID PROJ. NO.	FISCAL YEAR	SHEET NO.	TOTAL SHEETS
HAWAI'I	HAW.	ARR-050-1(036)	FY13/14		50

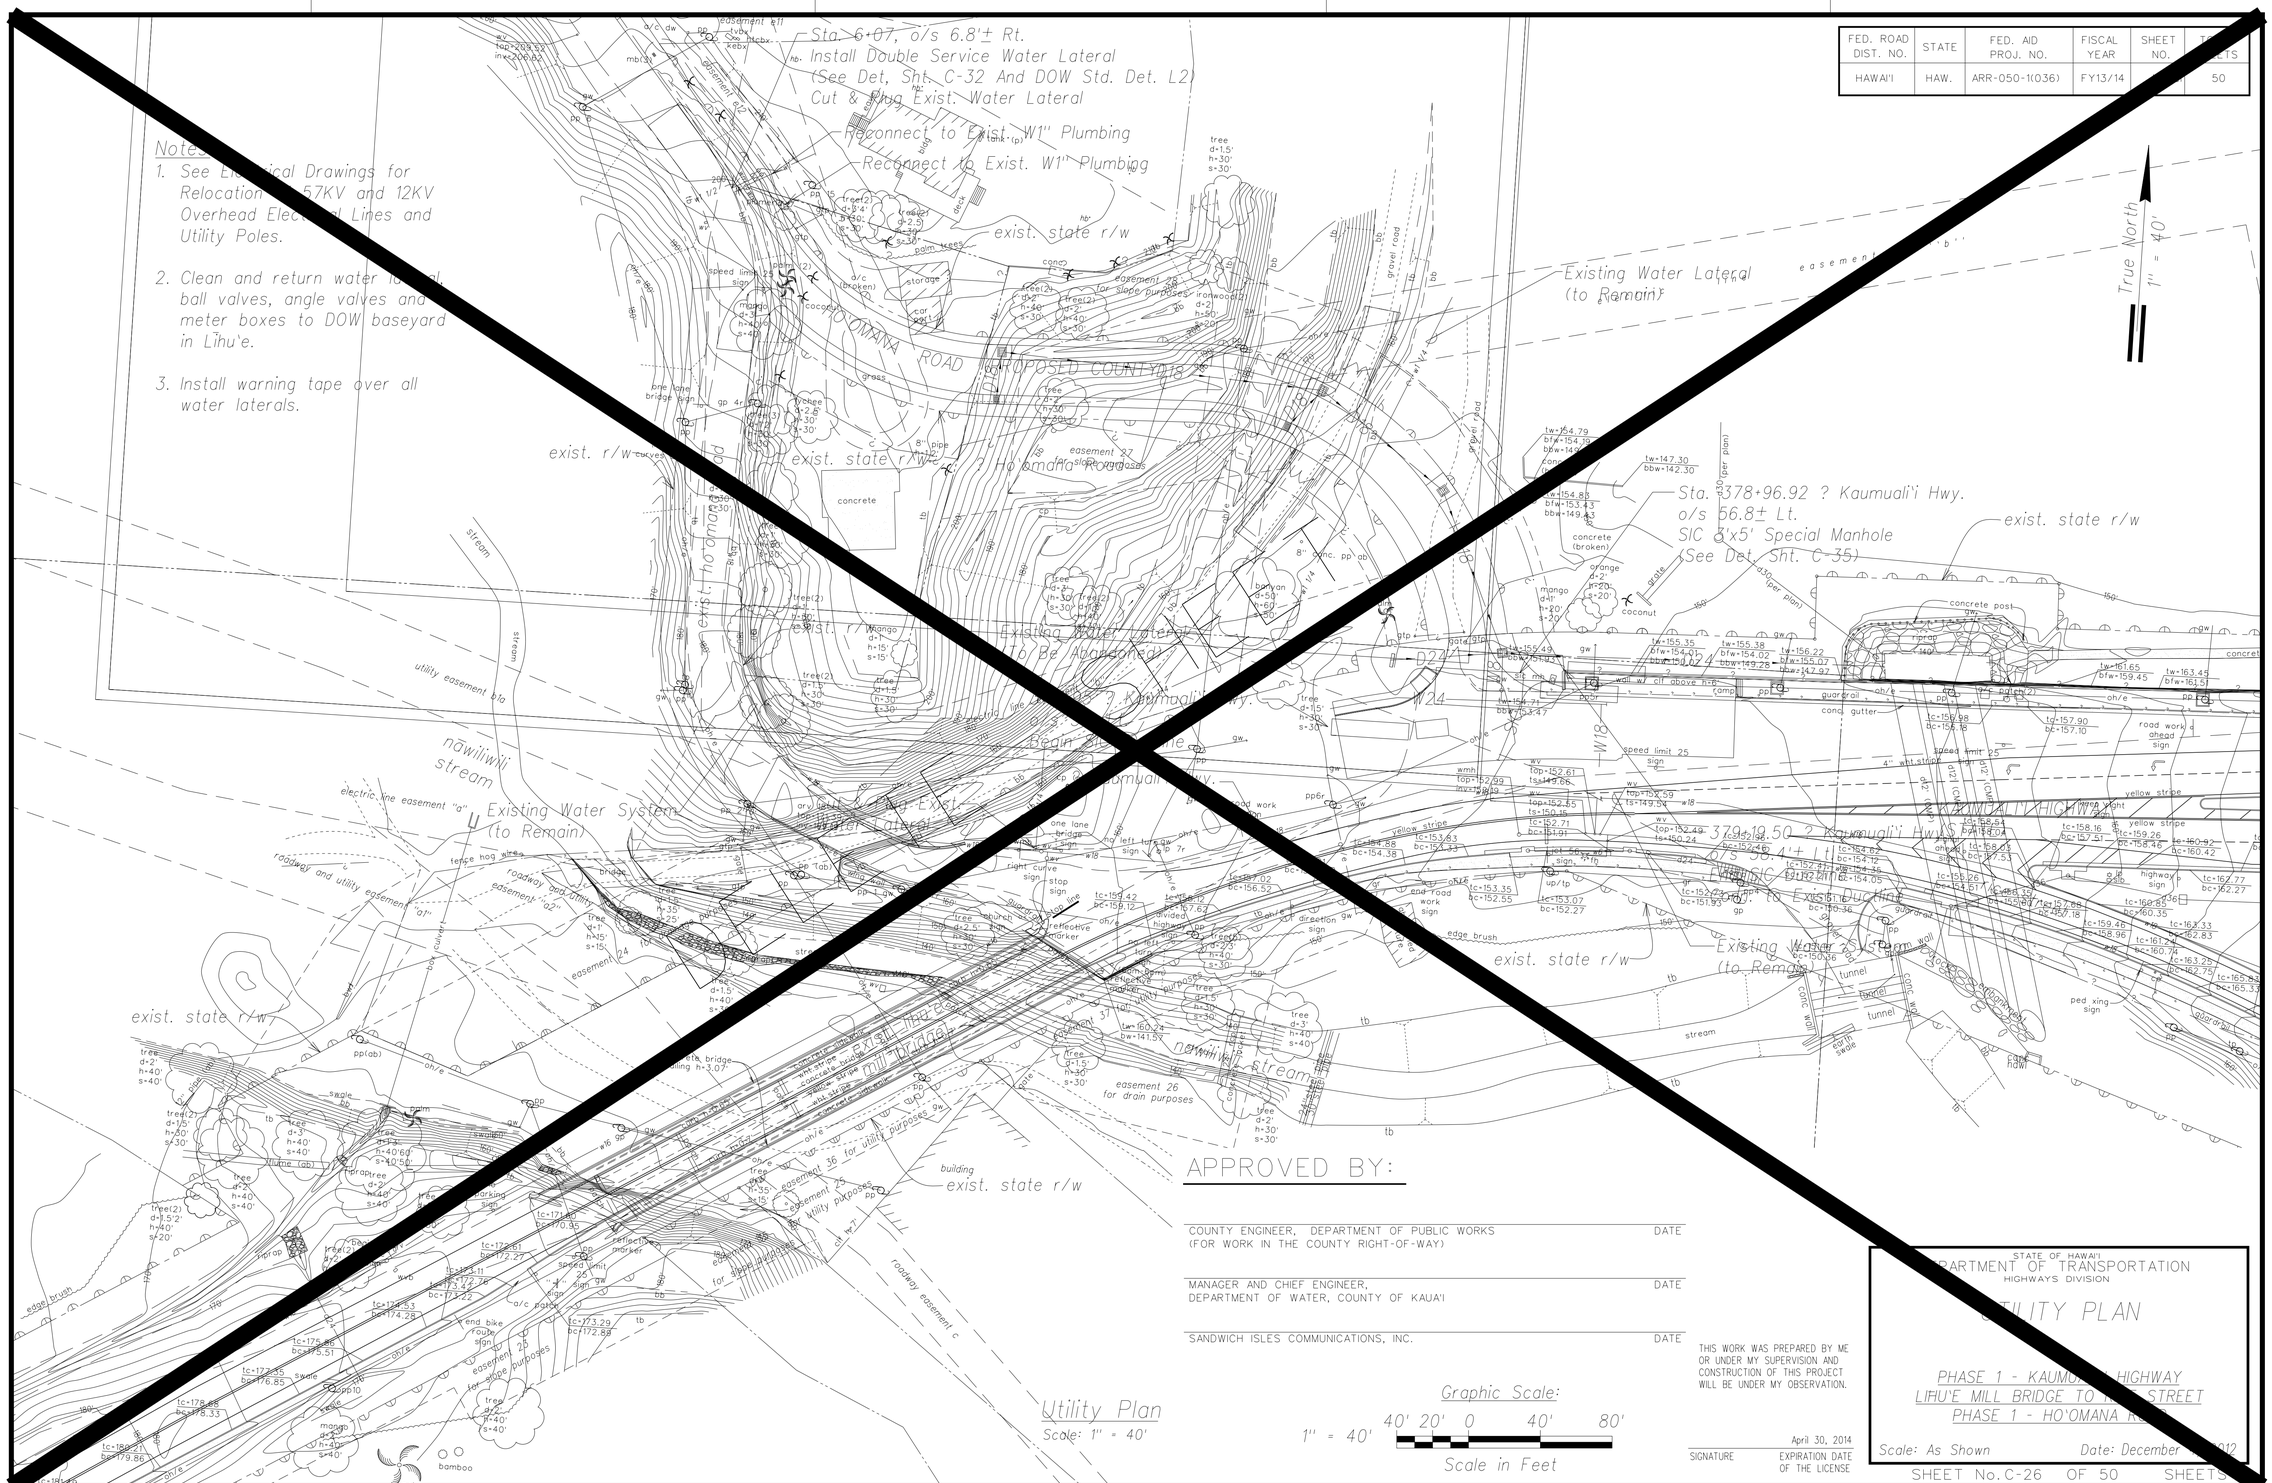

Notes:

1. See Electrical Drawings for Relocation of 57KV and 12KV Overhead Electrical Lines and Utility Poles.
2. Clean and return water lateral, ball valves, angle valves and meter boxes to DOW baseyard in Līhu'e.
3. Install warning tape over all water laterals.

APPROVED BY:

COUNTY ENGINEER, DEPARTMENT OF PUBLIC WORKS (FOR WORK IN THE COUNTY RIGHT-OF-WAY) — DATE

MANAGER AND CHIEF ENGINEER, DEPARTMENT OF WATER, COUNTY OF KAUA'I — DATE

SANDWICH ISLES COMMUNICATIONS, INC. — DATE

THIS WORK WAS PREPARED BY ME OR UNDER MY SUPERVISION AND CONSTRUCTION OF THIS PROJECT WILL BE UNDER MY OBSERVATION.

SIGNATURE — April 30, 2014 EXPIRATION DATE OF THE LICENSE

Graphic Scale:

1" = 40' 40' 20' 0 40' 80'

Scale in Feet

STATE OF HAWAII
DEPARTMENT OF TRANSPORTATION
HIGHWAYS DIVISION

UTILITY PLAN

PHASE 1 - KAUMUALI'I HIGHWAY
PHASE 1 - HO'OMANA ROAD

Scale: As Shown Date: December 2012

SHEET No. C-26 OF 50 SHEETS

ORIGINAL PLAN	
NOTE BOOK	
No.	

SURVEY PLOTTED BY ____ DATE
DRAWN BY ____
TRACED BY ____
DESIGNED BY ____
QUANTITIES BY ____
CHECKED BY ____

"AS-BUILT"

Model

FED. ROAD DIST. NO.	STATE	FED. AID PROJ. NO.	FISCAL YEAR	SHEET NO.	TOTAL SHEETS
HAWAI'I	HAW.	ARR-050-1(036)	FY13/14	Model	50

Notes:

1. See Electrical Drawings for Relocation of 57KV and 12KV Overhead Electrical Lines and Utility Poles.
2. Clean and return water lateral, ball valves, angle valves and meter boxes to DOW baseyard in Lihu'e.
3. Install warning tape over all water laterals.

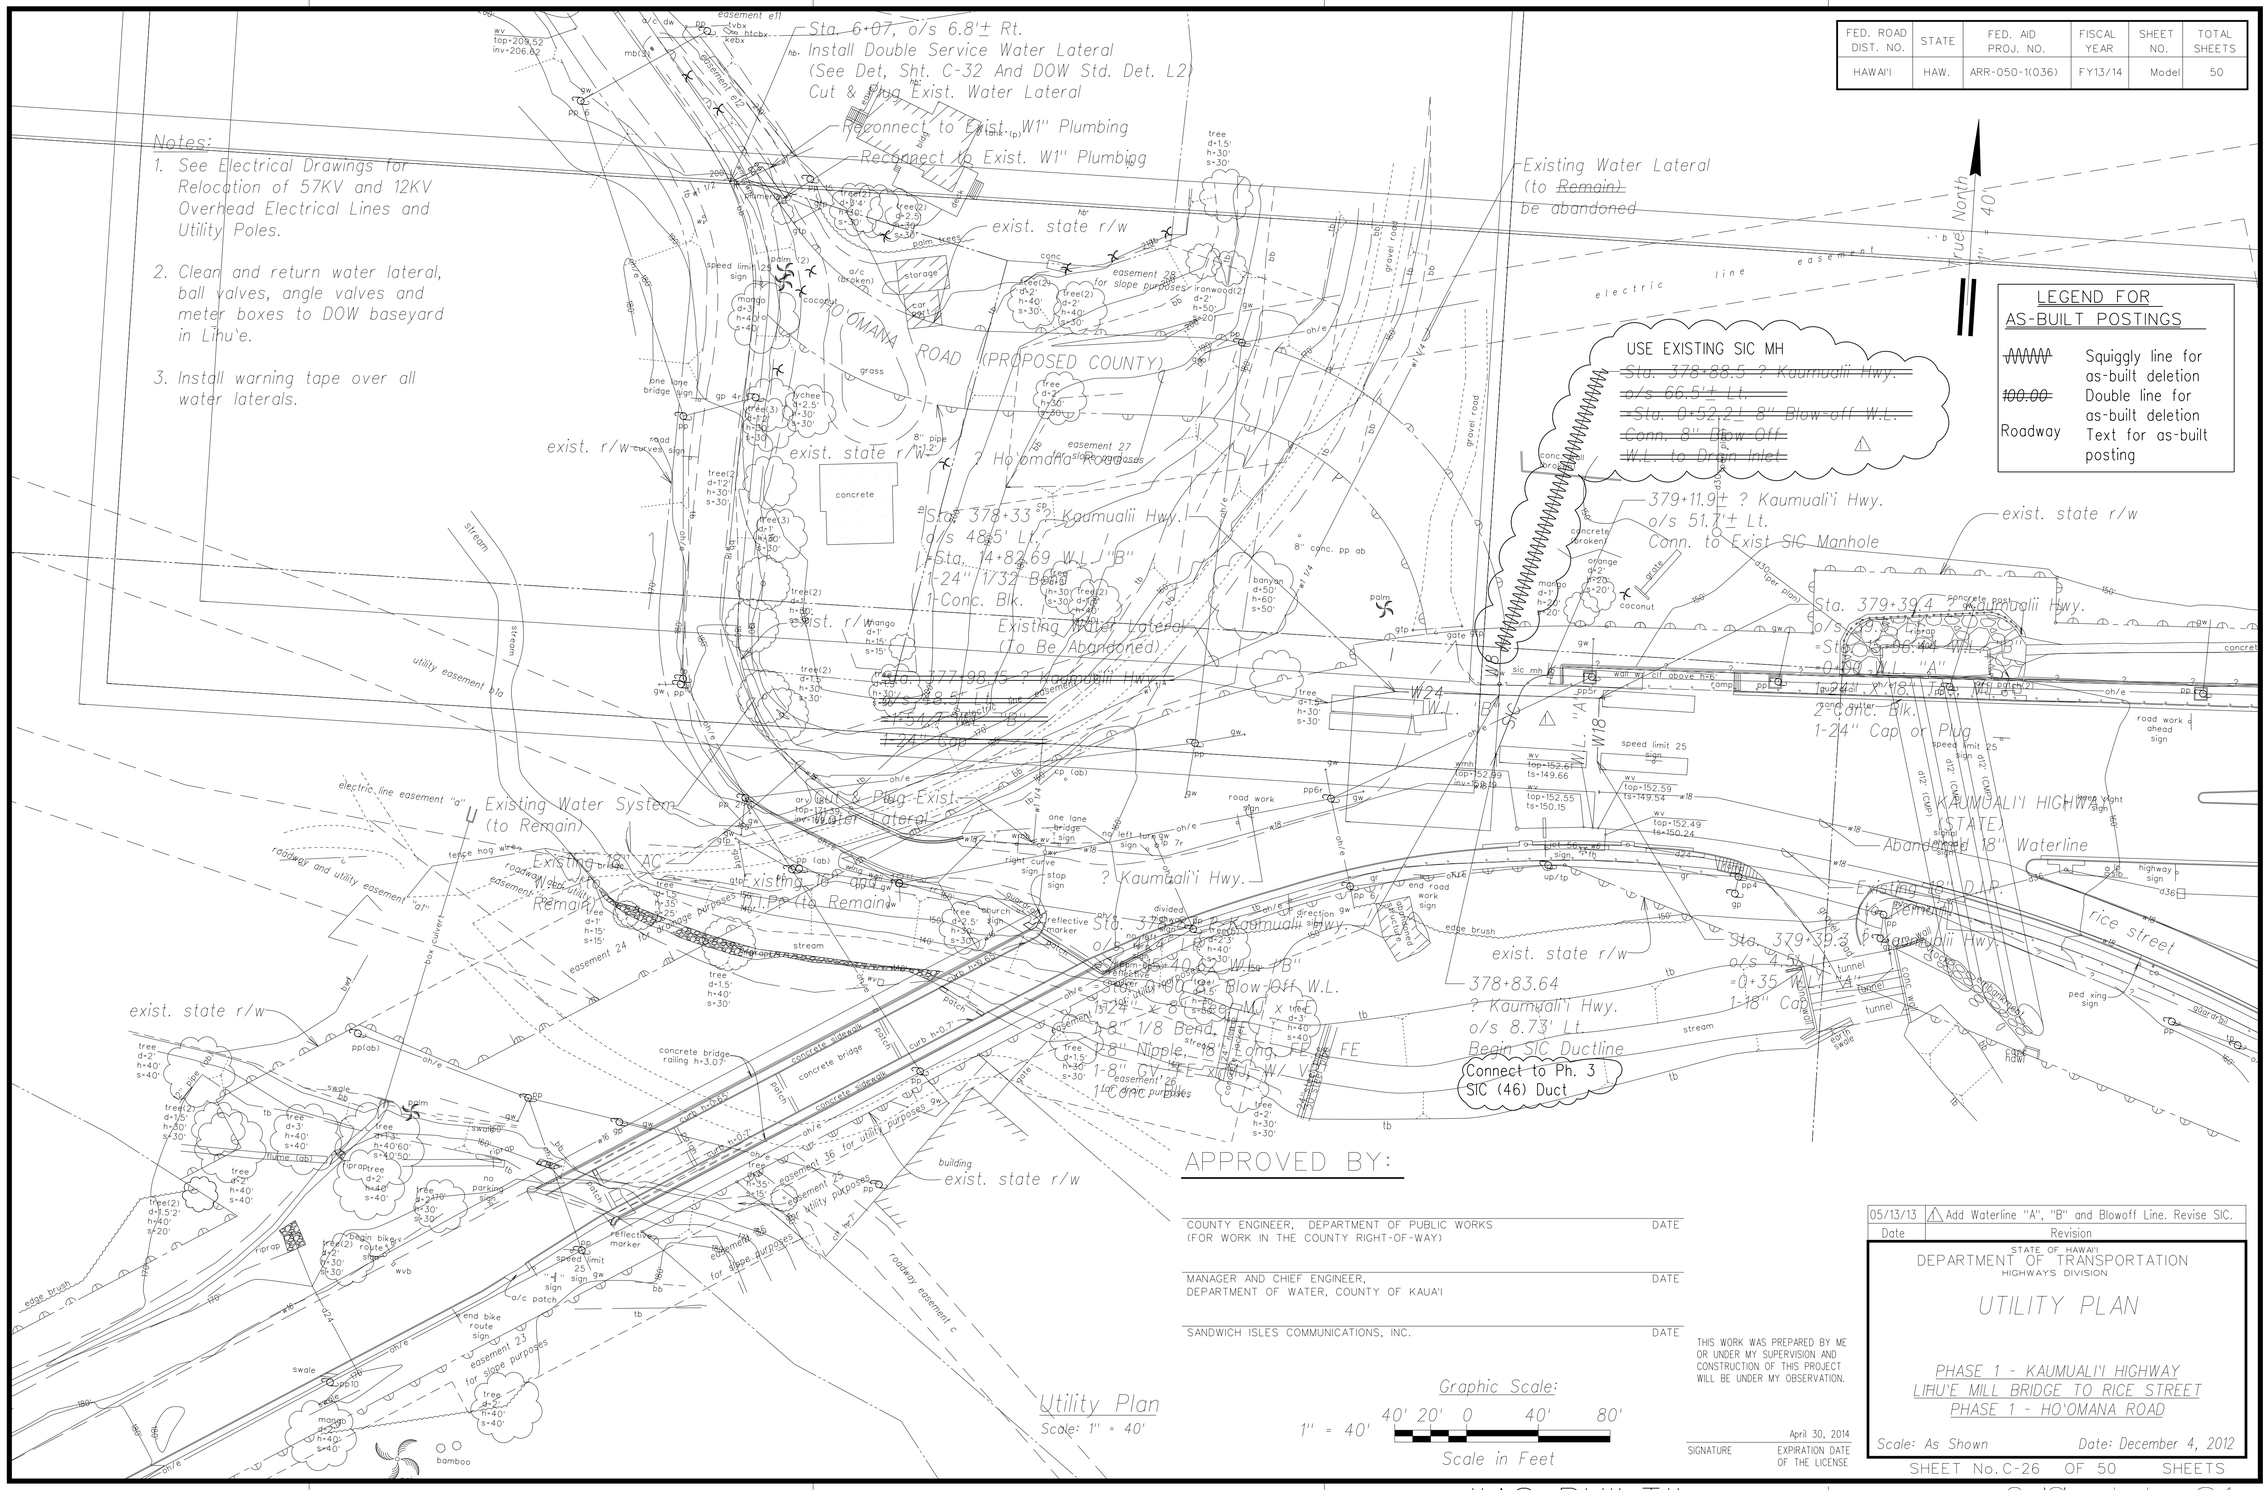

APPROVED BY:

COUNTY ENGINEER, DEPARTMENT OF PUBLIC WORKS (FOR WORK IN THE COUNTY RIGHT-OF-WAY) — DATE

MANAGER AND CHIEF ENGINEER, DEPARTMENT OF WATER, COUNTY OF KAUA'I — DATE

SANDWICH ISLES COMMUNICATIONS, INC. — DATE

THIS WORK WAS PREPARED BY ME OR UNDER MY SUPERVISION AND CONSTRUCTION OF THIS PROJECT WILL BE UNDER MY OBSERVATION.

SIGNATURE — April 30, 2014 EXPIRATION DATE OF THE LICENSE

Date	Revision
05/13/13	⚠ Add Waterline "A", "B" and Blowoff Line. Revise SIC.

STATE OF HAWAI'I
DEPARTMENT OF TRANSPORTATION
HIGHWAYS DIVISION

UTILITY PLAN

PHASE 1 - KAUMUALI'I HIGHWAY
LIHU'E MILL BRIDGE TO RICE STREET
PHASE 1 - HO'OMANA ROAD

Scale: As Shown — Date: December 4, 2012

SHEET No. C-26 OF 50 SHEETS

ORIGINAL PLAN — SURVEY PLOTTED BY / DRAWN BY / TRACED BY / DESIGNED BY / QUANTITIES BY / CHECKED BY — DATE

NOTE BOOK No.

"AS-BUILT"

C. Model S1