FED. ROAD DIST. NO.	STATE	FED. AID PROJ. NO.	FISCAL YEAR	SHEET NO.	TOTAL SHEETS
HAWAII	HAW.	ARR-050-1(036)	FY13/14	Model	131

RFI-D NO. 72

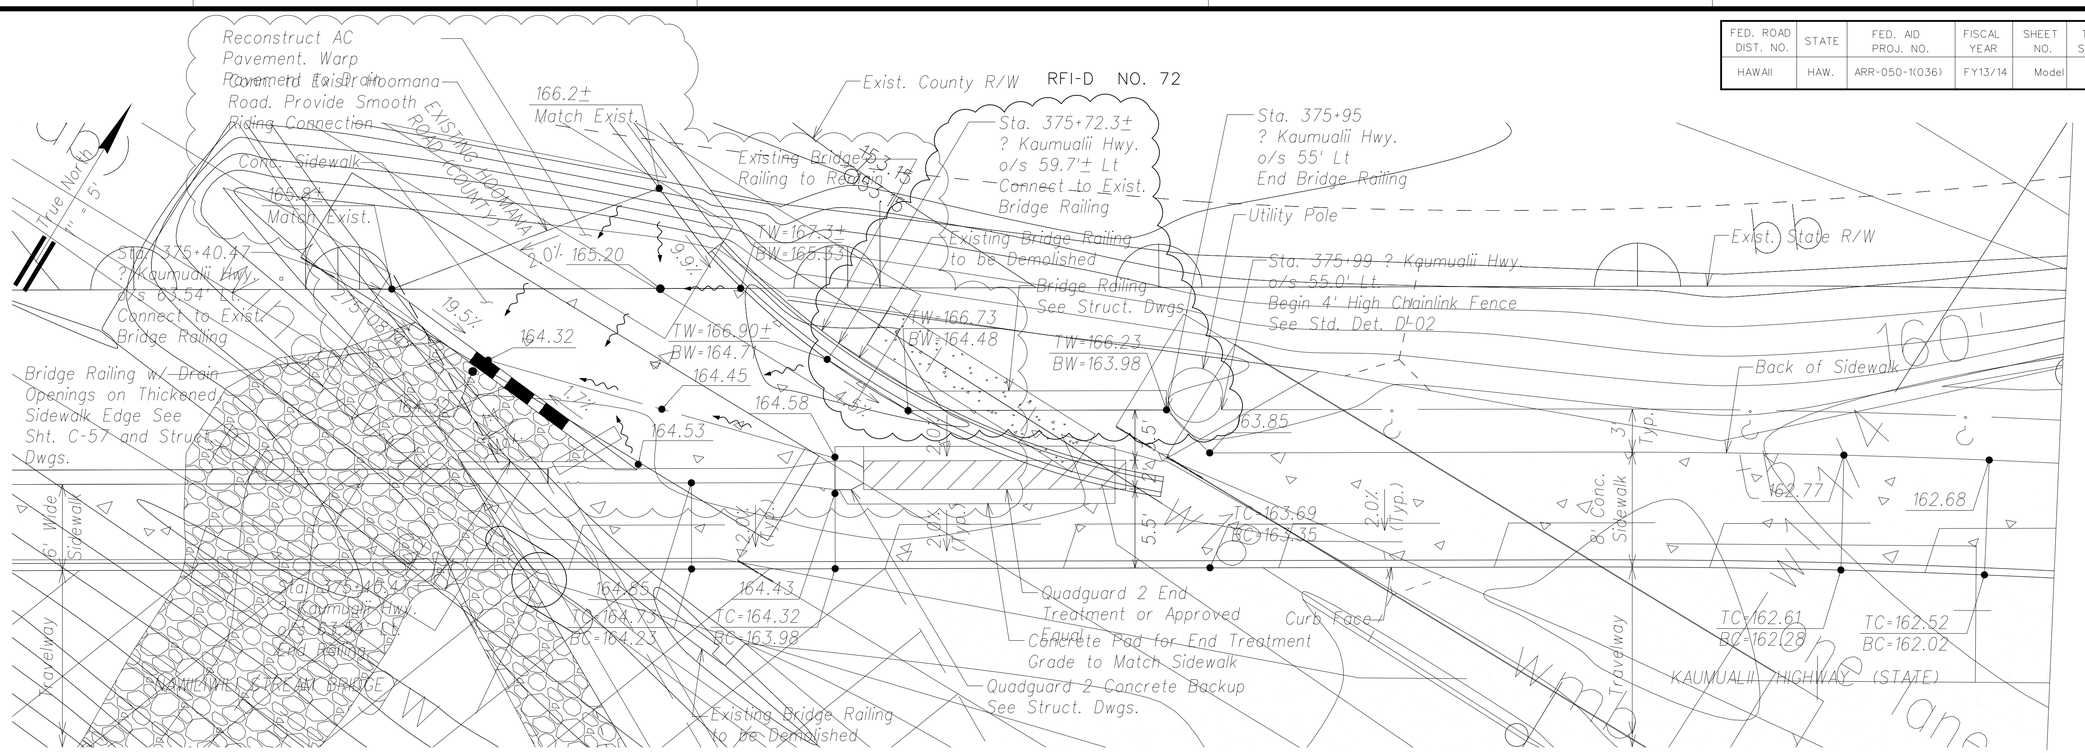

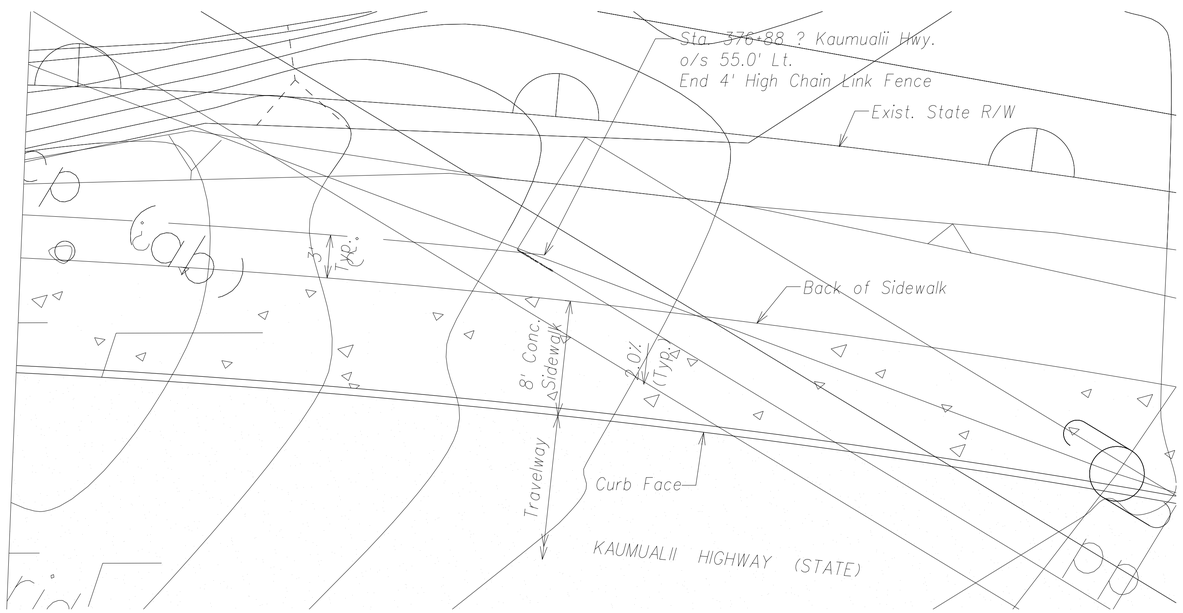

Enlargement: Connection to Existing Hoomana Road

Scale: 1" = 5'

Legend:

168.90	Finished Grade Elevation
	Exist. Property Line or County Right-of-Way
	Exist. State Right-of-Way
66	Exist. Ground Contour
66	Finish Ground Contour
	Top of Bank
	Bottom of Bank

Fill Condition Cut Condition

LEGEND FOR AS-BUILT POSTINGS

WWWWW	Squiggly line for as-built deletion
~~100.00~~	Double line for as-built deletion
Roadway	Text for as-built posting

Graphic Scales:

1" = 5' 5' 2.5' 0 5' 10'

Scale in Feet

MICHAEL H. OKAMOTO LICENSED PROFESSIONAL ENGINEER No. 8624-C HAWAII, U.S.A.

THIS WORK WAS PREPARED BY ME OR UNDER MY SUPERVISION AND CONSTRUCTION OF THIS PROJECT WILL BE UNDER MY OBSERVATION.

SIGNATURE — EXPIRATION DATE OF THE LICENSE: April 30, 2016

Date	Revision
2/17/15	1 Revise bike path grading

STATE OF HAWAII
DEPARTMENT OF TRANSPORTATION
HIGHWAYS DIVISION

WALL DETAILS

PHASE 1 - KAUMUALII HIGHWAY
LIHUE MILL BRIDGE TO RICE STREET
PHASE 2 - NAWILIWILI STREAM BRIDGE
AND MAUKA WIDENING

Scale: As Shown Date: March 25, 2013

SHEET No. C-61 OF 84 SHEETS

ORIGINAL PLAN — NOTE BOOK No. — SURVEY PLOTTED BY — DRAWN BY — TRACED BY — DESIGNED BY — QUANTITIES BY — CHECKED BY — DATE

"AS-BUILT"

MODEL S1