INDEX TO DRAWINGS	
SHEET NO.	DESCRIPTION
1	TITLE SHEET
2	STANDARD PLANS AND SUMMARY
3 – 4	GENERAL NOTES AND LEGEND
5 – 6	WATER POLLUTION AND EROSION CONTROL NOTES
7	TYPICAL SECTIONS
8	ROADWAY PLAN
9 – 10	PORTABLE CONCRETE BARRIER
11	CURB RAMP AND SIDEWALK NOTES
12	CURB RAMP MODIFIED TYPE "B" DETAIL
13	DETECTABLE WARNING DETAILS
14	RAILING DETAILS
15	PAVEMENT STRIPING, MARKING, LEGEND, DETAILS AND NOTES
16	TRAFFIC SIGNING AND PAVEMENT MARKING PLAN
17	LOW SPEED UNDIVIDED HIGHWAY WORK ZONE SIGNING PLANS, NOTES AND DETAILS
18	TRAFFIC CONTROL PLAN WITHIN COUNTY RIGHT-OF-WAY
19	CROSS SECTION

STATE OF HAWAII

DEPARTMENT OF TRANSPORTATION

HIGHWAYS DIVISION

HONOLULU, HAWAII

"AS-BUILT"

PLANS FOR

KAUMUALII HIGHWAY

INTERSECTION IMPROVEMENTS AT ALA WAI ROAD

PROJECT NO. 50B-01-09

DISTRICT OF WAIMEA

ISLAND OF KAUAI

FED. ROAD DIST. NO.	STATE	PROJ. NO.	FISCAL YEAR	SHEET NO.	TOTAL SHEETS
HAWAII	HAW.	50B-01-09	2009	1	19

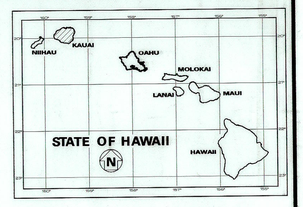

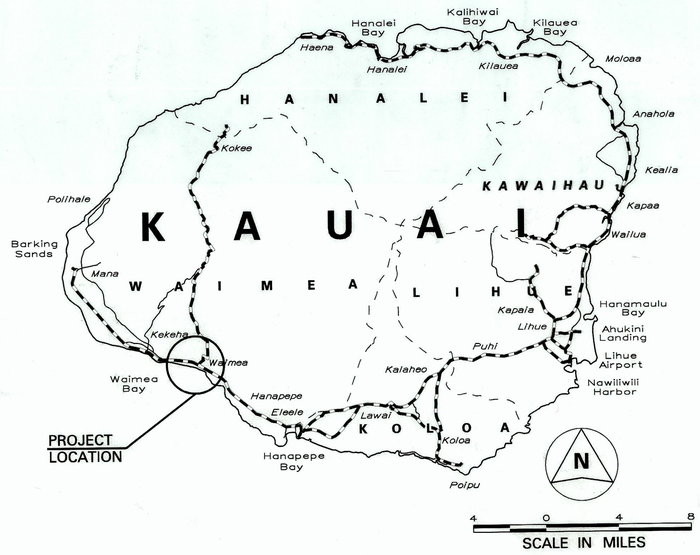

50

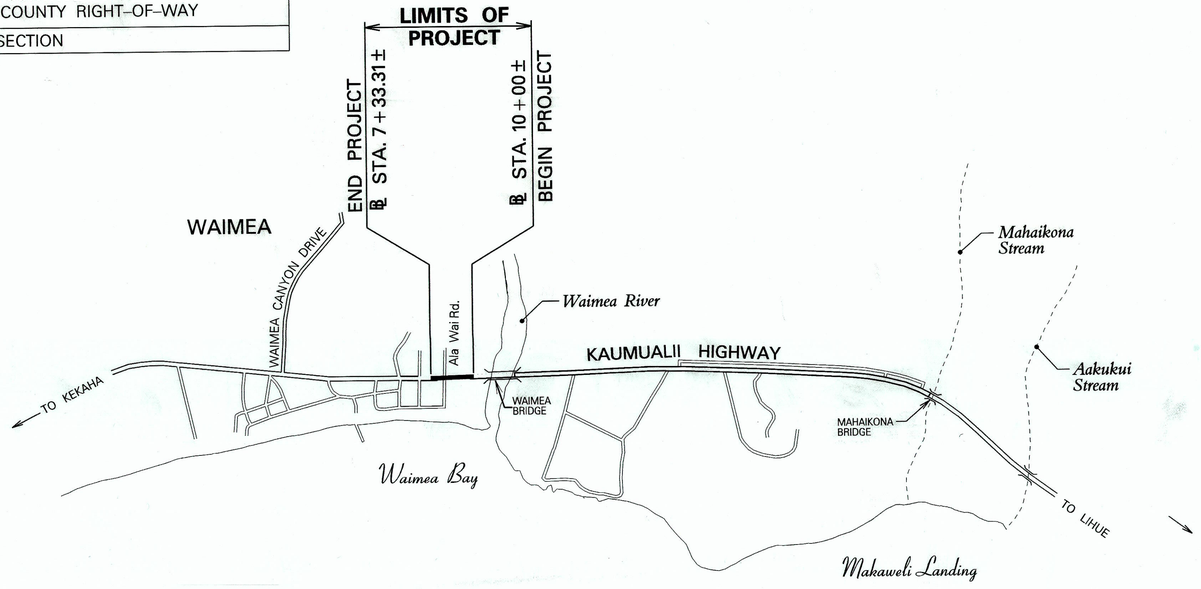

LAYOUT PLAN

GROSS LENGTH OF PROJECT.....0.08 MILE

NET LENGTH OF PROJECT.....0.08 MILE

---- FEDERAL AID PROJECTS PREVIOUSLY CONSTRUCTED OR UNDER CONSTRUCTION

MILE POST 22.56 TO MILE POST 22.66

NO SIGNIFICANT CHANGES WERE MADE DURING CONSTRUCTION ON THESE PLANS EXCEPT CHANGES IN THE ORIGINAL THEORETICAL QUANTITIES. FOR ACTUAL QUANTITIES, REFER TO PROJECT LEDGER AND/OR EXCAVATION BOOK.

[signature] 12/12/13
RESIDENT ENGINEER DATE

DEPARTMENT OF TRANSPORTATION STATE OF HAWAII	
APPROVED:	
for DIR. OF TRANSPORTATION	4.22.09 DATE

APRIL 2009 DATE

241-3000 PHONE

HWY-KE MANAGED BY

HWY-K DESIGNED BY