FED. ROAD DIST. NO.	STATE	PROJ. NO.	FISCAL YEAR	SHEET NO.	TOTAL SHEETS
HAWAII	HAW.	HWY-K-02-98	2000	9	53

NOTE: (XXX.X) denotes approximate existing pavement elevation.

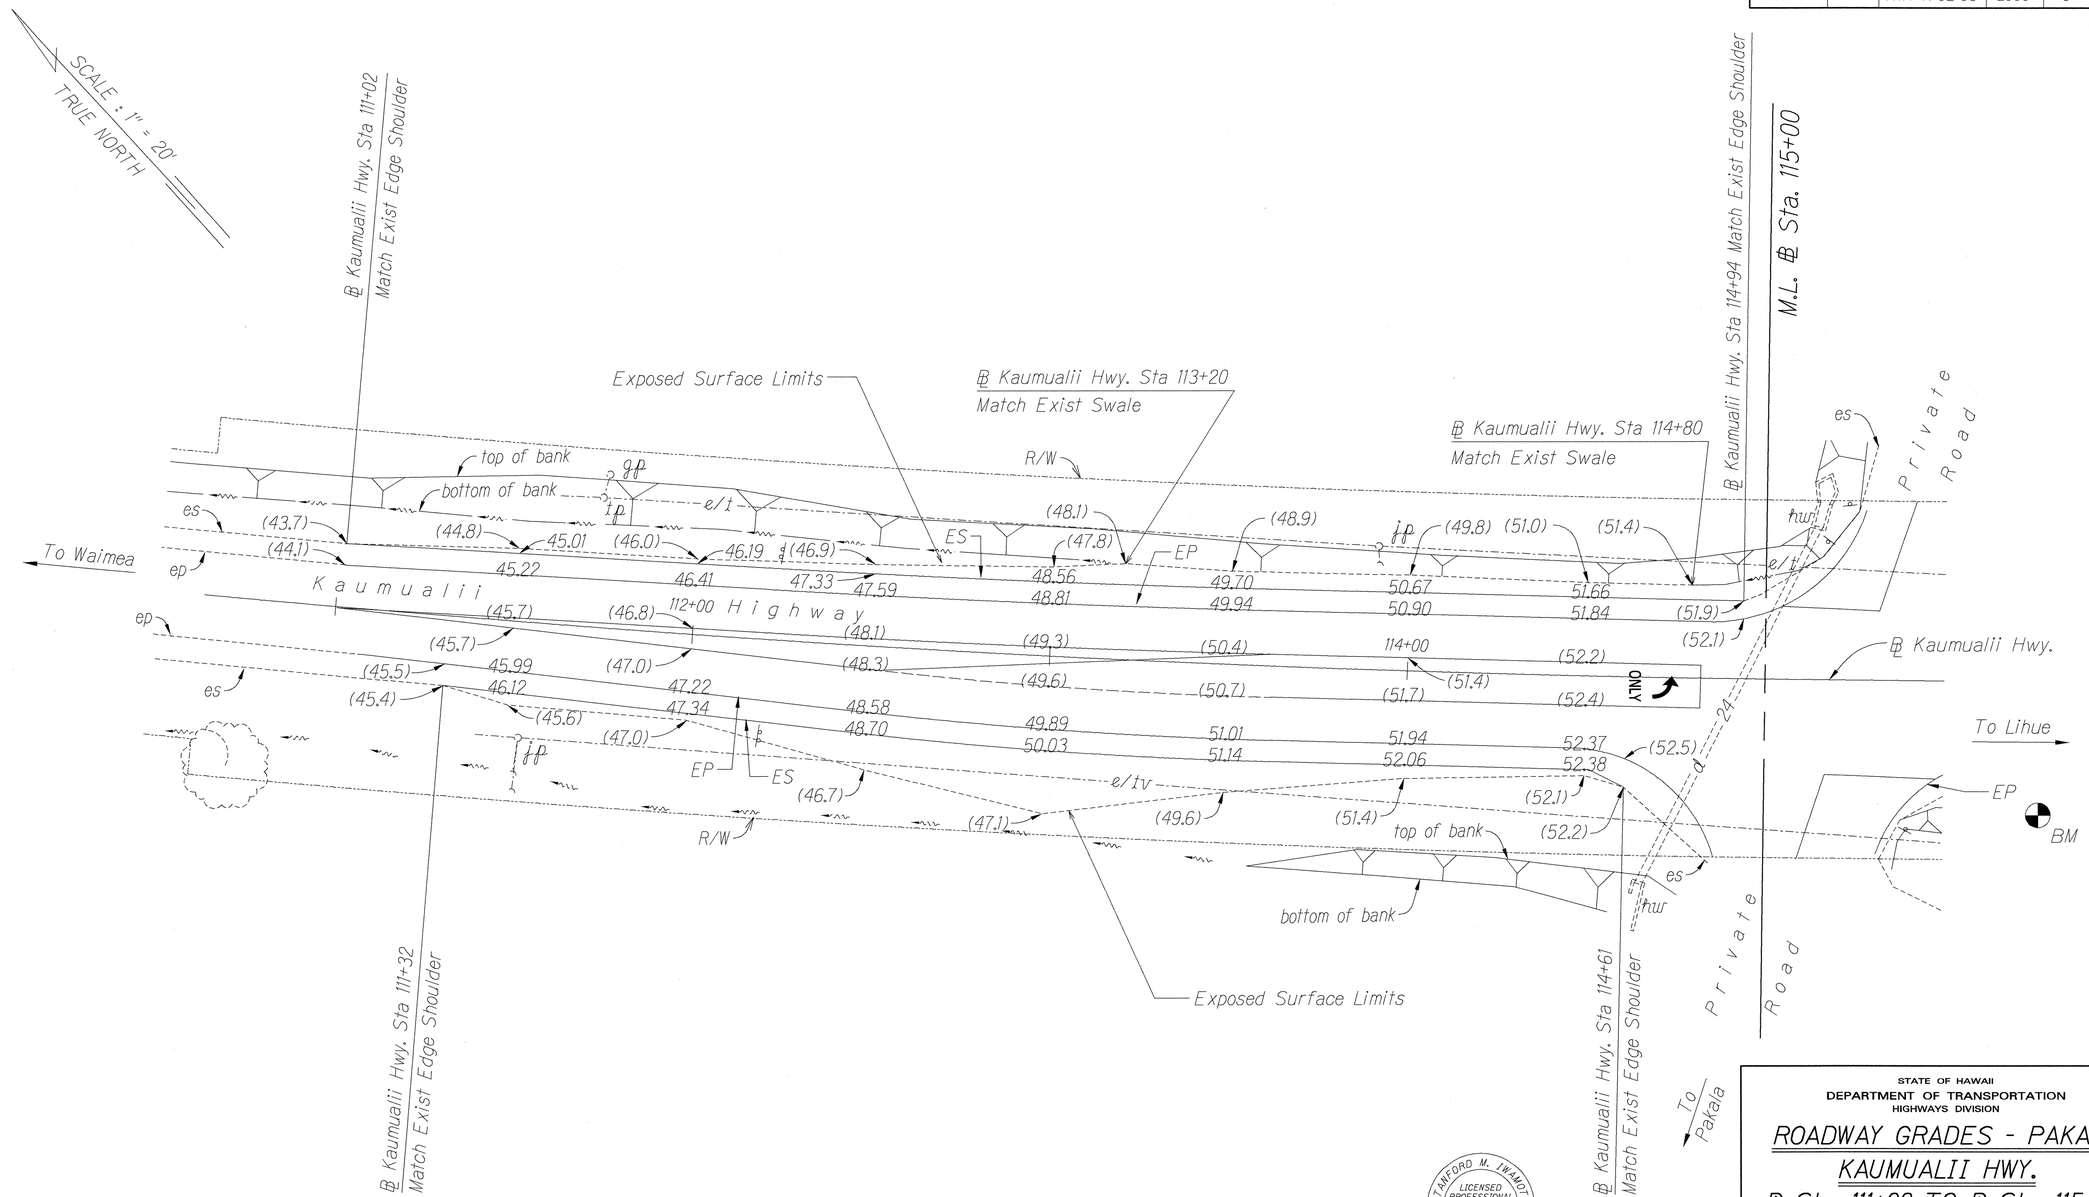

ORIGINAL PLAN	SURVEY PLOTTED BY ____ DATE ____
	DRAWN BY ____ DATE ____
	TRACED BY ____ DATE ____
NOTE BOOK No. ____	DESIGNED BY ____ DATE ____
	QUANTITIES BY ____ DATE ____
	CHECKED BY ____ DATE ____

STANFORD M. IWAMOTO
LICENSED PROFESSIONAL ENGINEER
No. 5738-C
HAWAII, U.S.A.

THIS WORK WAS PREPARED BY ME OR UNDER MY SUPERVISION

Signature

STATE OF HAWAII
DEPARTMENT OF TRANSPORTATION
HIGHWAYS DIVISION

ROADWAY GRADES - PAKALA KAUMUALII HWY.

℄ Sta. 111+02 TO ℄ Sta. 115+00

MISCELLANEOUS TRAFFIC OPERATIONAL AND SAFETY IMPROVEMENTS TO EXISTING INTERSECTIONS AND HIGHWAY FACILITIES

Project No. HWY-K-02-98

Scale: 1" = 20' Date: August, 1999

SHEET No. 1 OF 2 SHEETS

FED. ROAD DIST. NO.	STATE	PROJ. NO.	FISCAL YEAR	SHEET NO.	TOTAL SHEETS
HAWAII	HAW.	HWY-K-02-98	2000	10	53

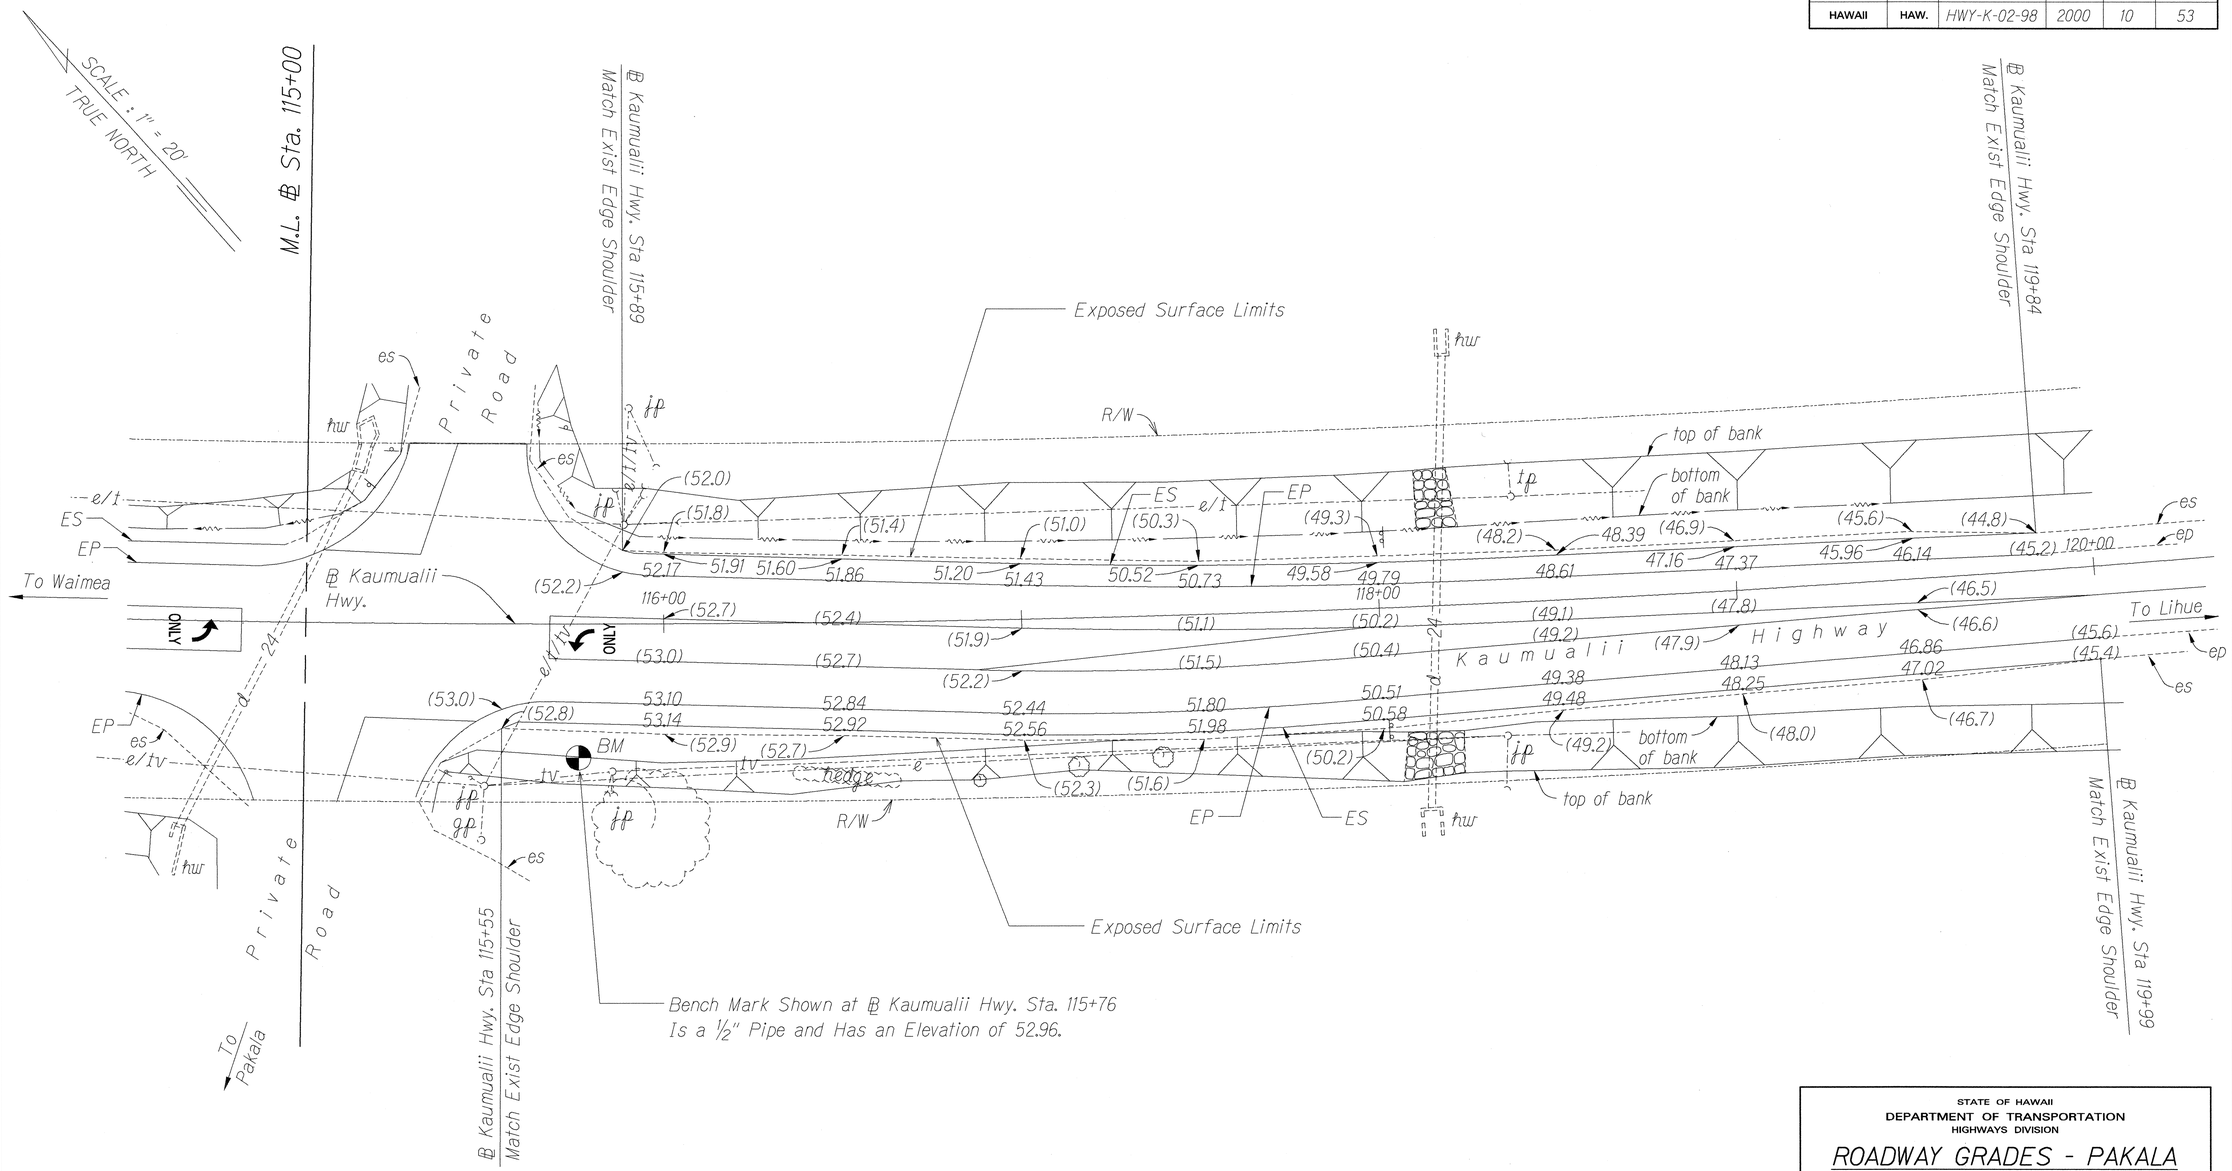

ORIGINAL PLAN	SURVEY PLOTTED BY	DATE
	DRAWN BY	DATE
	TRACED BY	DATE
NOTE BOOK	DESIGNED BY	DATE
No.	QUANTITIES BY	DATE
	CHECKED BY	DATE

STANFORD M. IWAMOTO
LICENSED PROFESSIONAL ENGINEER
No. 5738-C
HAWAII, U.S.A.

THIS WORK WAS PREPARED BY ME OR UNDER MY SUPERVISION

Signature

STATE OF HAWAII
DEPARTMENT OF TRANSPORTATION
HIGHWAYS DIVISION

ROADWAY GRADES - PAKALA
KAUMUALII HWY.
℄ Sta. 115+00 TO ℄ Sta. 119+99

MISCELLANEOUS TRAFFIC OPERATIONAL AND SAFETY IMPROVEMENTS TO EXISTING INTERSECTIONS AND HIGHWAY FACILITIES
Project No. HWY-K-02-98

Scale: 1" = 20' Date: August, 1999

SHEET No. 2 OF 2 SHEETS

"AS-BUILT"