


FED. ROAD DIST. NO.	STATE	FED. AID PROJ. NO.	FISCAL YEAR	SHEET NO.	TOTAL SHEETS
HAWAII	HAW.	STP-0700(083)	2019	7	14

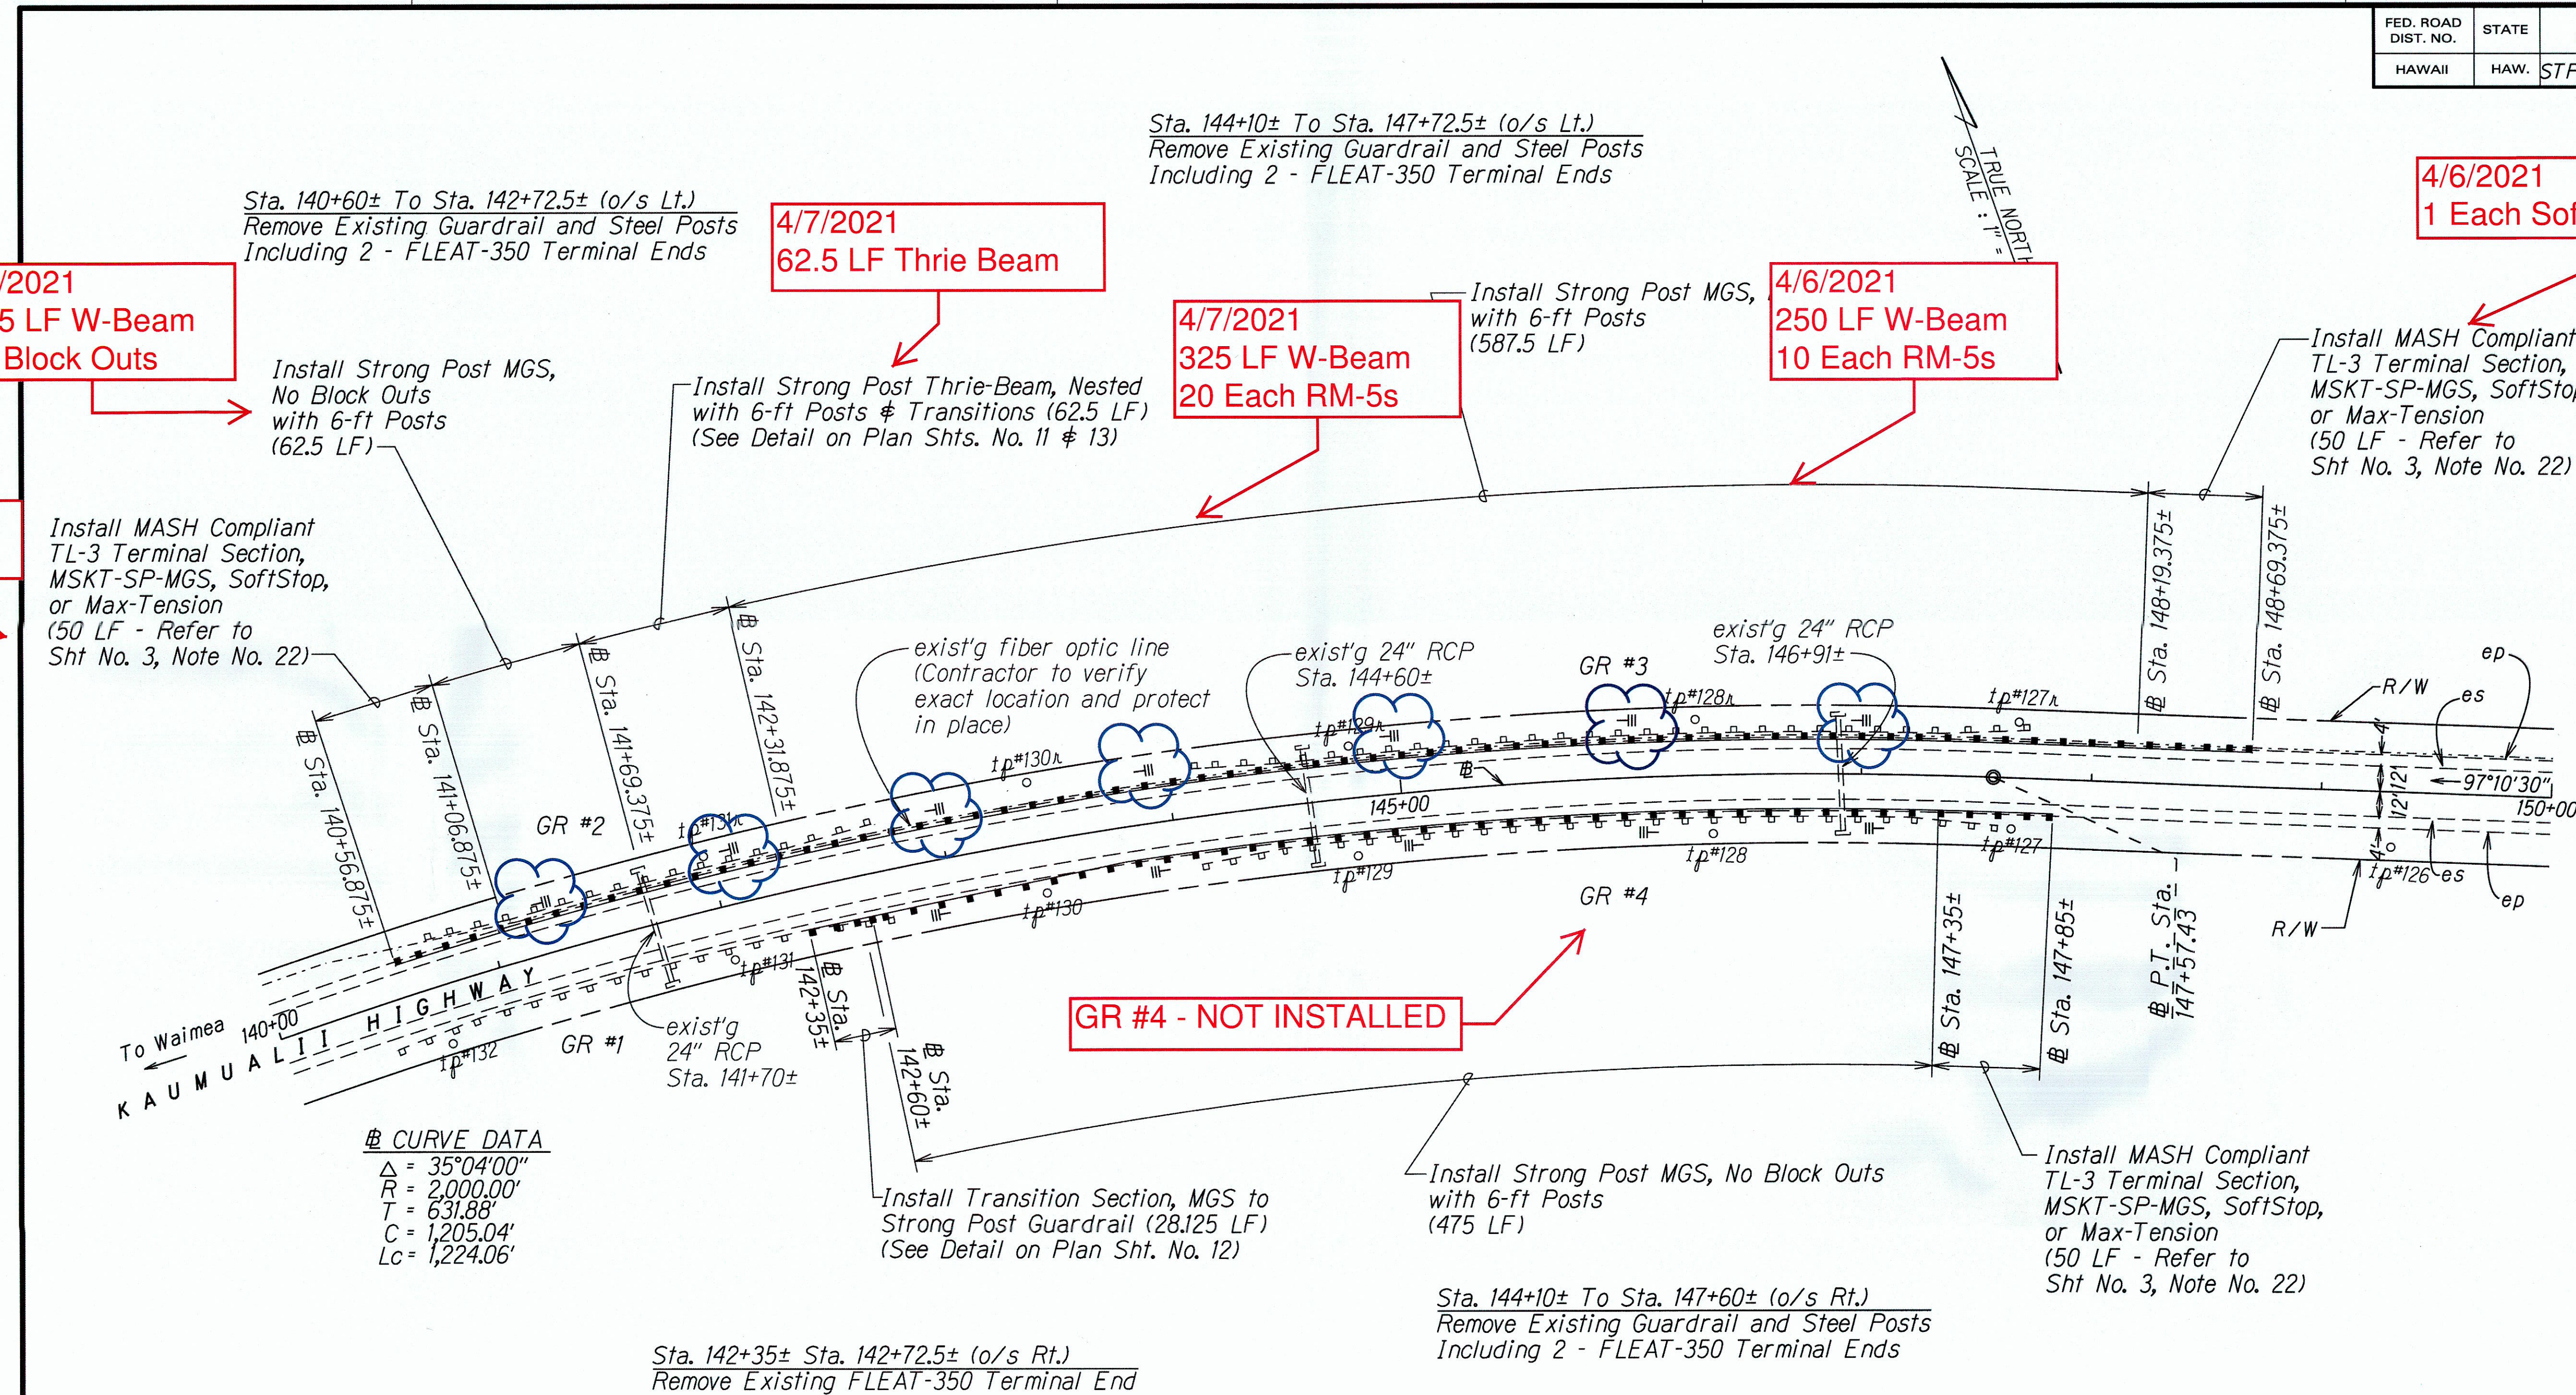

- NOTES:
1. Back of guardrail post to face of telephone pole shall be no less than 4'-1" where MGS guardrail is installed.
 2. Install new guardrail towards travelway as follows:
Guardrail #2: 25" from existing face of rail to new face of rail
Guardrail #3: 47" from existing face of rail to new face of rail
Guardrail #4: 23" from existing face of rail to new face of rail

DATE	1/2/20
SURVEY PLOTTED BY	JL
DESIGNED BY	JL
TRACED BY	JL
QUANTITIES BY	JL
CHECKED BY	JL
ORIGINAL PLAN	
NOTE BOOK	
STAMP	

STATE OF HAWAII
DEPARTMENT OF TRANSPORTATION
HIGHWAYS DIVISION

GUARDRAIL WORK ITEMS


GUARDRAIL & SHOULDER IMPROVEMENTS
AT VARIOUS LOCATIONS, PART 5
Federal-Aid Project No. STP-0700(083)

Scale: 1" = 40' Date: Mar. 2019

SHEET No. 1 OF 2 SHEETS

"AS-BUILT"

FED. ROAD DIST. NO.	STATE	FED. AID PROJ. NO.	FISCAL YEAR	SHEET NO.	TOTAL SHEETS
HAWAII	HAW.	STP-0700(083)	2019	8	14

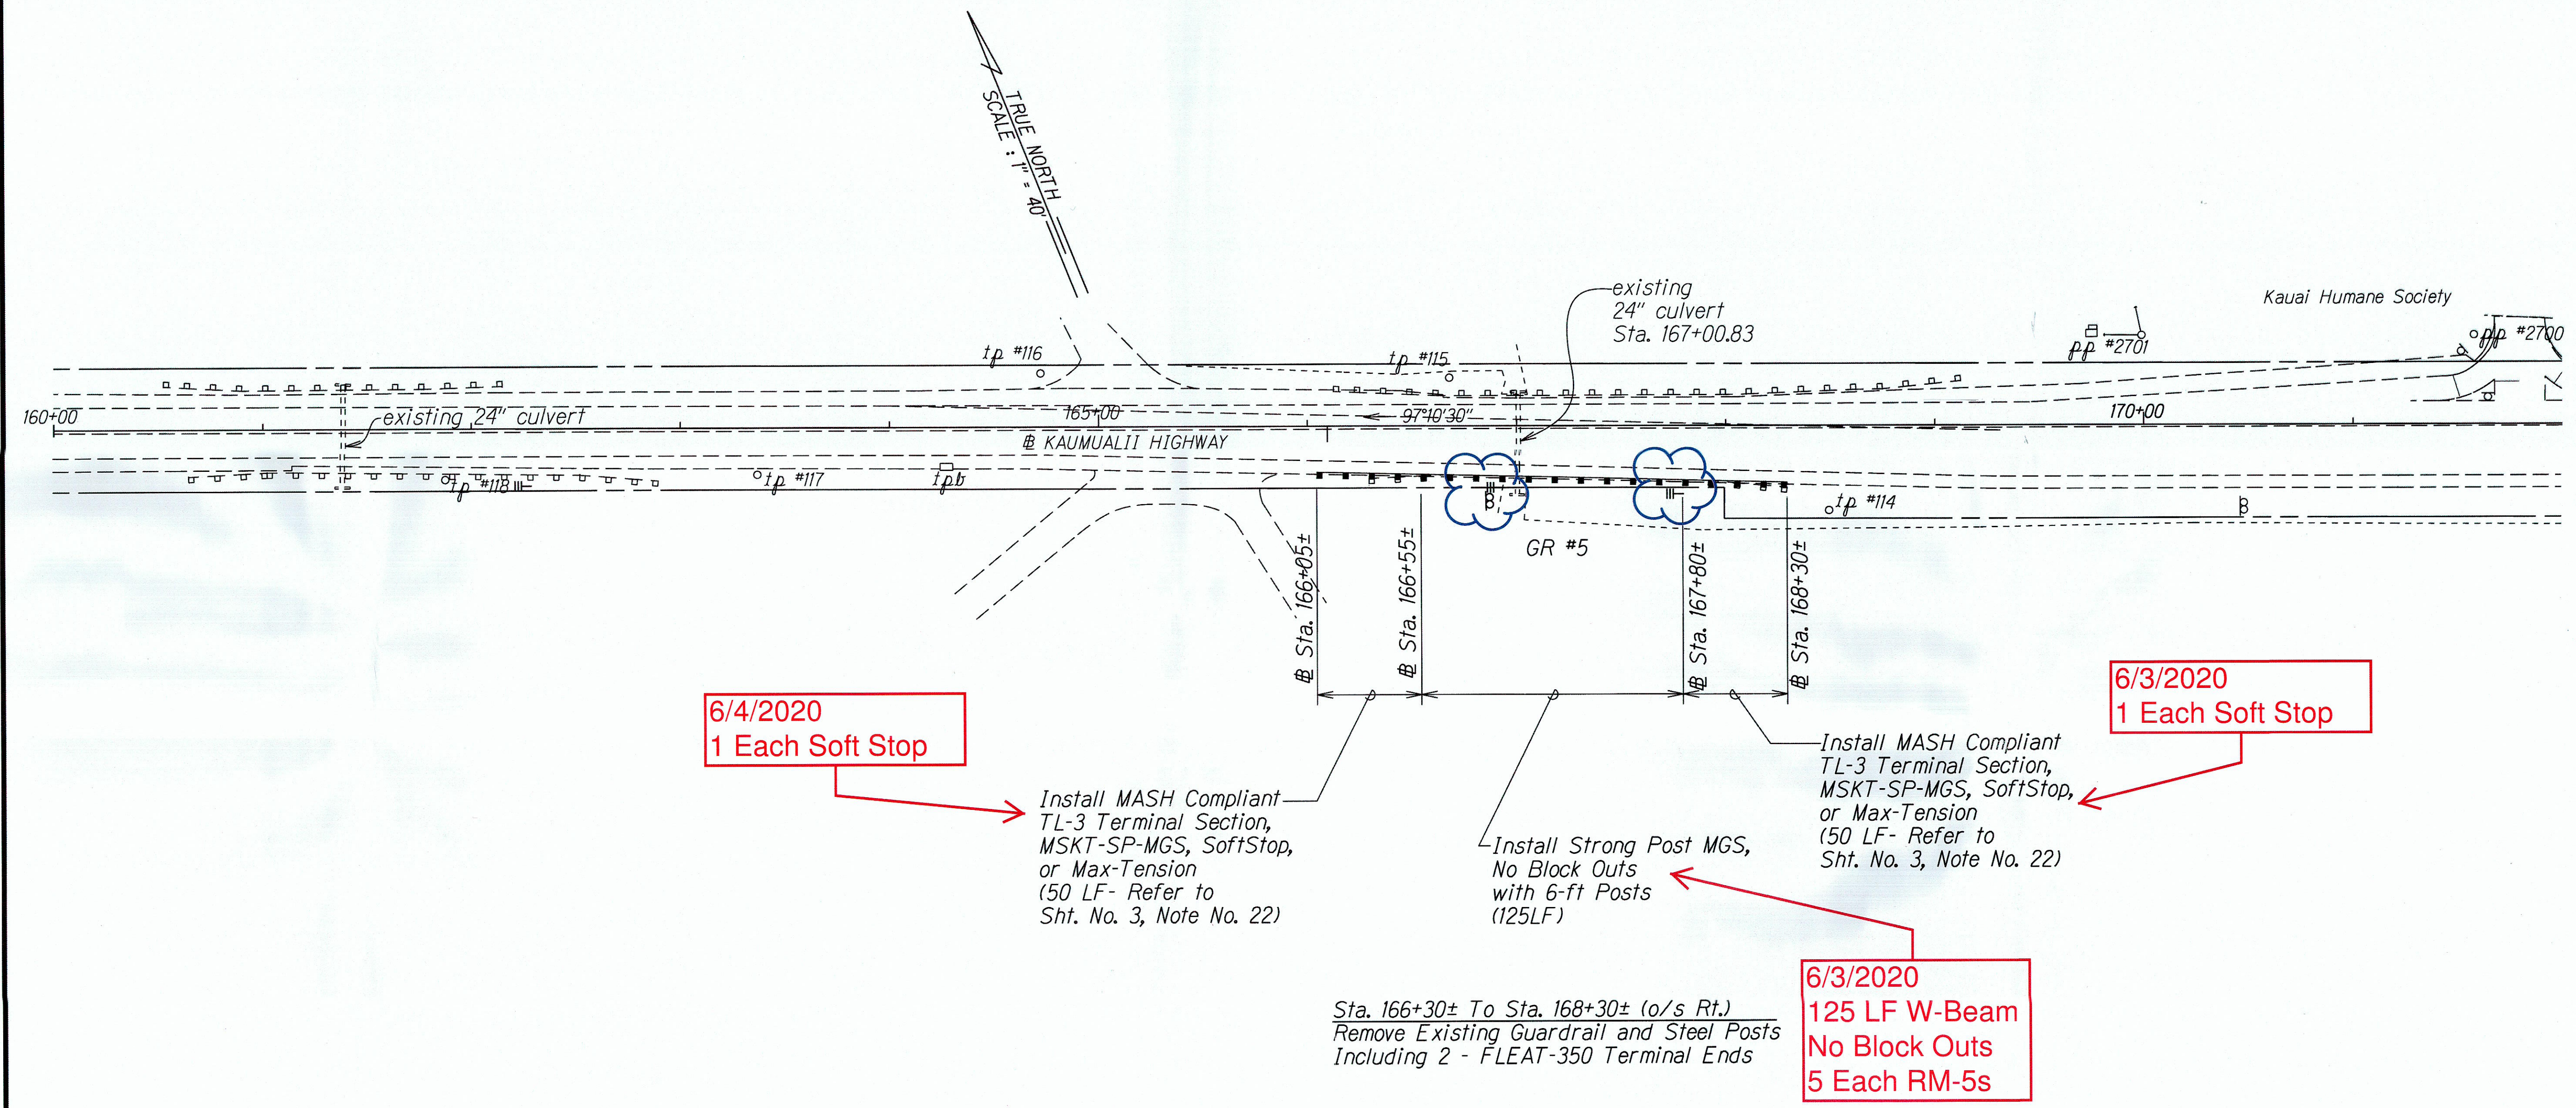

ORIGINAL PLAN	DATE
DESIGNED BY	DATE
QUANTITIES BY	DATE
CHECKED BY	DATE

STATE OF HAWAII
DEPARTMENT OF TRANSPORTATION
HIGHWAYS DIVISION

GUARDRAIL WORK ITEMS

GUARDRAIL & SHOULDER IMPROVEMENTS
AT VARIOUS LOCATIONS, PART 5
Federal-Aid Project No. STP-0700(083)

Scale: 1" = 40' Date: Mar. 2019

SHEET No. 2 OF 2 SHEETS

"AS-BUILT"