FED. ROAD DIST. NO.	STATE	FED. AID PROJ. NO.	FISCAL YEAR	SHEET NO.	TOTAL SHEETS
HAWAII	HAW.	STP-051-1(9)	1999	ADD. 11	23

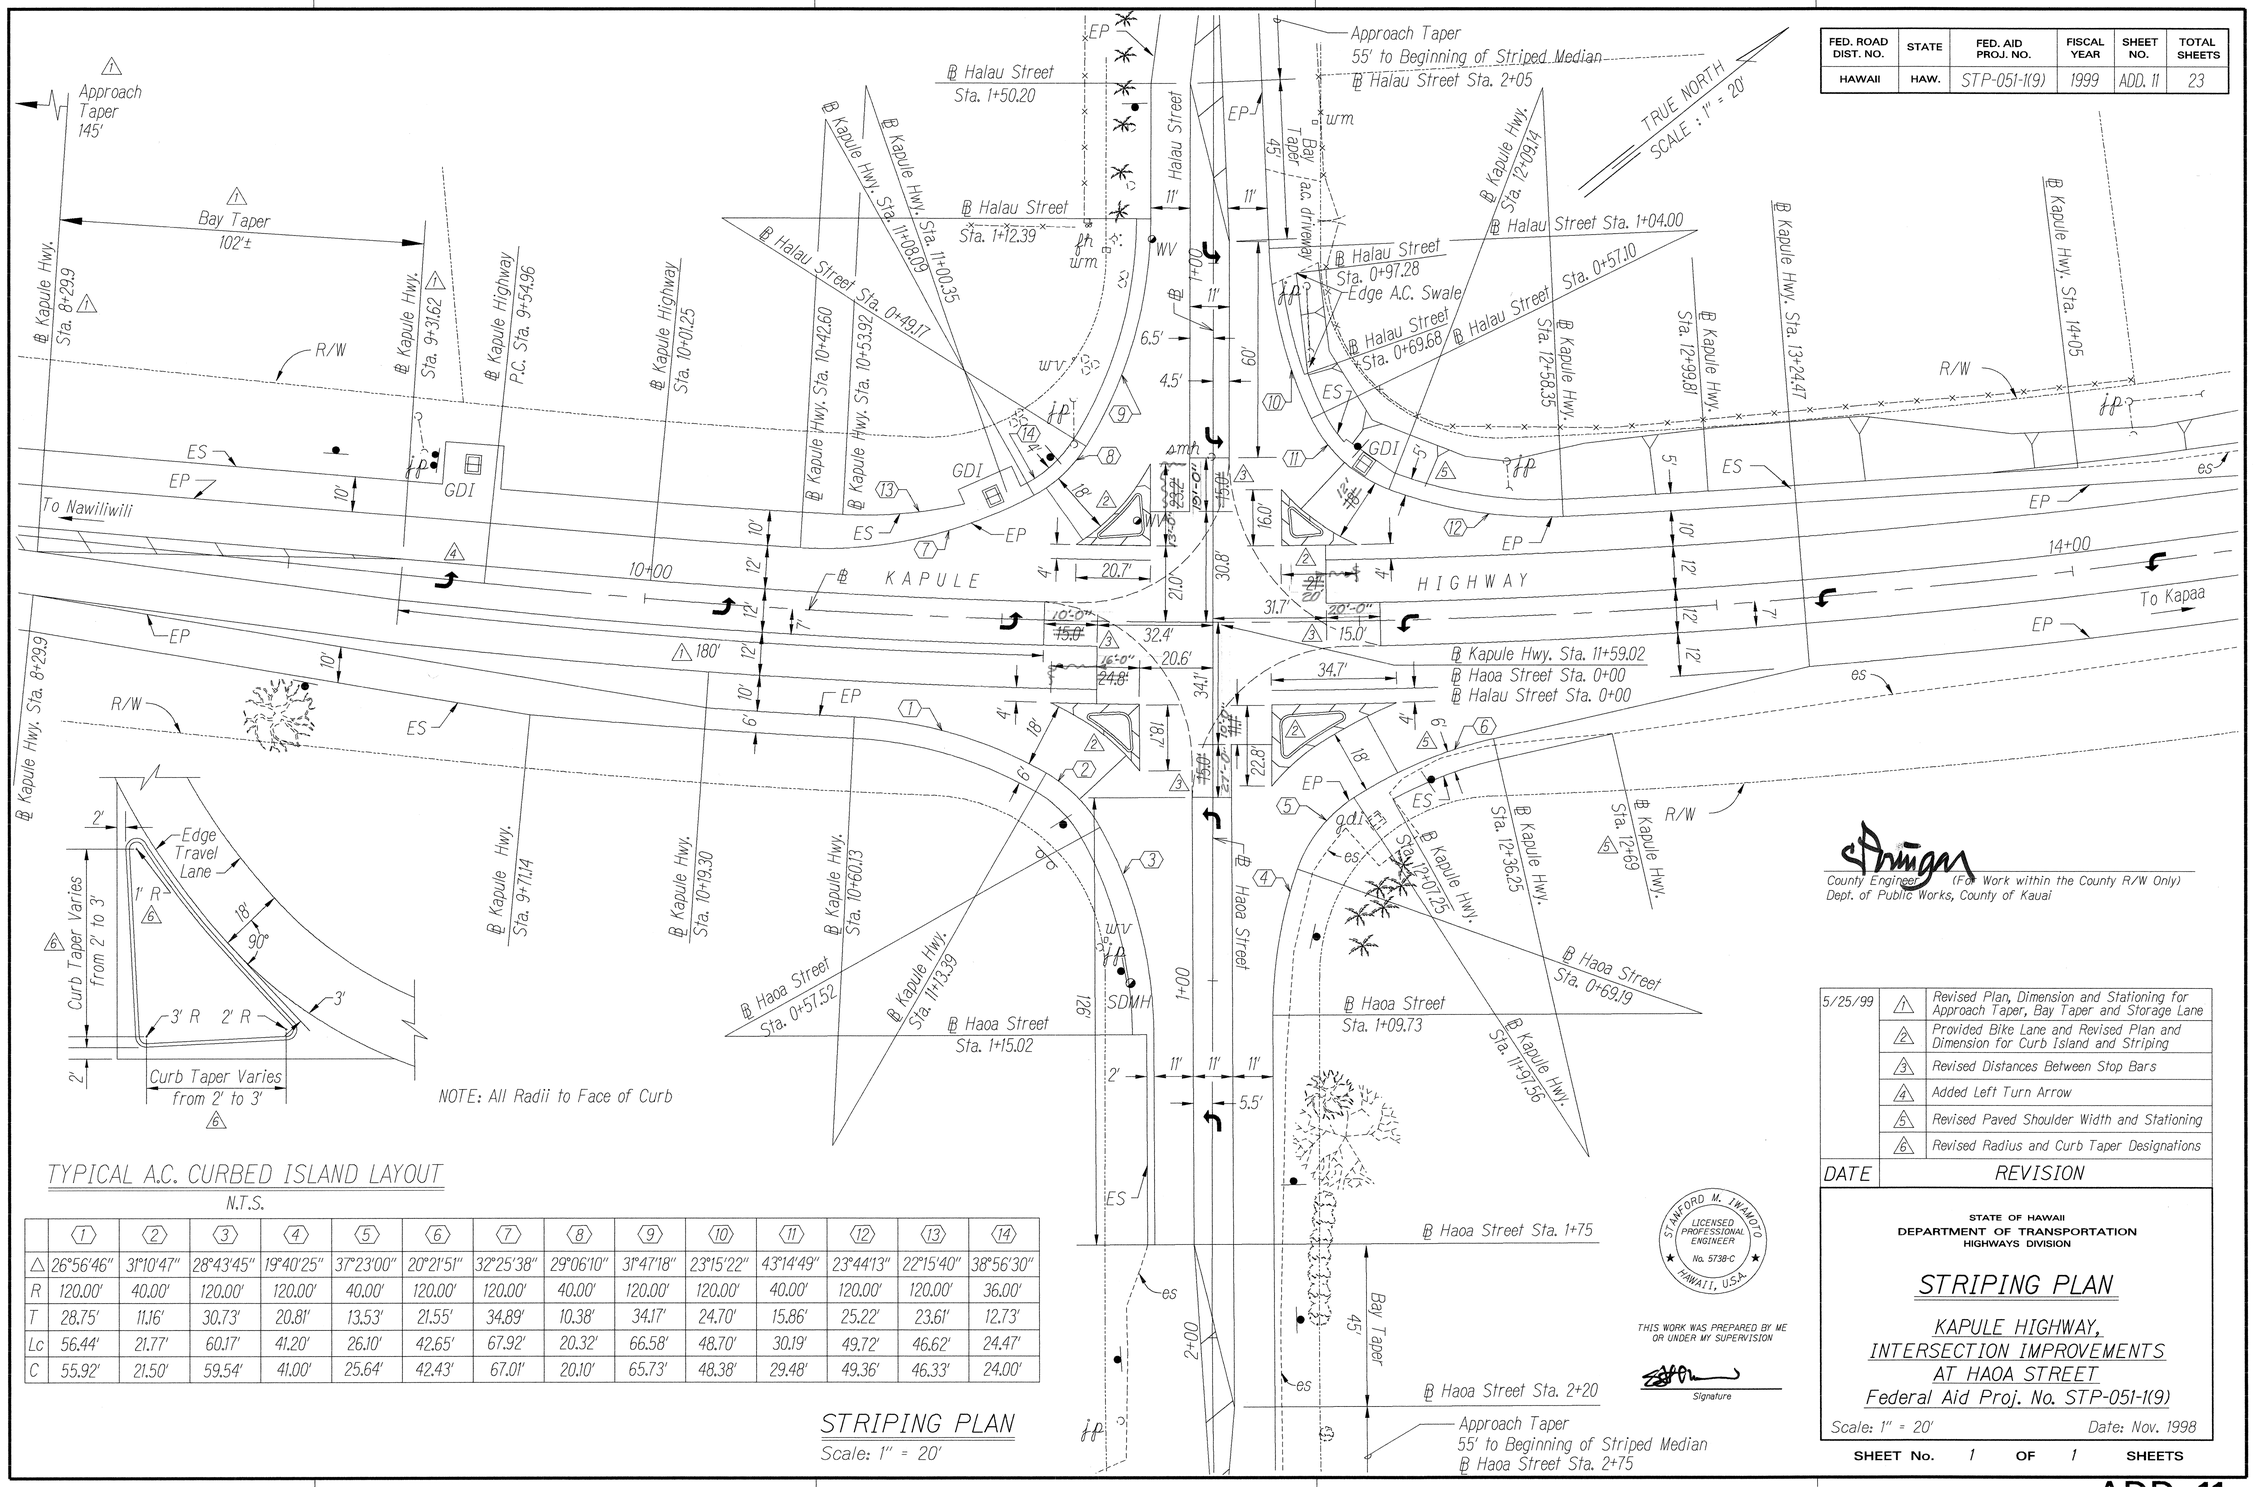

TYPICAL A.C. CURBED ISLAND LAYOUT

N.T.S.

	1	2	3	4	5	6	7	8	9	10	11	12	13	14
△	26°56'46"	31°10'47"	28°43'45"	19°40'25"	37°23'00"	20°21'51"	32°25'38"	29°06'10"	31°47'18"	23°15'22"	43°14'49"	23°44'13"	22°15'40"	38°56'30"
R	120.00'	40.00'	120.00'	120.00'	40.00'	120.00'	120.00'	40.00'	120.00'	120.00'	40.00'	120.00'	120.00'	36.00'
T	28.75'	11.16'	30.73'	20.81'	13.53'	21.55'	34.89'	10.38'	34.17'	24.70'	15.86'	25.22'	23.61'	12.73'
Lc	56.44'	21.77'	60.17'	41.20'	26.10'	42.65'	67.92'	20.32'	66.58'	48.70'	30.19'	49.72'	46.62'	24.47'
C	55.92'	21.50'	59.54'	41.00'	25.64'	42.43'	67.01'	20.10'	65.73'	48.38'	29.48'	49.36'	46.33'	24.00'

STRIPING PLAN

Scale: 1" = 20'

County Engineer (For Work within the County R/W Only)
Dept. of Public Works, County of Kauai

DATE		REVISION
5/25/99	1	Revised Plan, Dimension and Stationing for Approach Taper, Bay Taper and Storage Lane
	2	Provided Bike Lane and Revised Plan and Dimension for Curb Island and Striping
	3	Revised Distances Between Stop Bars
	4	Added Left Turn Arrow
	5	Revised Paved Shoulder Width and Stationing
	6	Revised Radius and Curb Taper Designations

STANFORD M. IWAMOTO
LICENSED PROFESSIONAL ENGINEER
No. 5738-C
HAWAII, U.S.A.

THIS WORK WAS PREPARED BY ME OR UNDER MY SUPERVISION

Signature

STATE OF HAWAII
DEPARTMENT OF TRANSPORTATION
HIGHWAYS DIVISION

STRIPING PLAN

KAPULE HIGHWAY, INTERSECTION IMPROVEMENTS AT HAOA STREET

Federal Aid Proj. No. STP-051-1(9)

Scale: 1" = 20' Date: Nov. 1998

SHEET No. 1 OF 1 SHEETS

ORIGINAL PLAN
SURVEY PLOTTED BY DATE
DRAWN BY DATE
TRACED BY DATE
DESIGNED BY DATE
NOTE BOOK QUANTITIES BY DATE
No. CHECKED BY DATE

ADD. 11