FED. ROAD DIST. NO.	STATE	PROJ. NO.	FISCAL YEAR	SHEET NO.	TOTAL SHEETS
HAWAII	HAW.	51B-01-00M	2000	15	23

Install Metal Guardrail, Type 3, Single, w/ Rubrail on Special Strong Post (75 Lin. Ft.) Install Special Strong Post on Concrete Foundation. See Details on Sheet 8 S-1.
Remove Existing AC Curb Where Necessary. After Guardrail Installation, Reconstruct AC Curbing.

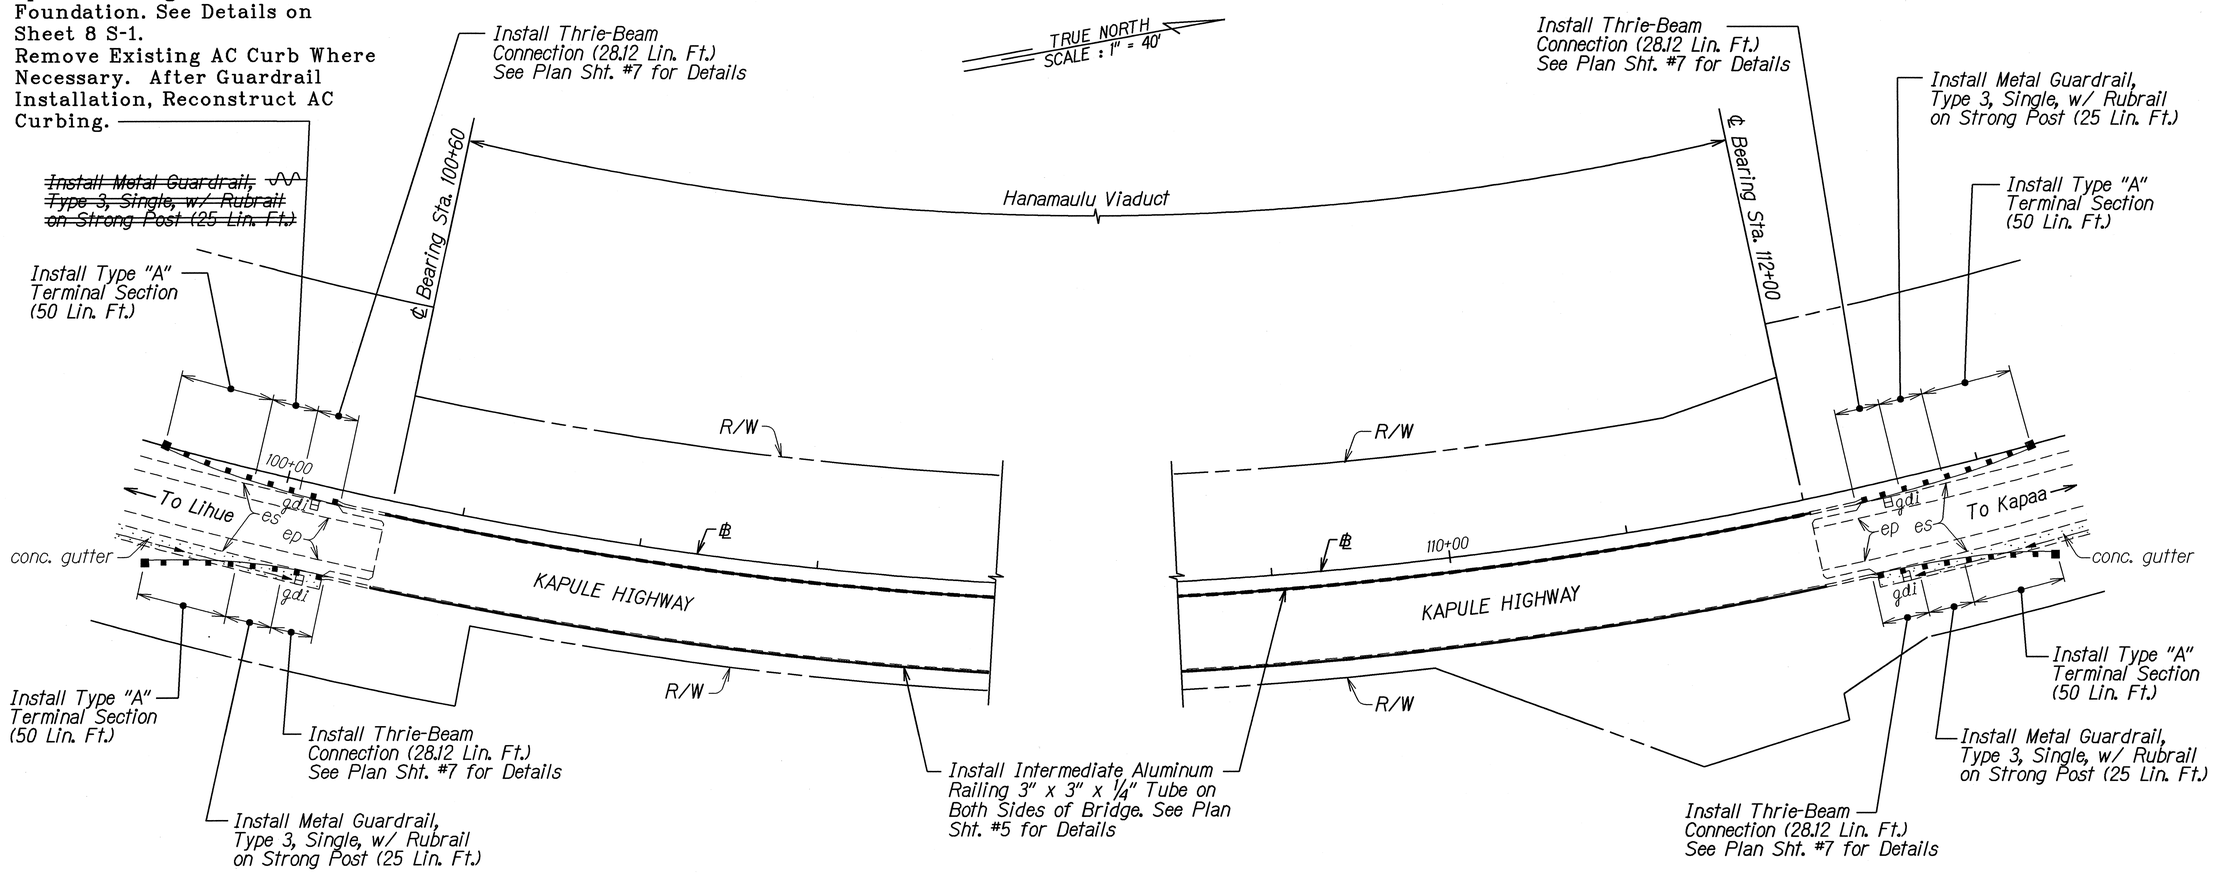

NOTE: Prior to installing new guardrail systems, remove and dispose of all existing guardrails and posts, including anchor bolts, nuts, washers, plates and other hardwares and appurtenances; concrete foundations and/or anchor blocks; and connections to bridge end posts. Removal and disposal of the abovementioned shall not be paid for separately, but shall be considered incidental to the various contract Items under Section 606 - Guardrail.

ORIGINAL PLAN	SURVEY PLOTTED BY	DATE 12-15-99
	DRAWN BY R. Acob, Inc.	
	TRACED BY	
66luar21ate	DESIGNED BY R. Acob	
ssbuil15b-01-00m	QUANTITIES BY	
46pu00ssdgn	CHECKED BY	

STATE OF HAWAII
DEPARTMENT OF TRANSPORTATION
HIGHWAYS DIVISION

PLAN - HANAMAULU VIADUCT

KAPULE HIGHWAY,
MISCELLANEOUS IMPROVEMENTS
Vicinity of Ahukini Road to Kuhio Highway
Project No. 51B-01-00M

Scale: 1" = 40' Date: December, 1999

SHEET No. 1 OF 1 SHEETS

"AS-BUILT"