FED. ROAD DIST. NO.	STATE	FED. AID PROJ. NO.	FISCAL YEAR	SHEET NO.	TOTAL SHEETS
Hawaii	Haw	F12(14)	1945	1	20

INDEX TO DRAWINGS

SHEET NO.	DESCRIPTIONS
1	TITLE SHEET
2	TYPICAL SECTION
3-4	PLAN & PROFILE
5-6	STD. DETAILS
7	STD. BRIDGE DETAILS
8-17	BRIDGE DETAILS
18-20	CROSS SECTIONS

All changes made during construction have been shown in red on these tracings and checked by

Richard Ze Kheyuma
Resident Engineer
Date: June 14, 1949

TERRITORY OF HAWAII
TERRITORIAL HIGHWAY DEPARTMENT
HONOLULU - T.H.

PLANS OF
KAUAI BELT ROAD
BRIDGES IN KAPAA SECTION
FEDERAL AID PROJECT NO. F12(14)
KAWAIHAU DISTRICT
ISLAND OF KAUAI

CONVENTIONAL SIGNS

- Centerline — 155
- Boundary Lines — or,
- Fences (Noted) — or,
- Existing Roadway
- Box Culvert
- Circular Culvert
- Bridge
- Railroad — or,
- Telephone Pole — TP
- Electric Line Pole — EP
- Fire Hydrant — FH
- Warning & Regulatory Signs — Type
- Centerline Monument

SCALE

PLAN	1 INCH =	50 FT.
PROFILE	HOR. 1 INCH =	50 FT.
	VER. 1 INCH =	5 FT.
X-SECTION	HOR. 1 INCH =	5 FT.
	VER. 1 INCH =	5 FT.

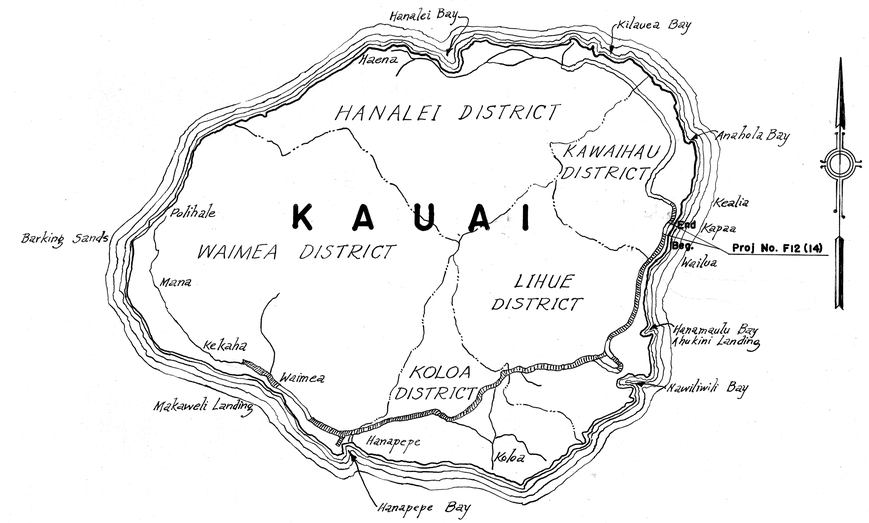

Federal Aid Projects previously constructed.

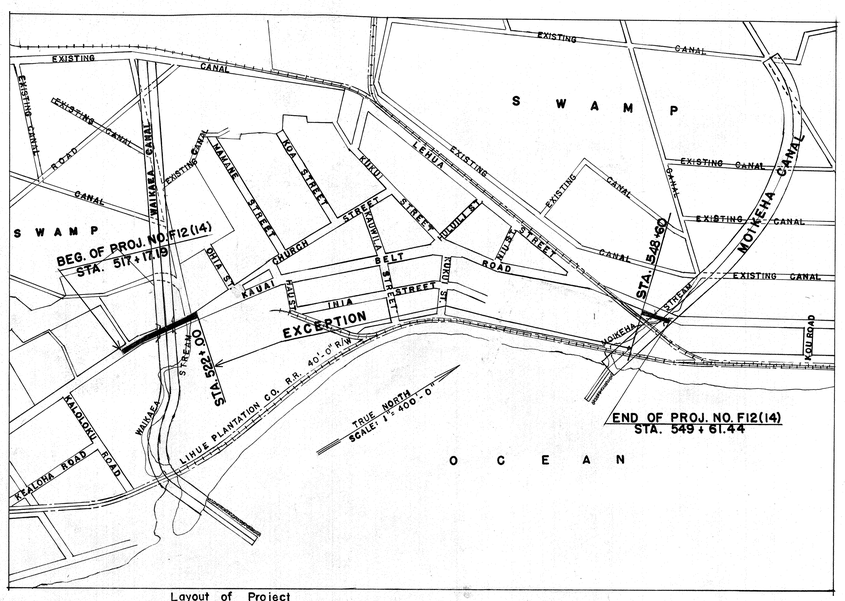

Layout of Project	
Gross Length of Project	0.615 mi.
Exception	0.504 "
Net Length of Project	0.111 "
Bridges over 20 feet Span	0.031 "
Net Length of Roadway	0.080 "

Revised : 5/3/46

ORIGINAL PLAN	SURVEYS PLOTTED BY	DATE
	DRAWN UP BY	"
	DRAWN BY	"
	TRACED BY	"
NOTE BOOK	QUANTITIES BY	"
	QUANTITIES CHECKED BY	"
No.	CHECKED BY	"

RECOMMENDED FOR APPROVAL
[redacted]
DISTRICT ENGINEER
Public Roads Administration
Federal Works Agency

RECOMMENDED FOR APPROVAL
[redacted]
CHIEF: WESTERN REGION
Public Roads Administration
Federal Works Agency

APPROVED
[redacted]
COMMISSIONER
Public Roads Administration
Federal Works Agency

APPROVED

APPROVED
Territorial Highway Engineer
Date: Jan. 8, 1946

5188.1

K & E CO., N. Y.
HALF TRACING CLOTH
PRINTED ON

DD-C-9