FED. ROAD DIST. NO.	STATE	FED. AID PROJ. NO.	FISCAL YEAR	SHEET NO.	TOTAL SHEETS
Hawaii	Haw	F12(18)	1950	1	26

L-10

INDEX TO DRAWINGS	
SHEET Nº	DESCRIPTIONS
1	Title Sheet
2-3	Typical Sections
4-19	PLAN & PROFILE
20-22	STANDARD DETAILS
23	GUTTER DETAIL - STA. 390± 27
24-26	CROSS SECTIONS

TERRITORY OF HAWAII

TERRITORIAL HIGHWAY DEPARTMENT

HONOLULU T. H.

PLANS OF

KAUAI BELT ROAD

(WIDENING AND RESURFACING)

FEDERAL AID PROJECT NO. F 12 (18)

DISTRICTS OF LIHUE AND KAWAIHAU

ISLAND OF KAUAI

SCALES

PLAN _ _ _ _ _ _ _ _ 1 INCH = 100 FEET

PROFILE HOR. _ _ 1 INCH = 100 FEET

VERT. _ _ 1 INCH = 20 FEET

CROSS SECTION _ _ 1 INCH = 10 FEET

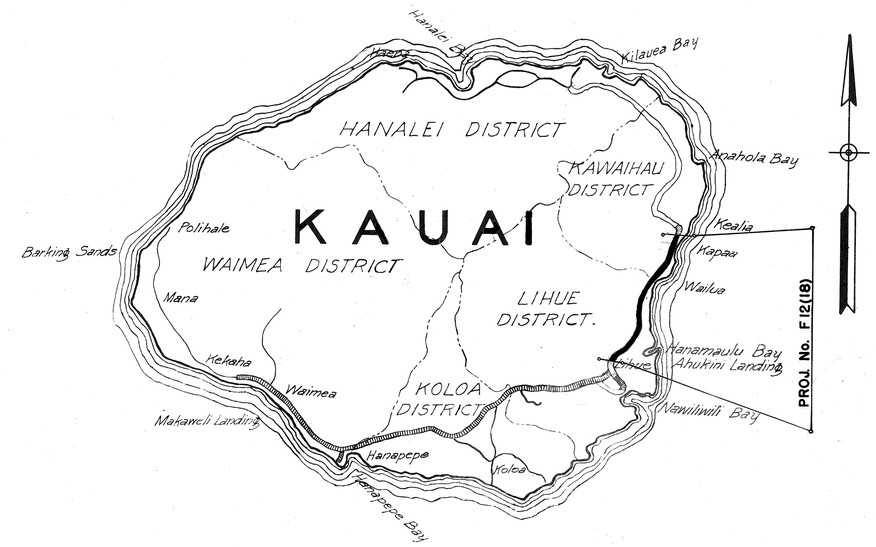

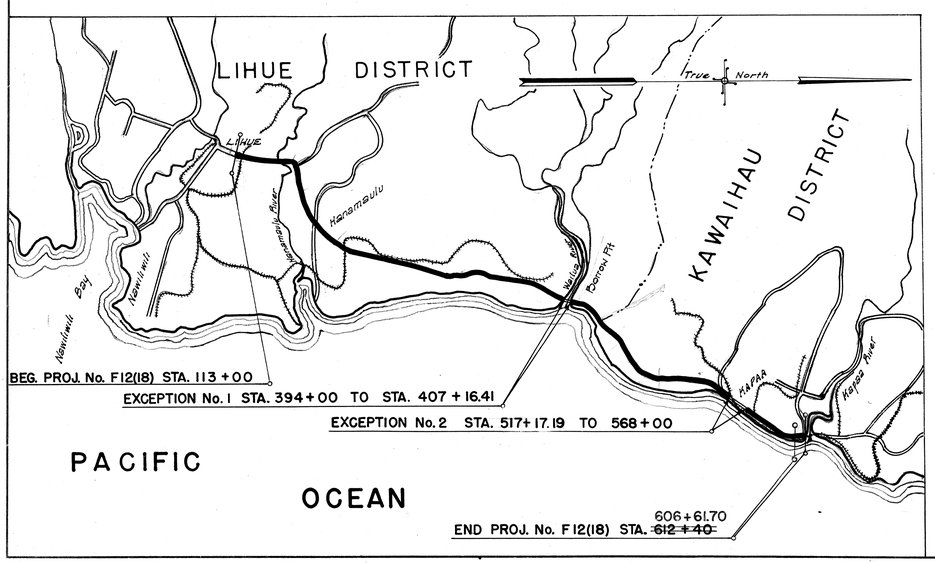

NOTE:
ALL CHANGES MADE DURING CONSTRUCTION HAVE BEEN NOTED IN RED ON THESE TRACINGS AND CHECKED BY:

Fred C. Blanchard
RESIDENT ENGINEER

4-28-52
DATE

LAYOUT OF PROJECT
SCALE - 1:62500

EXCEPTION NO. 1	=	0.249 Mi.	GROSS LENGTH	= ~~9.366~~ Mi.	9.256
EXCEPTION NO. 2	=	0.963 Mi.	TOTAL EXCEPTIONS	= 1.212 Mi.	
TOTAL	=	1.212 Mi.	LENGTH OF PROJECT	= ~~8.154~~ Mi.	8.044
			BRIDGES OVER 20'-0" SPAN	= 0.030 Mi.	
			NET LENGTH OF ROADWAY	= ~~8.124~~ Mi.	8.014

APPROVED: DATE 12-29-50

TERRITORIAL HIGHWAY ENGINEER

DEPARTMENT OF COMMERCE
BUREAU OF PUBLIC ROADS

RECOMMENDED FOR APPROVAL:

DISTRICT ENGINEER — DATE

APPROVED:

DIVISION ENGINEER — DATE

ORIGINAL PLAN		DATE
	SURVEY PLOTTED BY	
	DESIGNED BY	
	DRAWN BY	
	TRACED BY	
NOTE BOOK	QUANTITIES BY	
	QUANTITIES CHECKED BY	
No.	CHECKED BY	

5501.1