FED. ROAD DIST. NO.	STATE	FED. AID PROJ. NO.	FISCAL YEAR	SHEET NO.	TOTAL SHEETS
Hawaii	Haw	F 31(1)	1953	1	55

INDEX TO DRAWINGS

SHEET Nº	DESCRIPTIONS
1	Title Sheet
2	Typical Sections
3-9	Plan & Profile
10-17	Syphon Details
18-21	Culvert Details
22	Water Tunnel Details
23	Stairway Details
24-27	Standard Details
28-55	Cross Sections

TERRITORY OF HAWAII
TERRITORIAL HIGHWAY DEPARTMENT
HONOLULU T. H.

PLANS OF

KAUAI BELT ROAD

FEDERAL AID PROJECT NO. F 31 (I)

DISTRICT OF KAWAIHAU
ISLAND OF KAUAI

SCALES

PLAN		1 INCH = 100 FT.
PROFILE	HOR.	1 INCH = 100 FT.
	VER.	1 INCH = 10 FT.
CROSS SECTION	HOR.	1 INCH = 10 FT.
	VER.	1 INCH = 10 FT.

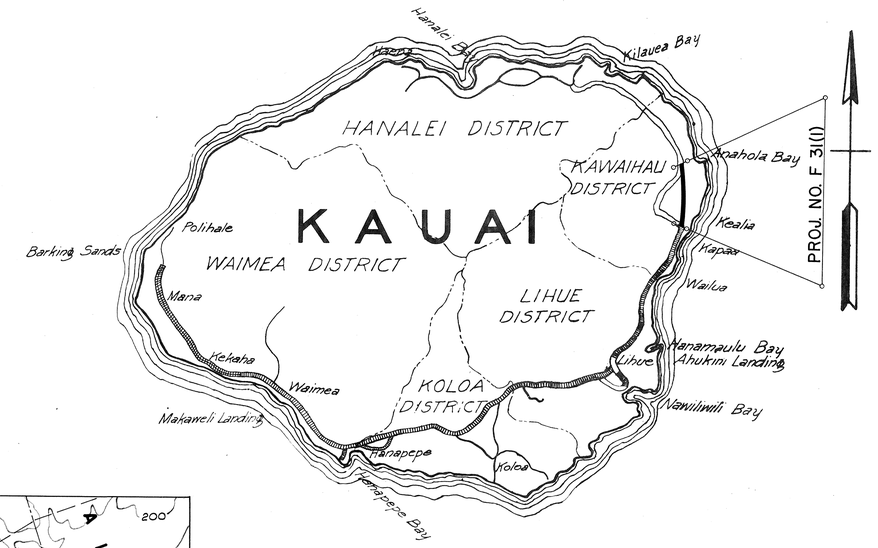

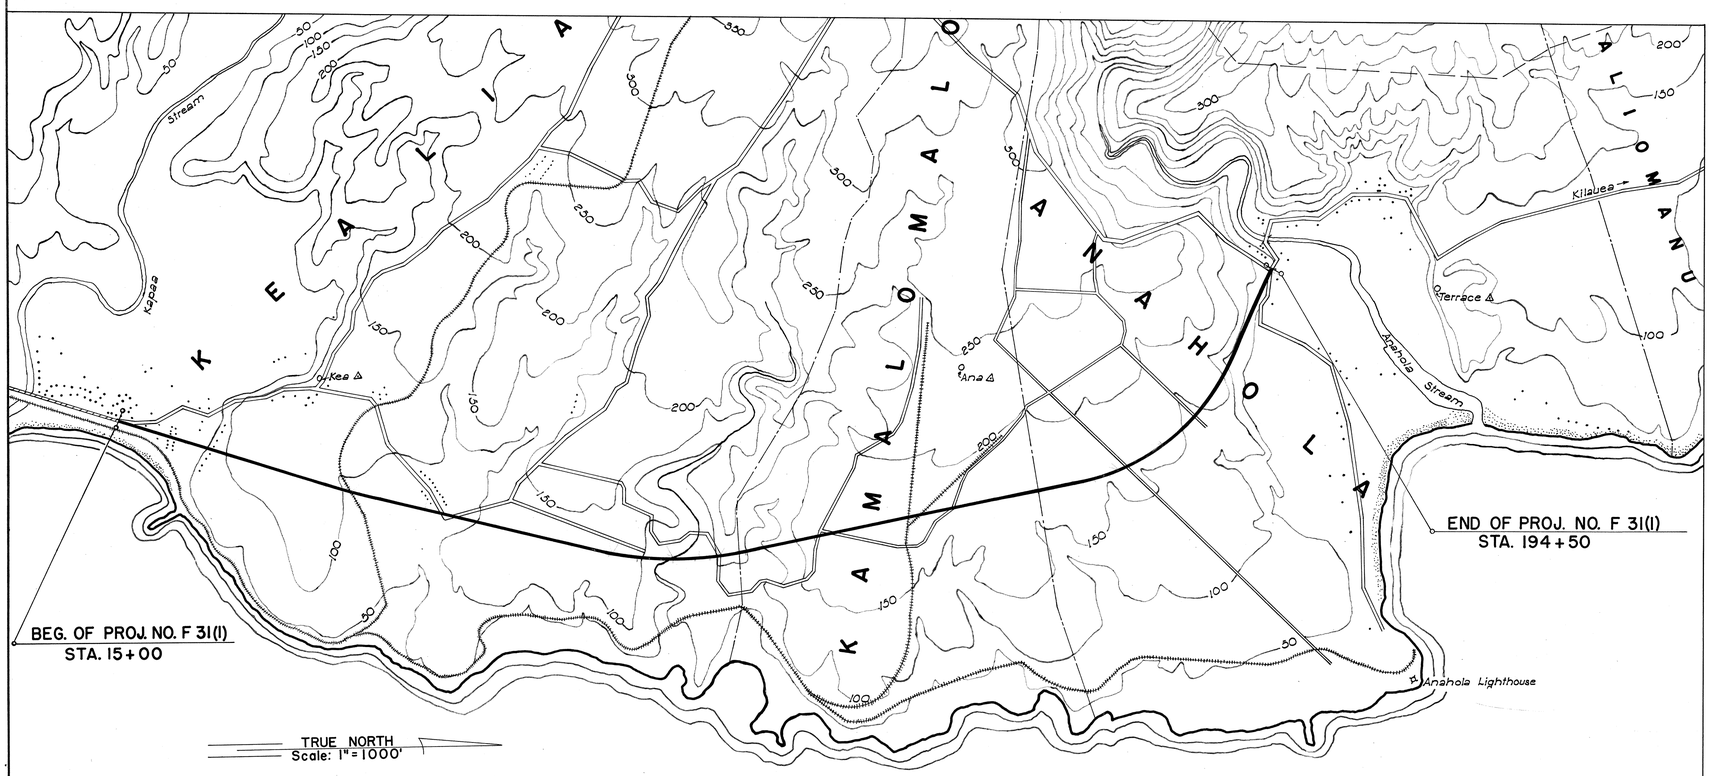

LAYOUT OF PROJECT
SCALE: 1" = 1000'

GROSS AND NET LENGTH OF ROADWAY = 3.400 MILES

NOTE

ALL CHANGES MADE DURING CONSTRUCTION HAVE BEEN NOTED IN RED ON THESE SHEETS AND CHECKED BY

Ed Nakano
PROJECT ENGINEER
12/23/54
DATE

APPROVED: DATE 2/10/55
B B Montgomery
TERRITORIAL HIGHWAY ENGINEER

DEPARTMENT OF COMMERCE
BUREAU OF PUBLIC ROADS
RECOMMENDED FOR APPROVAL:
DISTRICT ENGINEER DATE
APPROVED:
DIVISION ENGINEER DATE

ORIGINAL PLAN		DATE
	SURVEY PLOTTED BY	
	DESIGNED BY	
	DRAWN BY	
	TRACED BY	
NOTE BOOK	QUANTITIES BY	
	QUANTITIES CHECKED BY	
No.	CHECKED BY	

5593.1