FED. ROAD DIST. No.	STATE	FED. AID PROJ. No.	FISCAL YEAR	SHEET No.	TOTAL SHEETS
HAWAII	HAW.	S-0860(8) UNIT 2	1968	61	105

FINAL SURVEY — SURVEYED, PLOTTED, TYPED, NOTE BOOK, NO., DATE, BY, AREAS, AREAS CHECKED

ORIGINAL SURVEY — SURVEYED, PLOTTED, TYPED, NOTE BOOK, NO., DATE, BY, AREAS, AREAS CHECKED

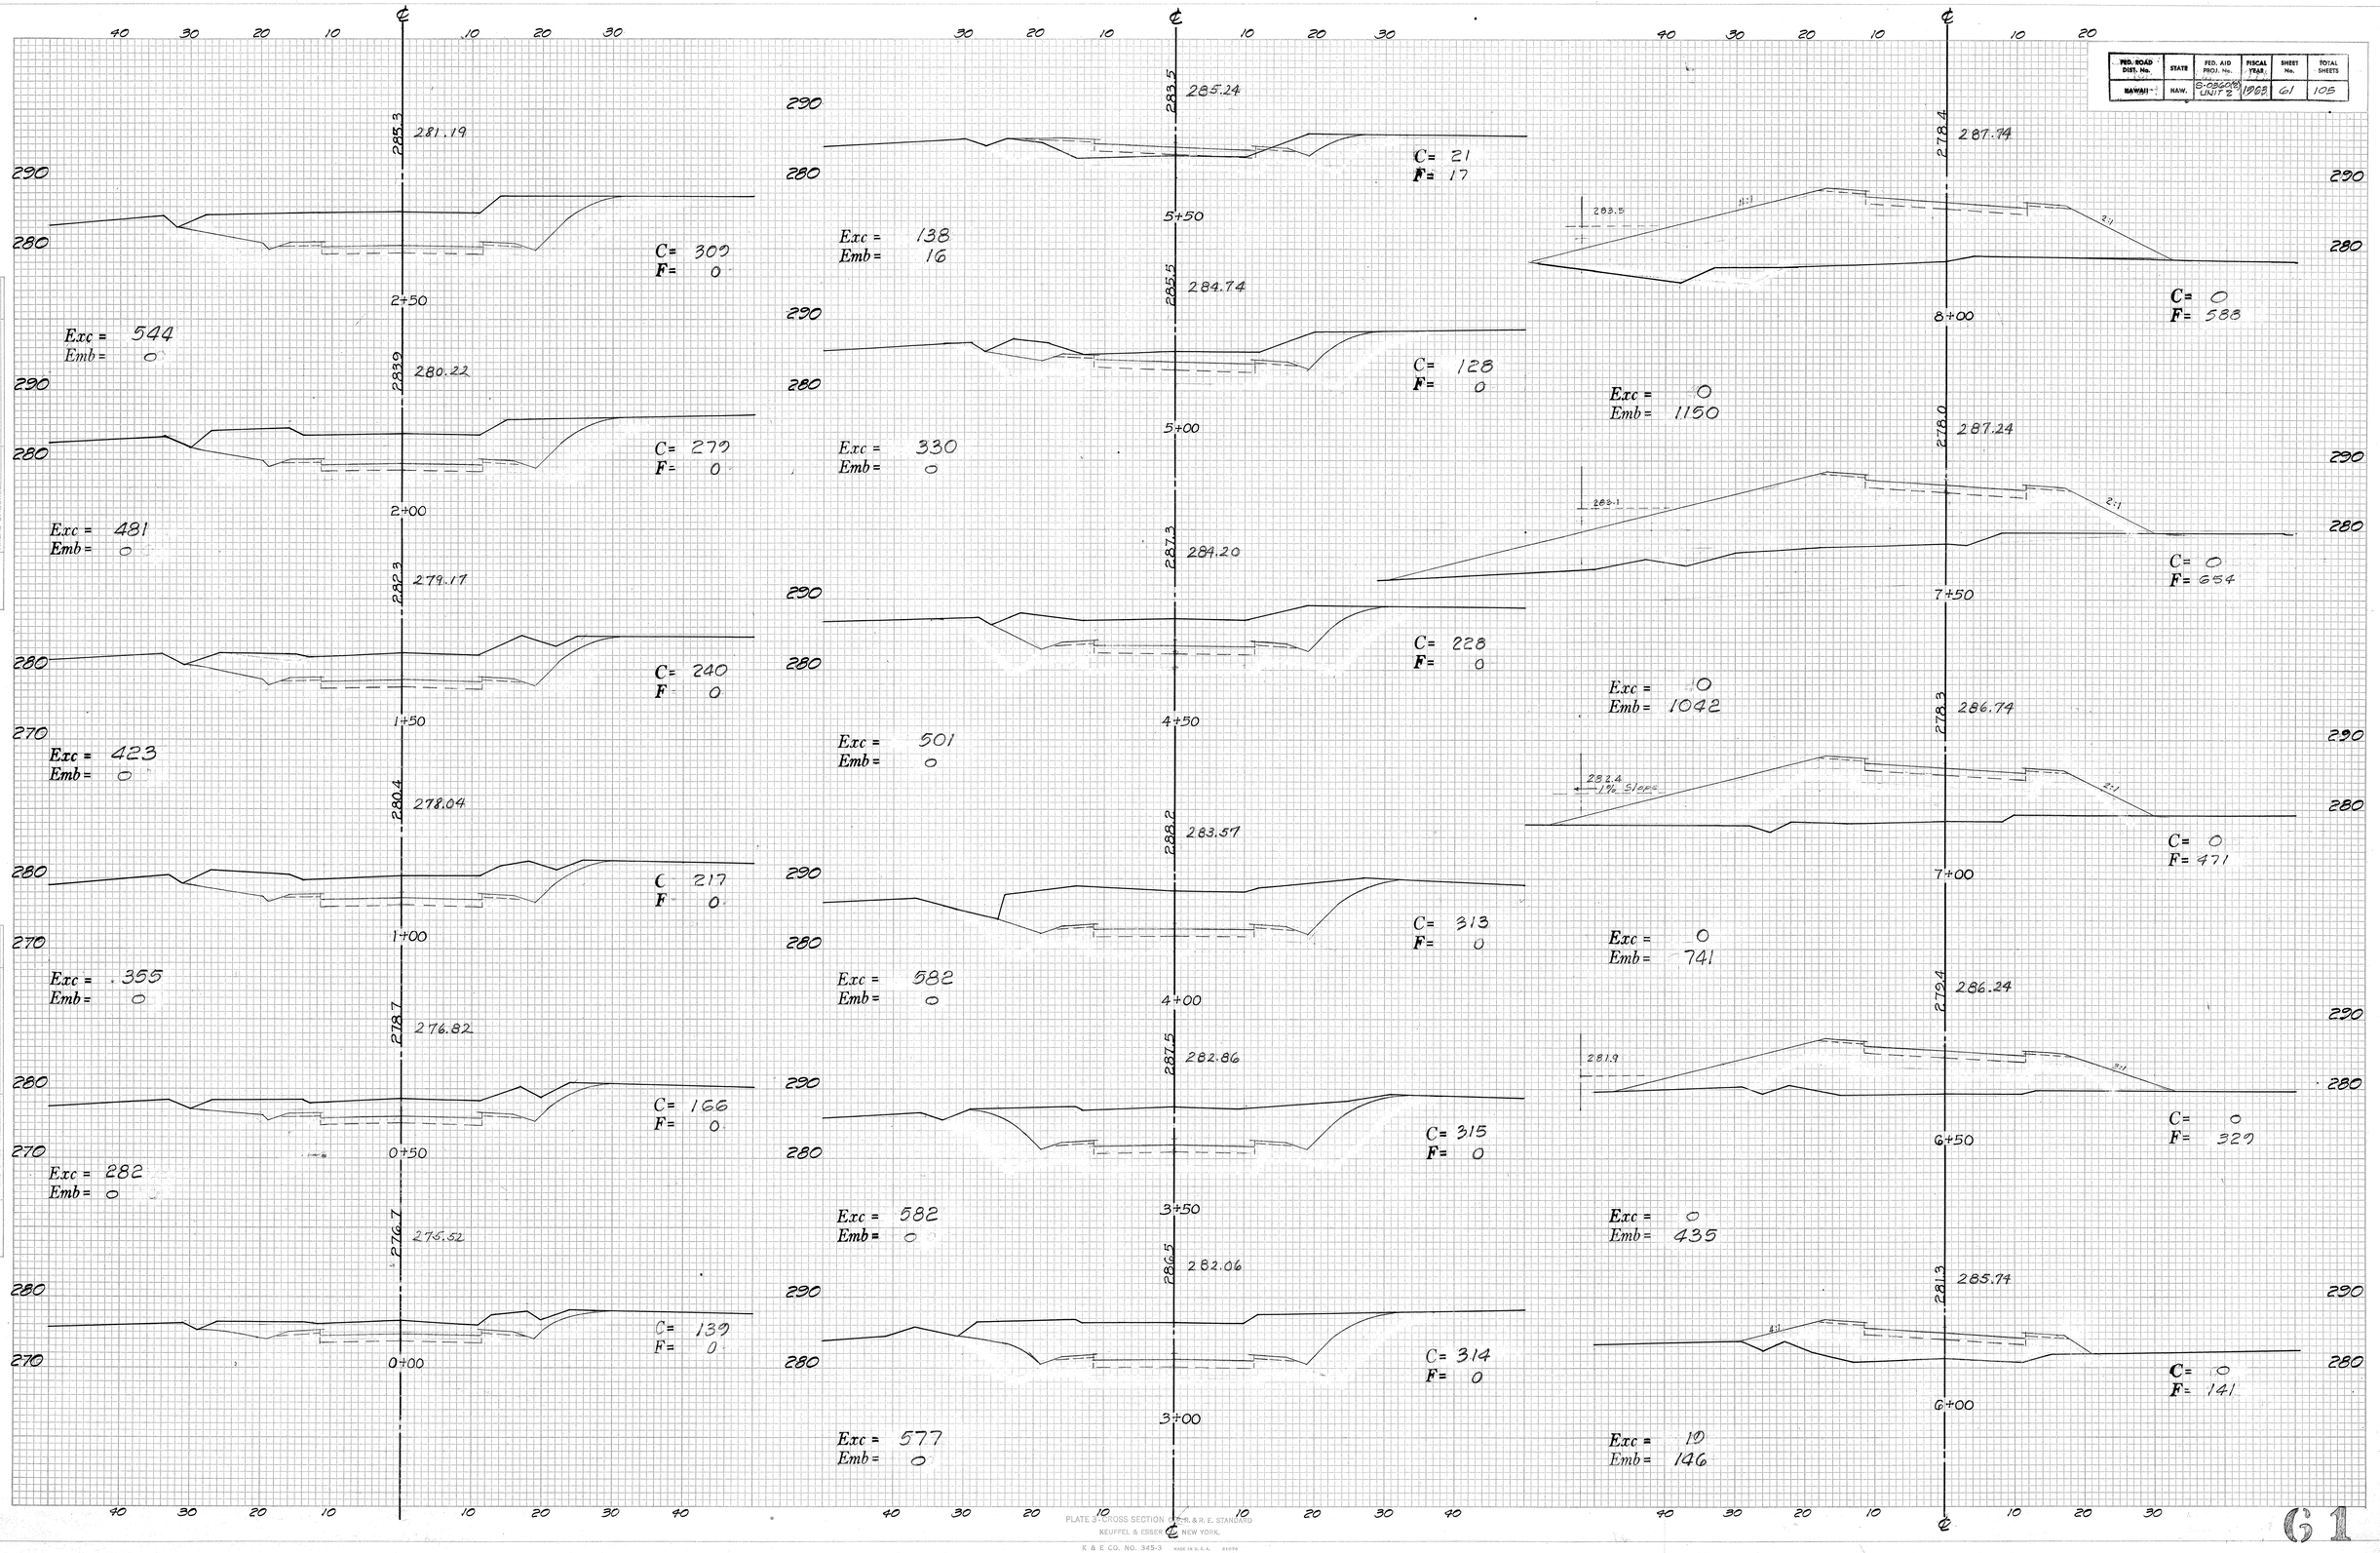

PLATE 3 CROSS SECTION
H. R. & R. E. STANSFIELD
KEUFFEL & ESSER ℄ NEW YORK.

K & E CO. NO. 345-3 MADE IN U.S.A. 21070

61

FED. ROAD DIST. No.	STATE	FED. AID PROJ. No.	FISCAL YEAR	SHEET No.	TOTAL SHEETS
HAWAII	HAW.	S-0860(10) UNIT 2	1963	62	105

FINAL SURVEY — NOTE BOOK — NO. — SURVEYED — PLOTTED — TRACED — AREAS — AREAS CHECKED — BY — DATE

ORIGINAL SURVEY — NOTE BOOK — NO. — SURVEYED — PLOTTED — TRACED — AREAS — AREAS CHECKED — BY — DATE

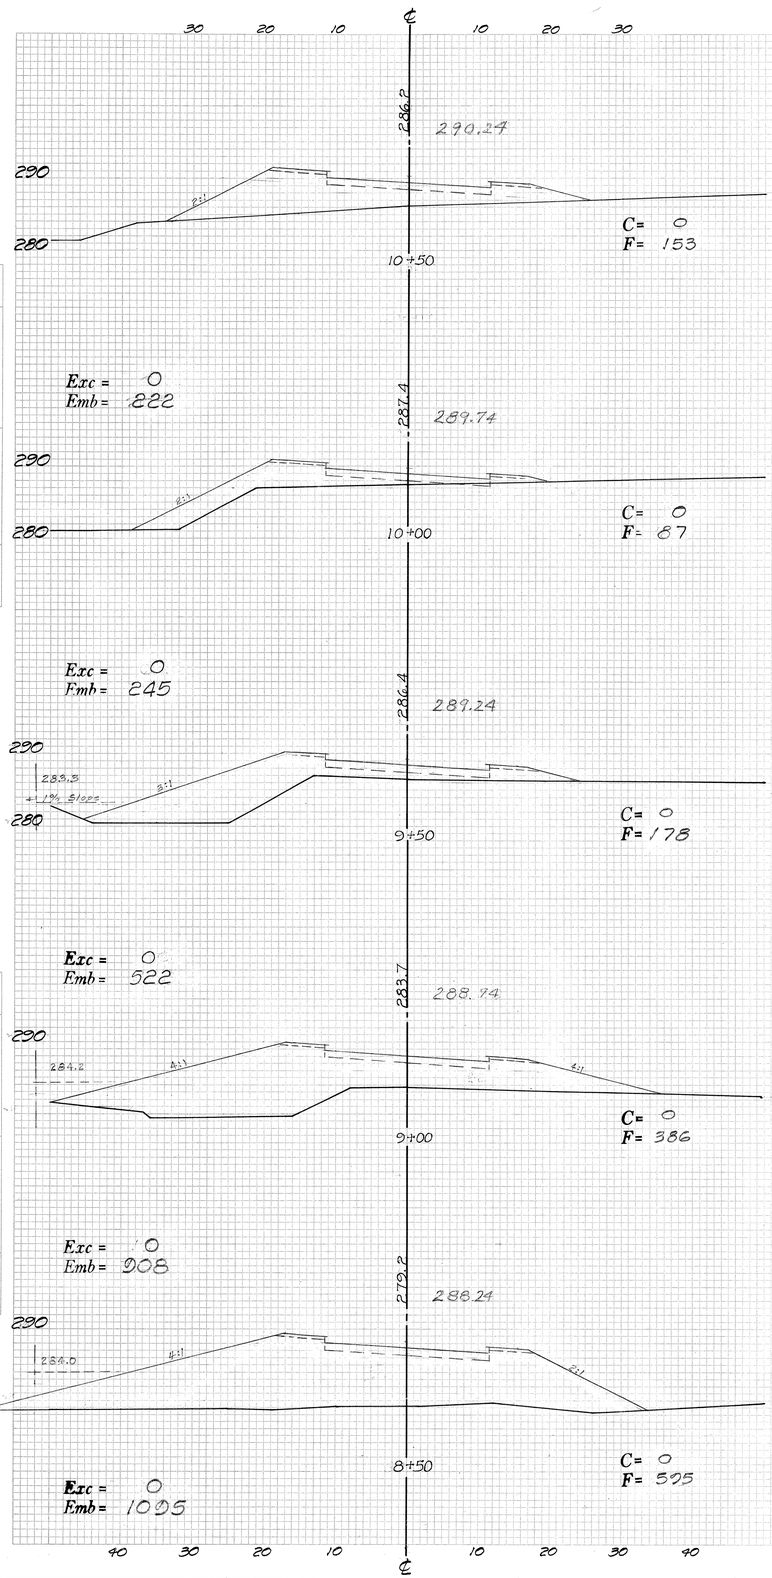

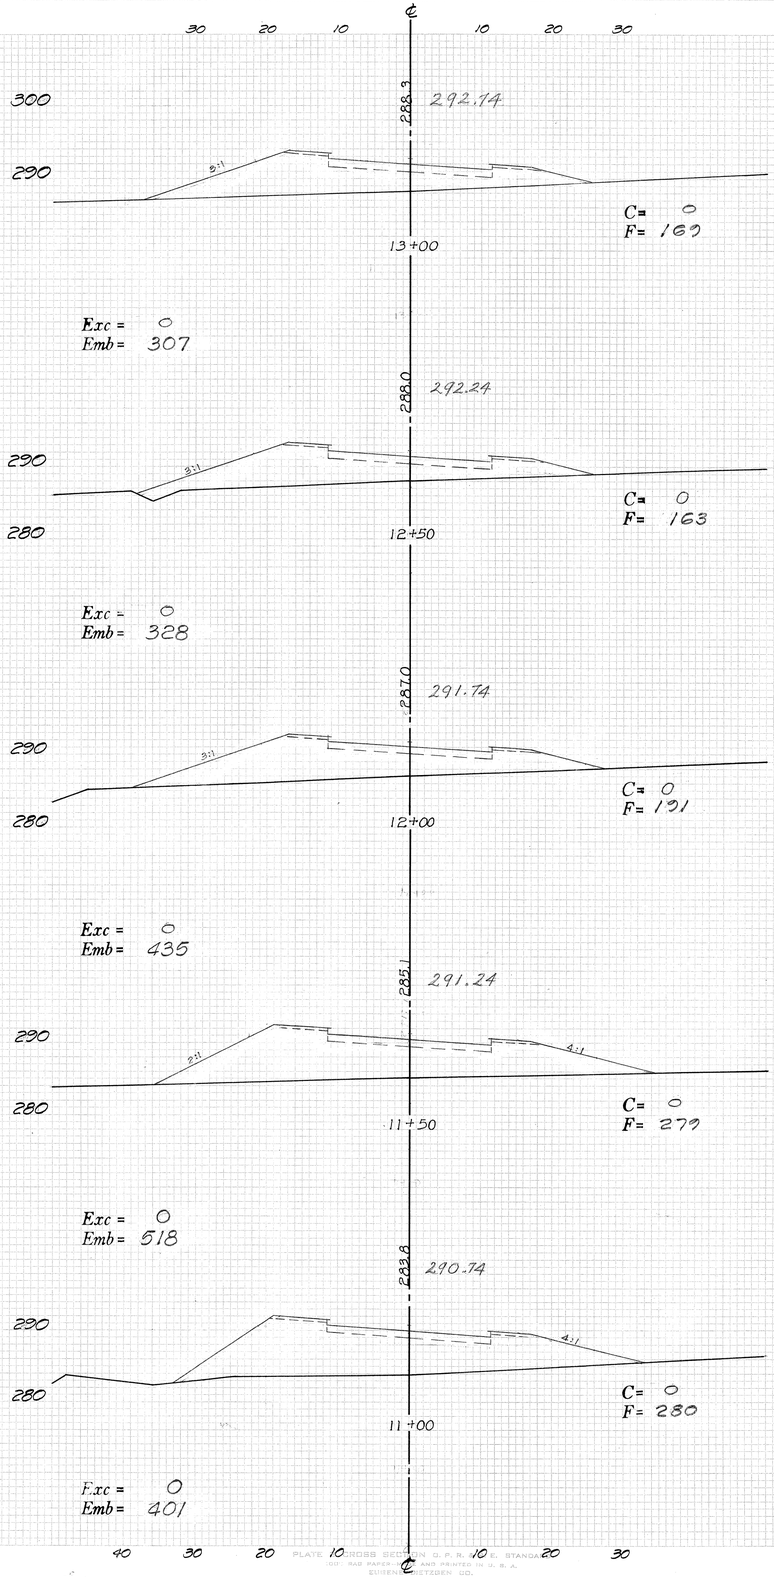

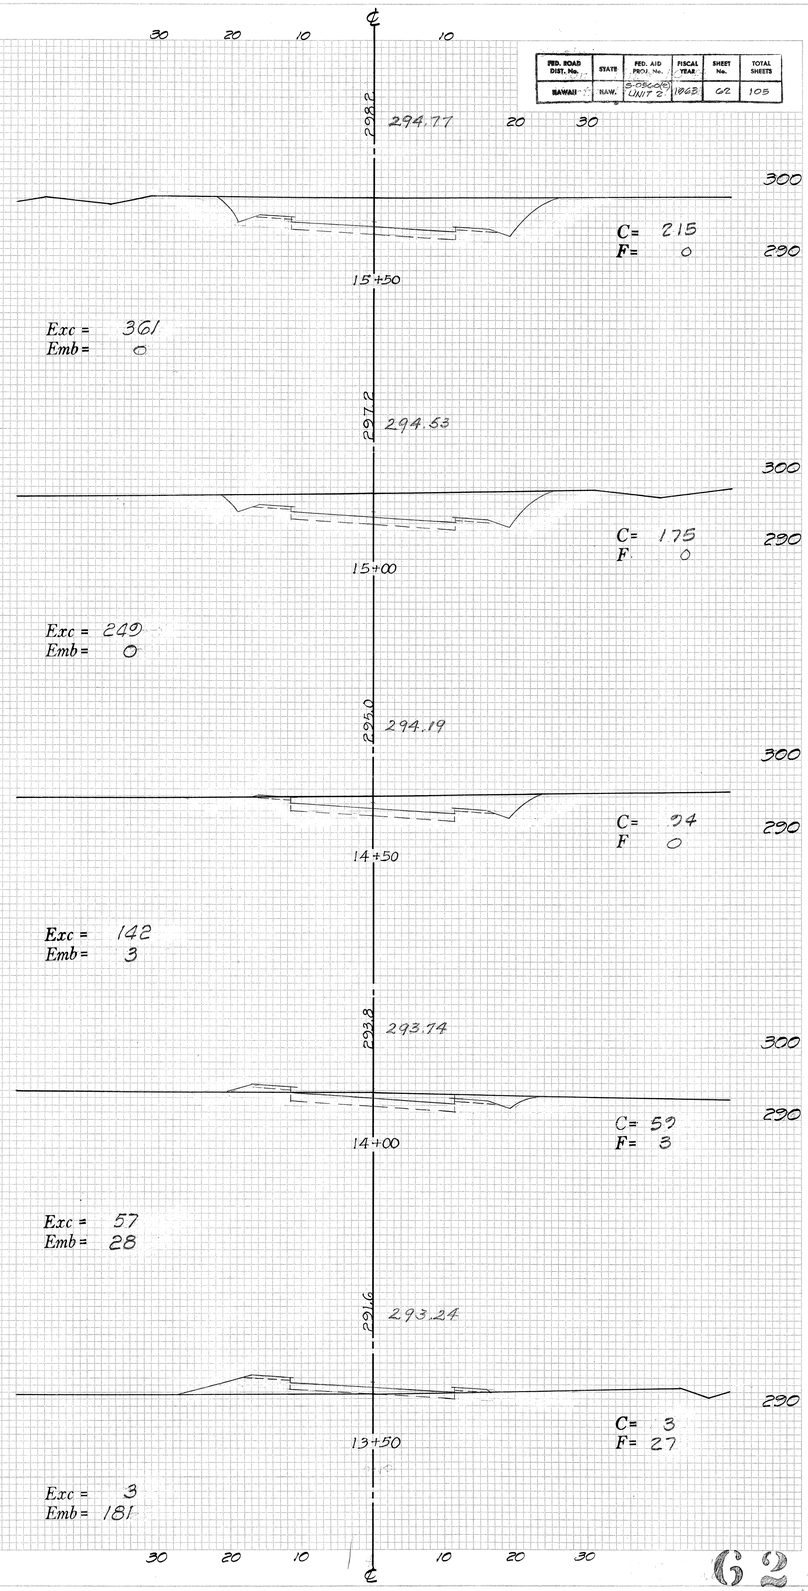

PLATE CROSS SECTION O. P. R. & E. STANDARD
100 RAG PAPER MADE AND PRINTED IN U. S. A.
EUGENE DIETZGEN CO.

62

FED. ROAD DIST. No.	STATE	FED. AID PROJ. No.	FISCAL YEAR	SHEET No.	TOTAL SHEETS
HAWAII	HAW.	S-056(7) UNIT B	1965	63	105

FINAL SURVEY — SURVEYED, OFFICE, TEMPLATE, AREAS, NOTE BOOK, NO., AREAS CHECKED, BY, DATE

ORIGINAL SURVEY — SURVEYED, OFFICE, TEMPLATE, AREAS, NOTE BOOK, NO., AREAS CHECKED, BY, DATE

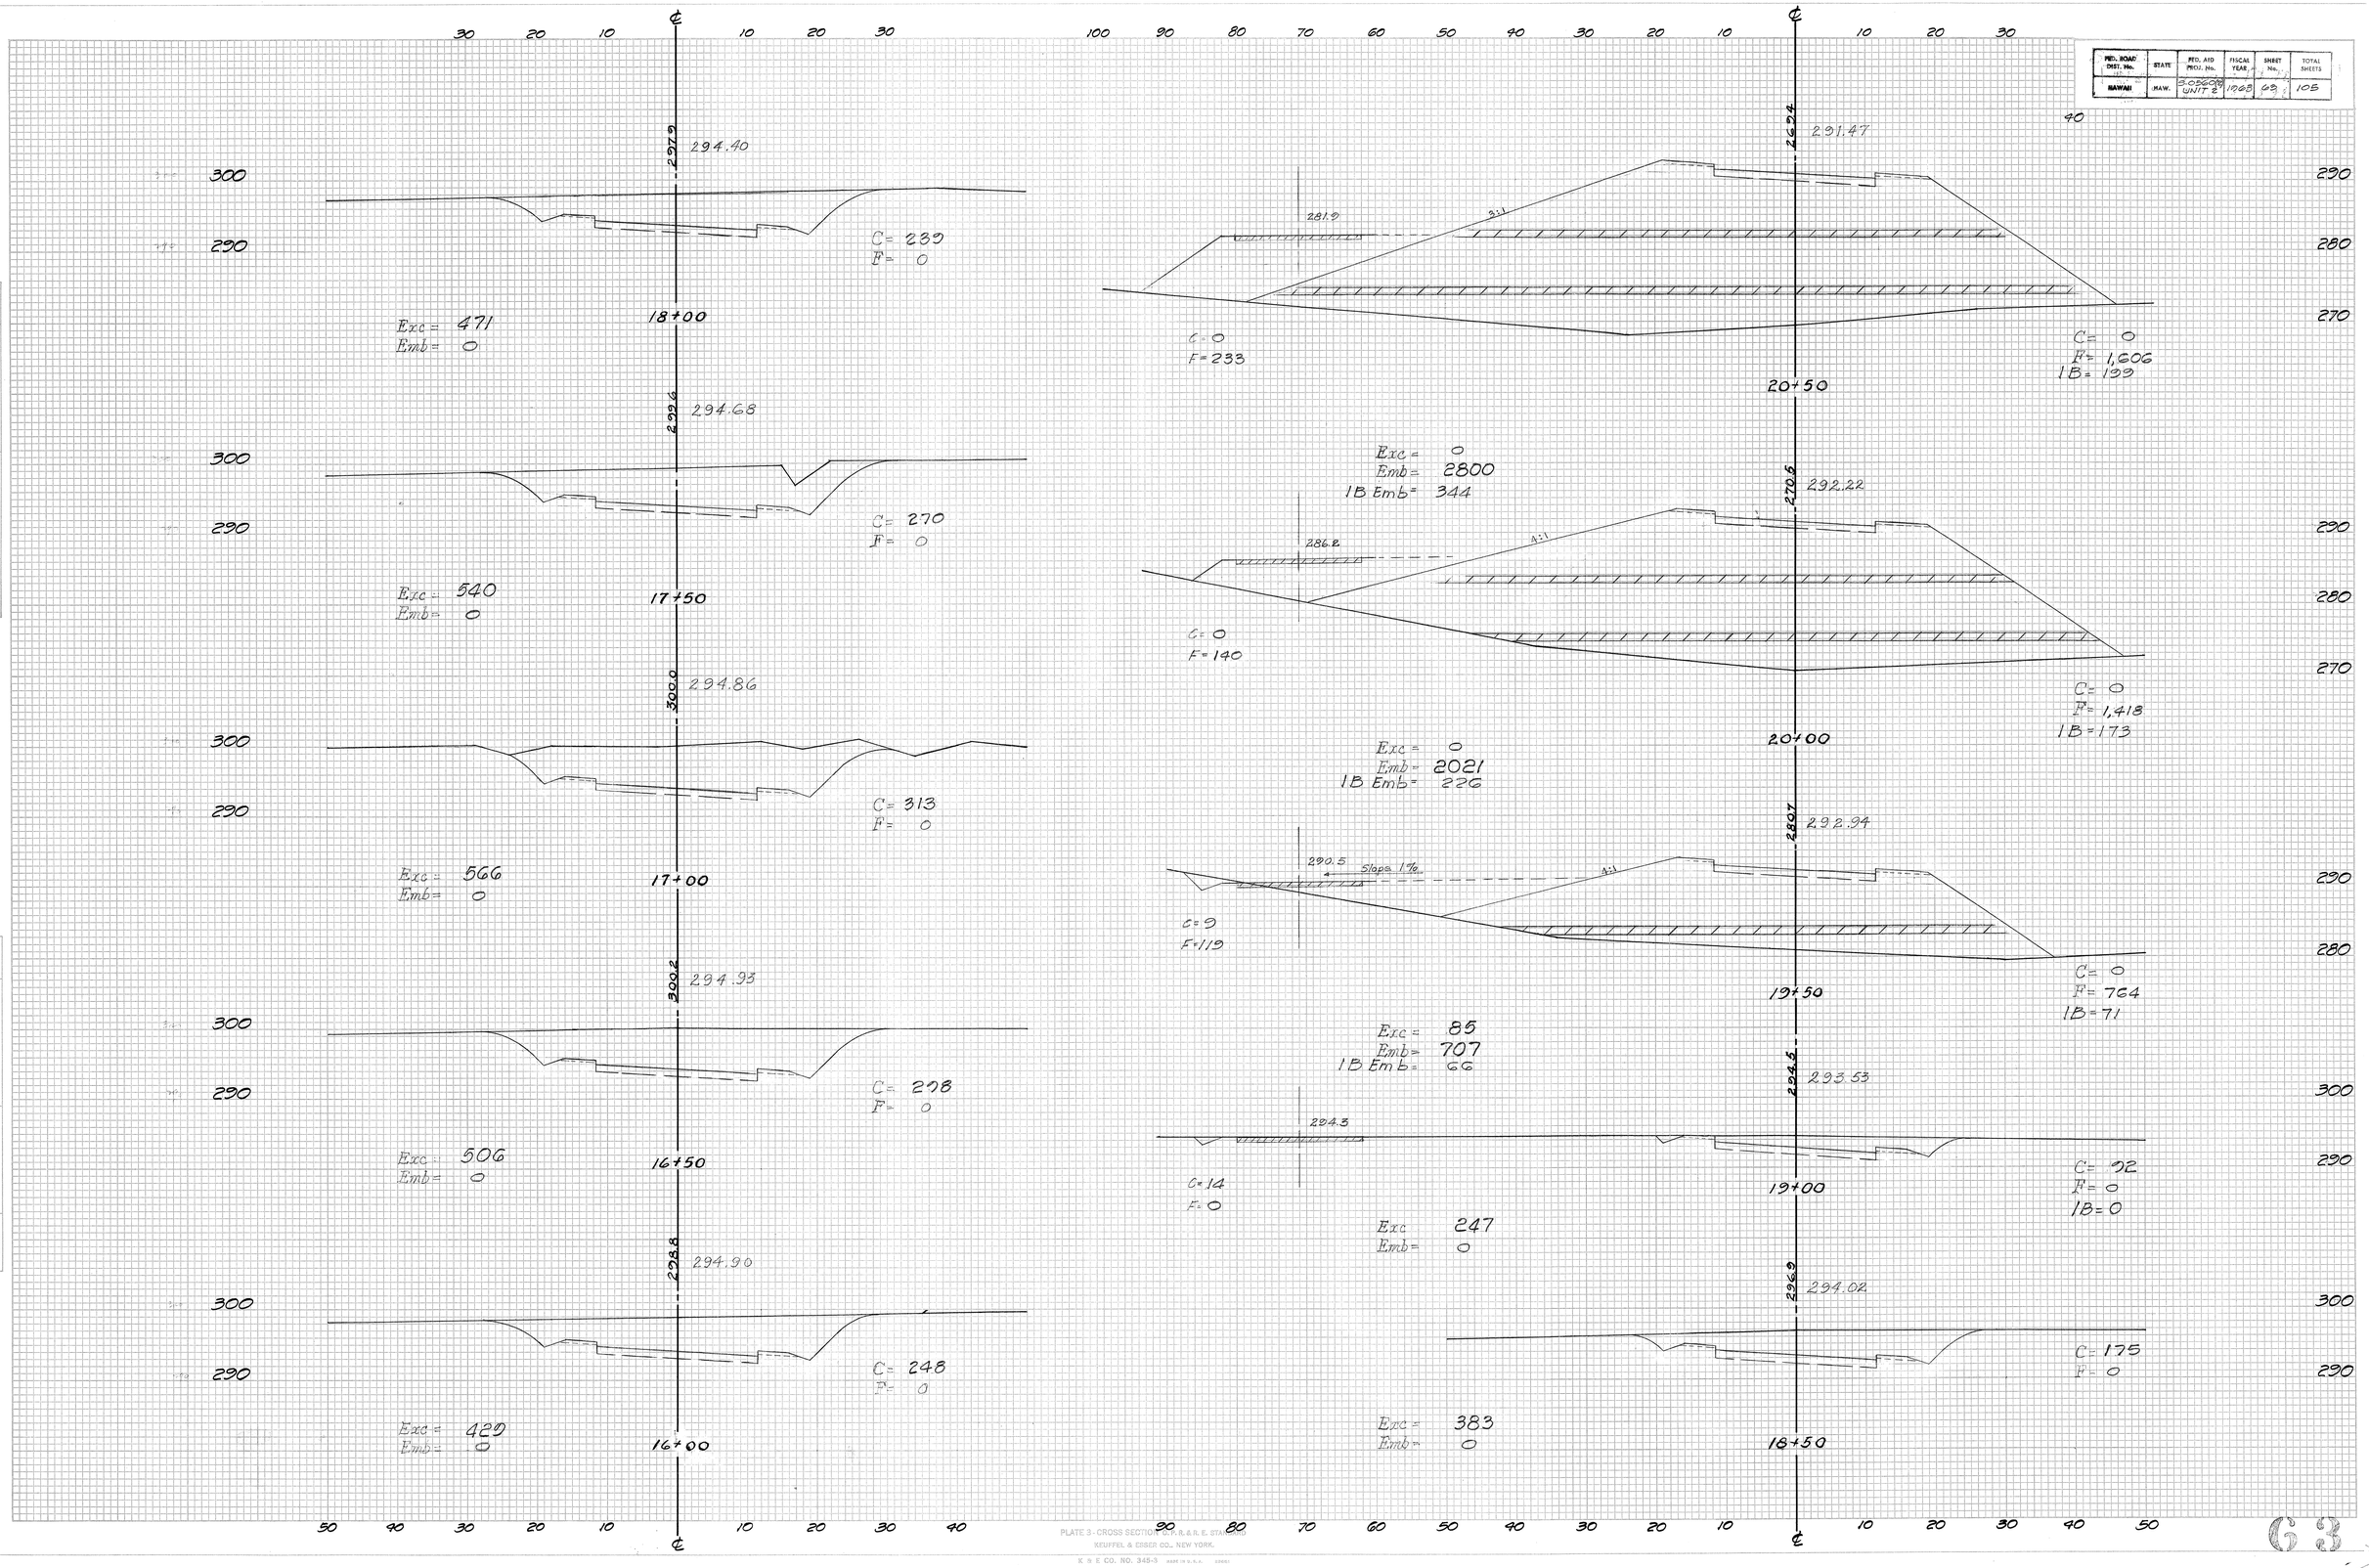

PLATE 3 - CROSS SECTIONS

U.S.B.R. E. STANDARD
KEUFFEL & ESSER CO., NEW YORK.
K & E CO. NO. 345-3 MADE IN U.S.A. 22661

FED. ROAD DIST. No.	STATE	FED. AID PROJ. No.	FISCAL YEAR	SHEET No.	TOTAL SHEETS
HAWAII	HAW.	S-0522(8) UNIT 2	1963	64	105

FINAL SURVEY — SURVEYED, PLOTTED, TEMPLATE, AREAS, AREAS CHECKED, NOTE BOOK, NO. — BY — DATE

ORIGINAL SURVEY — SURVEYED, PLOTTED, TEMPLATE, AREAS, AREAS CHECKED, NOTE BOOK, NO. — BY — DATE

60 50 40 30 20 10 ℄ 10 20 30

290 280 270

23+00 — 2803

289.04

4:1

C = 0
F = 464
1B = 29

Exc = 0
Emb = 1107
1B Emb = 20

22+50 — 2767

289.20

4:1

C = 0
F = 731
1B = 60

Exc = 0
Emb = 1409
1B Emb = 129

22+00 — 2752

289.55

2:1

260.1

C = 12
F = 1

C = 0
F = 784
1B = 88
BACKWARD

C = 0
F = 791
1B = 71
FORWARD

Exc = 0
Emb = 1681
1B Emb = 181

21+50 — 2733

290.04

273.4 slope 1%

C = 0
F = 1,031
1B = 108

C = 0
F = 270

Exc = 0
Emb = 2137
1B Emb = 231

21+00 — 2702

290.71

277.8

C = 0
F = 1,277
1B = 141

C = 0
F = 448

Exc = 0
Emb = 2670
1B Emb = 315

100 90 80 70 60 50 40 30 20 10 ℄ 10 20 30 40 50

PLATE 7 CROSS SECTIONS FOR R & R. E. STANDARD
KEUFFEL & ESSER CO., NEW YORK.

K & E CO. NO. 345-3 MADE IN U.S.A. 22061

64

FED. ROAD DIST. No.	STATE	FED. AID PROJ. No.	FISCAL YEAR	SHEET No.	TOTAL SHEETS
HAWAII	HAW.	S-0560(6) UNIT 2	1963	65	105

FINAL SURVEY — SURVEYED, PLOTTED, TEMPLATE, AREAS CHECKED, NOTE BOOK, NO., BY, DATE

ORIGINAL SURVEY — SURVEYED, PLOTTED, TEMPLATE, AREAS CHECKED, NOTE BOOK, NO., BY, DATE

30 20 10 ℄ 10 20 30
299.0 290.72
300 290
C= 478
F= 0
25+50
Exc = 857
Emb = 0

297.8 290.05
300 290
C=448
F= 0
25+00
Exc = 734
Emb = 0

296.0 289.55
300 290
C= 345
F= 0
24+50
Exc = 523
Emb = 0

293.1 289.21
300 290
C= 220
F= 0
24+00
Exc = 206
Emb = 108

286.2 289.05
290 280
C= 3
F= 117
IB = 0
23+50
Exc = 3
Emb = 538
IB Emb = 27

40 30 20 10 ℄ 10 20 30 40

40 30 20 10 ℄ 10 20 30
291.2 296.60
300 290
C= 0
F= 223
28+00
Exc = 109
Emb = 206

296.1 295.09
300 290
C= 118
F= 0
27+50
Exc = 425
Emb = 0

299.7 293.74
300 290
C= 341
F= 0
27+00
Exc = 733
Emb = 0

300.5 292.57
300 290
C= 451
F= 0
26+50
Exc = 858
Emb = 0

292.2 291.56
300 290
C= 476
F= 0
26+00
Exc = 883
Emb = 0

30 20 10 ℄ 10 20 30

40 30 20 10 ℄ 10 20
295.0 306.66
30
300 290
Inv. = 294.3
C= 10
F= 579
30+50
Exc = 44
Emb = 873

296.7 304.32
300 290
C= 38
F= 364
Inv. = 295.8
30+00
Exc = 87
Emb = 467

298.6 302.13
300 290
C= 56
F= 140
Inv. = 295.0
29+50
Exc = 103
Emb = 242

296.7 300.12
300 290
Inv. = 296.0
C= 55
F= 121
29+00
Exc = 56
Emb = 306

293.2 298.28
300 290
Inv. = 296.1
C= 6
F= 209
28+50
Exc = 6
Emb = 400

30 20 10 ℄ 10 20 30 40 50

PLATE 10 CROSS SECTION C. P. R. R. E. STANDARD
1931 - 11 x 17 PAPER - PRINTED IN U. S. A.
EUGENE DIETZGEN CO.

FED. ROAD DIST. No.	STATE	FED. AID PROJ. No.	FISCAL YEAR	SHEET No.	TOTAL SHEETS
HAWAII	HAW.	S-0560(8) UNIT 2	1963	66	105

FINAL SURVEY — NOTE BOOK NO. — SURVEYED — PLOTTED — TEMPLATE — AREAS — CROSS CHECKED — BY — DATE

ORIGINAL SURVEY — NOTE BOOK NO. — SURVEYED — PLOTTED — TEMPLATE — AREAS — CROSS CHECKED — BY — DATE

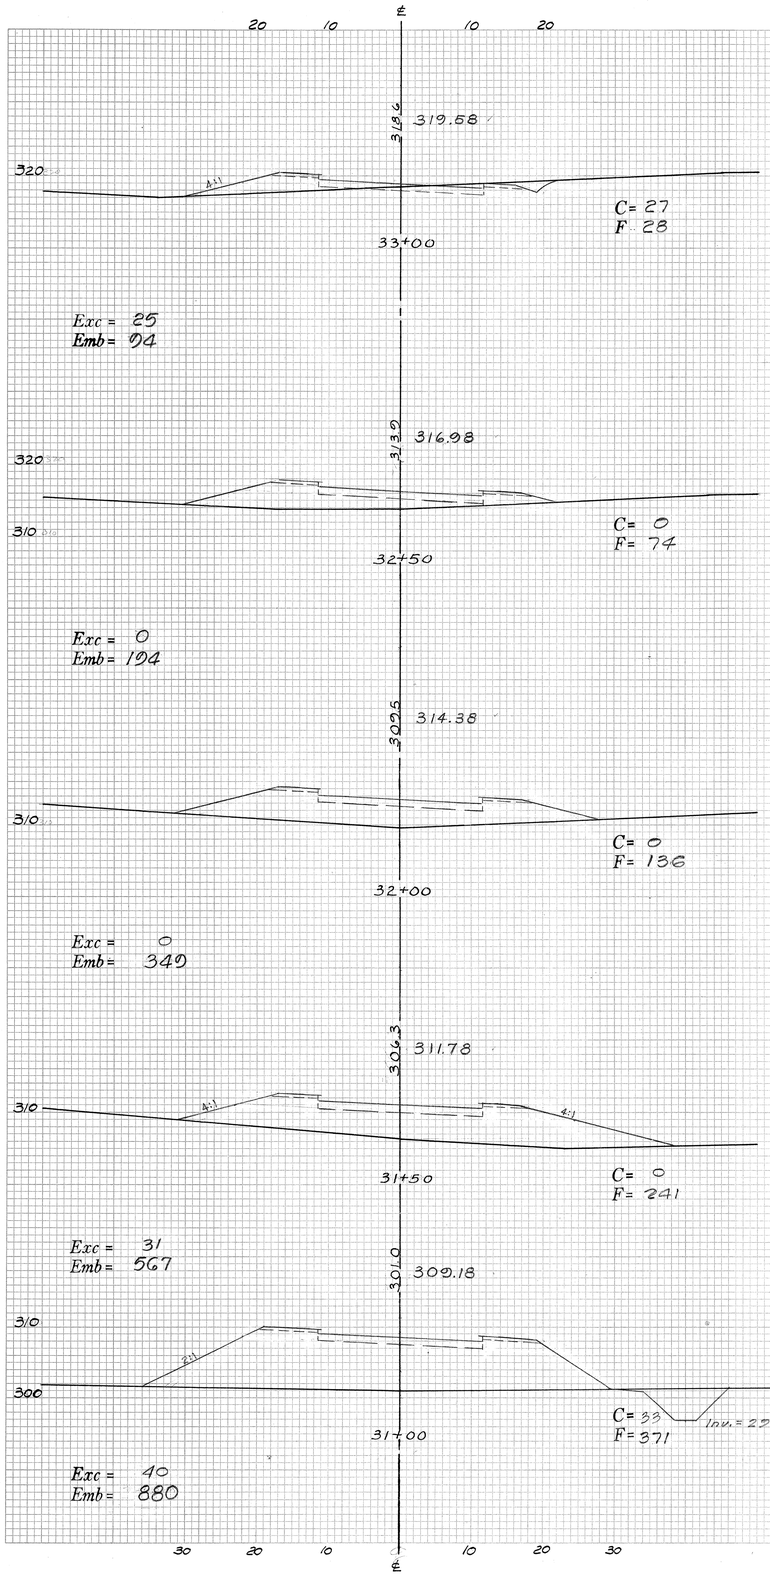

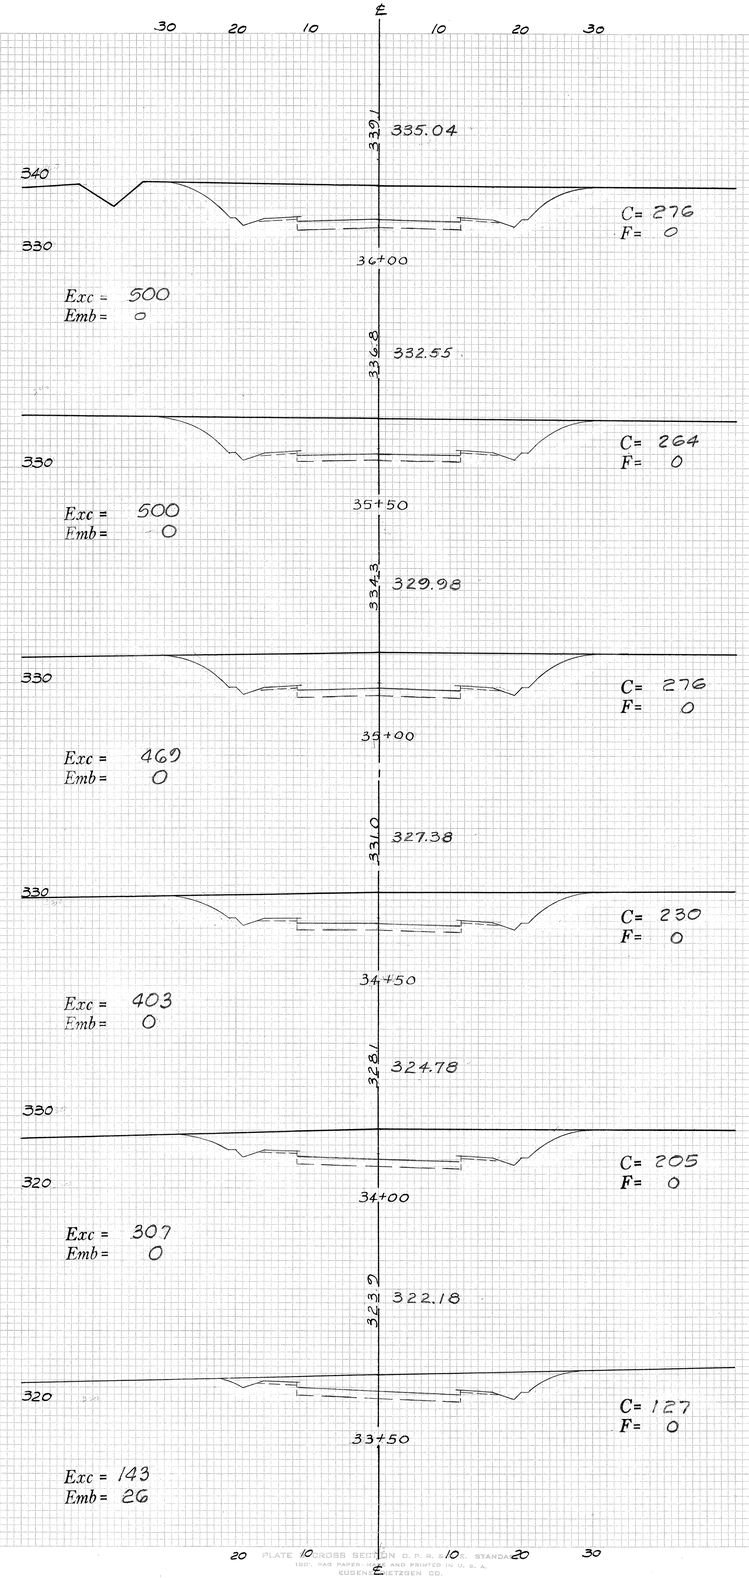

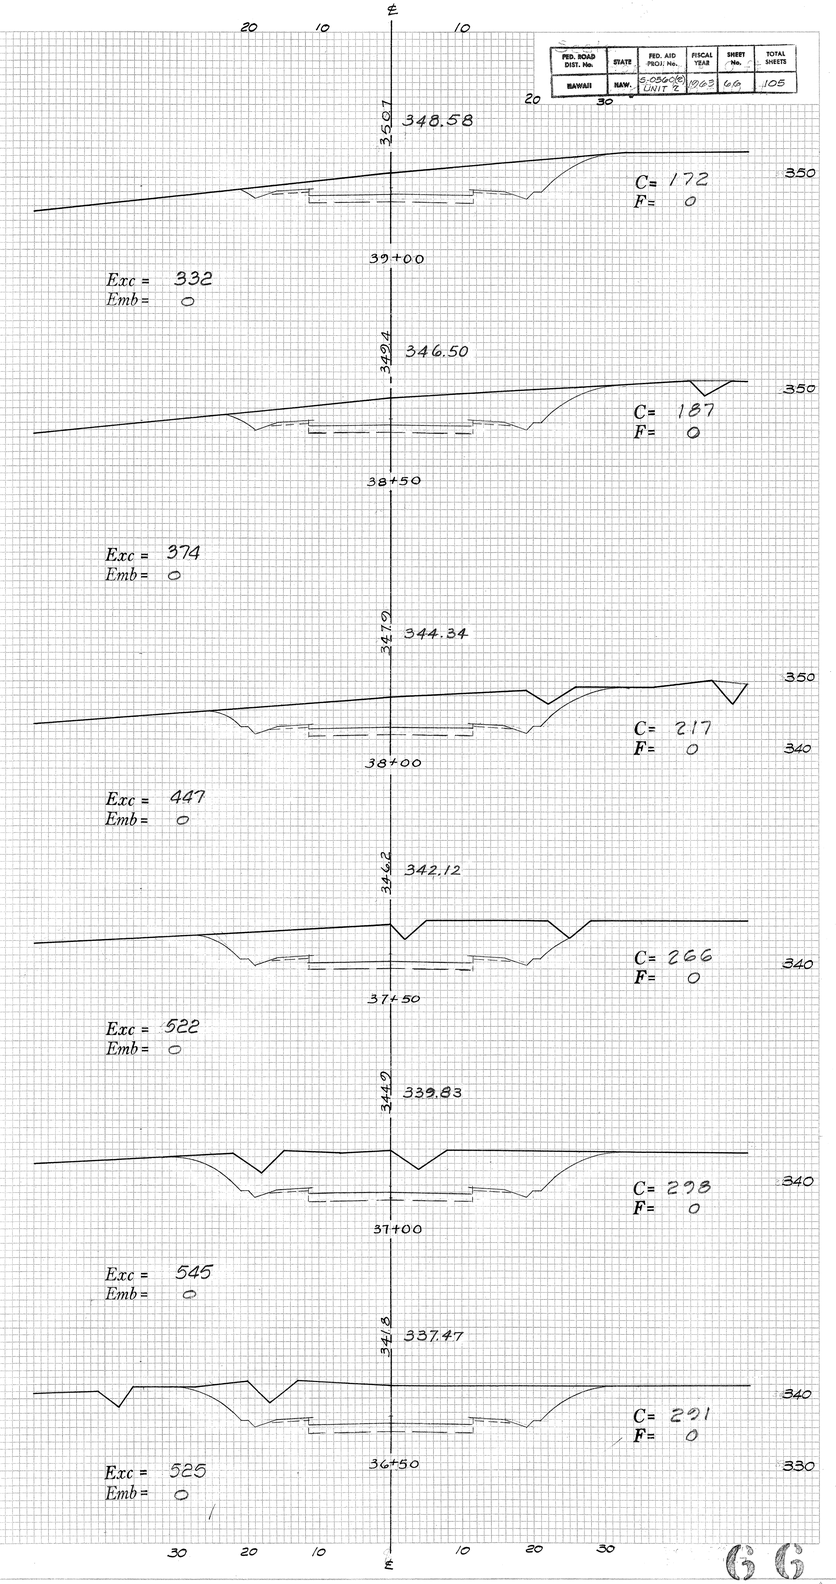

PLATE 10 CROSS SECTION G. P. R. STANDARD
1957 HAS PAPER HAND AND PRINTED IN U. S. A.
EUGENE DIETZGEN CO.

FED. ROAD DIST. No.	STATE	FED. AID PROJ. No.	FISCAL YEAR	SHEET No.	TOTAL SHEETS
HAWAII	HAW.	S-0560(8) UNIT 2	1963	67	105

FINAL SURVEY — NOTE BOOK — NO. — SURVEYED — PLOTTED — TEMPLATE — AREAS — CROSS SECTIONED — AREAS CHECKED — BY — DATE

ORIGINAL SURVEY — NOTE BOOK — NO. — SURVEYED — PLOTTED — TEMPLATE — AREAS — CROSS SECTIONED — AREAS CHECKED — BY — DATE

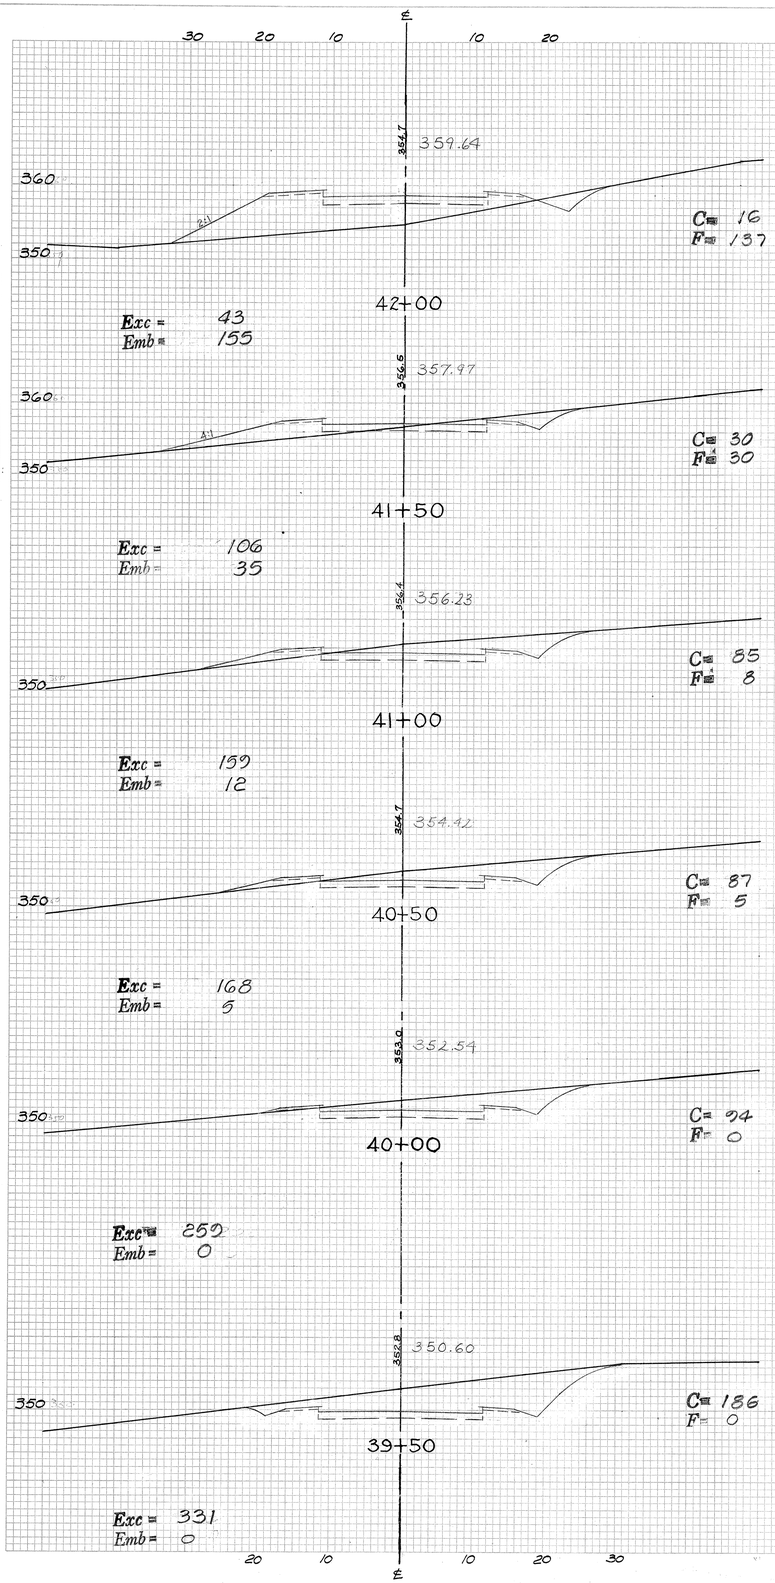

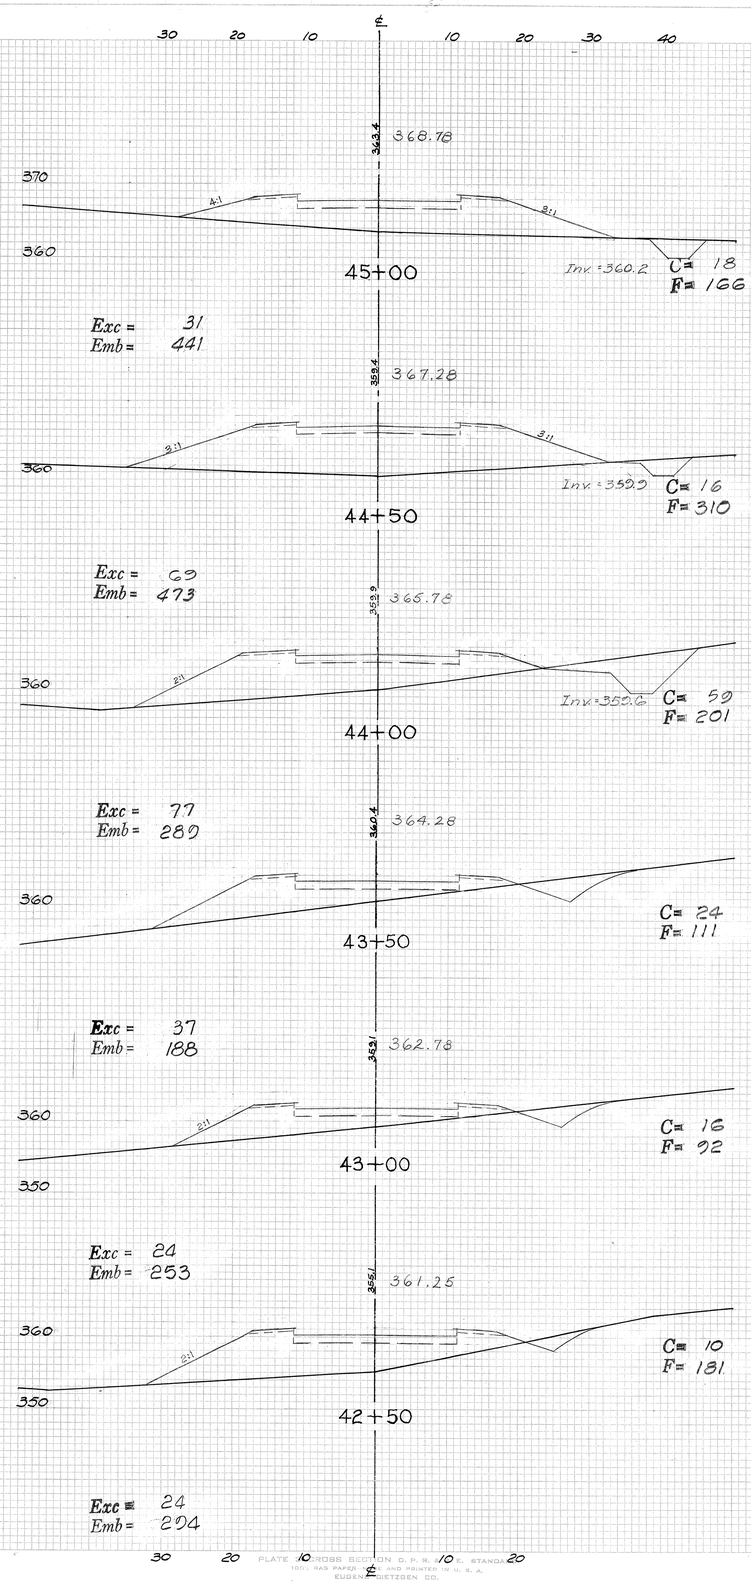

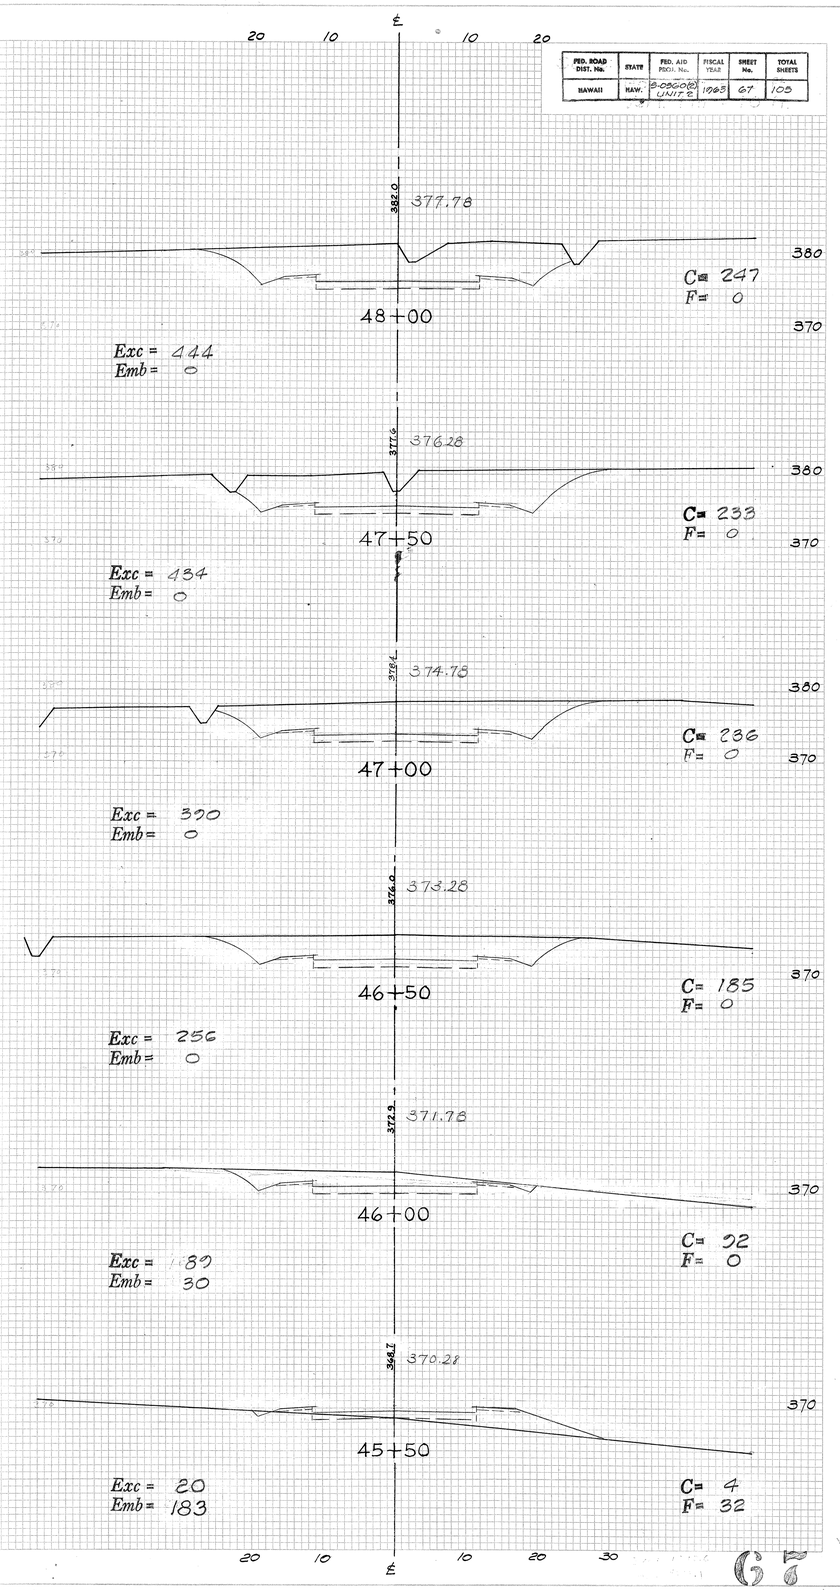

PLATE CROSS SECTION C. P. R. R. C. STANDARD
WHITE RAG PAPER MADE AND PRINTED IN U. S. A.
EUGENE DIETZGEN CO.

FED. ROAD DIST. No.	STATE	FED. AID PROJ. No.	FISCAL YEAR	SHEET No.	TOTAL SHEETS

FINAL SURVEY — NOTE BOOK — ND. — SURVEYED — PLOTTED — TEMPLATE — AREAS — CHECKED — BY — DATE

ORIGINAL SURVEY — NOTE BOOK — ND. — SURVEYED — PLOTTED — TEMPLATE — AREAS — CHECKED — BY — DATE

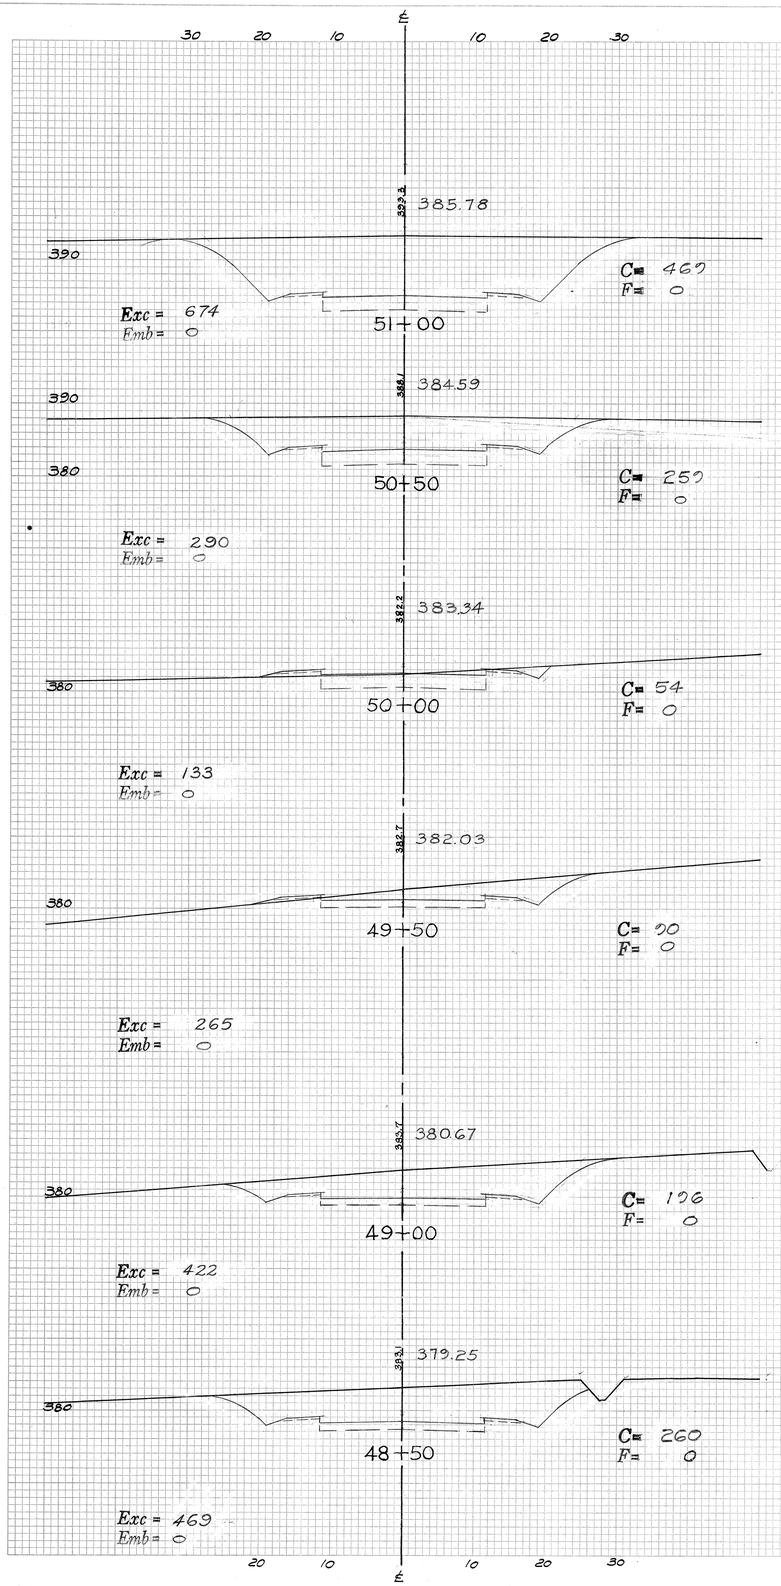

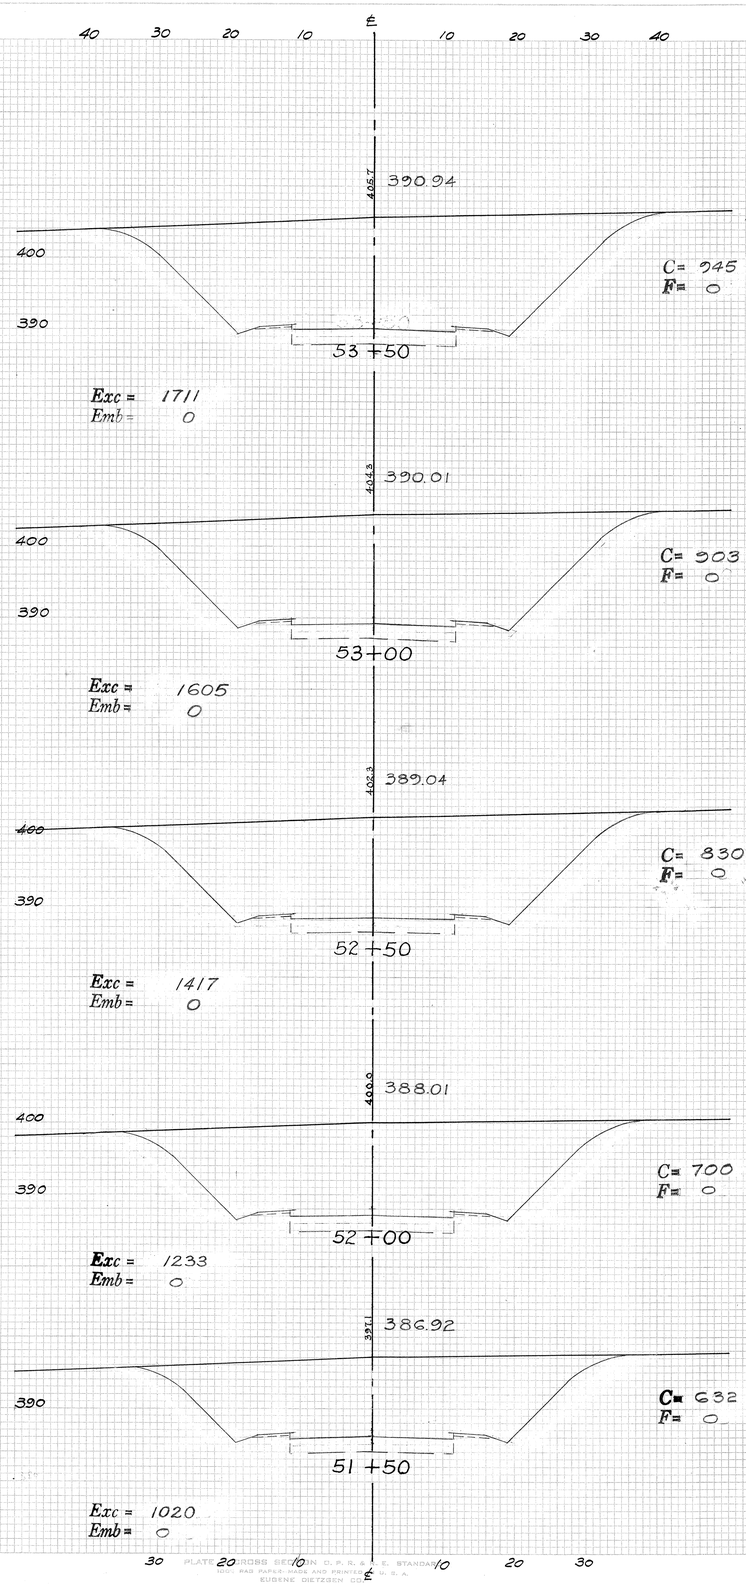

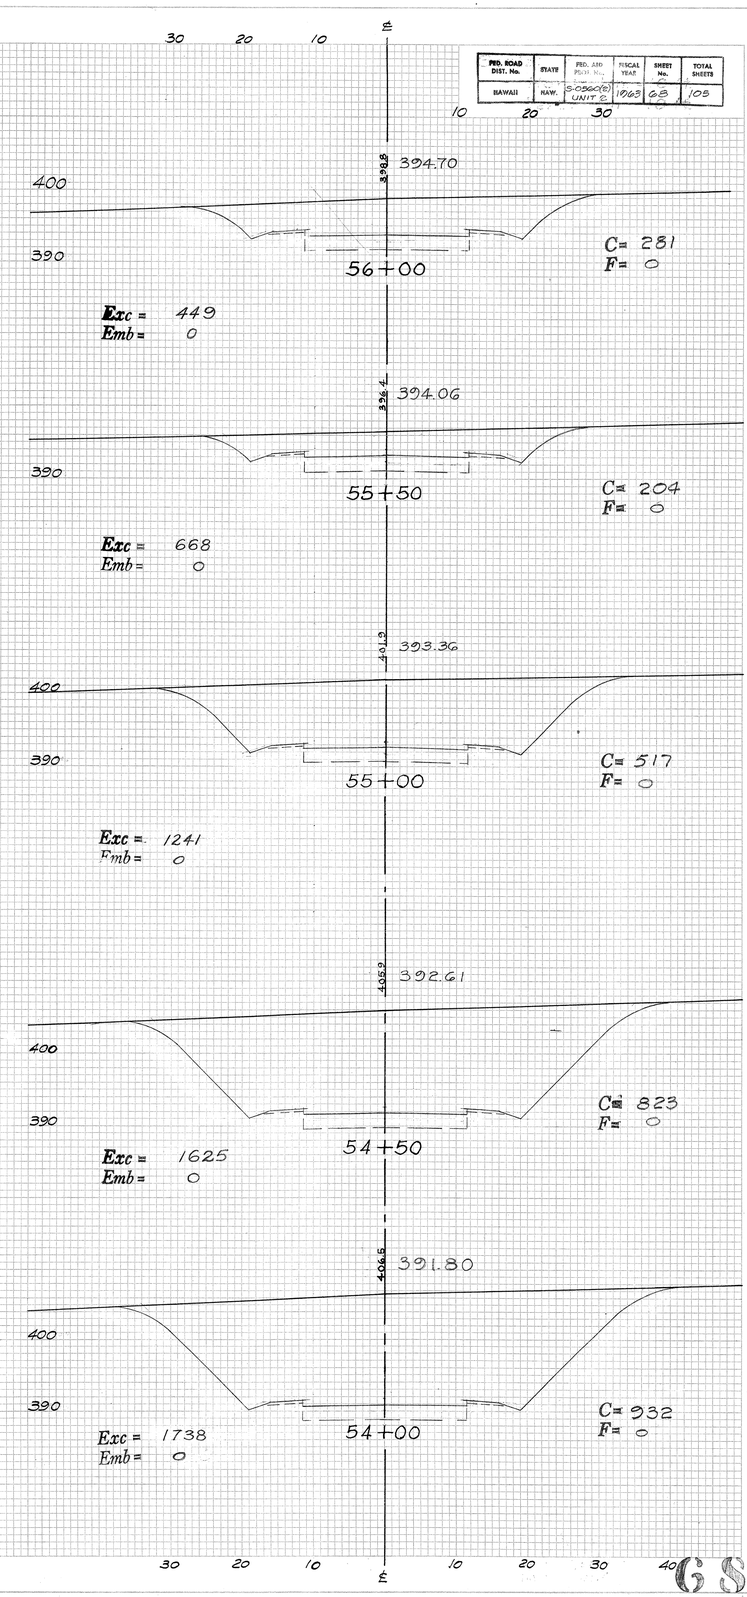

PLATE 2 CROSS SECTION C. P. R. & E. STANDARD
100% RAG PAPER MADE AND PRINTED IN U. S. A.
EUGENE DIETZGEN CO.

FED. ROAD DIST. No.	STATE	FED. AID PROJ. No.	FISCAL YEAR	SHEET No.	TOTAL SHEETS

FINAL SURVEY — SURVEYED, PLOTTED, TEMPLATE, AREAS, AREAS CHECKED, NOTE BOOK, NO., BY, DATE

ORIGINAL SURVEY — SURVEYED, PLOTTED, TEMPLATE, AREAS, AREAS CHECKED, NOTE BOOK, NO., BY, DATE

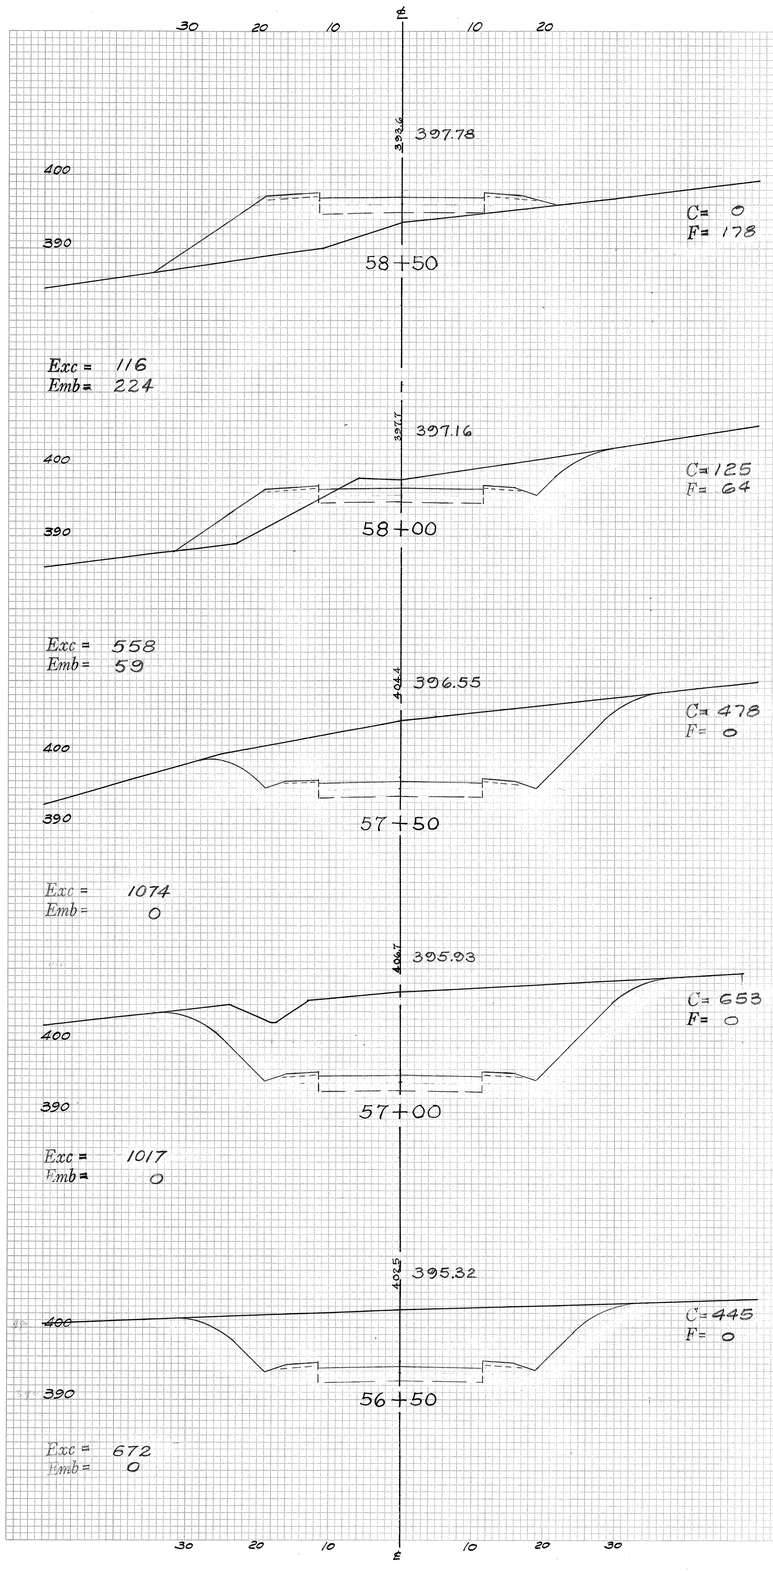

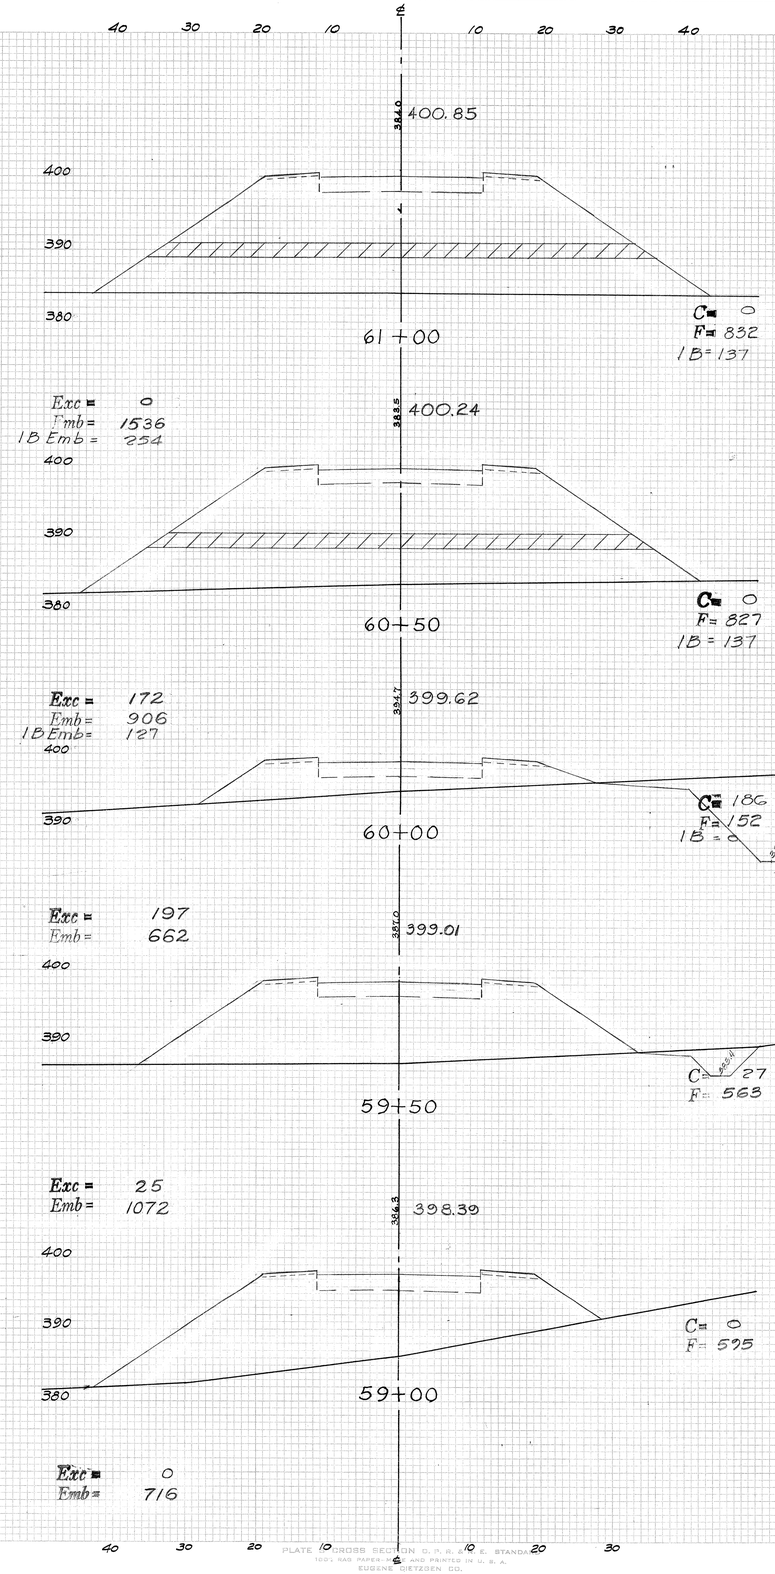

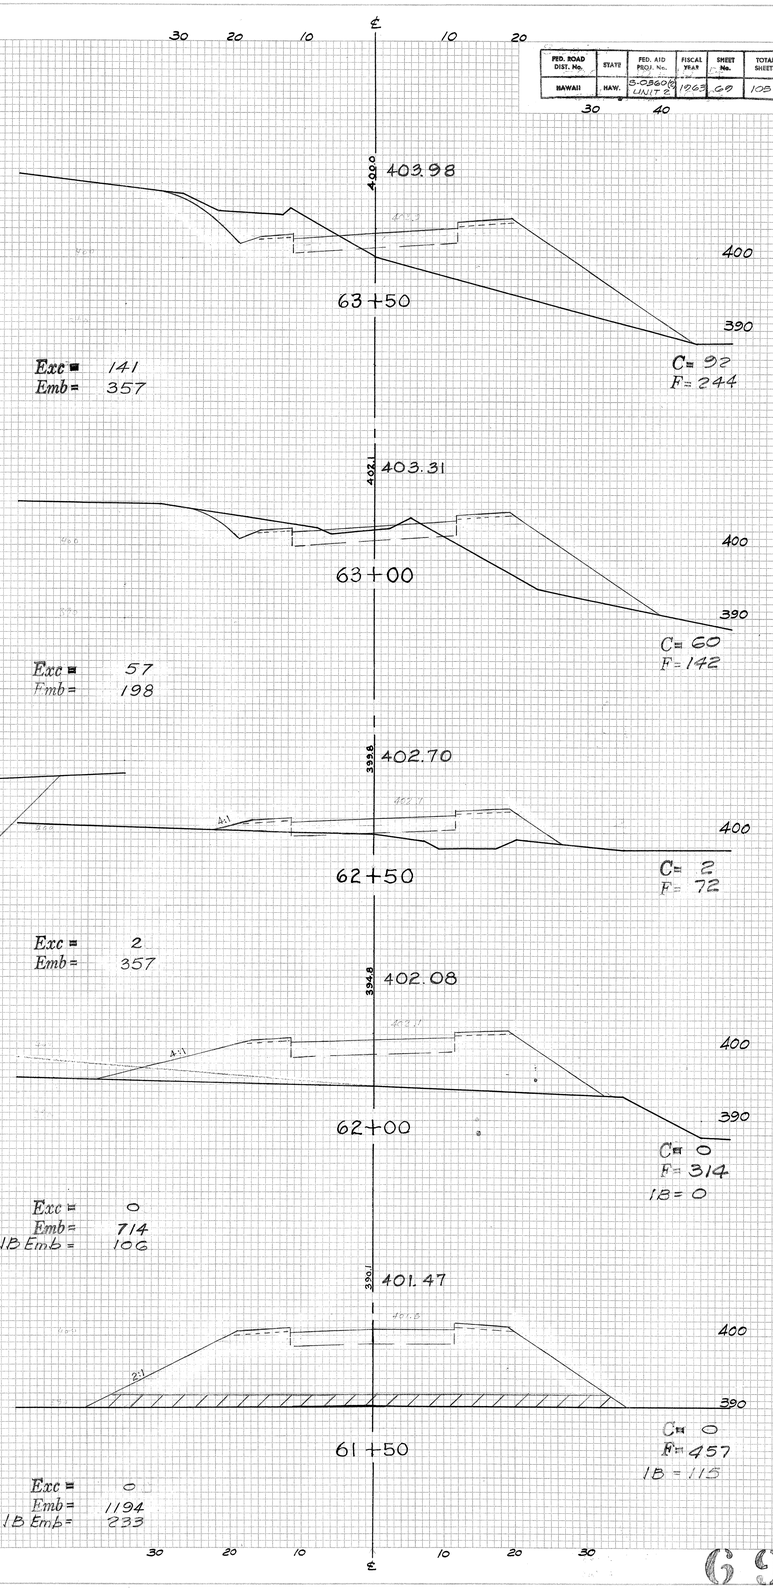

PLATE CROSS SECTION C. P. R. & E. STANDARD
100% RAG PAPER MADE AND PRINTED IN U. S. A.
EUGENE DIETZGEN CO.

FED. ROAD DIST. No.	STATE	FED. AID PROJ. No.	FISCAL YEAR	SHEET No.	TOTAL SHEETS

FINAL SURVEY — SURVEYED — PLOTTED — TRACED — NOTE BOOK — NO. — DATE — BY — AREAS — AREAS CHECKED

ORIGINAL SURVEY — SURVEYED — PLOTTED — TRACED — NOTE BOOK — NO. — DATE — BY — AREAS — AREAS CHECKED

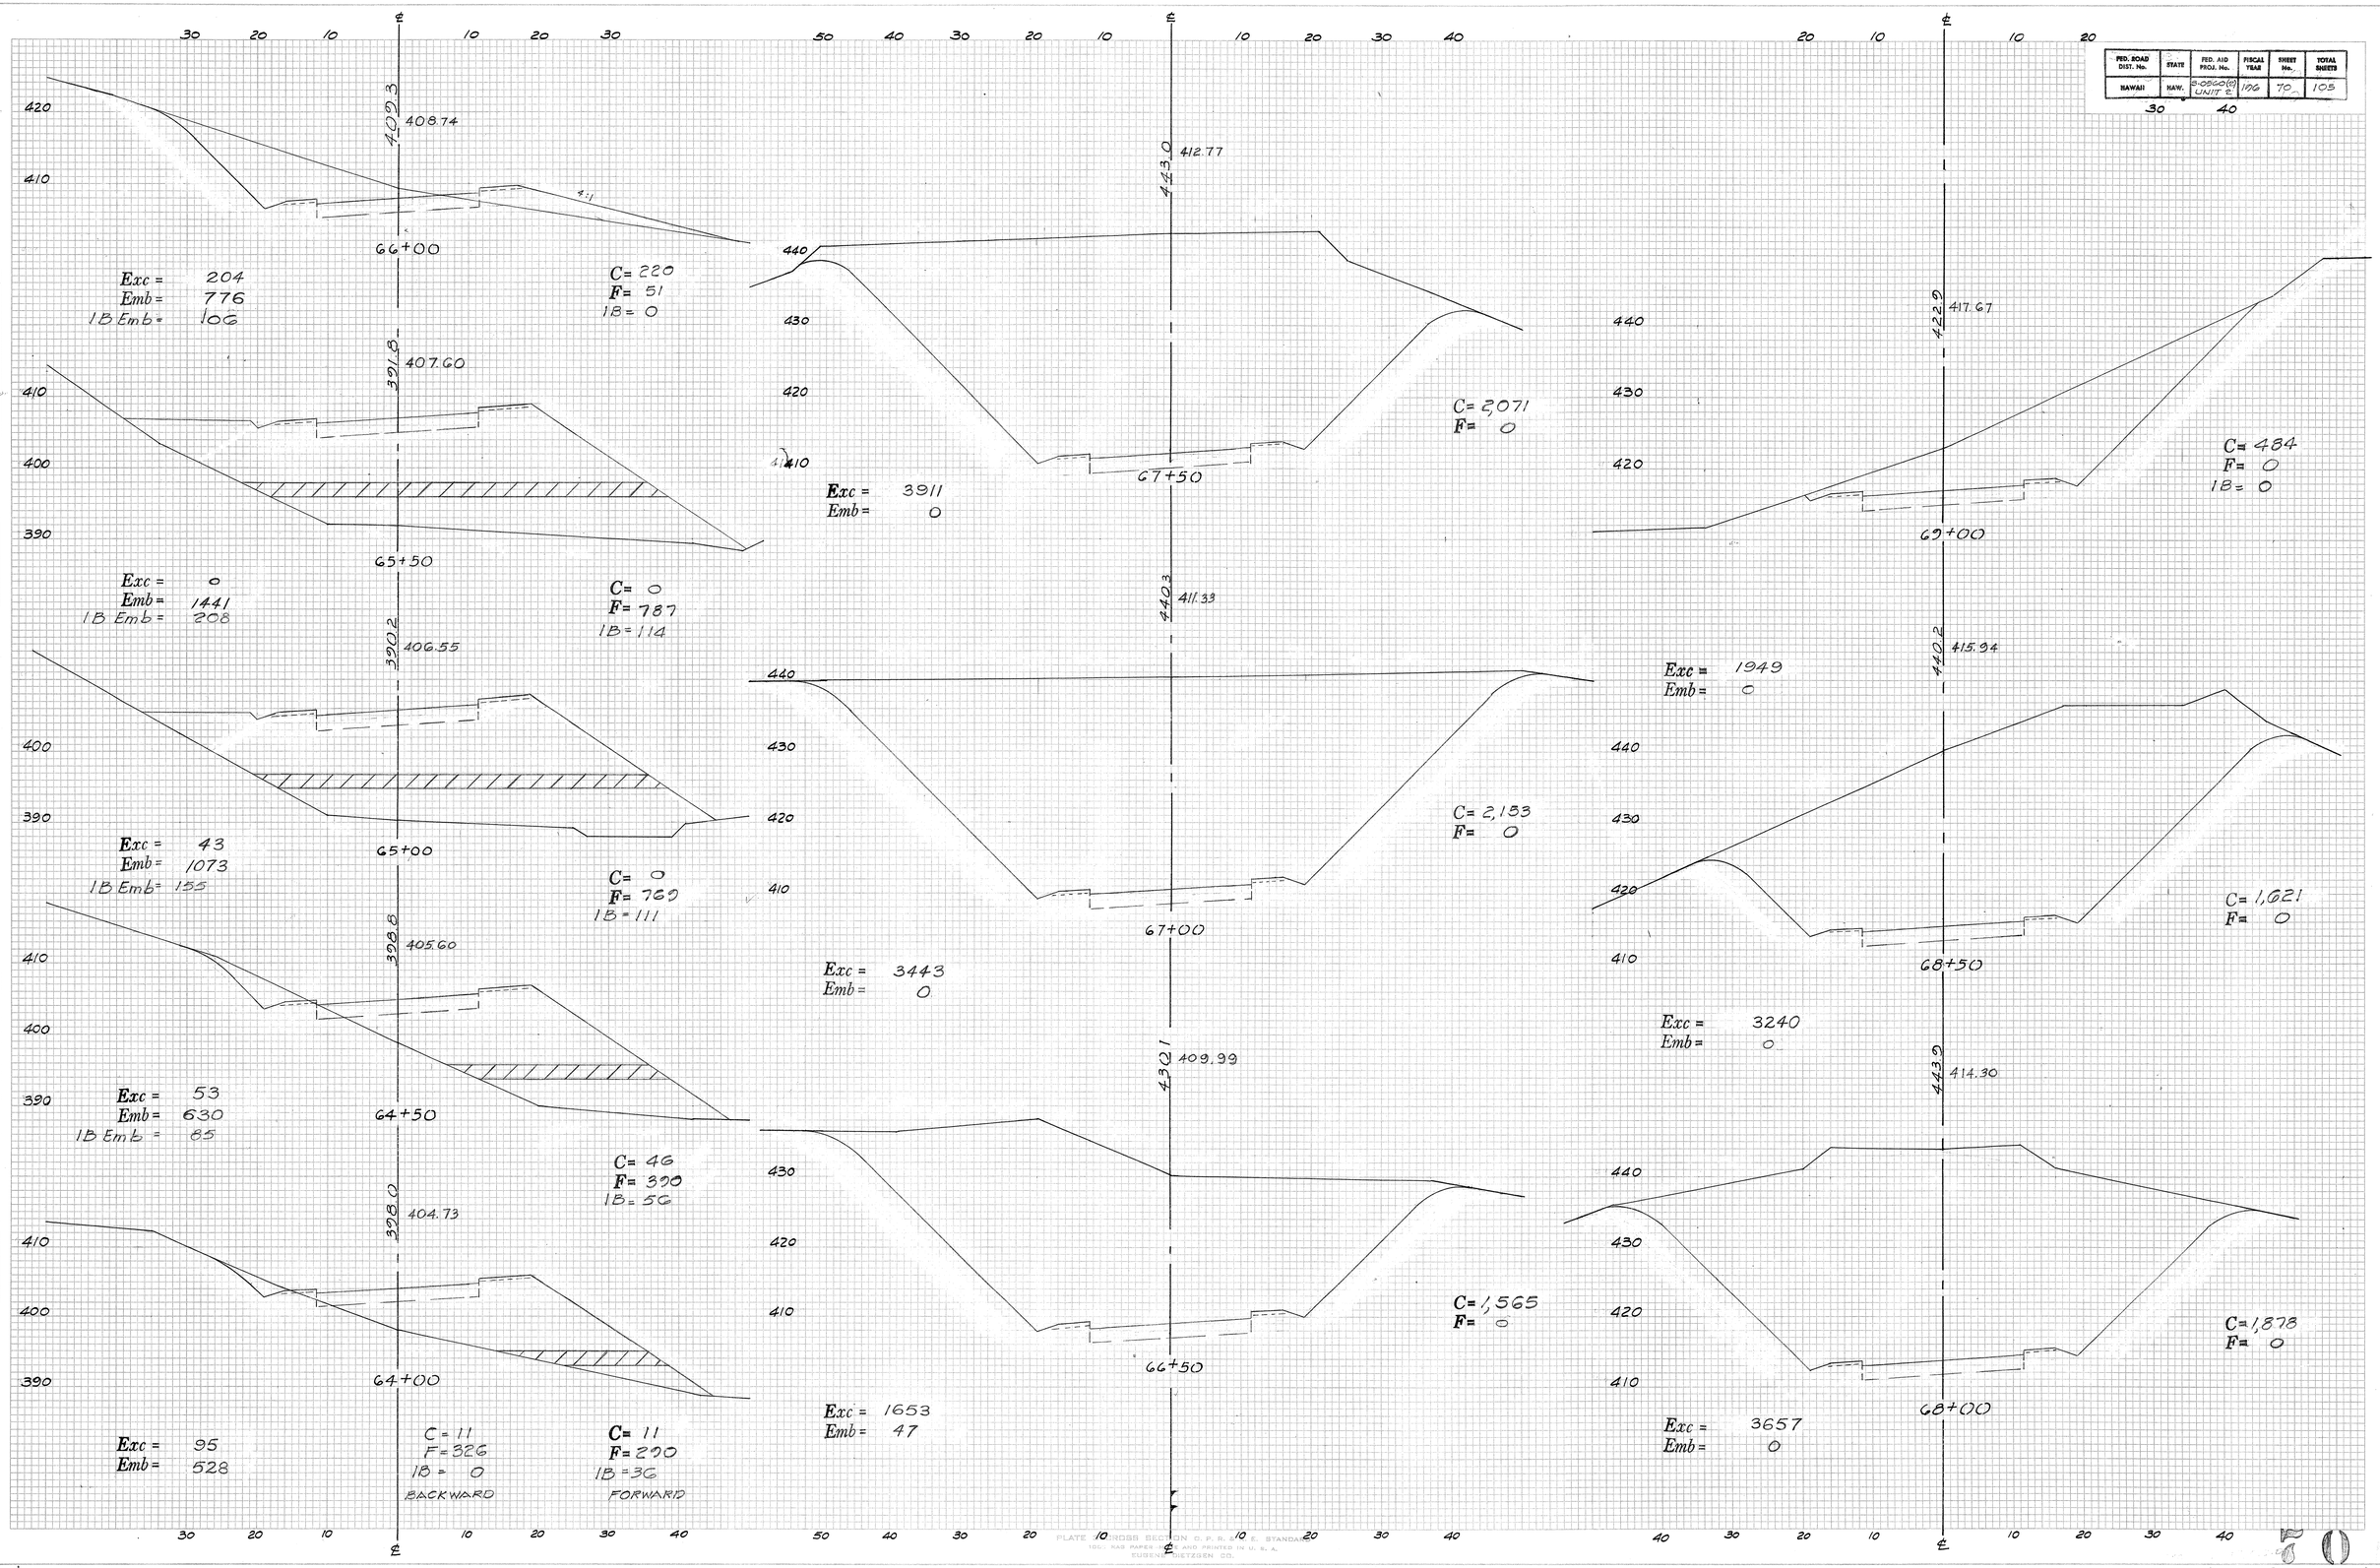

PLATE 10 JOBB SECTION C. P. R. C. STANDARD
1967 KAS PAPER MADE AND PRINTED IN U. S. A.
EUGENE DIETZGEN CO.

FED. ROAD DIST. No.	STATE	FED. AID PROJ. No.	FISCAL YEAR	SHEET No.	TOTAL SHEETS
HAWAII	HAW.	S-0060(6) UNIT E	196	71	105

FINAL SURVEY — SURVEYED BY, PLOTTED BY, TEMPLATE BY, AREAS CHECKED ✓, NOTE BOOK, NO., DATE, BY

ORIGINAL SURVEY — SURVEYED BY, PLOTTED BY, TEMPLATE BY, AREAS CHECKED, NOTE BOOK, NO., DATE, BY

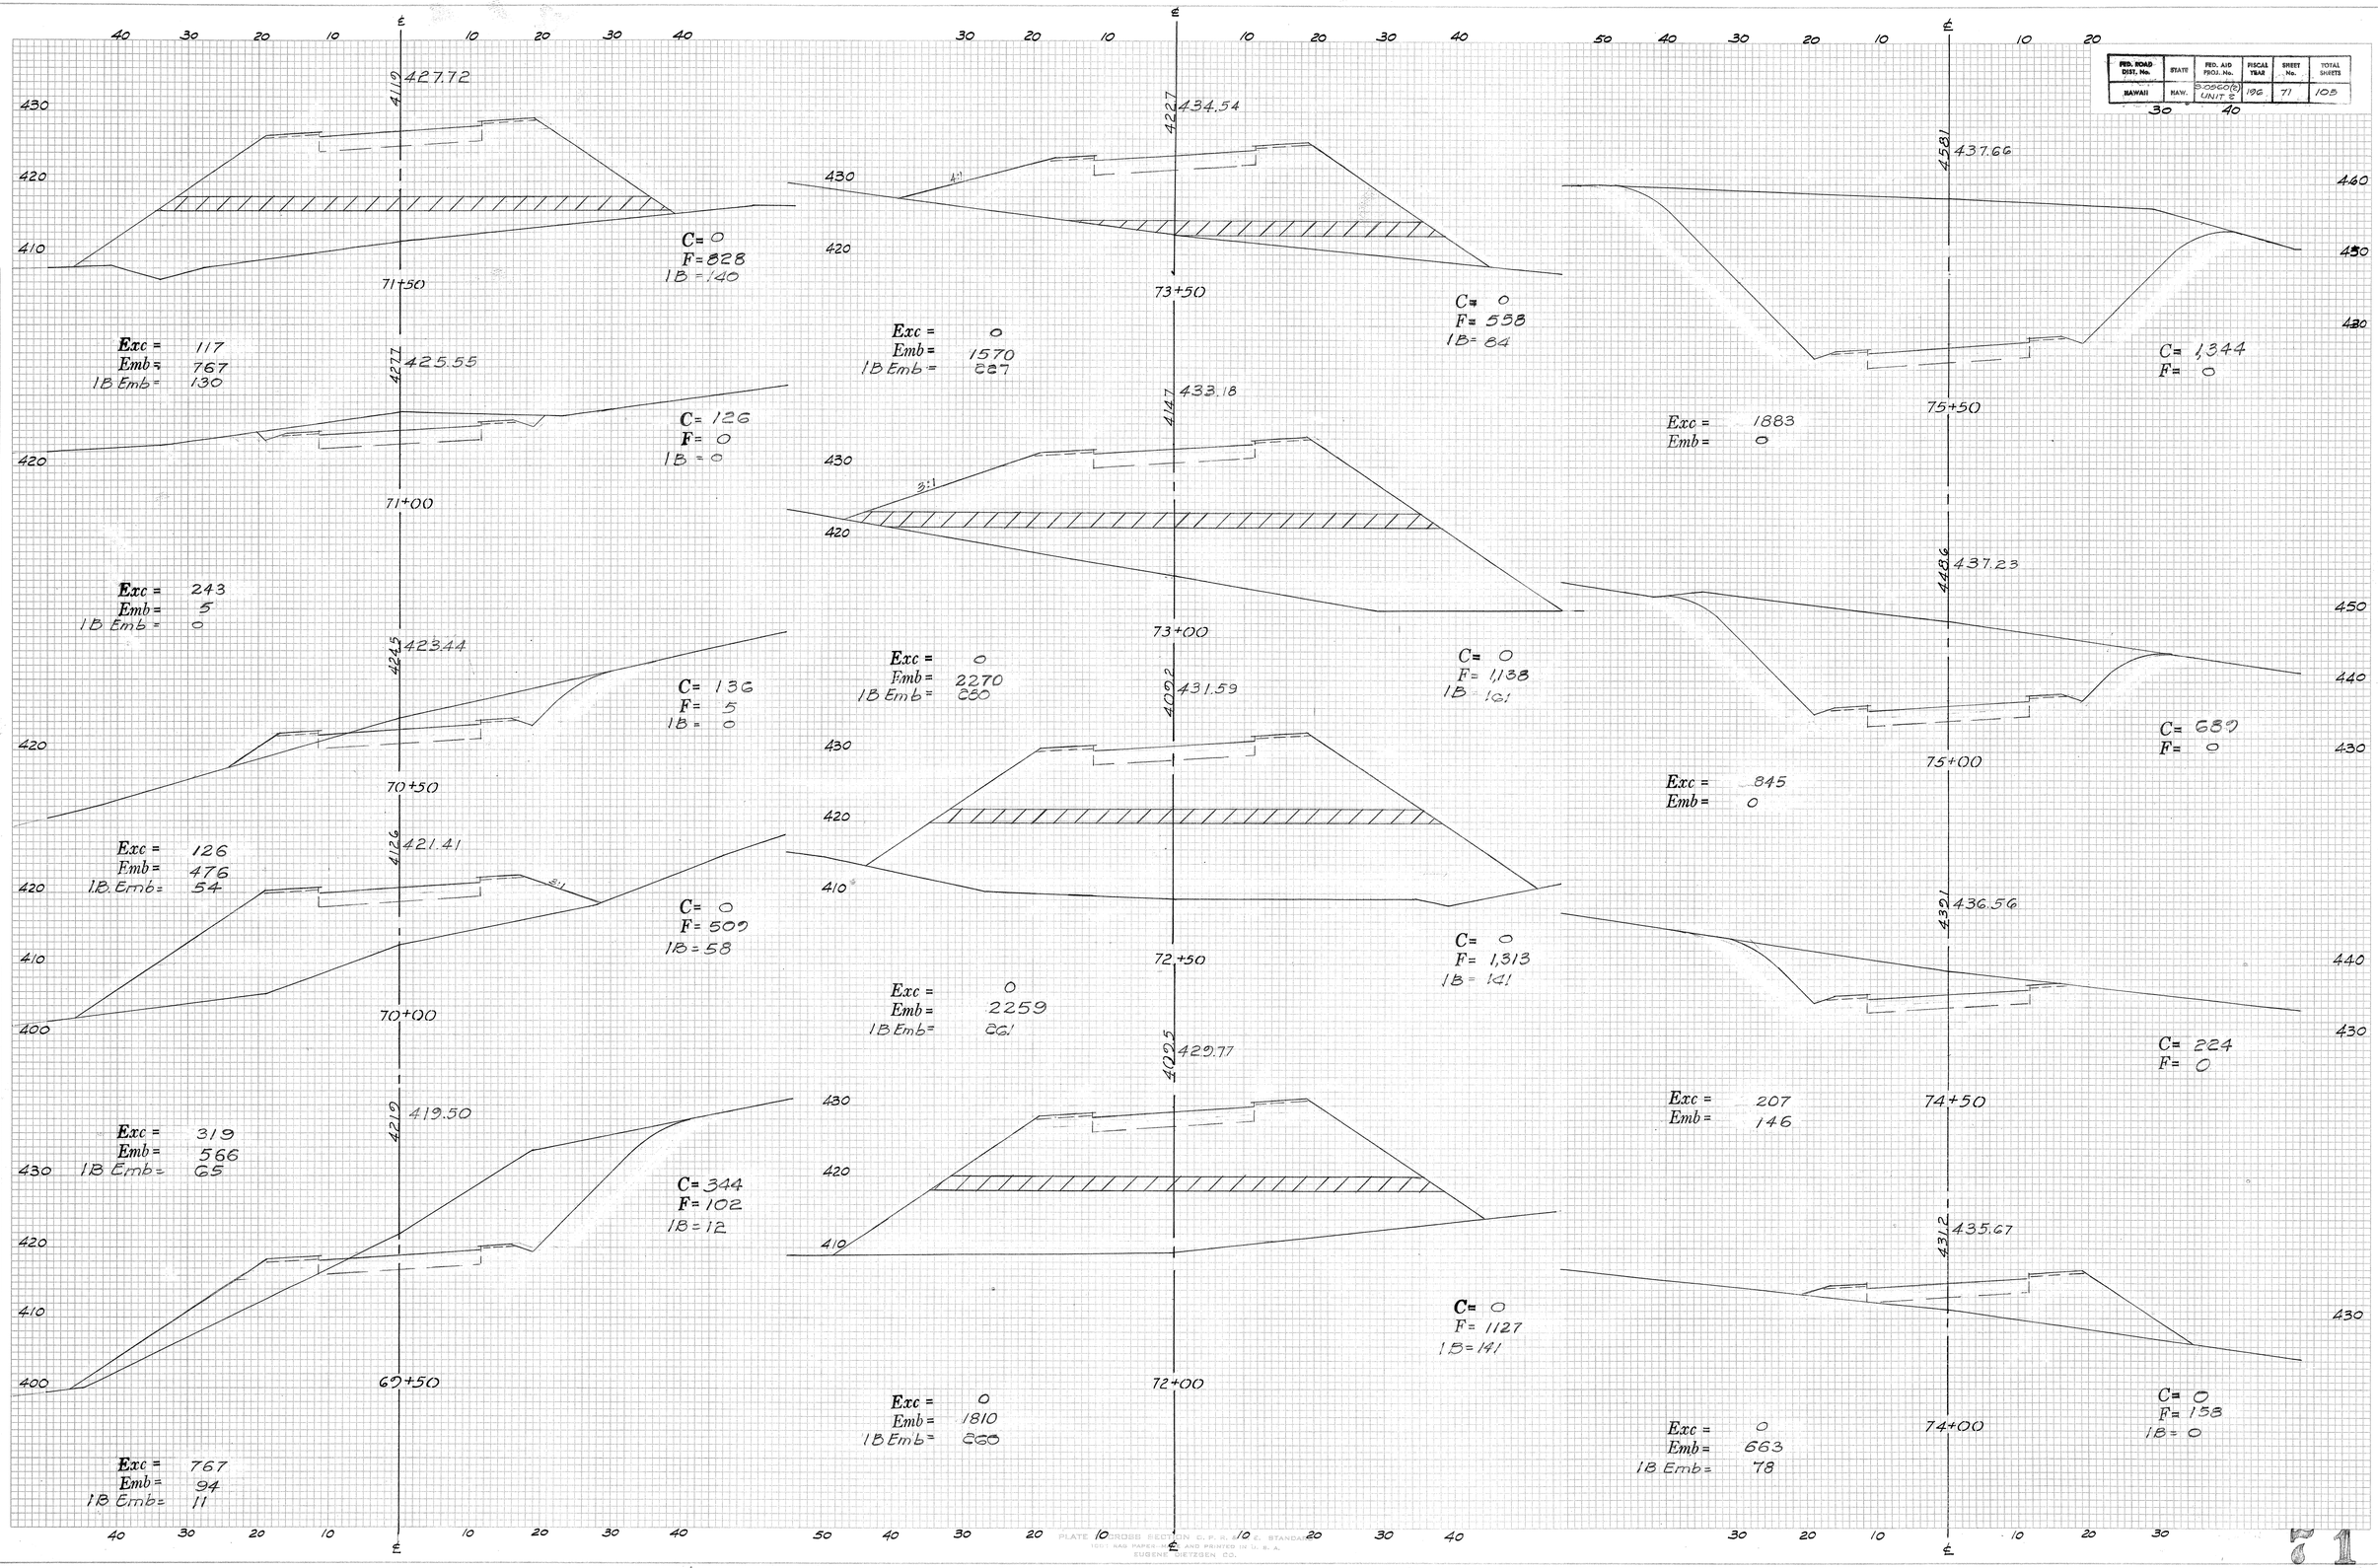

PLATE CROSS SECTION C. P. R. ℄ STANDARD
1951 NAG PAPER-MADE AND PRINTED IN U. S. A.
EUGENE DIETZGEN CO.

FED. ROAD DIST. No.	STATE	FED. AID PROJ. No.	FISCAL YEAR	SHEET No.	TOTAL SHEETS
HAWAII	HAW.	S-052(28) UNIT 2	1965	72	105

FINAL SURVEY — SURVEYED BY / PLOTTED BY / TEMPLATE AREAS / AREAS CHECKED / NOTE BOOK / NO. / DATE / BY

ORIGINAL SURVEY — SURVEYED BY / PLOTTED BY / TEMPLATE AREAS / AREAS CHECKED / NOTE BOOK / NO. / DATE / BY

4676 — 437.10

77+50

Exc = 3922
Emb = 0

C= 2,274
F= 0

4650 — 437.59

77+00

Exc = 3465
Emb = 0

C= 1,961
F= 0

4632 — 437.85

76+50

Exc = 3117
Emb = 0

C= 1,781
F= 0

4613 — 437.88

76+00

Exc = 2712
Emb = 0

C= 1,585
F= 0

4770 — 434.26

79+00

Exc = 7341
Emb = 0

C= 4,172
F= 0

4756 — 435.44

78+50

Exc = 6059
Emb = 0

C= 3,757
F= 0

4719 — 436.38

78+00

Exc = 4686
Emb = 0

C= 2,786
F= 0

PLATE 3, CROSS SECTION C. P. R. & R. E. STANDARD
100% RAG PAPER-MADE AND PRINTED IN U. S. A.
EUGENE DIETZGEN CO.

72

12

FED. ROAD DIST. No.	STATE	FED. AID PROJ. No.	FISCAL YEAR	SHEET No.	TOTAL SHEETS

FINAL SURVEY — DATE / BY — SURVEYED — PLOTTED — TEMPLATE — NOTE BOOK — AREAS CHECKED — NO.

ORIGINAL SURVEY — DATE / BY — SURVEYED — PLOTTED — TEMPLATE — NOTE BOOK — AREAS CHECKED — NO.

60 50 40 30 20 10 Ê 10 20 30 40 50 60

4700 429.35

80+50

C= 3,081
F= 0

Exc = 7448
Emb = 0

4724 431.21

80+00

C= 4,063
F= 0

Exc = 7497
Emb = 0

4747 432.86

79+50

C= 4,034
F= 0

Exc = 7598
Emb = 0

4598 424.92

81+50

C= 3,136
F= 0

Exc = 6340
Emb = 0

4661 427.25

81+00

C= 3,711
F= 0

Exc = 7122
Emb = 0

470 460 450 440 430 420

PLATE 3 CROSS SECTION C. P. R. & R. E. STANDARD
100% RAG PAPER—MADE AND PRINTED IN U. S. A.
EUGENE DIETZGEN CO.

FED. ROAD DIST. No.	STATE	FED. AID PROJ. No.	FISCAL YEAR	SHEET No.	TOTAL SHEETS
HAWAII	HAW.	S-050(006) UNIT 2	1970	74	105

FINAL SURVEY
SURVEYED
PLOTTED
TYPING CHK.
NOTE BOOK
AREAS
NO.
AREAS CHECKED
BY
DATE

ORIGINAL SURVEY
SURVEYED
PLOTTED
TYPING CHK.
NOTE BOOK
AREAS
NO.
AREAS CHECKED ✓
BY
DATE

50 40 30 20 10 ℄ 10 20 30 40 50 60 70

460 450 440 430 420

457.8 420.02

82+50

C= 3,227
F= 0

Exc = 4960
Emb = 0

444.0 422.47

82+00

C= 2,129
F= 0

Exc = 4875
Emb = 0

458.1 415.13

83+50

C= 3,698
F= 0

Exc = 6775
Emb = 0

460.1 417.58

83+00

C= 3,620
F= 0

Exc = 6340
Emb = 0

460 450 440 430 420 410

50 40 30 20 10 ℄ 10 20 30 40 50 60 70

PLATE CROSS SECTION C. P. R. & R. E. STANDARD
100% RAG PAPER—MADE AND PRINTED IN U. S. A.
EUGENE DIETZGEN CO.

25 41

FED. ROAD DIST. No.	STATE	FED. AID PROJ. No.	FISCAL YEAR	SHEET No.	TOTAL SHEETS
HAWAII	HAW.	S-0500(6) UNIT 5	1963	75	105

FINAL SURVEY — NOTE BOOK ____ NO. ____ — SURVEYED ____ PLOTTED ____ TRIANGULATE ____ AREAS ____ AREAS CHECKED ____ — BY ____ DATE ____

ORIGINAL SURVEY — NOTE BOOK ____ NO. ____ — SURVEYED ____ PLOTTED ____ TRIANGULATE ____ AREAS ____ AREAS CHECKED ____ — BY ____ DATE ____

50 40 30 20 10 ℄ 10 20 30

440 430 420 410

421.2 410.34

C= 881
F= 0
IB = 0

Exc = 3321
Emb = 0

84+50

30 20 10 ℄ 10 20 30 40 50 60 70

405.7 406.27

400 390 380

Invert: 381.9

85+50 (FOR QUANTITY PURPOSE ONLY)

C= 21
F= 852
IB = 130

Exc =
Emb =

Begin of Bridge Sta. 85 + 46.75

460 450 430 420 410

414.2 412.69

Exc = 178
Emb = 938
IB Emb = 197

C= 2,705
F= 0

Exc = 5929
Emb = 0

84+00

420 410 400 390

403.6 408.21

Invert: 388.0

Exc = 976
Emb = 298
IB Emb = 69

85+00

C= 53
F= 761
IB = 153

C= 173
F= 322
IB = 74

60 50 40 30 20 10 ℄ 10 20 30 40 50 60 70

PLATE 3 CROSS SECTION U. P. R. & R. E. STANDARD
100% RAG PAPER - MADE AND PRINTED IN U. S. A.
EUGENE DIETZGEN CO.

15

FED. ROAD DIST. No.	STATE	FED. AID PROJ. No.	FISCAL YEAR	SHEET No.	TOTAL SHEETS
HAWAII	HAW.	DOBS-019(8) UNIT-B	1963	76	105

FINAL SURVEY — NOTE BOOK — NO. — SURVEYED — PLOTTED — TEMPLATE — AREAS — CHECKED — BY — DATE

ORIGINAL SURVEY — NOTE BOOK — NO. — SURVEYED — PLOTTED — TEMPLATE — AREAS — CHECKED — BY — DATE

50 40 30 20 10 ℄ 10 20 30 40

420 400 390 380 370 360

4104 398.92

Exc = 671
Emb = 746
1B Emb = 167

88+50

C = 725
F = 0
1B = 0

3933 399.63

Exc = 0
Emb = 230
1B Emb = 52

88+00

End of Bridge Sta. 87+93.13

C = 0
F = 806
1B = 180

3652 400.55

C = 0
F = 339
1B = 234

87+50 (For Quantity Purpose Only)

Exc =
Emb =

C = 0
F = 2,400
1B = 570

70 60 50 40 30 20 10 ℄ 10 20 30 40 50 60

60 50 40 30 20 10 ℄ 10 20 30 40 50 60

4263 397.98

Exc = 4330
Emb = 0

90+00

C = 2,734
F = 0

4222 398.09

Exc = 3472
Emb = 0

89+50

C = 1,942
F = 0

4242 398.40

Exc = 2345
Emb = 0

89+00

C = 1,807
F = 0

440 430 420 410 400 390

PLATE 70 CROSS SECTION U. P. R. & R. E. STANDARD
100% RAG PAPER-MADE AND PRINTED IN U. S. A.
EUGENE DIETZGEN CO.

76

17

FED. ROAD DIST. No.	STATE	FED. AID PROJ. No.	FISCAL YEAR	SHEET No.	TOTAL SHEETS
	HAW.	S-0560(8) UNIT: 2	19 64	77	105

FINAL SURVEY — NOTE BOOK — NO. — SURVEYED — PLOTTED — TEMPLATE — AREAS — AREAS CHECKED — BY — DATE

ORIGINAL SURVEY — NOTE BOOK — NO. — SURVEYED — PLOTTED — TEMPLATE — AREAS — AREAS CHECKED — BY — DATE

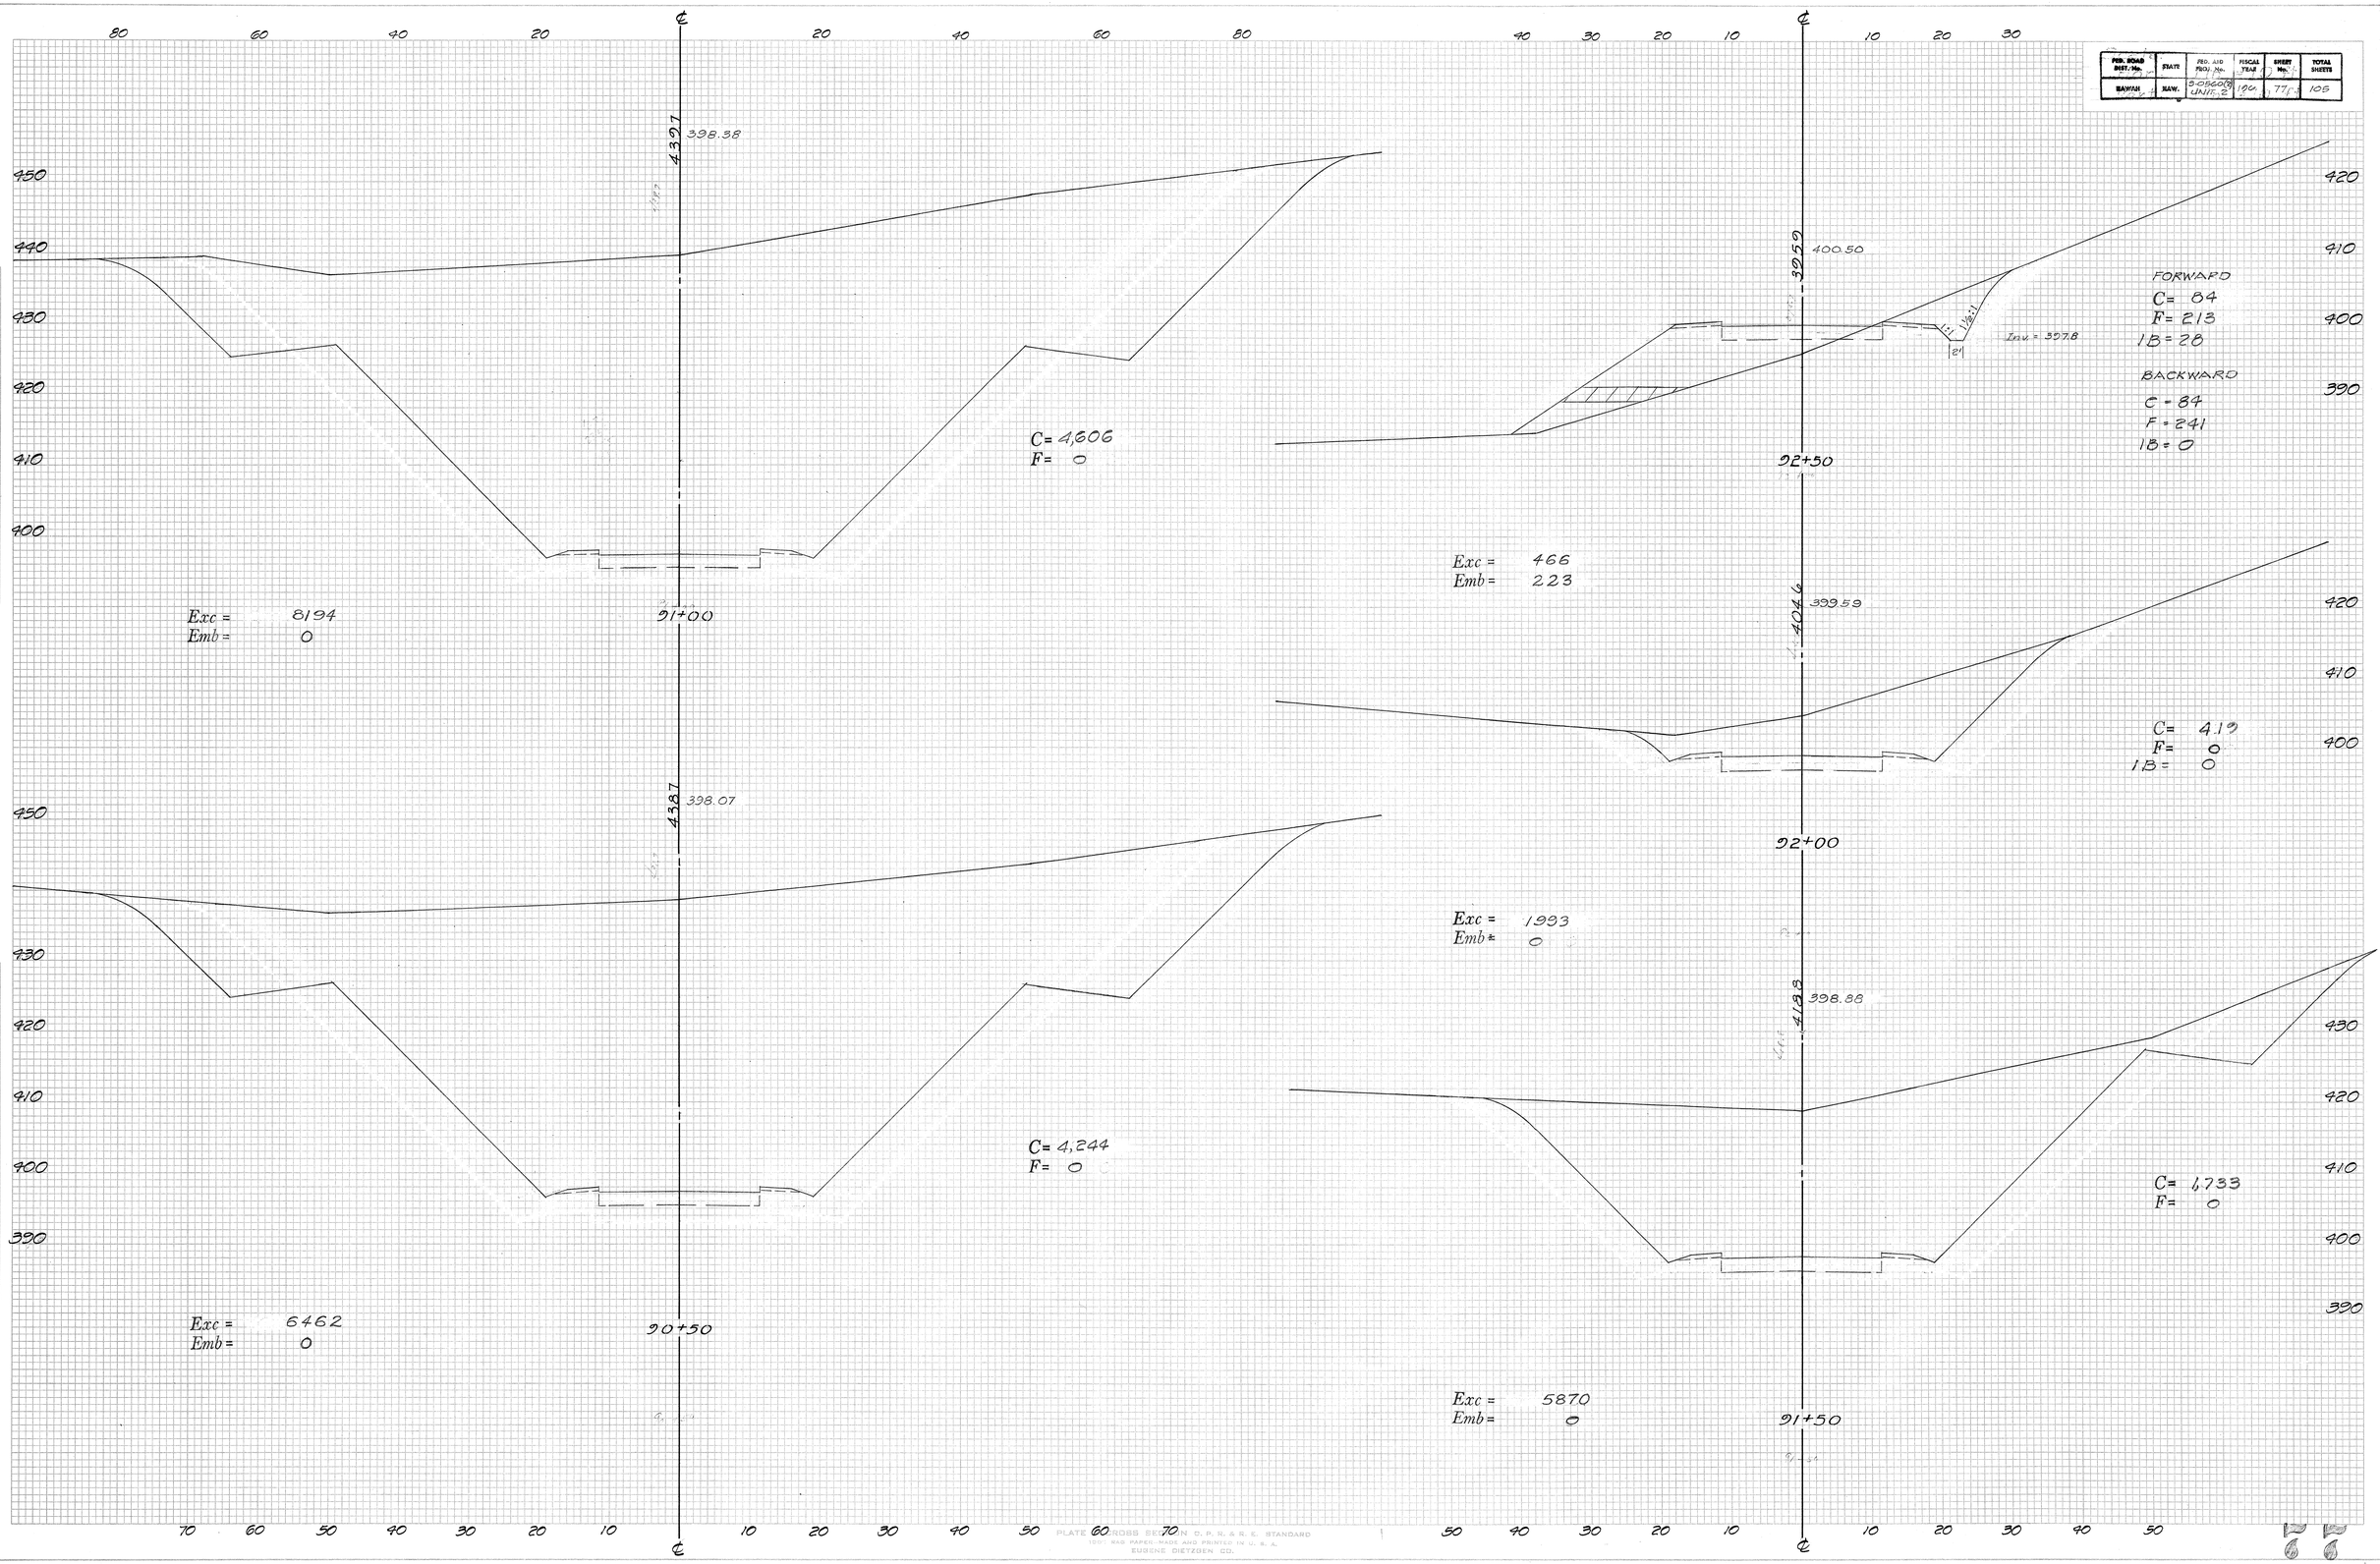

PLATE CROSS SECTION C. P. R. & R. E. STANDARD
1901. RAG PAPER MADE AND PRINTED IN U. S. A.
EUGENE DIETZGEN CO.

FED. ROAD DIST. No.	STATE	FED. AID PROJ. No.	FISCAL YEAR	SHEET No.	TOTAL SHEETS

FINAL SURVEY — NOTE BOOK NO. — SURVEYED. PLOTTED. CHECKED. AREAS. AREAS CHECKED. — BY — DATE

ORIGINAL SURVEY — NOTE BOOK NO. — SURVEYED. PLOTTED. CHECKED. AREAS. AREAS CHECKED. — BY — DATE




















80 70 60 50 40 30 20 10 ℄ 10 20 30

PLATE 3 - CROSS SECTION O.P.R.&R.E. STANDARD
KEUFFEL & ESSER CO., NEW YORK.
K & E CO. NO. 345-3 MADE IN U.S.A. 82663

FED. ROAD DIST. No.	STATE	FED. AID PROJ. No.	FISCAL YEAR	SHEET No.	TOTAL SHEETS
HAWAII	HAW.	S-0582(2) UNIT 2	1963	79	105

FINAL SURVEY — SURVEYED, PLOTTED, FIELD BOOK, NO., DATE, BY, AREAS, AREAS CHECKED

ORIGINAL SURVEY — SURVEYED, PLOTTED, FIELD BOOK, NO., DATE, BY, AREAS, AREAS CHECKED

100 80 60 40 20 ℄ 20 40 60 80 100 120 140

372.7

410.23

5:1 10:1

.038/ft.

410 400 390 380 370

96+00

C= 0
F= 5335
IB = 856

Exc = 0
Emb = 9158
IB Emb = 1637

369.6

409.31

5:1 10:1

.038/ft.

410 400 390 380 370

95+50

C= 0
F= 4556
IB = 816

370.0

407.69

5:1 10:1

.038'/ft.

420 410 400 390 380 370 360

95+00

C= 0
F= 4020
IB = 588

Exc = 0
Emb = 8774
IB Emb = 1758

Exc = 0
Emb = 8419
IB Emb = 1621

100 80 60 40 20 ℄ 20 40 60 80 100 120 140 160

PLATE 3 - CROSS SECTIONS - U.S.B.R. STANDARD
KEUFFEL & ESSER CO., NEW YORK.
K & E CO. NO. 345-3

79

FED. ROAD DIST. No.	STATE	FED. AID PROJ. No.	FISCAL YEAR	SHEET No.	TOTAL SHEETS
HAWAII	HAW.	350(6)(8) UNIT 2	1963	80	105

FINAL SURVEY — SURVEYED, PLOTTED, TRIANGULATE, NOTE BOOK, NO., AREAS, AREAS CHECKED, BY, DATE

ORIGINAL SURVEY — SURVEYED, PLOTTED, TRIANGULATE, NOTE BOOK, NO., AREAS, AREAS CHECKED, BY, DATE

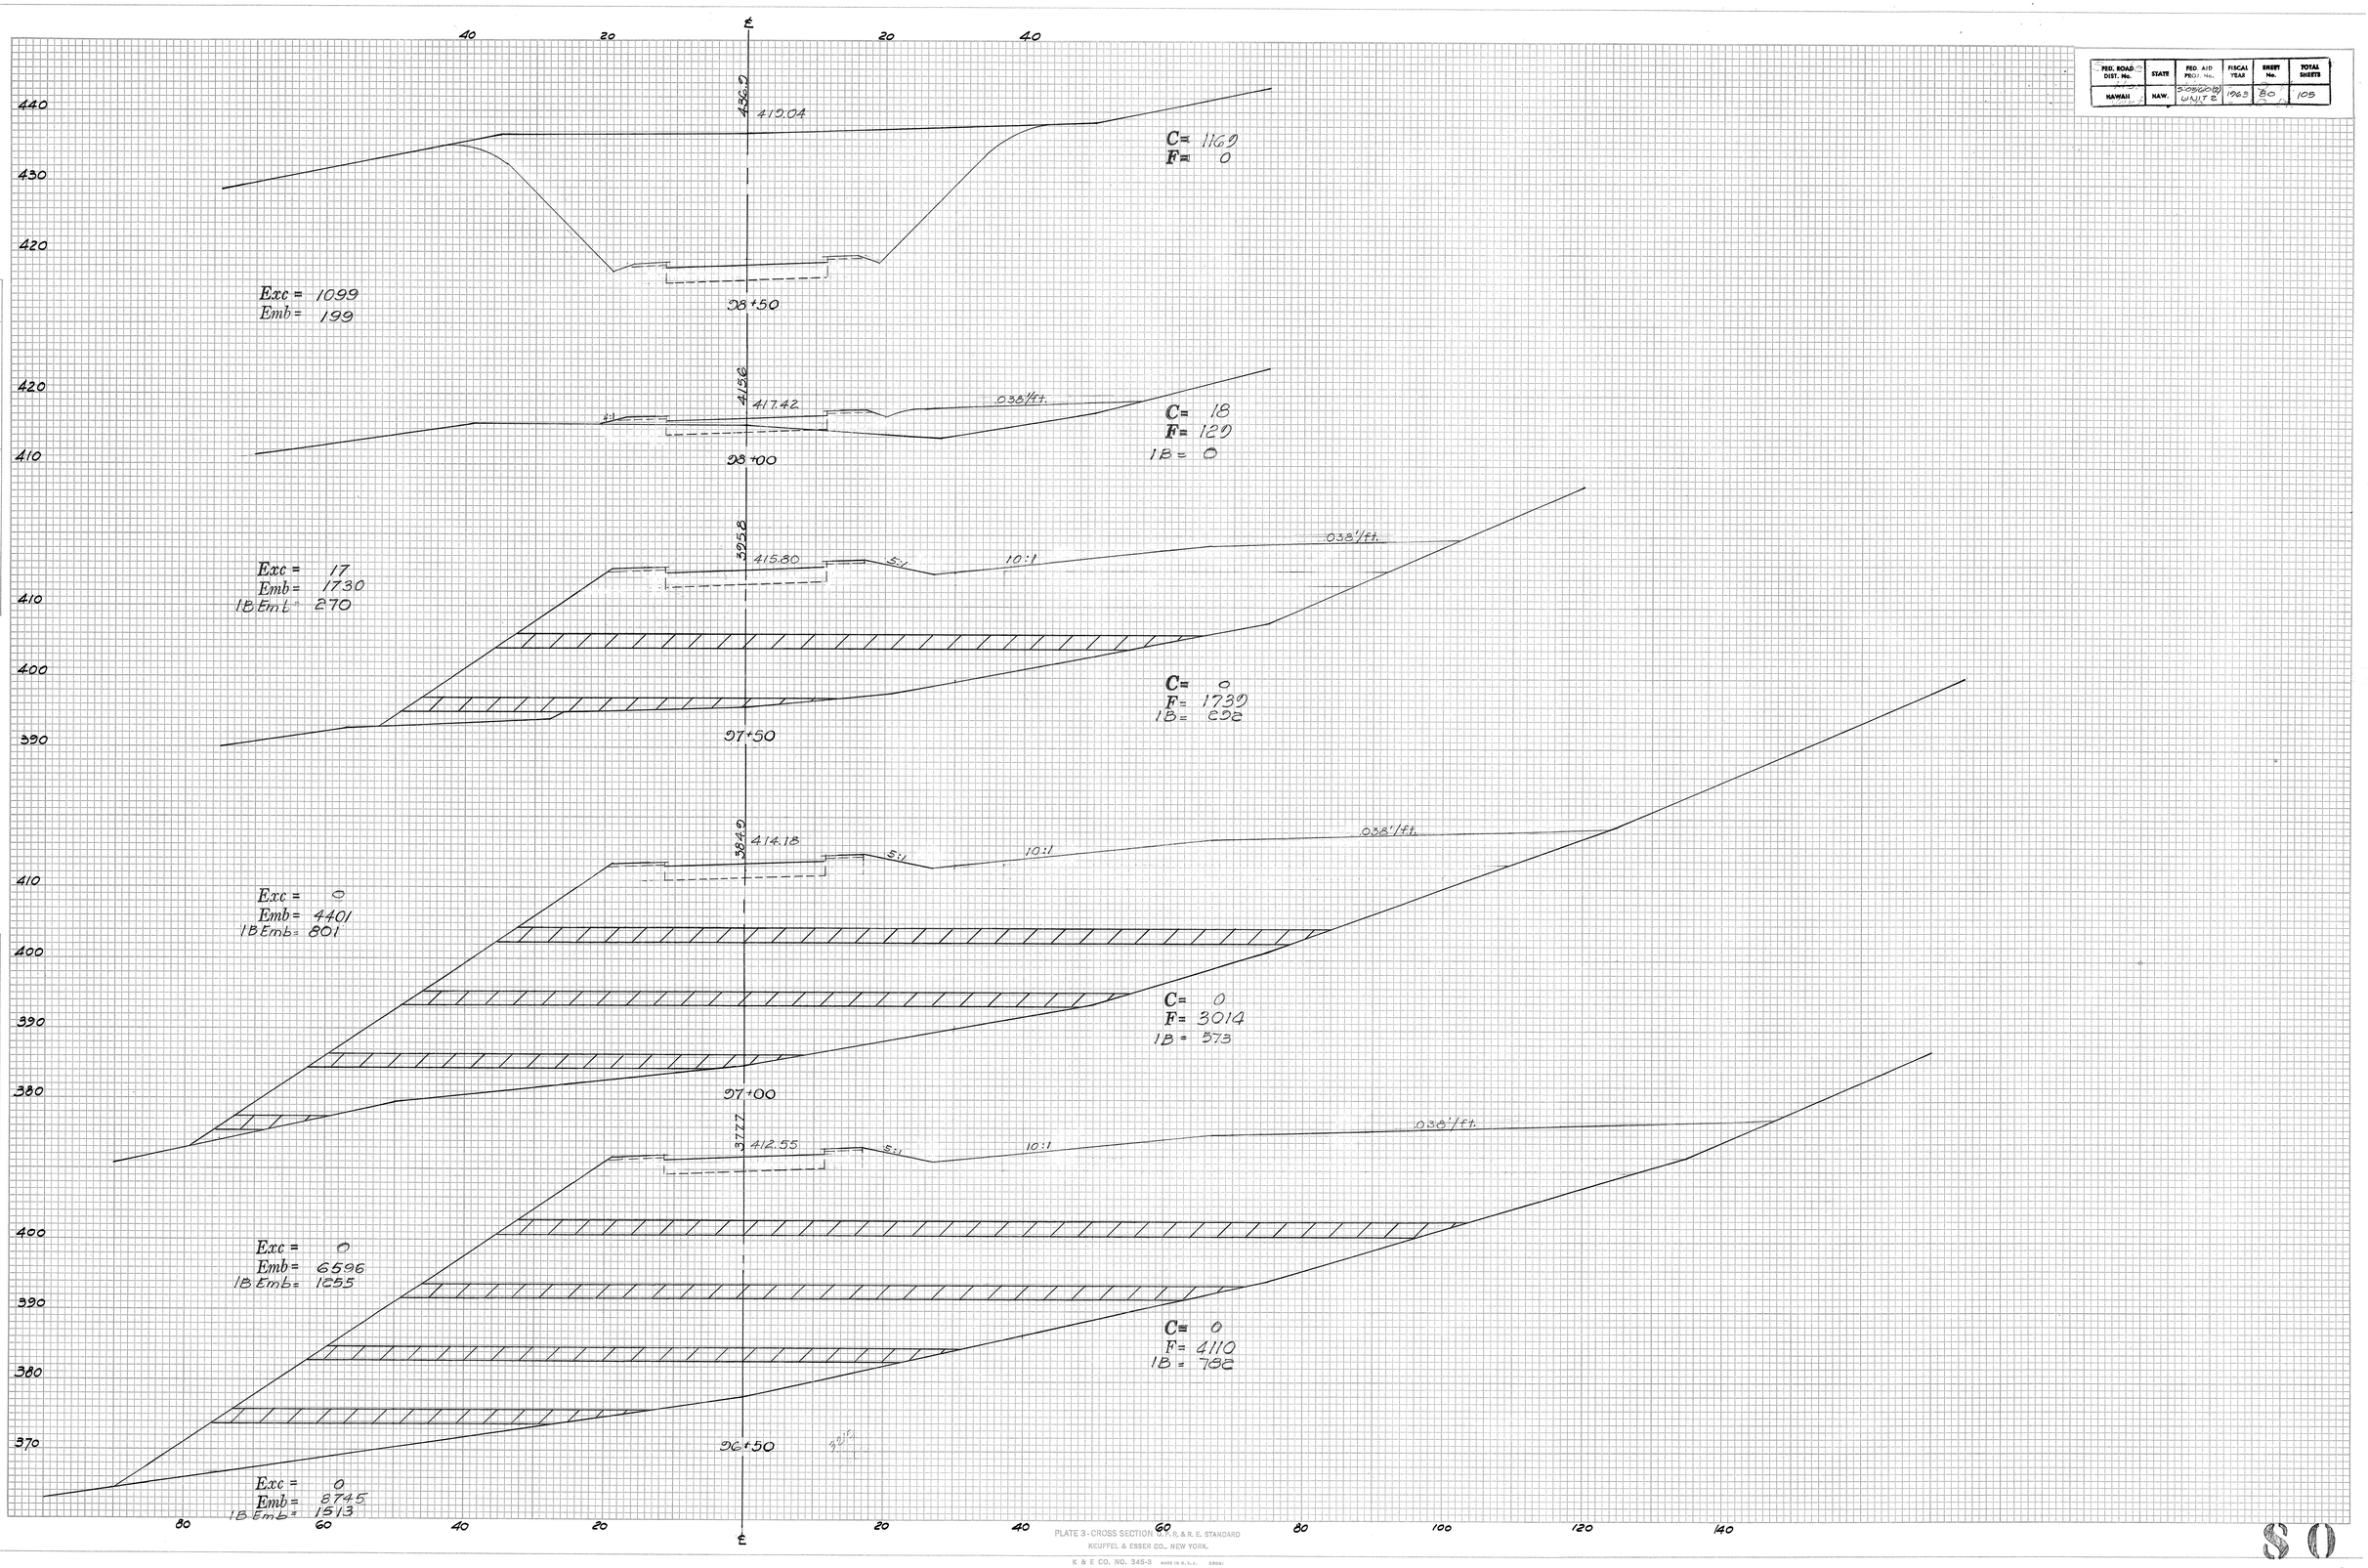

PLATE 3 - CROSS SECTION U.P.R. & R. E. STANDARD
KEUFFEL & ESSER CO., NEW YORK.

K & E CO. NO. 345-3 MADE IN U.S.A. 2806

80

21

FED. ROAD DIST. No.	STATE	FED. AID PROJ. No.	FISCAL YEAR	SHEET No.	TOTAL SHEETS
HAWAII	HAW.	S-0860(8) UNIT 2	1963	81	105

FINAL SURVEY — SURVEYED BY, PLOTTED DATE, TYPED DATE, AREAS, AREAS CHECKED, NOTE BOOK, NO.

ORIGINAL SURVEY — SURVEYED BY, PLOTTED DATE, TYPED DATE, AREAS, AREAS CHECKED, NOTE BOOK, NO.

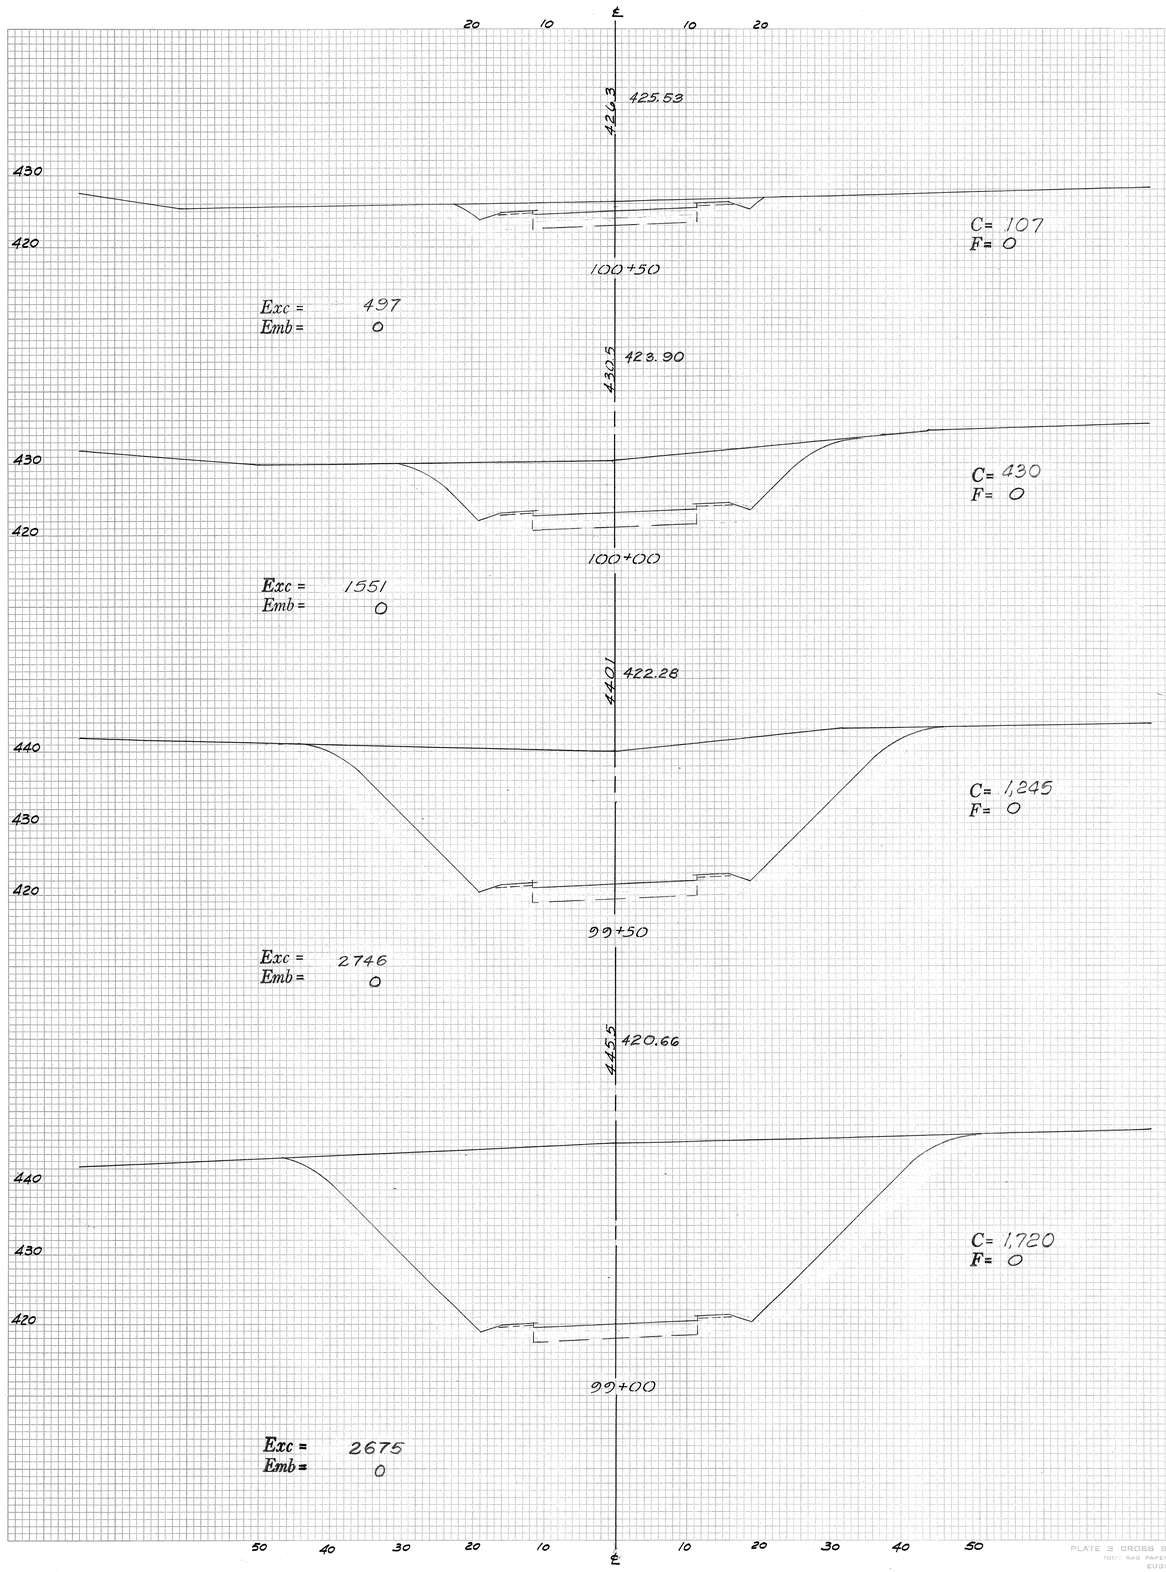

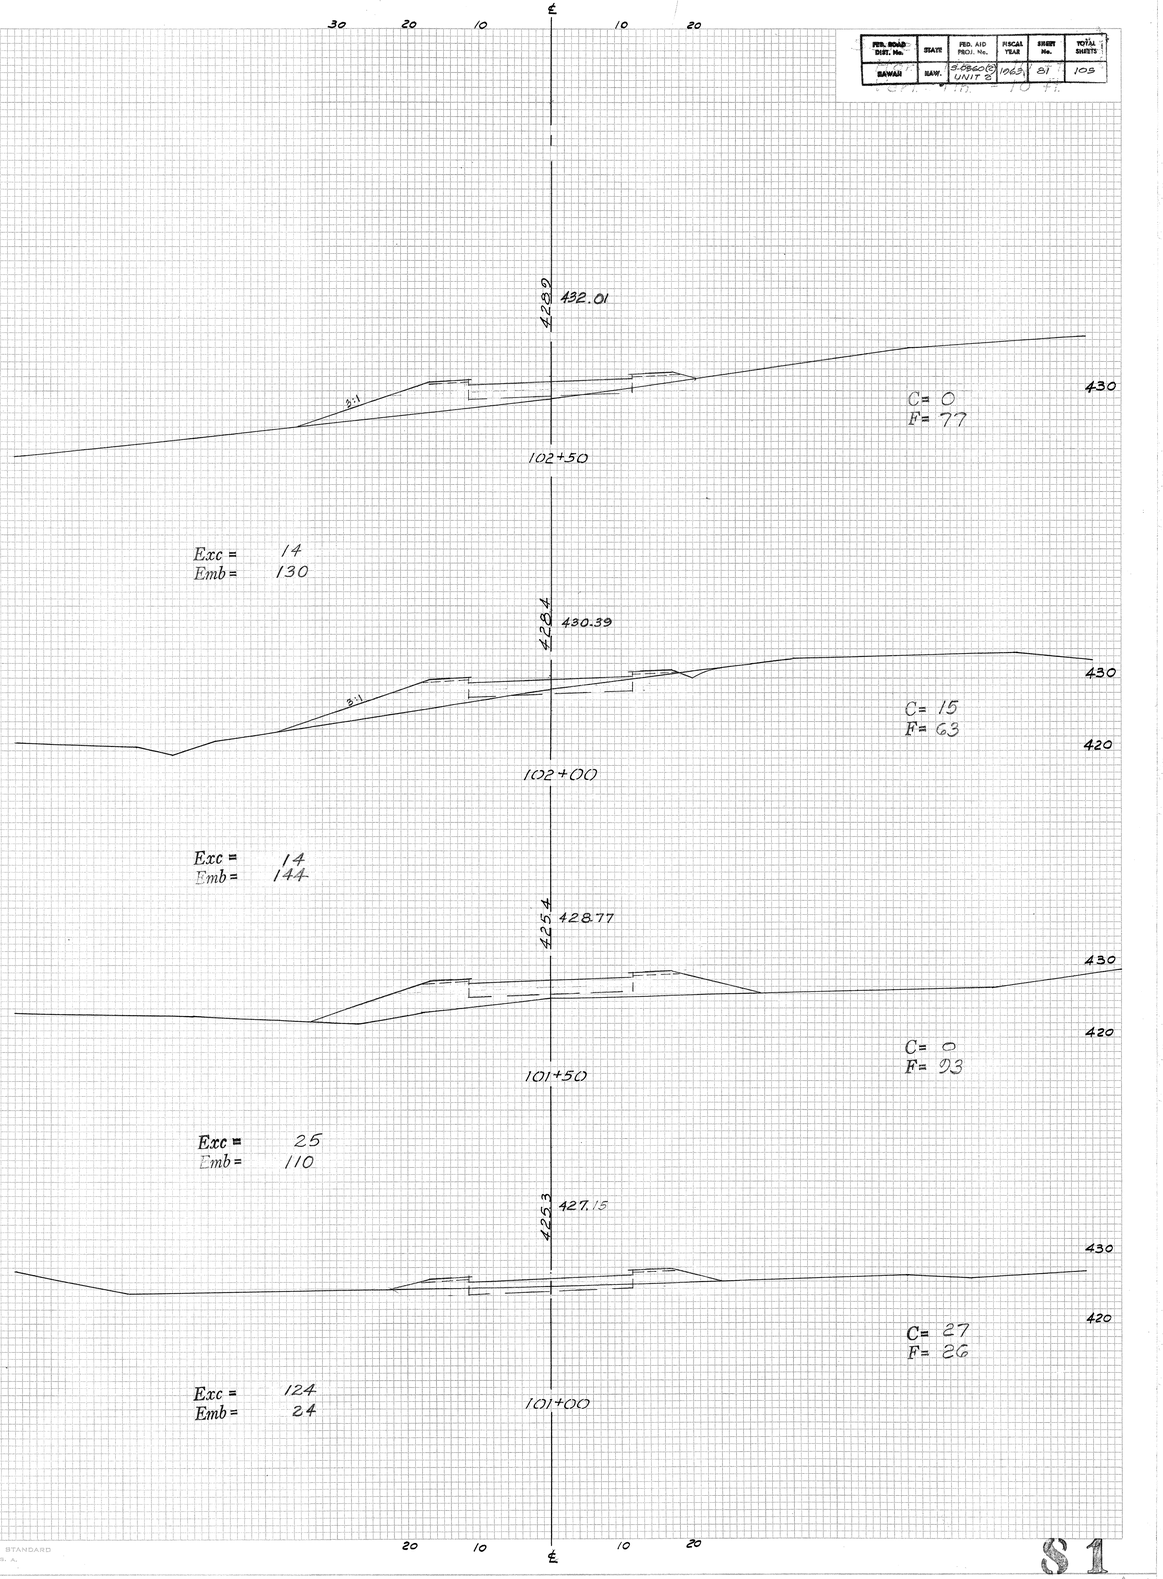

PLATE 3 CROSS SECTION U. P. R. & R. E. STANDARD
100 % RAG PAPER MADE AND PRINTED IN U. S. A.
EUGENE DIETZGEN CO.

S1

FED. ROAD DIST. No.	STATE	FED. AID PROJ. No.	FISCAL YEAR	SHEET No.	TOTAL SHEETS

FINAL SURVEY — NOTE BOOK NO. — SURVEYED — PLOTTED — TEMPLATE — AREAS — AREAS CHECKED — BY — DATE

ORIGINAL SURVEY — NOTE BOOK NO. — SURVEYED — PLOTTED — TEMPLATE — AREAS — AREAS CHECKED — BY — DATE

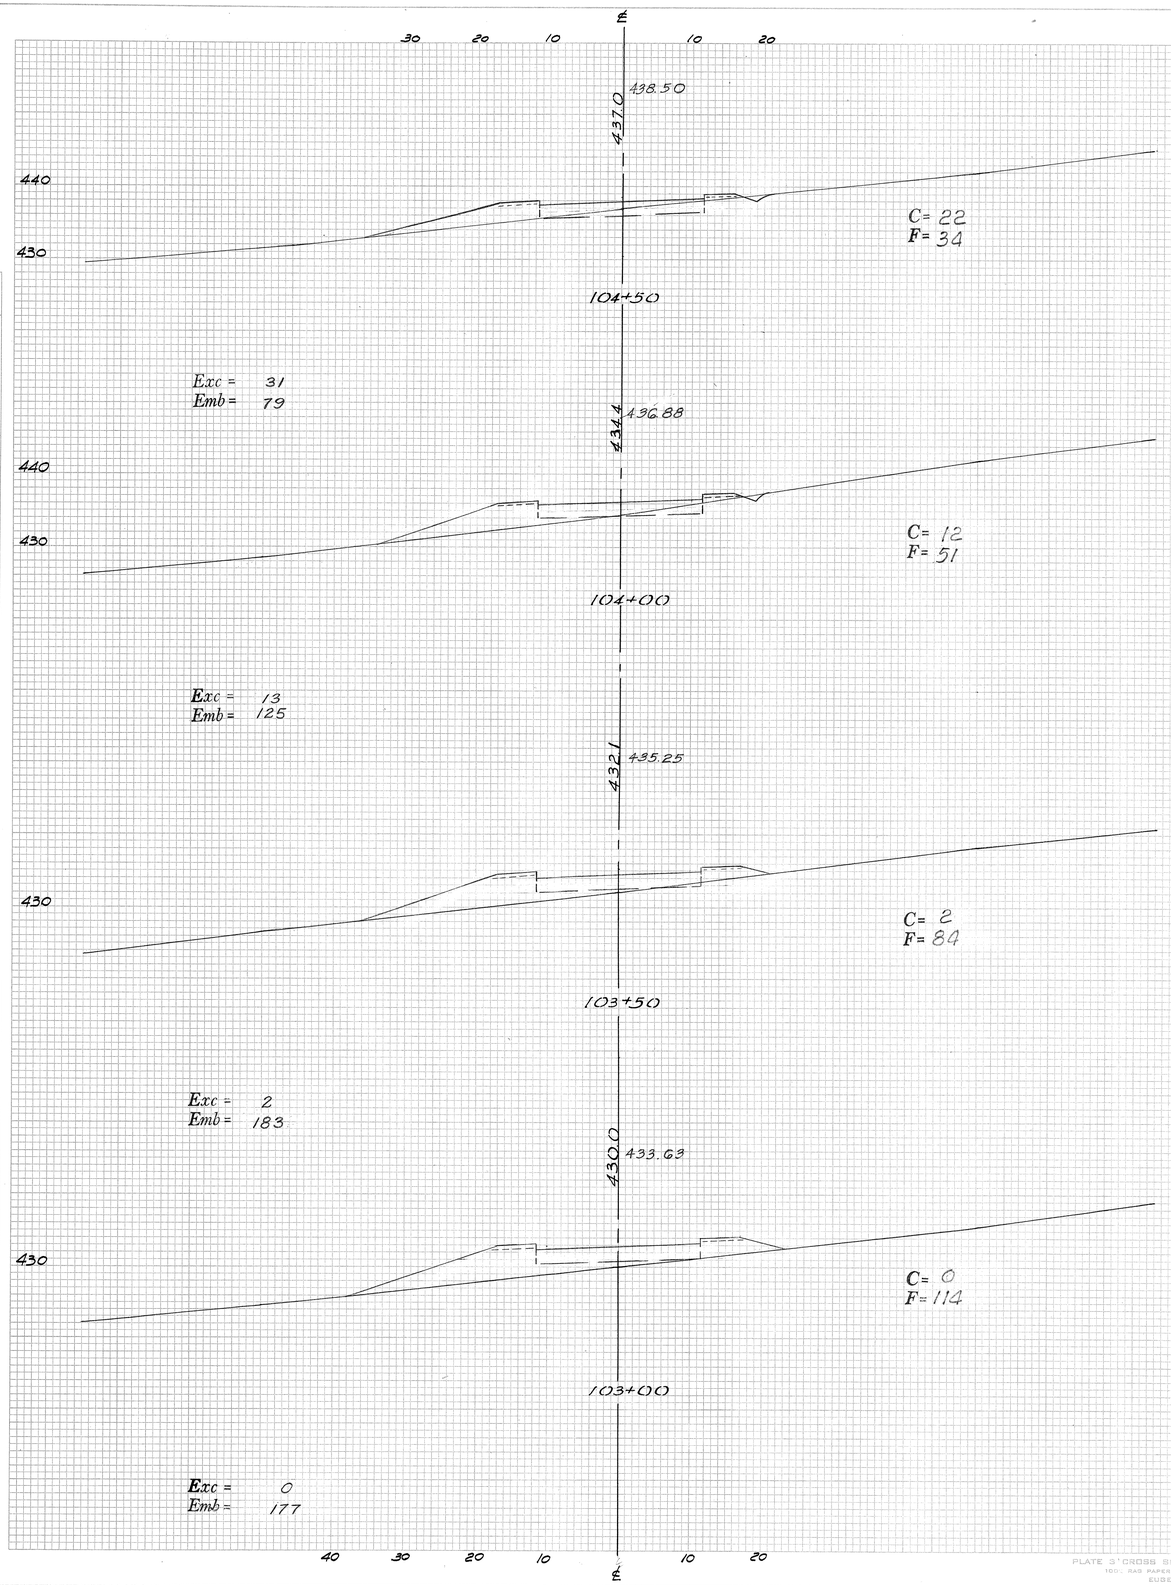

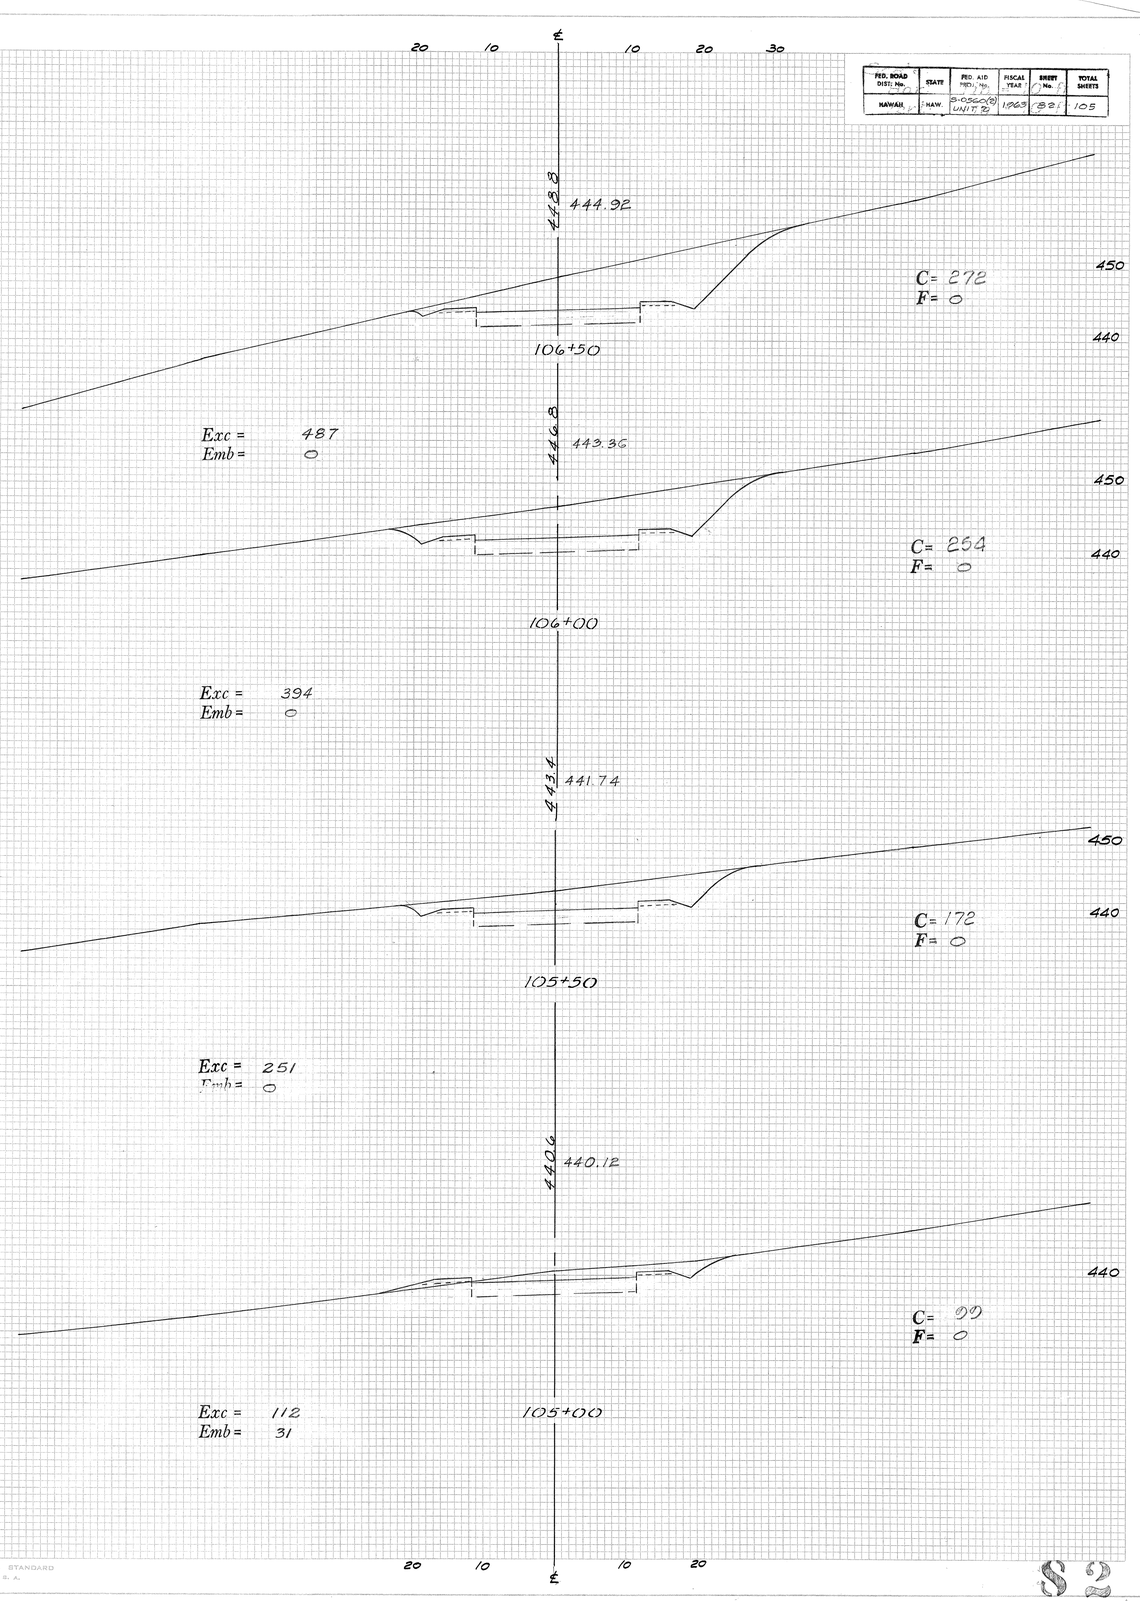

S 2

FED. ROAD DIST. No.	STATE	FED. AID PROJ. No.	FISCAL YEAR	SHEET No.	TOTAL SHEETS

FINAL SURVEY — SURVEYED / PLOTTED / TEMPLATE AREAS / AREAS CHECKED — BY — DATE — NOTE BOOK — NO.

ORIGINAL SURVEY — SURVEYED / PLOTTED / TEMPLATE AREAS / AREAS CHECKED — BY — DATE — NOTE BOOK — NO.

40 30 20 10 ℄ 10 20 30

450
440
430

433.8 441.67

C= 0
F= 585
IB = 98

107+50

Exc = 157
Emb = 597
IB Emb = 91

447.4 446.36

460
450
440
430

C= 170
F= 60
IB = 0

107+00

Exc = 409
Emb = 56

30 20 10 ℄ 10 20 30 40

40 30 20 10 ℄ 10 20 30 40

466.3 450.84

470
460
450

C= 1024
F= 0

109+00

Exc = 1442
Emb = 0

458.5 449.91

460
450

C= 533
F= 0

108+50

Exc = 494
Emb = 96

445.1 448.85

450
440

C= 0
F= 104
IB = 0

108+00

Exc = 0
Emb = 638
IB Emb = 91

20 10 ℄ 10 20

PLATE 3 CROSS SECTION C. P. R. & R. E. STANDARD
100% RAG PAPER MADE AND PRINTED IN U. S. A.
EUGENE DIETZGEN CO.

FED. ROAD DIST. No.	STATE	FED. AID PROJ. No.	FISCAL YEAR	SHEET No.	TOTAL SHEETS
HAWAII	HAW.	S-0550(8) UNIT 2	1963	84	105

FINAL SURVEY — NOTE BOOK NO. — SURVEYED, PLOTTED, TEMPLATE AREAS, AREAS CHECKED — BY — DATE

ORIGINAL SURVEY — NOTE BOOK NO. — SURVEYED, PLOTTED, TEMPLATE AREAS, AREAS CHECKED — BY — DATE

4710 452.90

480 470 460 450

C= 1500
F= 0

Exc = 2834
Emb = 0

110+50

4737 452.33

470 460 450

C= 1471
F= 0

Exc = 2477
Emb = 0

110+00

4628 451.65

470 460 450

C= 1204
F= 0

Exc = 2063
Emb = 0

100+50

4451 453.89

450 440

C= 0
F= 321

Exc = 18
Emb = 420

112+50

4517 453.83

450

C= 19
F= 63

Exc = 381
Emb = 58

112+00

4603 453.64

460 450

C= 392
F= 0

Exc = 1462
Emb = 0

111+50

4725 453.33

470 460 450

C= 1187
F= 0

Exc = 2571
Emb = 0

111+00

40 30 20 10 ℄ 10 20 30 40 50

PLATE 3 CROSS SECTION C. P. R. & R. E. STANDARD
100% RAG PAPER—MADE AND PRINTED IN U. S. A.
EUGENE DIETZGEN CO.

S 4

FED. ROAD DIST. No.	STATE	FED. AID PROJ. No.	FISCAL YEAR	SHEET No.	TOTAL SHEETS
HAWAII	HAWAII	S-0560(9) UNIT B	1963	85	105

FINAL SURVEY — NOTE BOOK ____ NO. ____ — SURVEYED ____ PLOTTED ____ TEMPLATE ____ AREAS ____ AREAS CHECKED ____ — BY ____ DATE ____

ORIGINAL SURVEY — NOTE BOOK ____ NO. ____ — SURVEYED ____ PLOTTED ____ TEMPLATE ____ AREAS ____ AREAS CHECKED ____ — BY ____ DATE ____

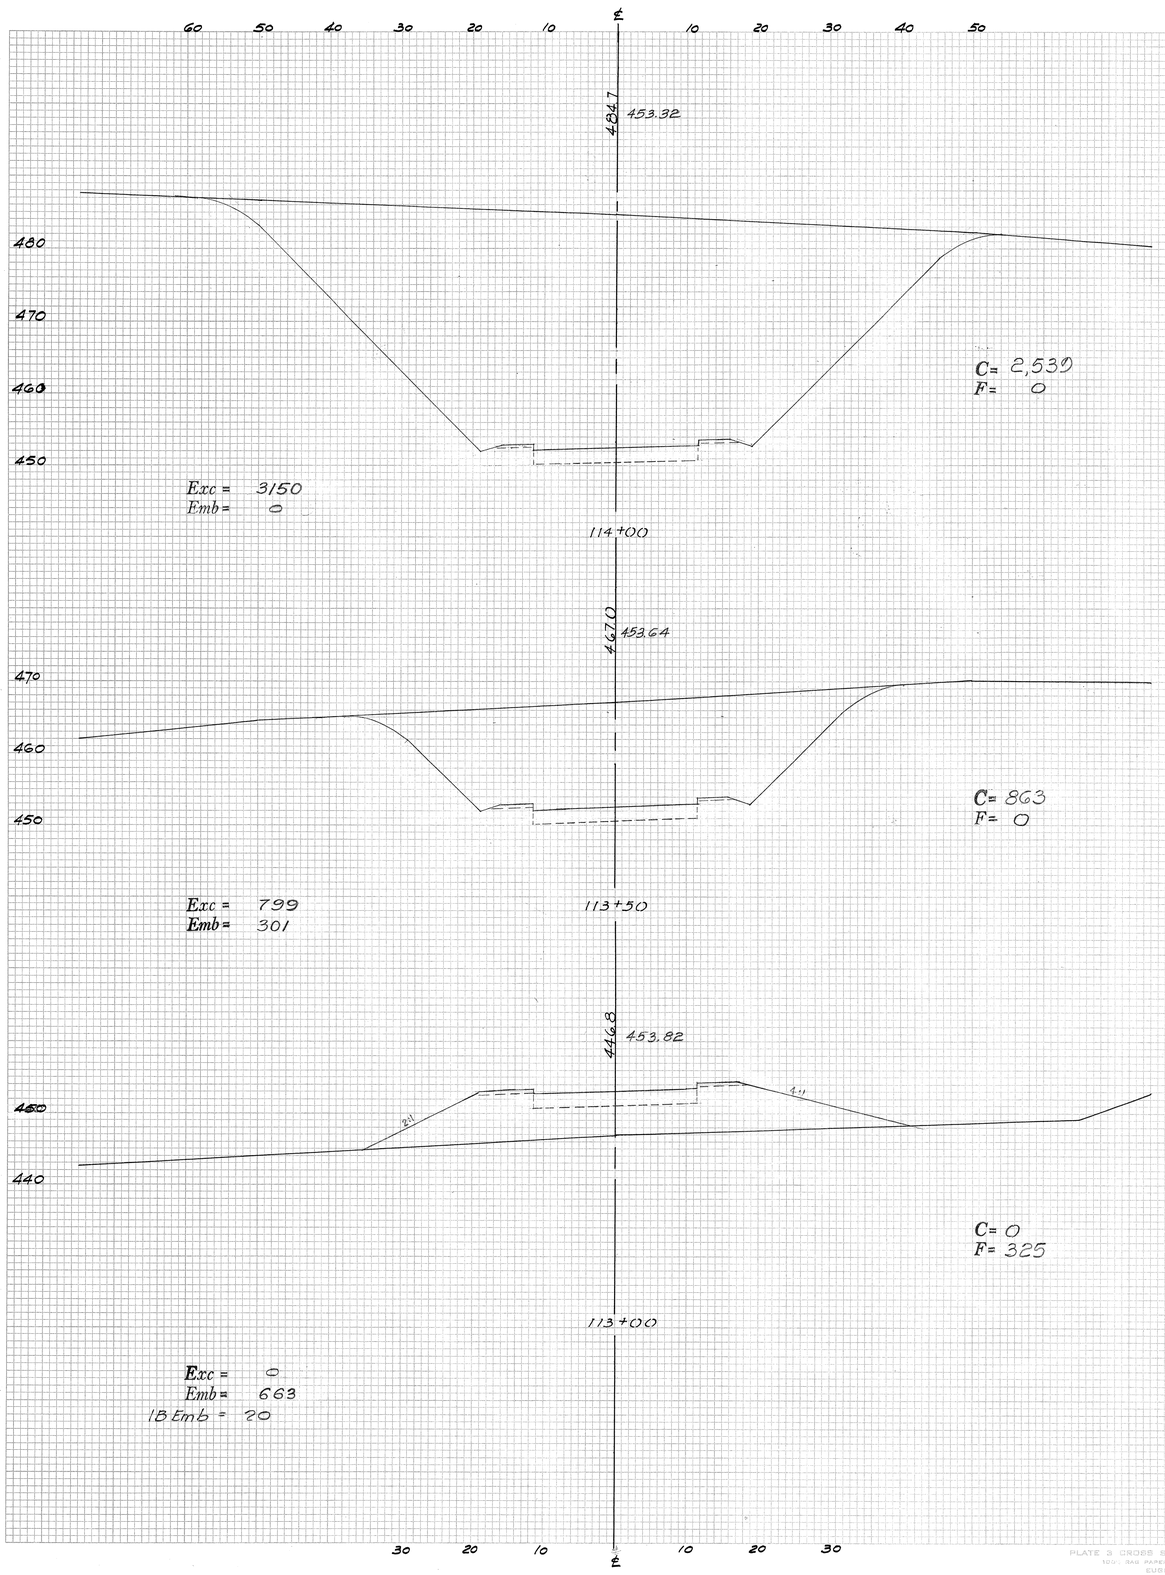

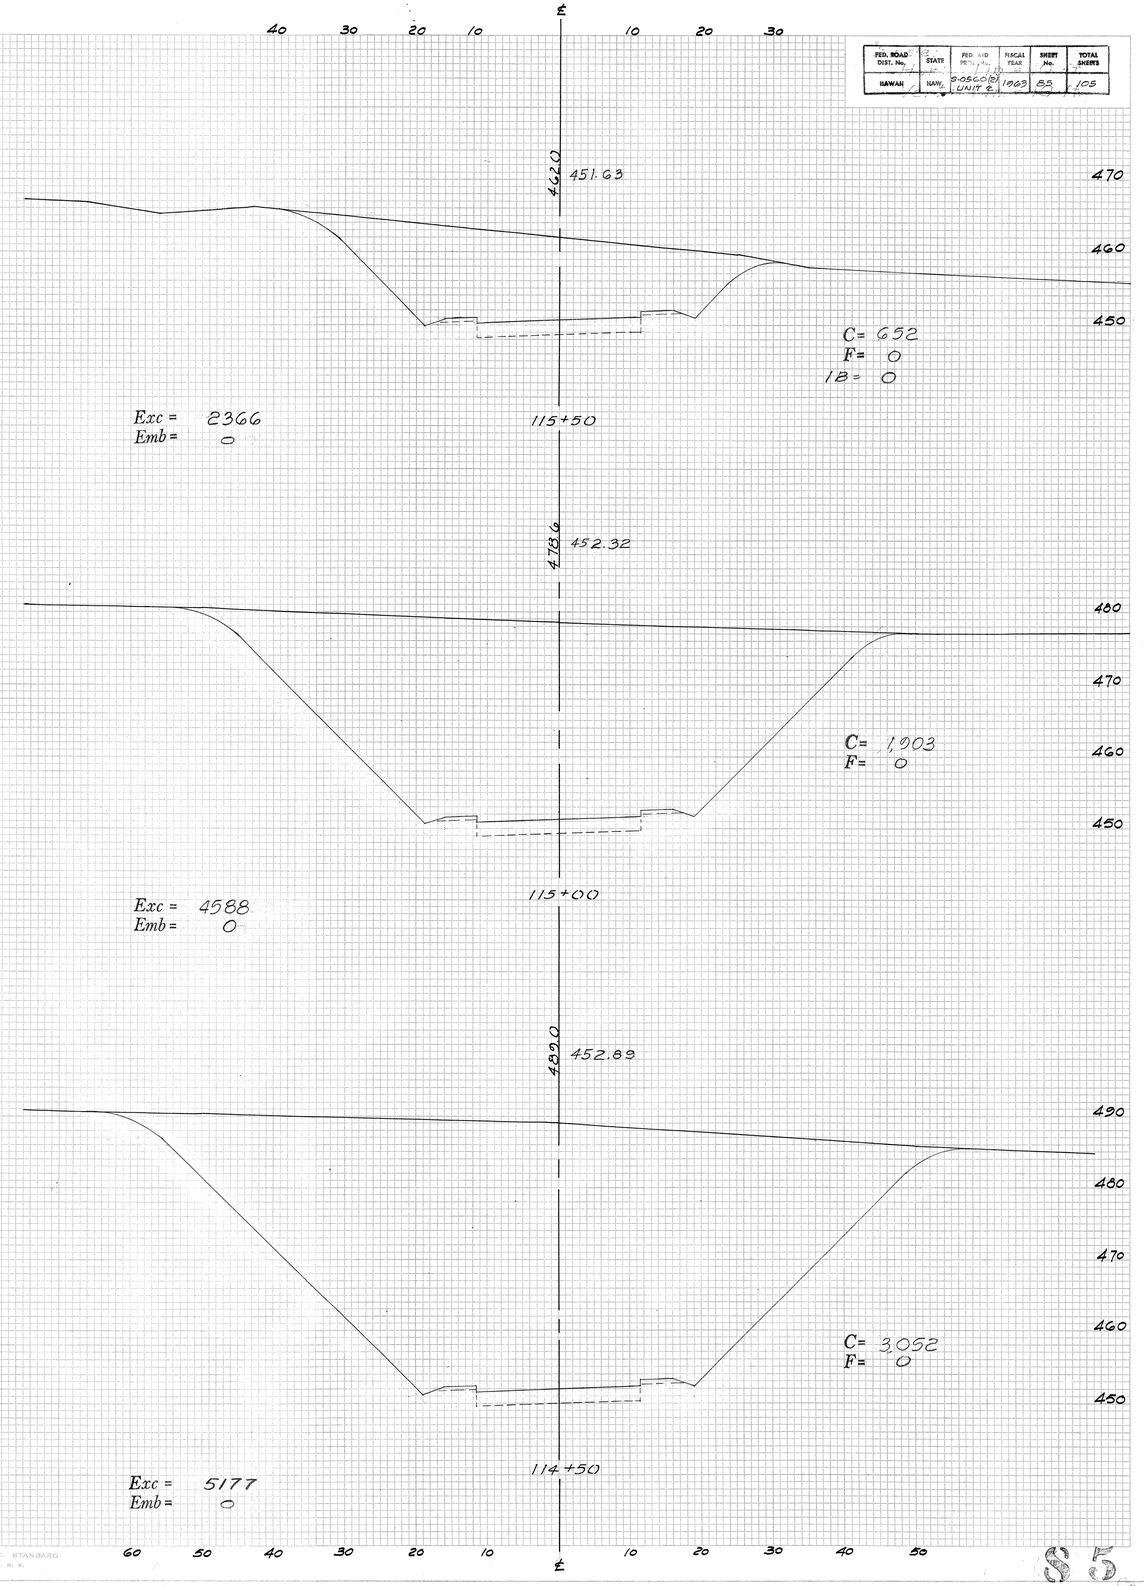

PLATE 3 CROSS SECTION U. P. R. & H. C. STANDARD
100% RAG PAPER-MADE AND PRINTED IN U. S. A.
EUGENE DIETZGEN CO.

FED. ROAD DIST. No.	STATE	FED. AID PROJ.	FISCAL YEAR	SHEET No.	TOTAL SHEETS

FINAL SURVEY — NOTE BOOK — ND. — SURVEYED — PLOTTED — TEMPLATE — TOTALS — AREAS CHECKED — BY — DATE

ORIGINAL SURVEY — NOTE BOOK — ND. — SURVEYED — PLOTTED — TEMPLATE — TOTALS — AREAS CHECKED — BY — DATE

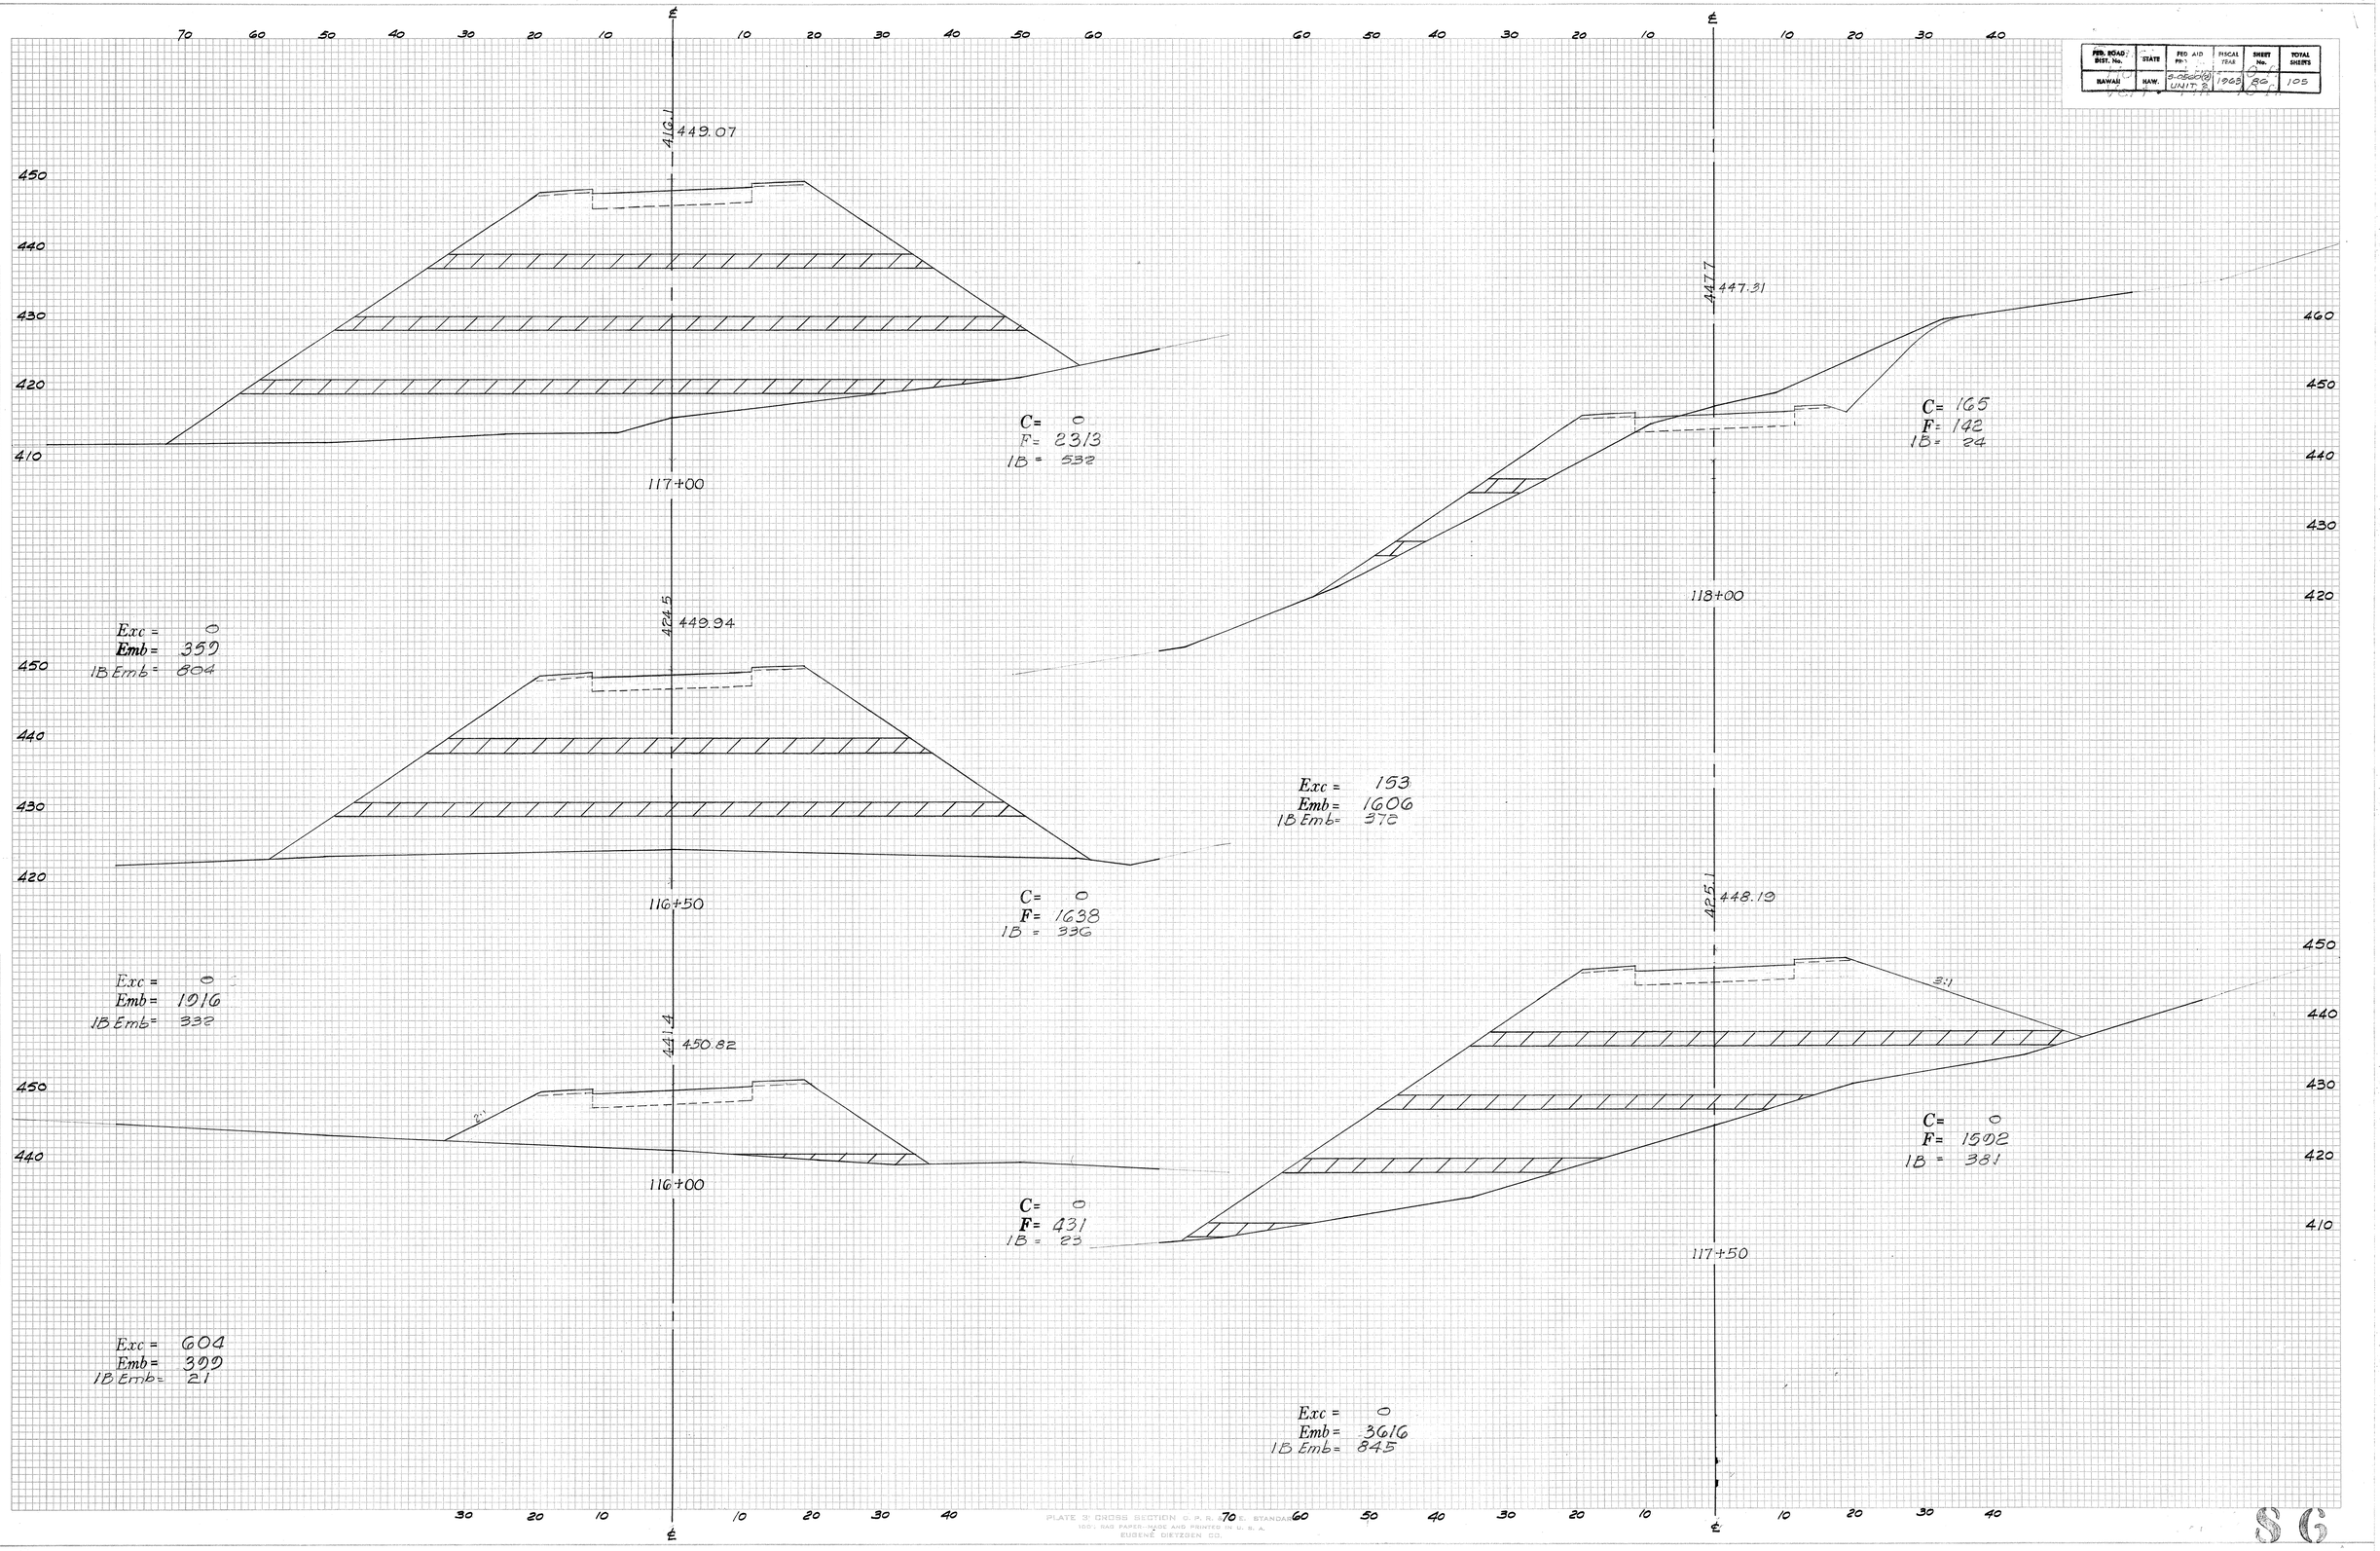

PLATE 3: CROSS SECTION C. P. R. R. STANDARD
100% RAG PAPER—MADE AND PRINTED IN U. S. A.
EUGENE DIETZGEN CO.

SG

FED. ROAD DIST. No.	STATE	FED. AID PROJ. NO.	FISCAL YEAR	SHEET No.	TOTAL SHEETS

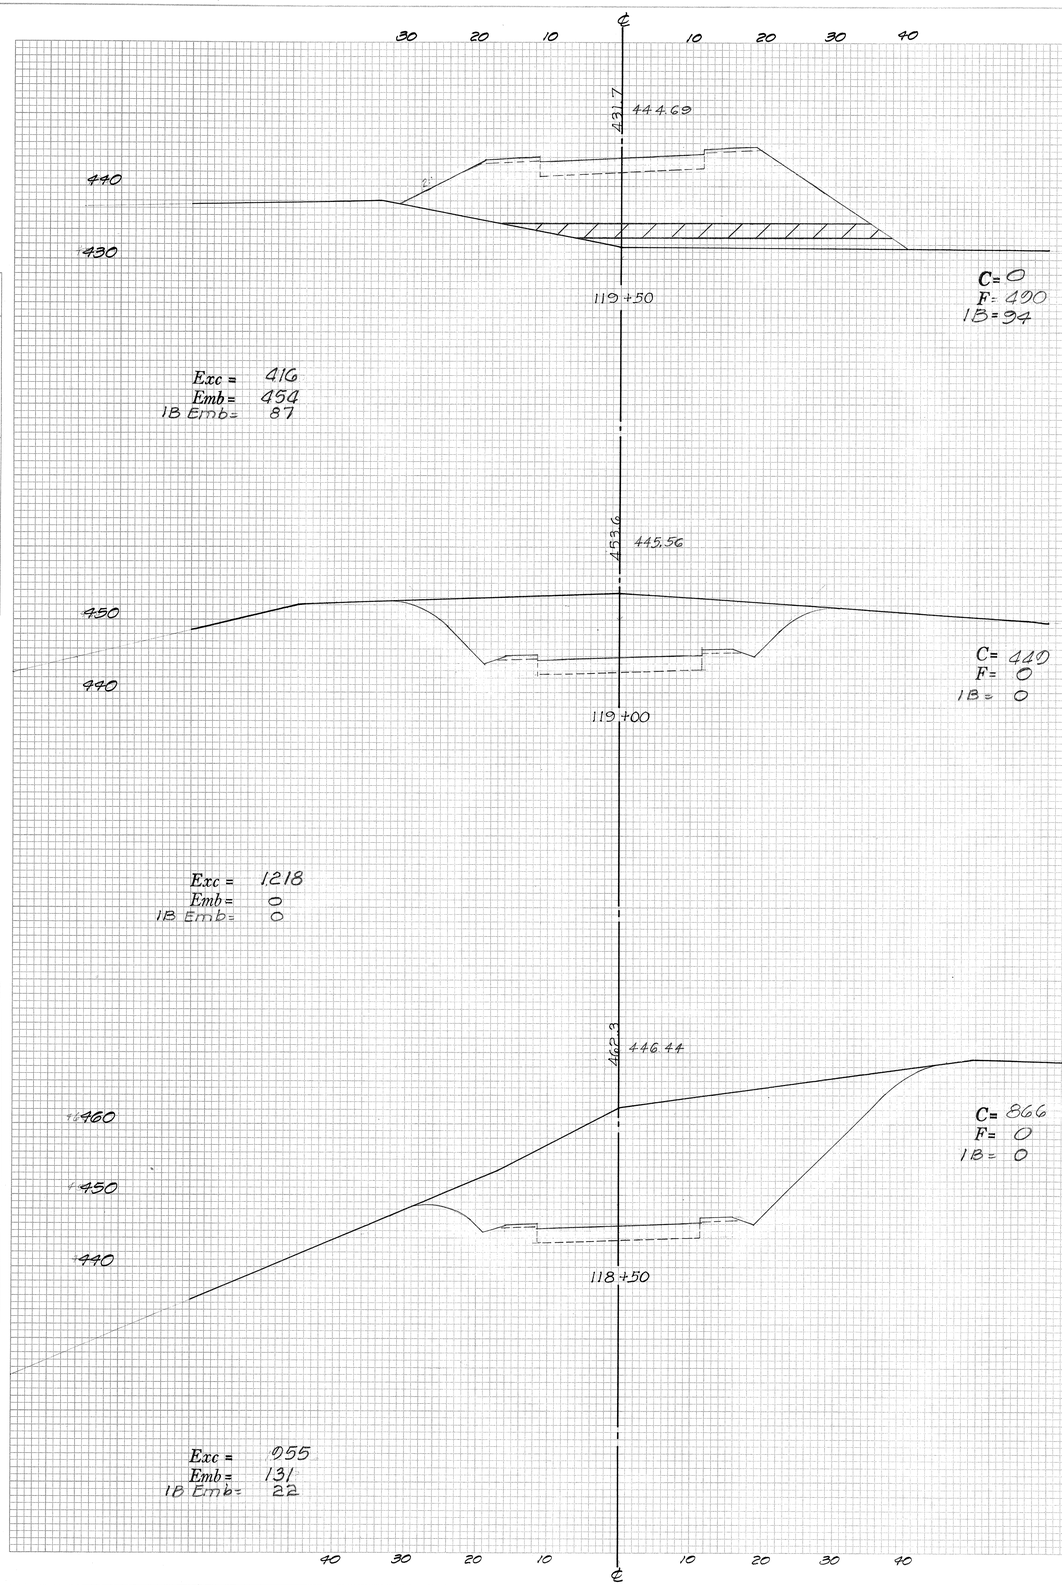

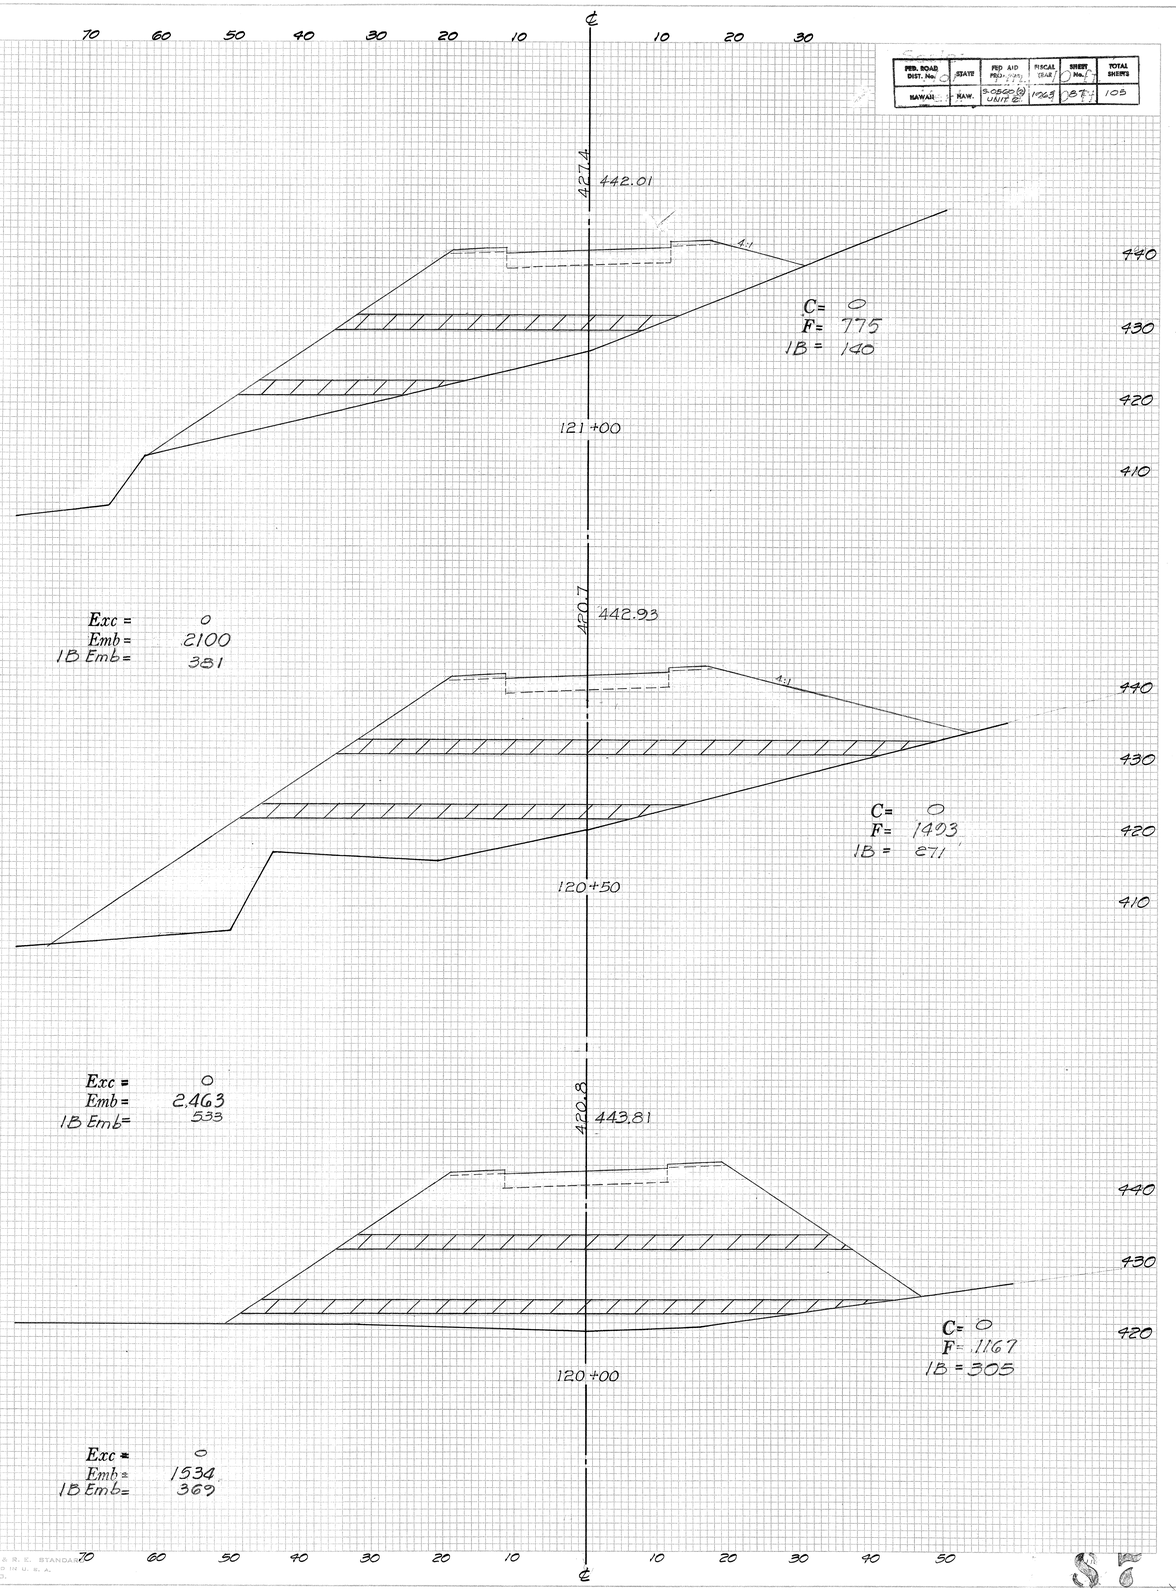

PLATE 3 CROSS SECTION U. P. R. & R. K. STANDARD
100% RAG PAPER-MADE AND PRINTED IN U. S. A.
EUGENE DIETZGEN CO.

S6

DATE
BY
FINAL SURVEY
SURVEYED
PLOTTED
NOTE BOOK
TEMPLATE
AREAS
NO.
AREAS CHECKED

ORIGINAL SURVEY
SURVEYED
PLOTTED
NOTE BOOK
TEMPLATE
AREAS
NO.
AREAS CHECKED

FED. ROAD DIST. No.	STATE	FED. AID PROJ. No.	FISCAL YEAR	SHEET No.	TOTAL SHEETS

FINAL SURVEY — NOTE BOOK — NO. — SURVEYED — PLOTTED — TEMPLATE — AREAS — AREAS CHECKED — BY — DATE

ORIGINAL SURVEY — NOTE BOOK — NO. — SURVEYED — PLOTTED — TEMPLATE — AREAS — AREAS CHECKED — BY — DATE

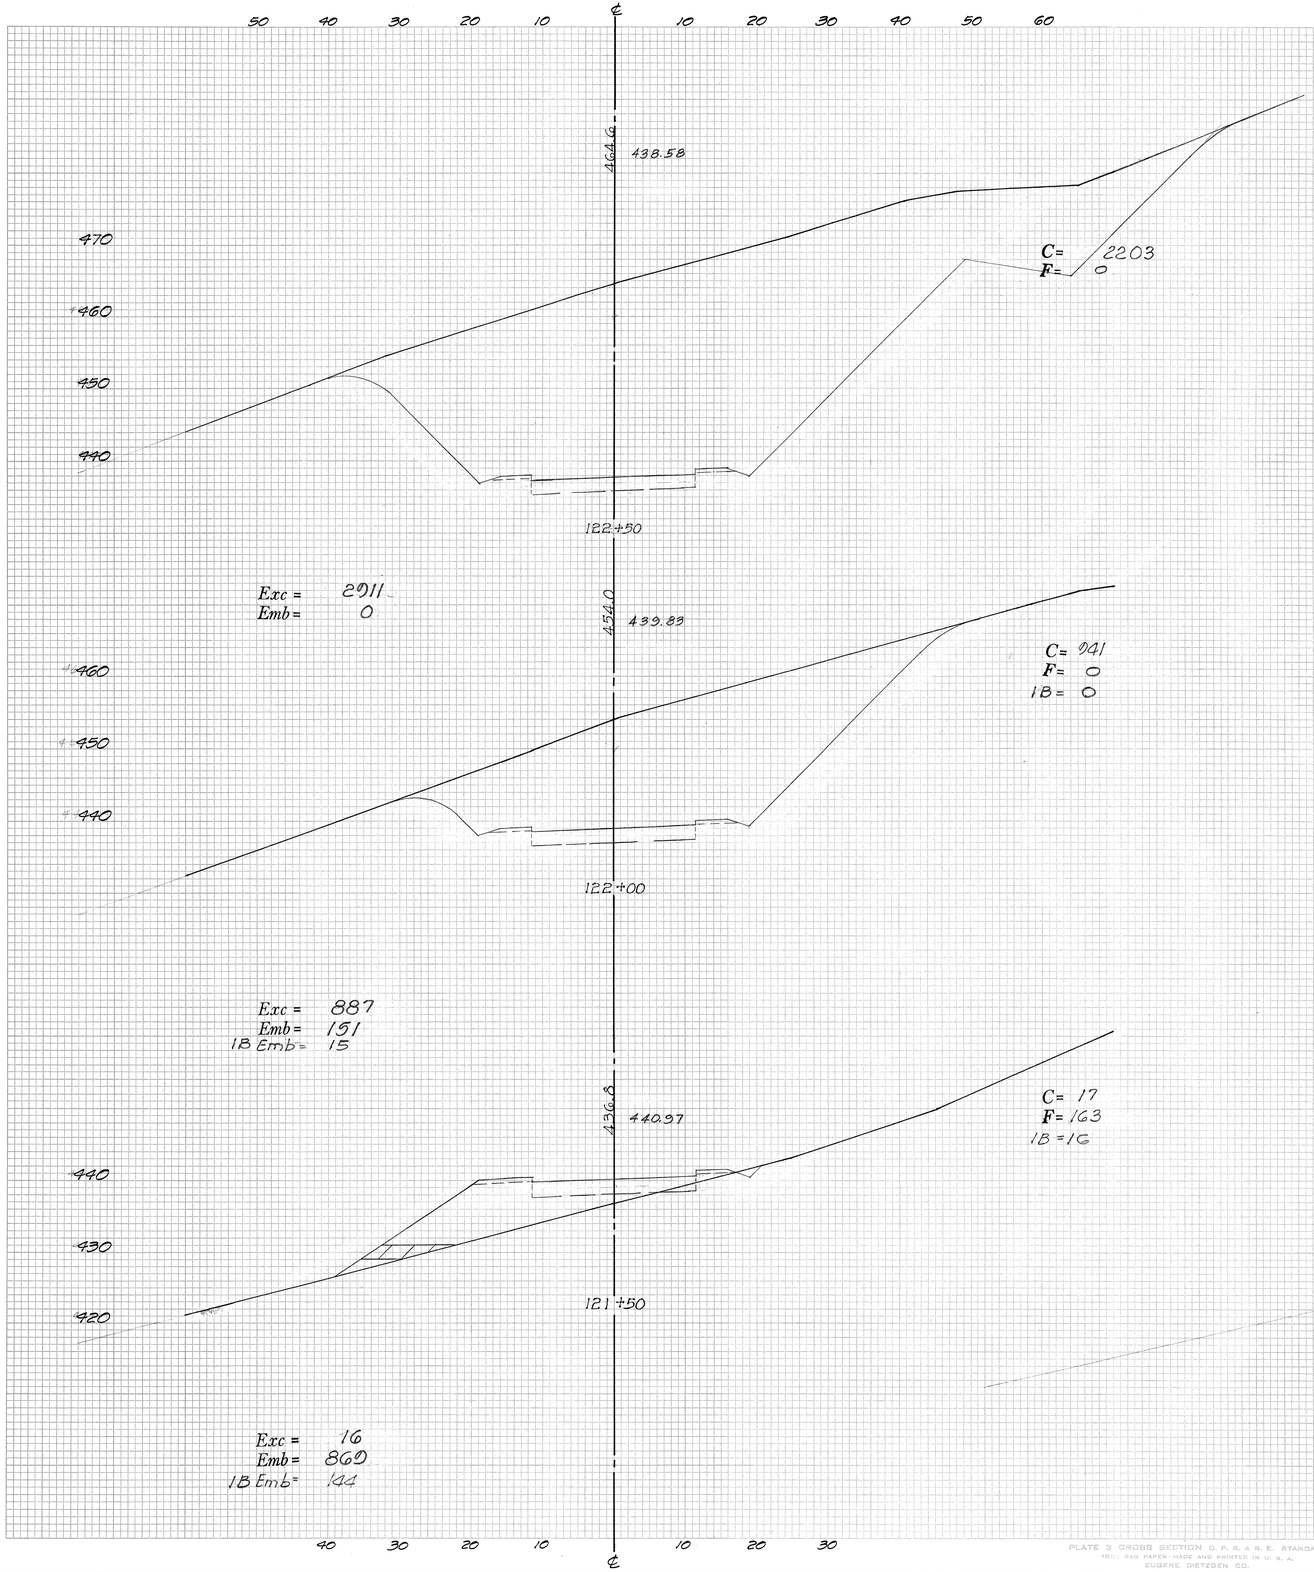

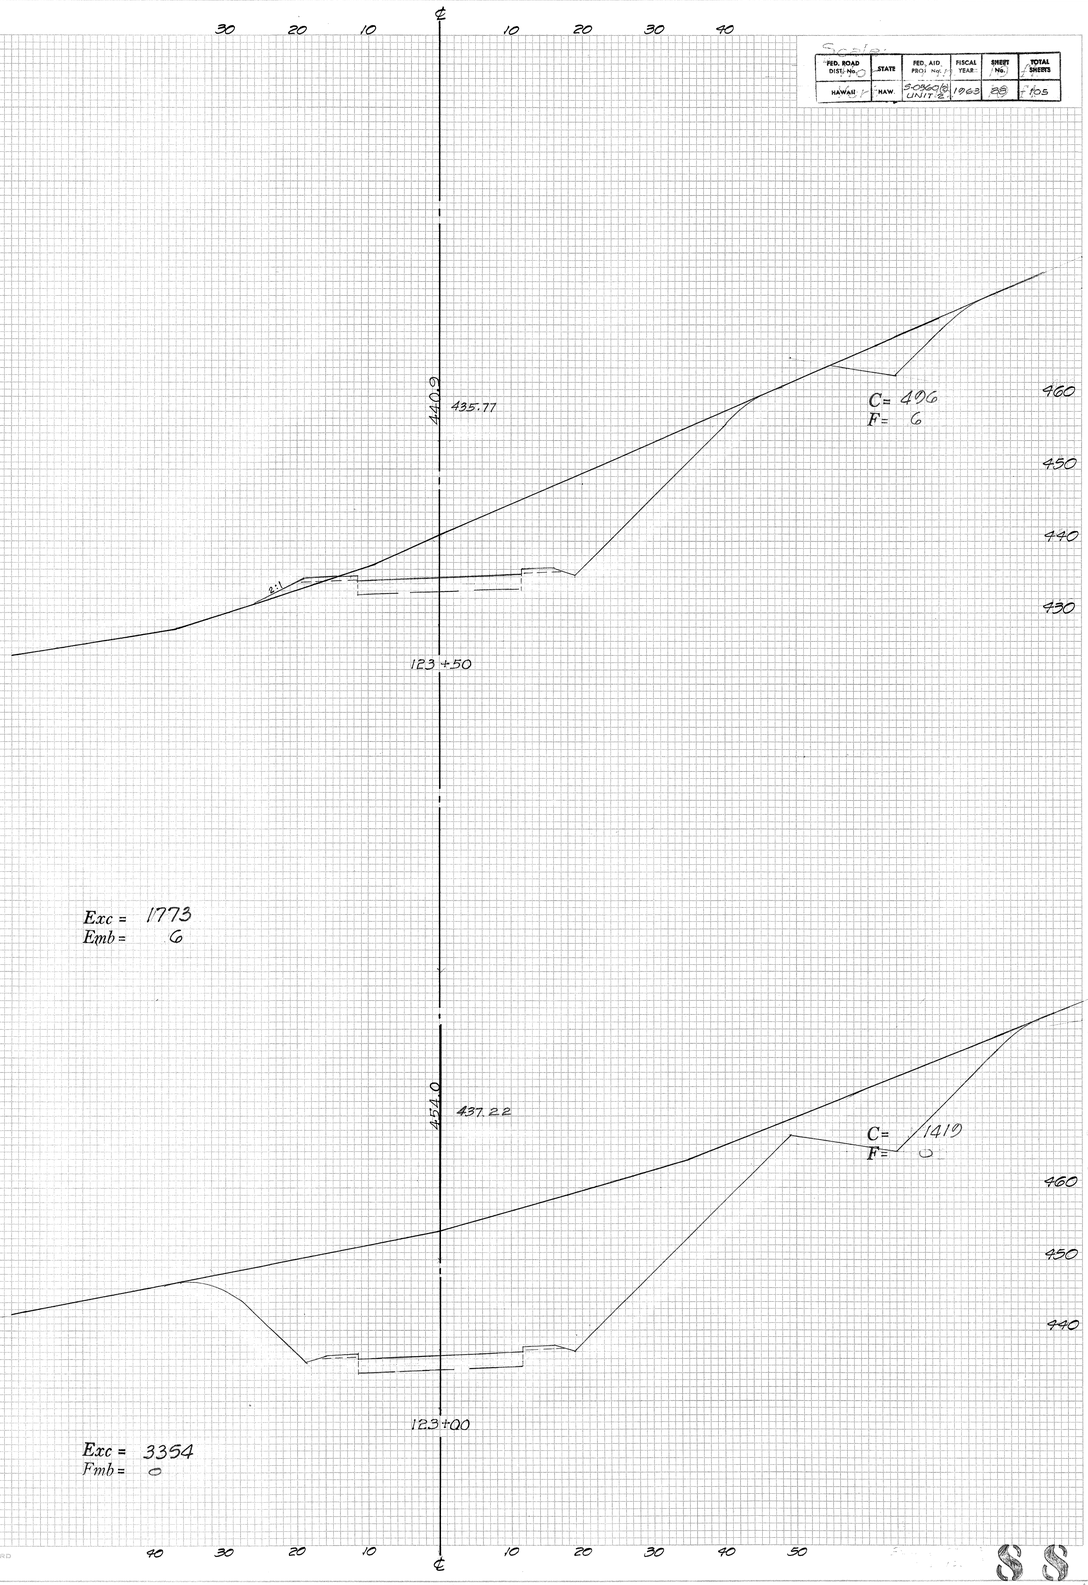

PLATE 3 CROSS SECTION D. P. R. & R. E. STANDARD
100% RAG PAPER-MADE AND PRINTED IN U. S. A.
EUGENE DIETZGEN CO.

FED. ROAD DIST. No.	STATE	FED. AID PROJ. No.	FISCAL YEAR	SHEET No.	TOTAL SHEETS
HAWAII	HAW.	S-0560(8) UNIT 2	1963	89	105

FINAL SURVEY — SURVEYED BY; NOTE BOOK; NO.; COMPUTED BY; TEMPLATE AREAS; AREAS CHECKED; BY; DATE

ORIGINAL SURVEY — SURVEYED BY; NOTE BOOK; NO.; COMPUTED BY; TEMPLATE AREAS; AREAS CHECKED ✓; BY; DATE

60 50 40 30 20 10 ℄ 10 20 30 40 50 60 70

463.7 432.53

C= 3457
F= 0

470 460 450 440 430

124+50

Exc = 4694
Emb = 0

450.5 434.20

C= 1612
F= 0

124+00

Exc = 1052
Emb = 6

60 50 40 30 20 10 ℄ 10 20 30 40 50 60

Exc = 9086
Emb = 0

473.3 428.87

C= 4890
F= 0

490 480 470 460 450 440 430

125+50

475.2 430.73

C= 4923
F= 0

490 480 470 460 450 440 430

125+00

Exc = 7759
Emb = 0

40 30 20 10 ℄ 10 20 30 40 50 60 70

PLATE 3 CROSS SECTION C. P. R. STANDARD
1951 RAG PAPER-MADE AND PRINTED IN U. S. A.
EUGENE DIETZGEN CO.

89

FED. ROAD DIST. No.	STATE	FED. AID PROJECT	FISCAL YEAR	SHEET No.	TOTAL SHEETS
HAWAII	HAW.	S-0960(2) UNIT 2	1963	90	103

FINAL SURVEY — SURVEYED BY, PLOTTED BY, NOTE BOOK, NO., TEMPLATE USED, AREAS CHECKED, DATE, BY

ORIGINAL SURVEY — SURVEYED BY, PLOTTED BY, NOTE BOOK, NO., TEMPLATE USED, AREAS CHECKED ✓, DATE, BY

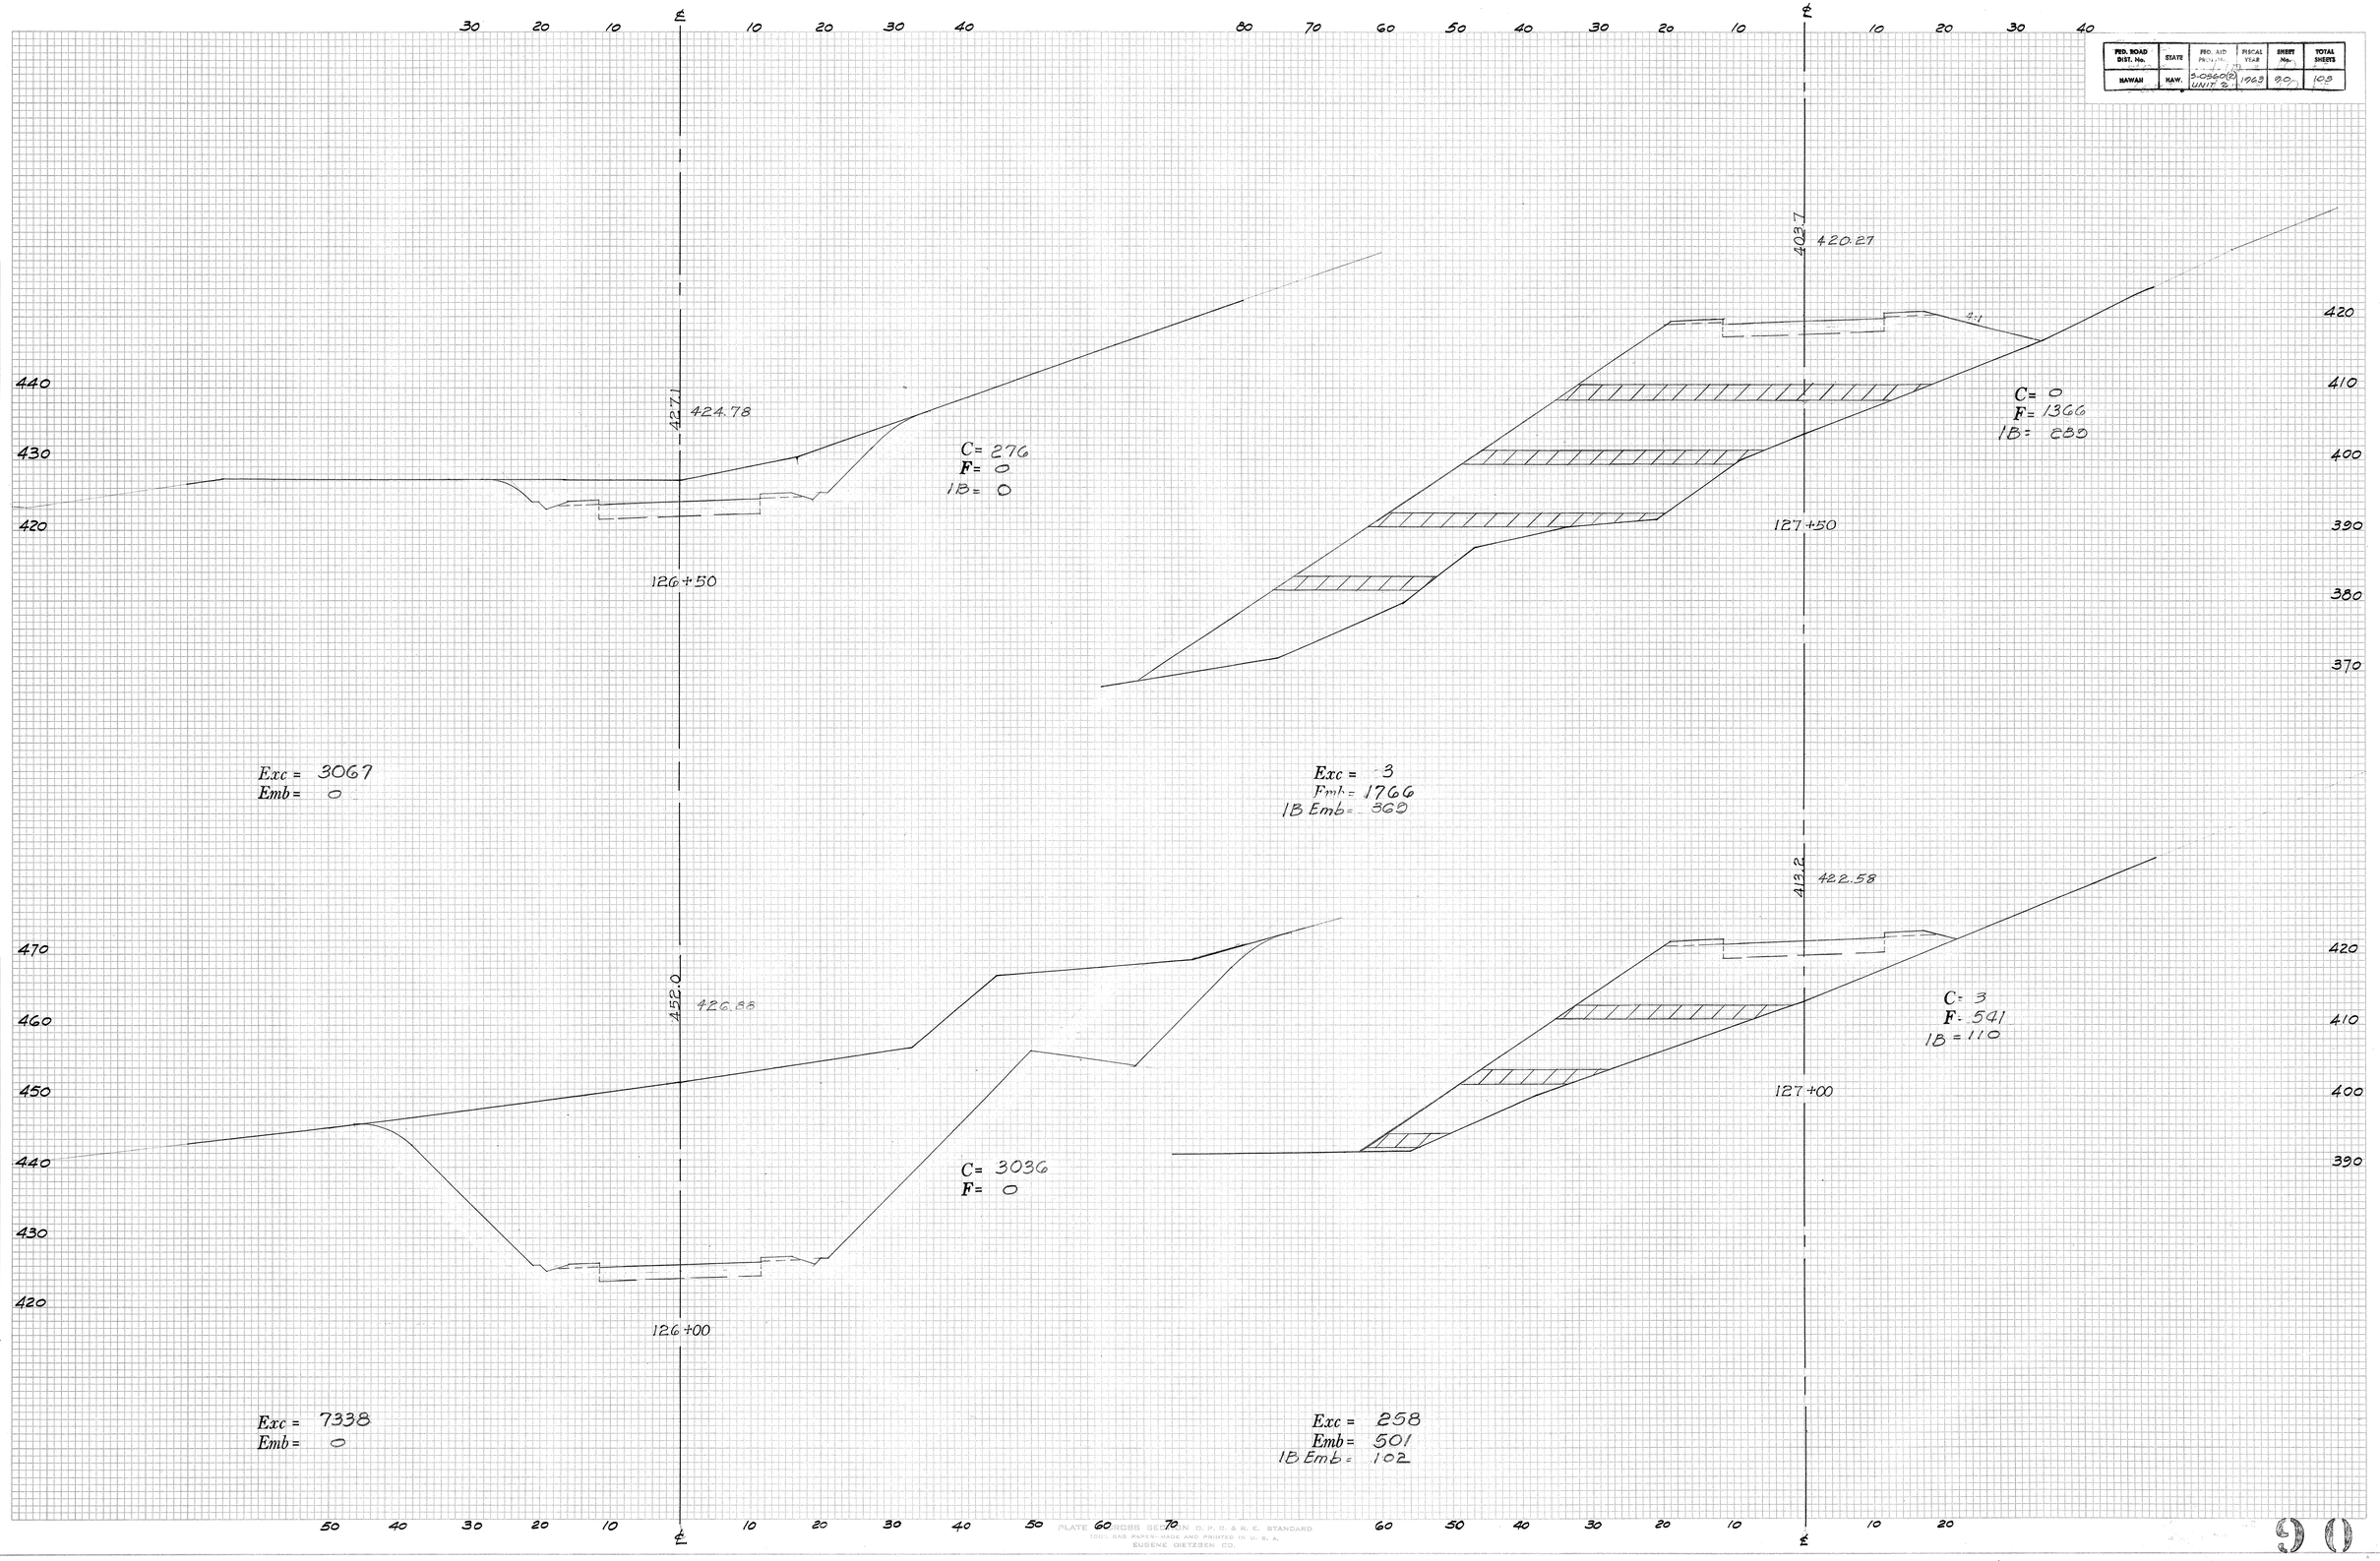

PLATE CROSS SECTION D. P. R. & R. E. STANDARD
100% RAG PAPER MADE AND PRINTED IN U. S. A.
EUGENE DIETZGEN CO.

FED. ROAD DIST. No.	STATE	FED. AID PROJ. NO.	FISCAL YEAR	SHEET No.	TOTAL SHEETS
HAWAII	HAW.	S-0560(6) UNIT B	1963	91	105

FINAL SURVEY — NOTE BOOK — NO. — SURVEYED — PLOTTED — TYPED — AREAS — AREAS CHECKED — BY — DATE

ORIGINAL SURVEY — NOTE BOOK — NO. — SURVEYED — PLOTTED — TYPED — AREAS — AREAS CHECKED ✓ — BY — DATE

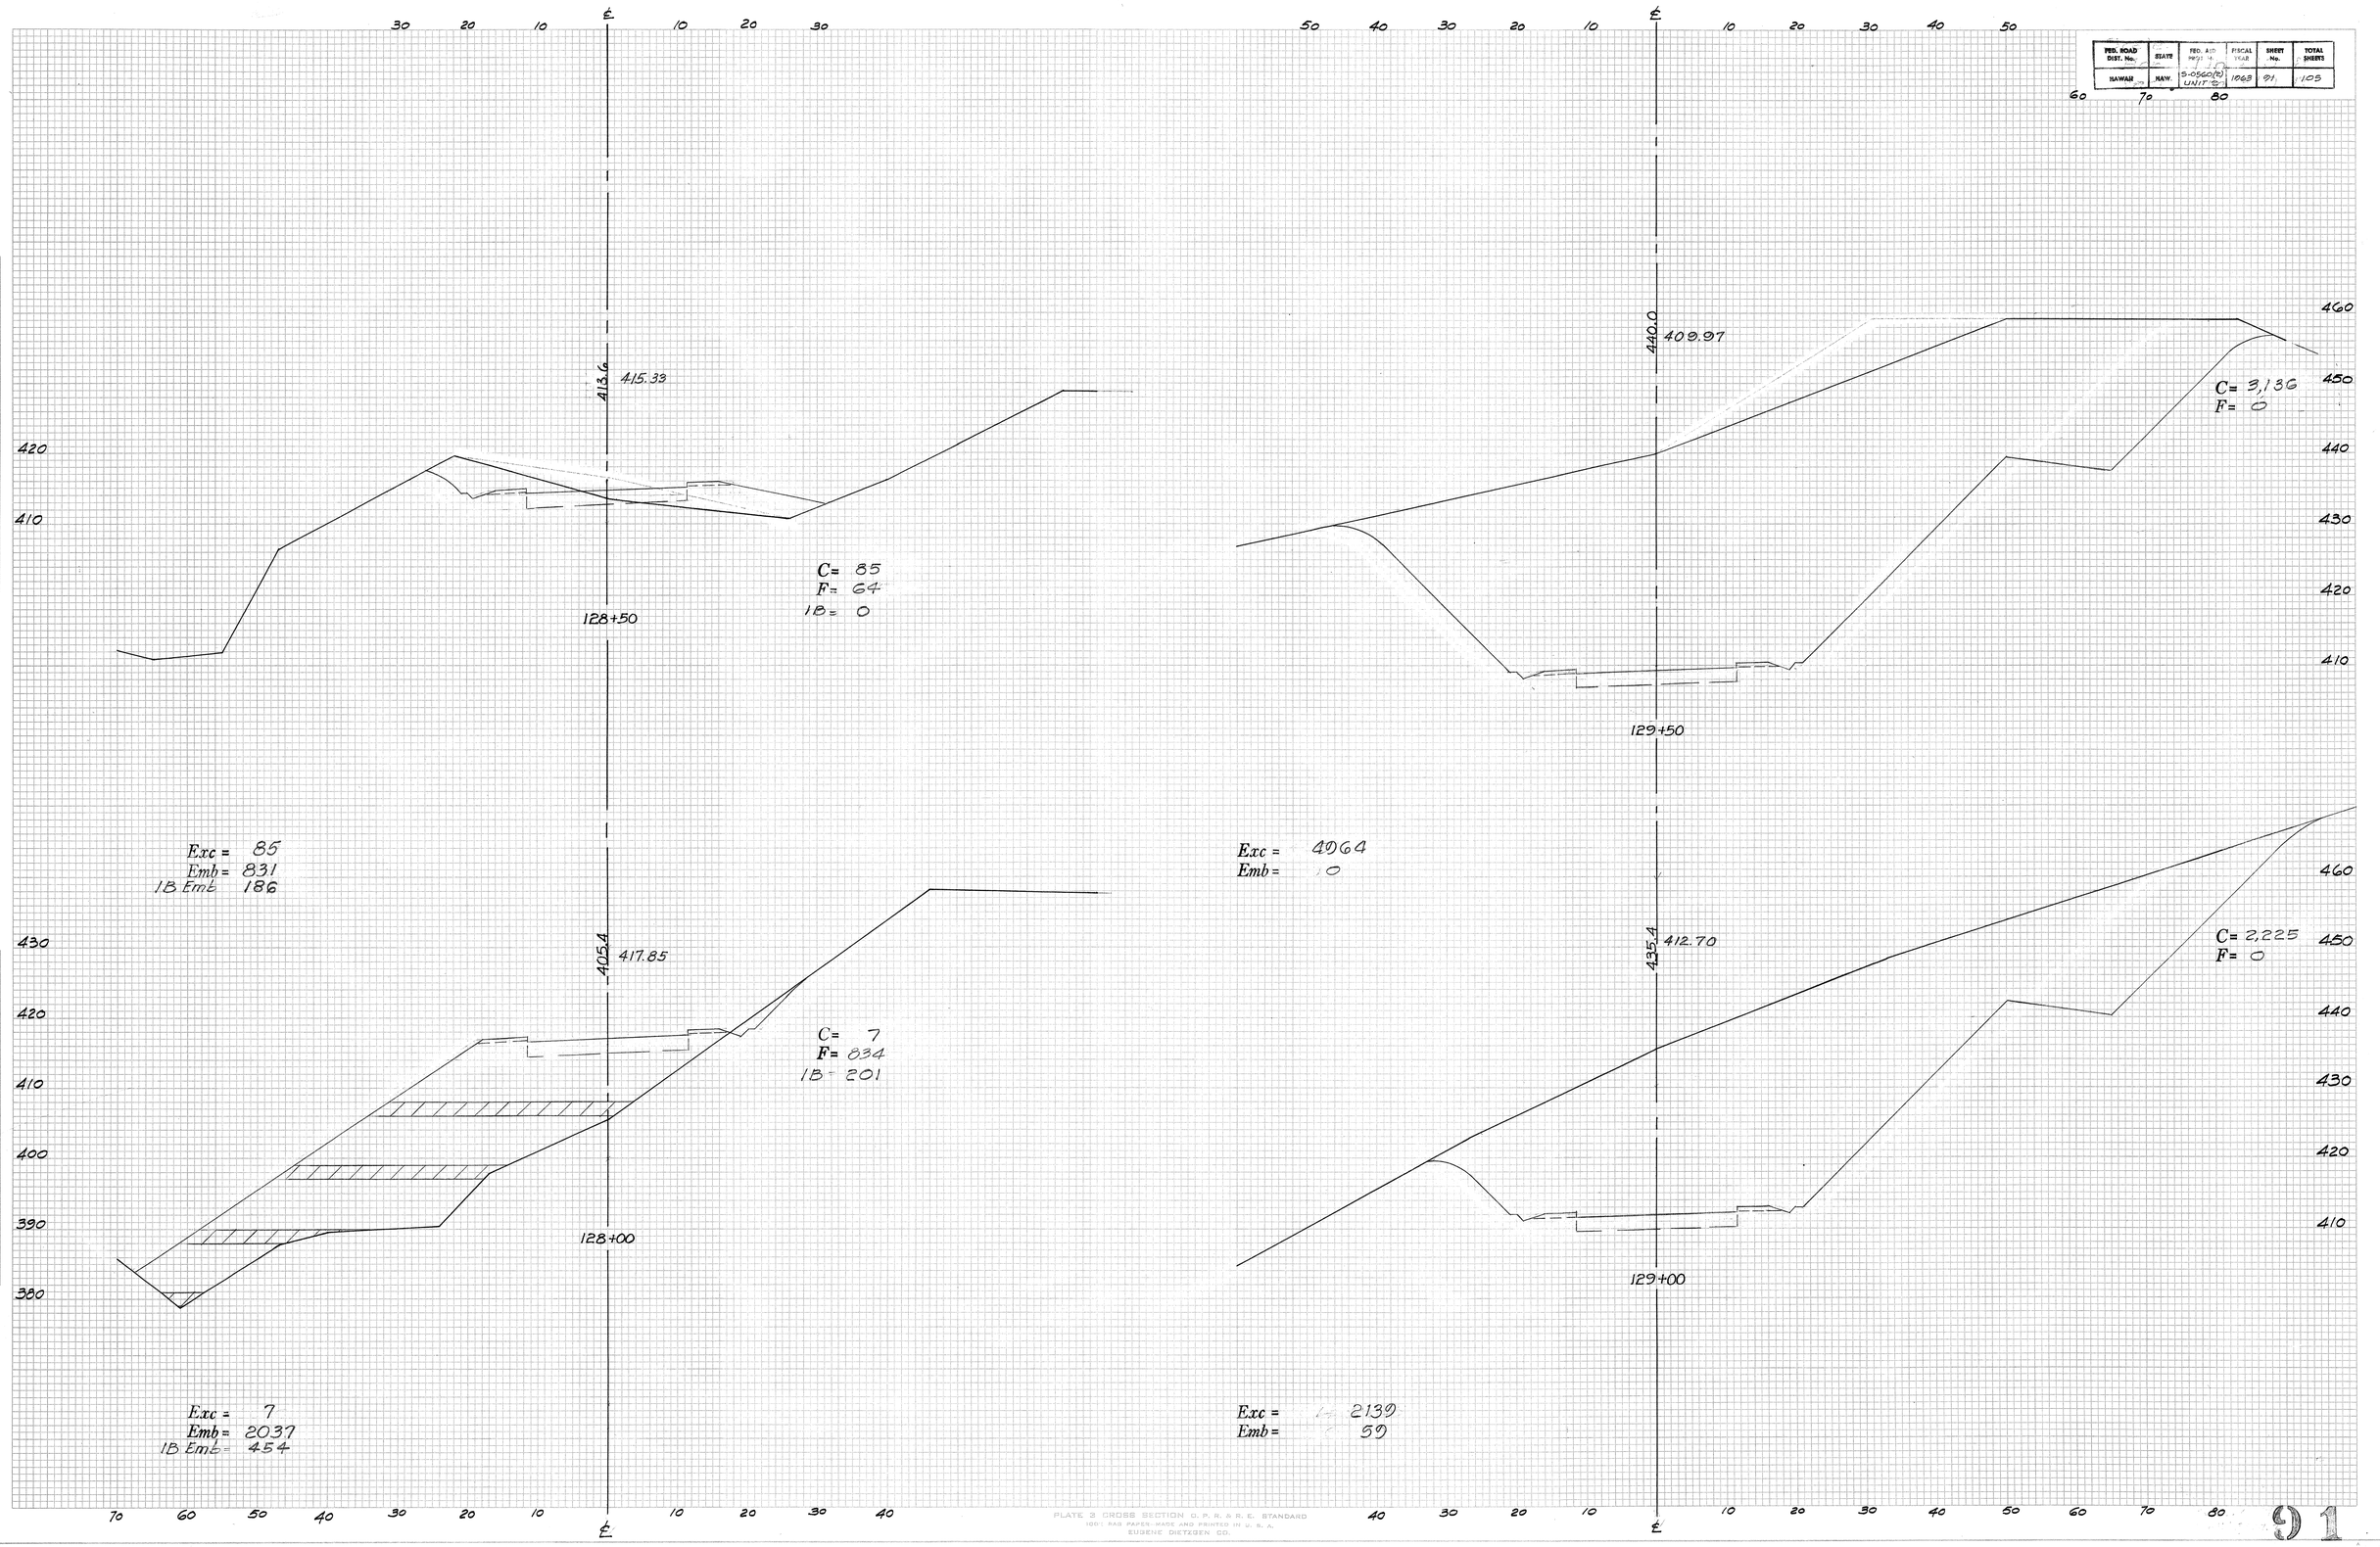

PLATE 3 CROSS SECTION U. P. R. & R. E. STANDARD
100% RAG PAPER-MADE AND PRINTED IN U. S. A.
EUGENE DIETZGEN CO.

FED. ROAD DIST. No.	STATE	FED. AID PROJ. No.	FISCAL YEAR	SHEET No.	TOTAL SHEETS
HAWAII	HAW.	S-0660(8) UNIT 2	1963	92	105

FINAL SURVEY — SURVEYED / PLOTTED / NOTE BOOK / NO. / TEMPLATE / AREAS / AREAS CHECKED / BY / DATE

ORIGINAL SURVEY — APPROVED / PLOTTED / NOTE BOOK / NO. / TEMPLATE / AREAS / AREAS CHECKED / BY / DATE

60 40 20 ℄ 20 40 60

453.4
404.18
450
440
430
420
410
400
C= 4286
F= 0
130+50
Exc = 8107
Emb = 0

456.8
407.13
460
450
440
430
420
410
400
C= 4,567
F= 0
130+00
Exc = 7132
Emb = 0

40 20 ℄ 20 40 60

430.0
398.18
440
430
420
410
400
390
C= 2,675
F= 0
131+50
Exc = 5808
Emb = 0

439.7
401.18
440
430
420
410
400
C= 3,597
F= 0
131+00
Exc = 7200
Emb = 0

PLATE 3. CROSS SECTION C. P. K. & E. STANDARD
100 - RAG PAPER MADE AND PRINTED IN U. S. A.
EUGENE DIETZGEN CO.

FED. ROAD DIST. No.	STATE	FED. AID PROJ. No.	FISCAL YEAR	SHEET No.	TOTAL SHEETS
HAWAII	HAW.	S-0562(5) UNIT 2	1963	93	155

FINAL SURVEY — NOTE BOOK NO. — SURVEYED — PLOTTED — TEMPLATE AREAS AREAS CHECKED — BY — DATE

ORIGINAL SURVEY — NOTE BOOK NO. — SURVEYED — PLOTTED — TEMPLATE AREAS AREAS CHECKED — BY — DATE

60 50 40 30 20 10 ℄ 10 20 30 40 50 60

430.1
392.18
132+50
C= 2,900
F= 0
Exc = 5519
Emb = 0

433.7
395.18
132+00
C= 3,060
F= 0
Exc = 5311
Emb = 0

50 40 30 20 10 ℄ 10 20 30 40 50

401.8
383.18
134+00
C= 1,259
F= 0
Exc = 2708
Emb = 0

410.8
386.18
133+50
C= 1,763
F= 0
Exc = 3750
Emb = 0

418.4
389.18
133+00
C= 2,287
F= 0
Exc = 4803
Emb = 0

430 420 410 400 390 380

PLATE 3 CROSS SECTION O. P. R. & R. E. STANDARD
1001 MAS PAPER-MADE AND PRINTED IN U. S. A.
EUGENE DIETZGEN CO.

93

FED. ROAD DIST. No.	STATE	FED. AID PROJECT	FISCAL YEAR	SHEET No.	TOTAL SHEETS
HAWAII	HAW.	S-0550(6) UNIT B	1963	94	105

FINAL SURVEY — NOTE BOOK — NO. — SURVEYED — PLOTTED — TEMPLATE — AREAS — AREAS CHECKED — BY — DATE

ORIGINAL SURVEY — NOTE BOOK — NO. — SURVEYED — PLOTTED — TEMPLATE — AREAS — AREAS CHECKED — BY — DATE

30 20 10 ℄ 10 20

374.5 374.18

371

370

135+50

C= 113
F= 0

Exc = 475
Emb = 0

382.1 377.18

380

370

135+00

C= 400
F= 0

Exc = 1115
Emb = 0

392.6 380.18

390

380

134+50

C= 804
F= 0

Exc = 1910
Emb = 0

40 30 20 10 ℄ 10 20 30 40

30 20 10 ℄ 10 20 30

358.7 365.18

360

137+00

C= 0
F= 234

Exc = 0
Emb = 308

364.4 368.18

370

360

136+50

C= 0
F= 99

Exc = 0
Emb = 189

368.2 371.18

370

136+00

C= 10
F= 105

Exc = 114
Emb = 97

20 10 ℄ 10 20 30

PLATE 3 CROSS SECTION C. P. R. & R. E. STANDARD
100% RAG PAPER—MADE AND PRINTED IN U. S. A.
EUGENE DIETZGEN CO.

FED. ROAD DIST. No.	STATE	FED. AID PROJ. No.	FISCAL YEAR	SHEET No.	TOTAL SHEETS
HAWAII	HAW.	S-0500(2) UNIT 2	1963	95	109

FINAL SURVEY — SURVEYED, PLOTTED, TEMPLATE, AREAS, AREAS CHECKED, NOTE BOOK, NO., BY, DATE

ORIGINAL SURVEY — SURVEYED, PLOTTED, TEMPLATE, AREAS, AREAS CHECKED, NOTE BOOK, NO., BY, DATE

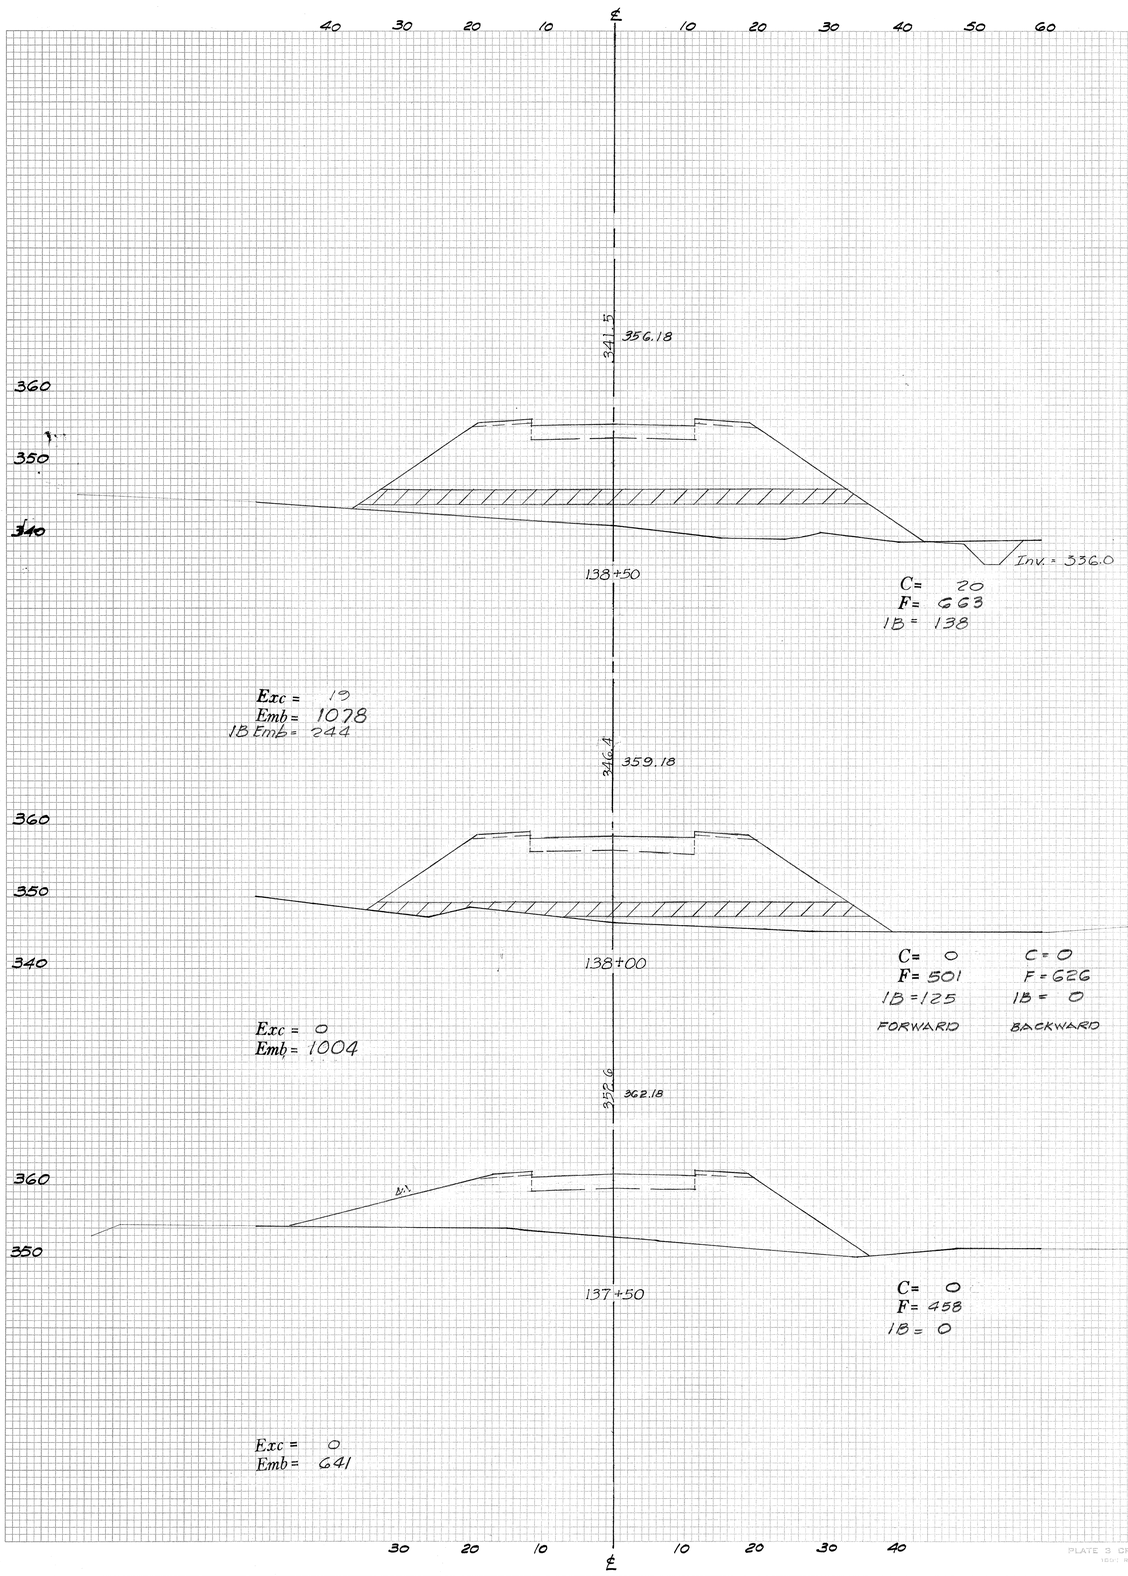

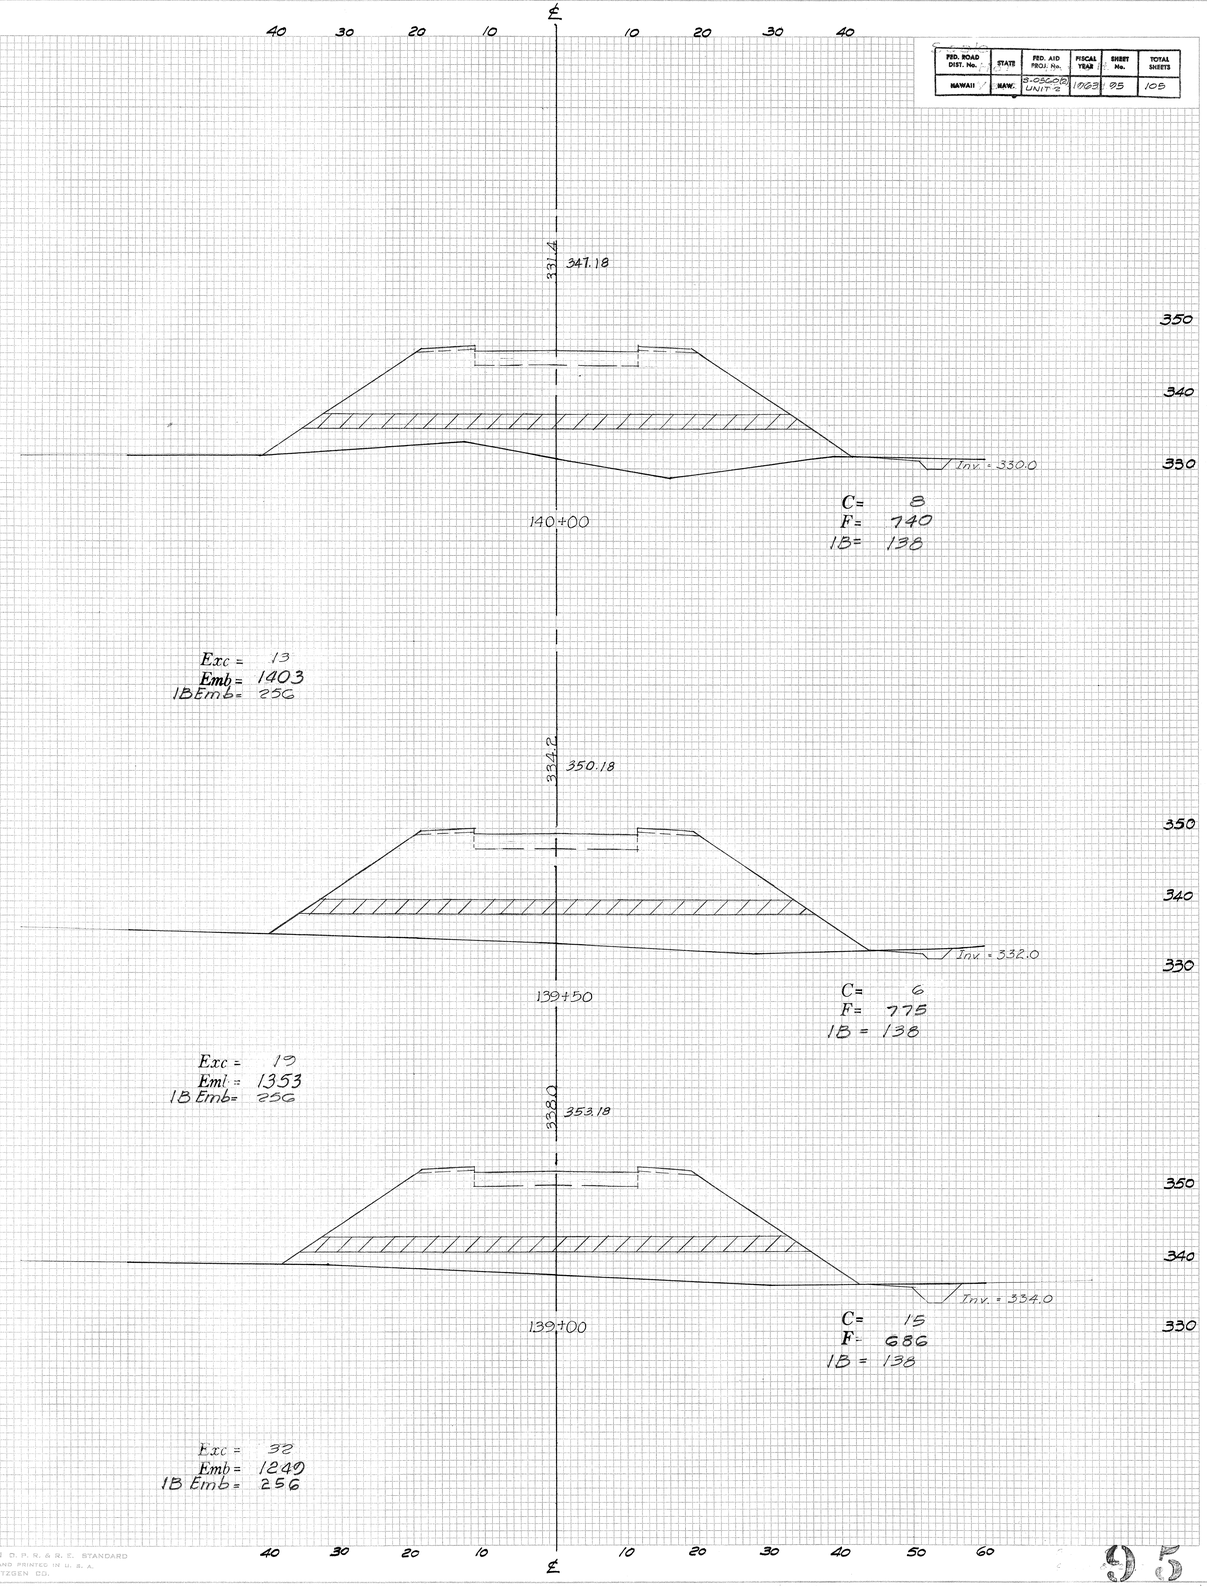

PLATE 3 CROSS SECTION O. P. R. & R. E. STANDARD
100% RAG PAPER—MADE AND PRINTED IN U. S. A.
EUGENE DIETZGEN CO.

95

FED. ROAD DIST. No.	STATE	FED. AID PROJ. No.	FISCAL YEAR	SHEET No.	TOTAL SHEETS

FINAL SURVEY — SURVEYED / PLOTTED / PLANIMETERED / AREAS / AREAS CHECKED / NOTE BOOK / NO. / BY / DATE

ORIGINAL SURVEY — SURVEYED / PLOTTED / PLANIMETERED / AREAS / AREAS CHECKED / NOTE BOOK / NO. / BY / DATE

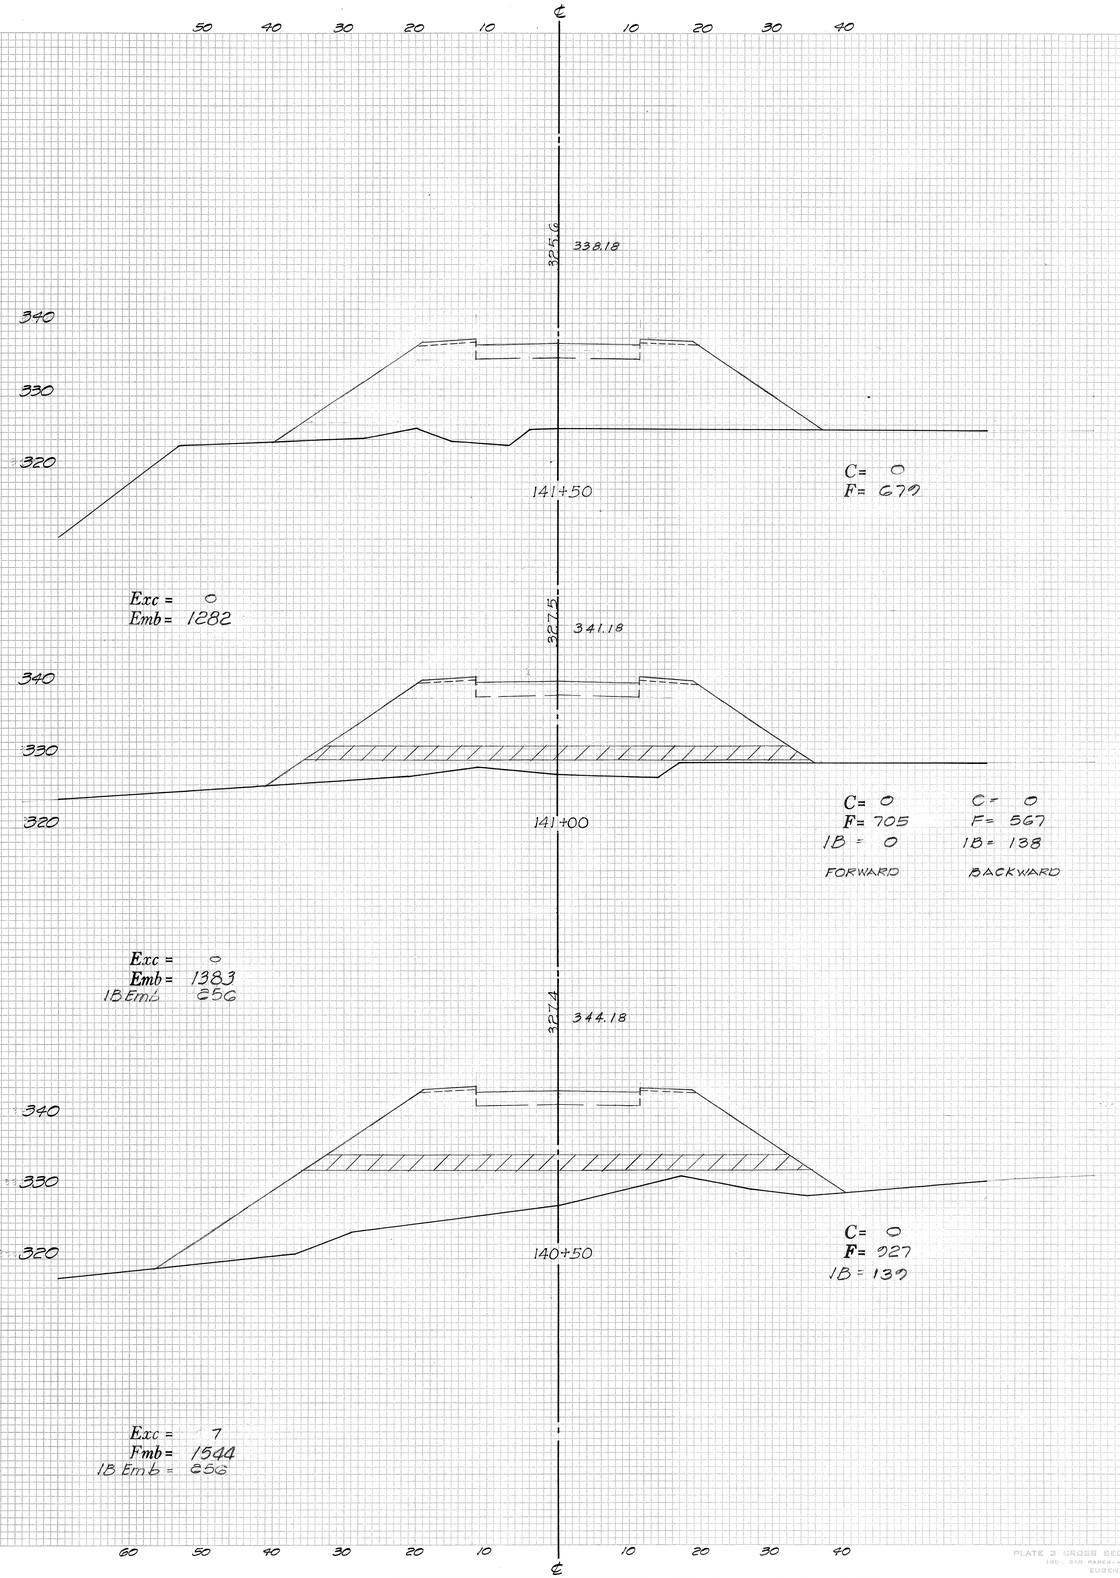

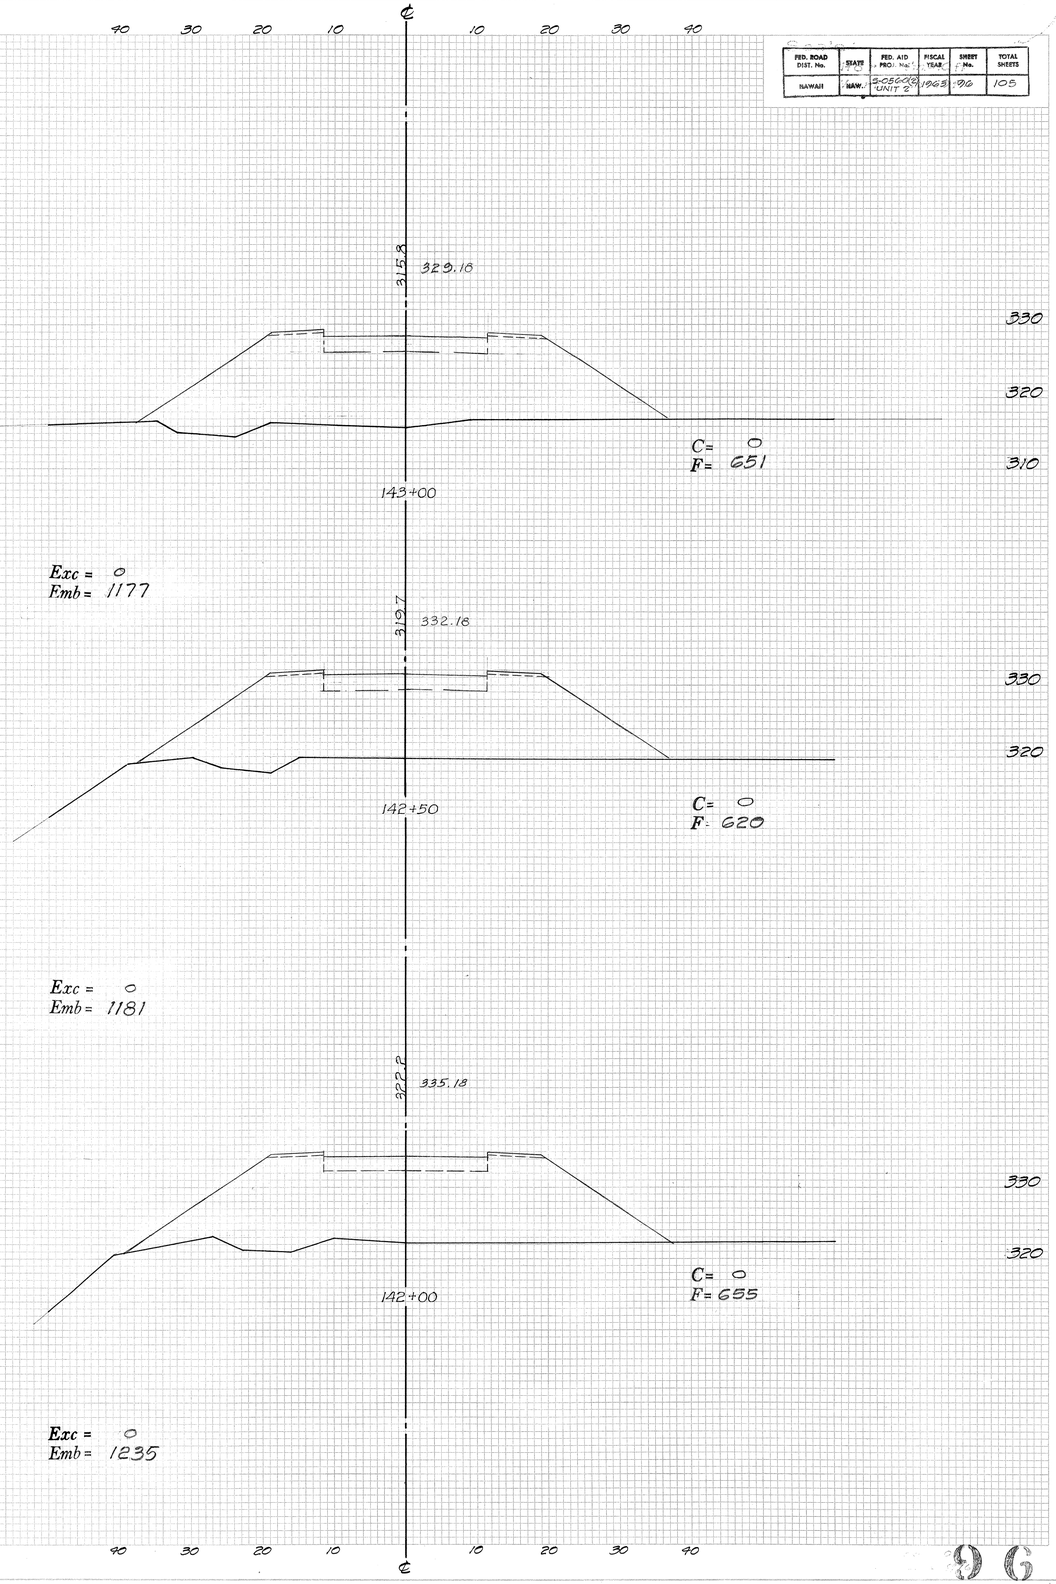

PLATE 3 CROSS SECTION D. P. R. & R. E. STANDARD
100% RAG PAPER-MADE AND PRINTED IN U. S. A.
EUGENE DIETZGEN CO.

FED. ROAD DIST. No.	STATE	FED. AID PROJ. No.	FISCAL YEAR	SHEET No.	TOTAL SHEETS
HAWAII	HAW.	S-0530(2) UNIT 2	1963	97	105

FINAL SURVEY — SURVEYED BY, PLOTTED, TYPEWRITE, NOTE BOOK, NO., AREAS, AREAS CHECKED, DATE

ORIGINAL SURVEY — SURVEYED BY, PLOTTED, TYPEWRITE, NOTE BOOK, NO., AREAS, AREAS CHECKED, DATE

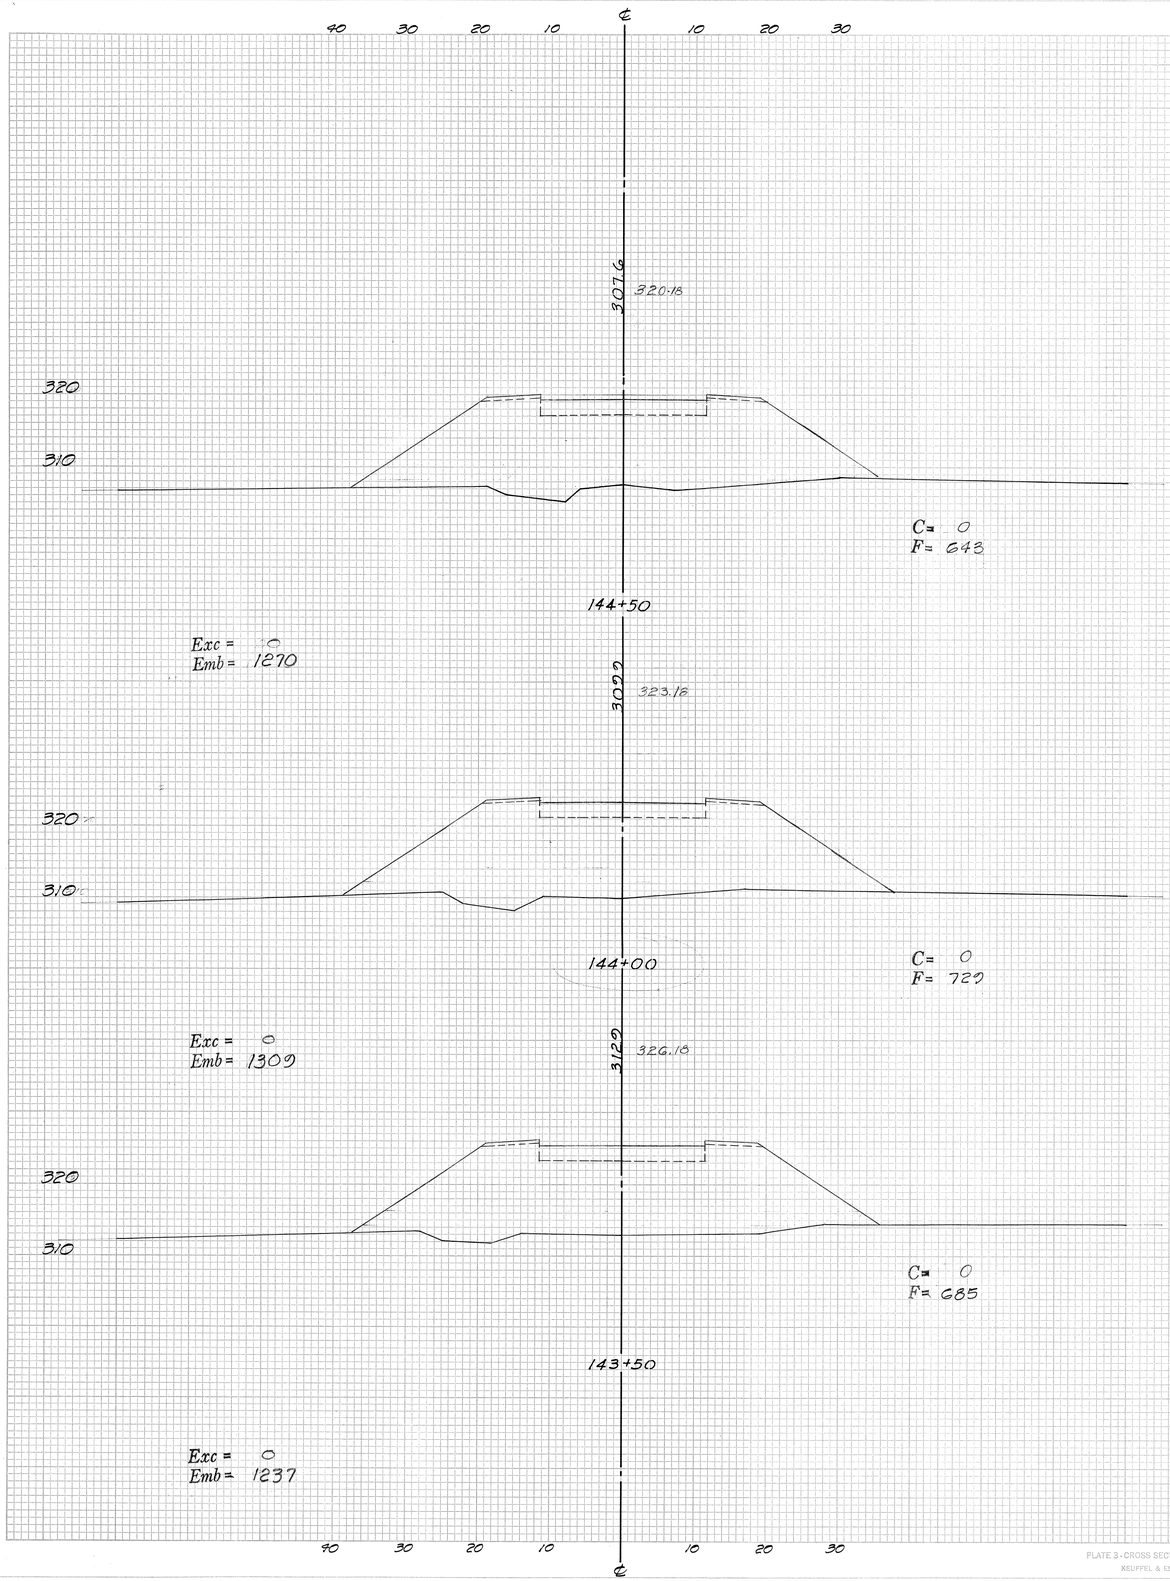

PLATE 3 - CROSS SECTION O. P. R. & R. E. STANDARD
KEUFFEL & ESSER CO., NEW YORK.
K & E CO. NO. 345-3 MADE IN U.S.A. 21070

FED. ROAD DIST. No.	STATE	FED. AID PROJ. No.	FISCAL YEAR	SHEET No.	TOTAL SHEETS
HAWAII	HAW.	S-0560(2) UNIT 2	1963	98	105

FINAL SURVEY — SURVEYED BY; NOTE BOOK; NO.; DRAWN BY; TRACED BY; AREAS; AREAS CHECKED; DATE

ORIGINAL SURVEY — SURVEYED BY; NOTE BOOK; NO.; DRAWN BY; TRACED BY; AREAS; AREAS CHECKED; DATE

2936 — 299.74

148+50: C= 0, F= 223; Exc = 0, Emb = 513

2939 — 301.91

148+00: C= 0, F= 331; Exc = 0, Emb = 706

2954 — 304.18

147+50: C= 0, F= 431; Exc = 0, Emb = 830

2974 — 306.57

147+00: C= 0, F= 465; Exc = 0, Emb = 879

2998 — 309.07

146+50: C= 0, F= 484; Exc = 0, Emb = 878

2934 — 290.58

151+00: C= 19, F= 25; Exc = 21, Emb = 247

2929 — 292.19

150+50: C= 4, F= 244; Exc = 4, Emb = 208

2903 — 293.91

150+00: C= 0, F= 78; Exc = 0, Emb = 177

2911 — 295.74

149+50: C= 0, F= 113; Exc = 0, Emb = 324

2917 — 297.69

149+00: C= 0, F= 237; Exc = 0, Emb = 426

2810 — 284.20

153+50: C= 8, F= 44; Exc = 8, Emb = 76

2824 — 285.26

153+00: C= 1, F= 38; Exc = 2, Emb = 68

2833 — 286.42

152+50: C= 1, F= 35; Exc = 2, Emb = 73

2851 — 287.70

152+00: C= 1, F= 44; Exc = 6, Emb = 81

2863 — 289.08

151+50: C= 5, F= 44; Exc = 22, Emb = 64

PLATE — CROSS SECTION O. P. R. & E. STANDARD
SIZE - 8½ x 11 — PAPER - PRINTED IN U. S. A.
EUGENE DIETZGEN CO.

39

FED. ROAD DIST. No.	STATE	FED. AID PROJ. No.	FISCAL YEAR	SHEET No.	TOTAL SHEETS
HAWAII	HAW.	S-0560(8) UNIT E	1965	99	103

FINAL SURVEY — NOTE BOOK ____ NO. ____ — SURVEYED — PLOTTED — CROSS SECTIONED — AREAS — AREAS CHECKED — BY — DATE

ORIGINAL SURVEY — NOTE BOOK ____ NO. ____ — SURVEYED — PLOTTED — CROSS SECTIONED — AREAS — AREAS CHECKED — BY — DATE

---

30 20 10 | 10 20 30 — 2785 — 280.61

280

156+00

C= 12
F= 31

Exc = 25
Emb = 57

279.4 — 281.10

280

155+50

C= 15
F= 31

Exc = 28
Emb = 55

279.9 — 281.71

280

155+00

C= 15
F= 28

Exc = 23
Emb = 51

280.1 — 282.43

280

154+50

C= 10
F= 27

Exc = 20
Emb = 59

281.1 — 283.26

280

154+00

C= 12
F= 37

Exc = 19
Emb = 75

30 20 10 ℄ 10 20 30

---

30 20 10 | 10 20 30 — 276.3 — 279.79

280

2:1 — 4:1

158+50

C= 0
F= 92

Exc = 0
Emb = 141

276.7 — 279.73

280

158+00

C= 0
F= 60

Exc = 3
Emb = 96

277.4 — 279.78

280

157+50

C= 3
F= 44

Exc = 24
Emb = 64

278.4 — 279.95

280

157+00

C= 23
F= 25

Exc = 42
Emb = 42

278.3 — 280.22

280

156+50

C= 22
F= 20

Exc = 31
Emb = 47

10 20 10 ℄ 10 20 30

---

40 30 20 10 ℄ — 276.1 — 281.70 10 20 30

280

161+00

C= 0
F= 227

270

Exc = 0
Emb = 386

275.7 — 281.14

280

160+50

C= 0
F= 100

270

Exc = 0
Emb = 310

276.0 — 280.64

280

160+00

C= 0
F= 145

270

Exc = 0
Emb = 244

275.8 — 280.24

280

159+50

C= 0
F= 118

270

Exc = 0
Emb = 202

276.0 — 279.96

2:1 — 3:1

280

159+00

C= 0
F= 100

270

Exc = 0
Emb = 178

30 20 10 ℄ 10 20 30

PLATE 10 CROSS SECTION U. P. R. S. STANDARD
1001 RAG PAPER MADE AND PRINTED IN U. S. A.
EUGENE DIETZGEN CO.

99

FED. ROAD DIST. No.	STATE	FED. AID PROJ. No.	FISCAL YEAR	SHEET No.	TOTAL SHEETS
HAWAII	HAW.	S-0360(8) UNIT, B	1963	100	105

FINAL SURVEY — SURVEYED BY, PLOTTED BY, TEMPLATE, AREAS, AREAS CHECKED, NOTE BOOK, NO., DATE, BY

ORIGINAL SURVEY — SURVEYED BY, PLOTTED BY, TEMPLATE, AREAS, AREAS CHECKED, NOTE BOOK, NO., DATE, BY

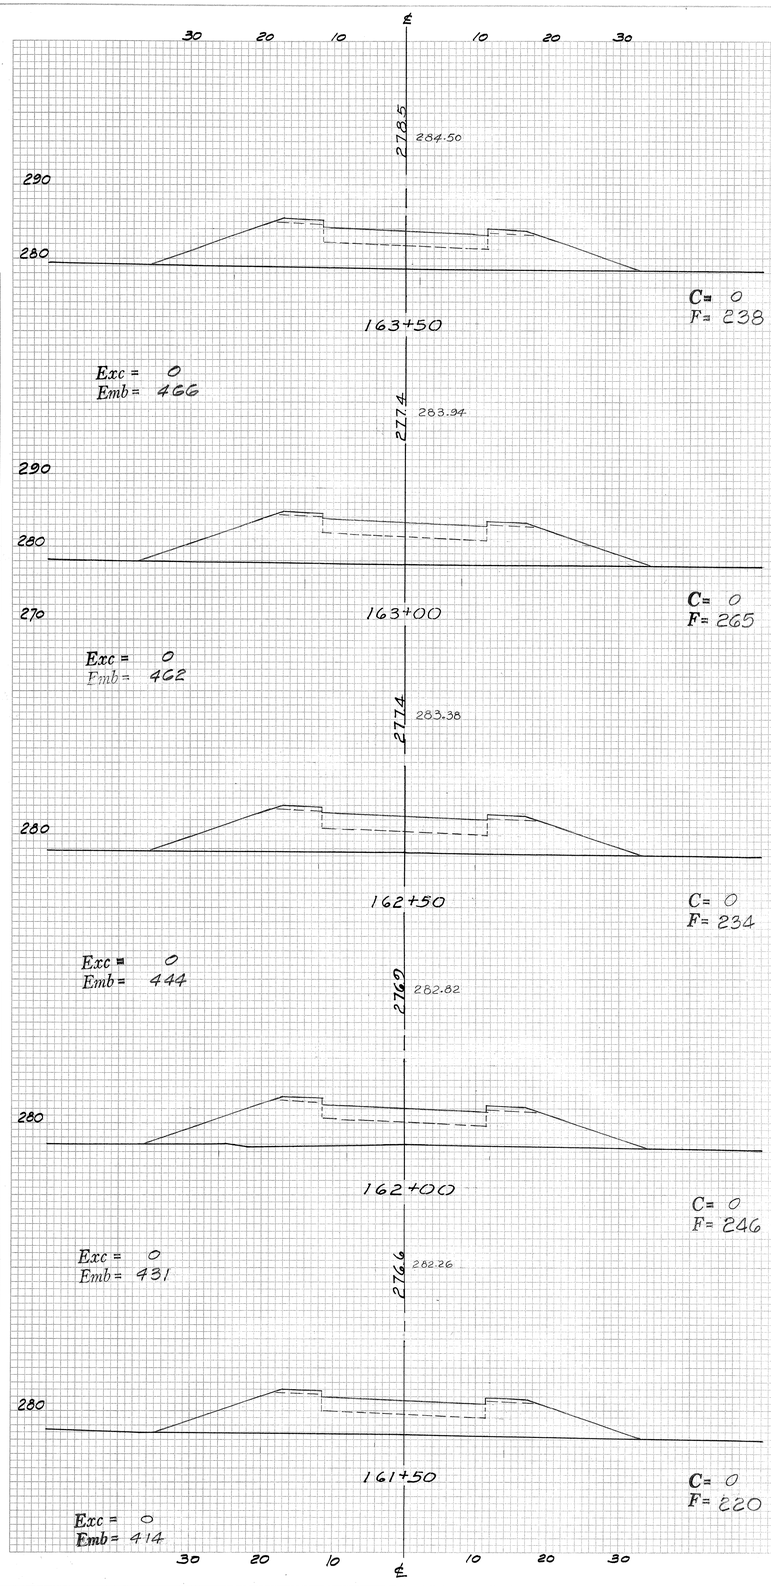

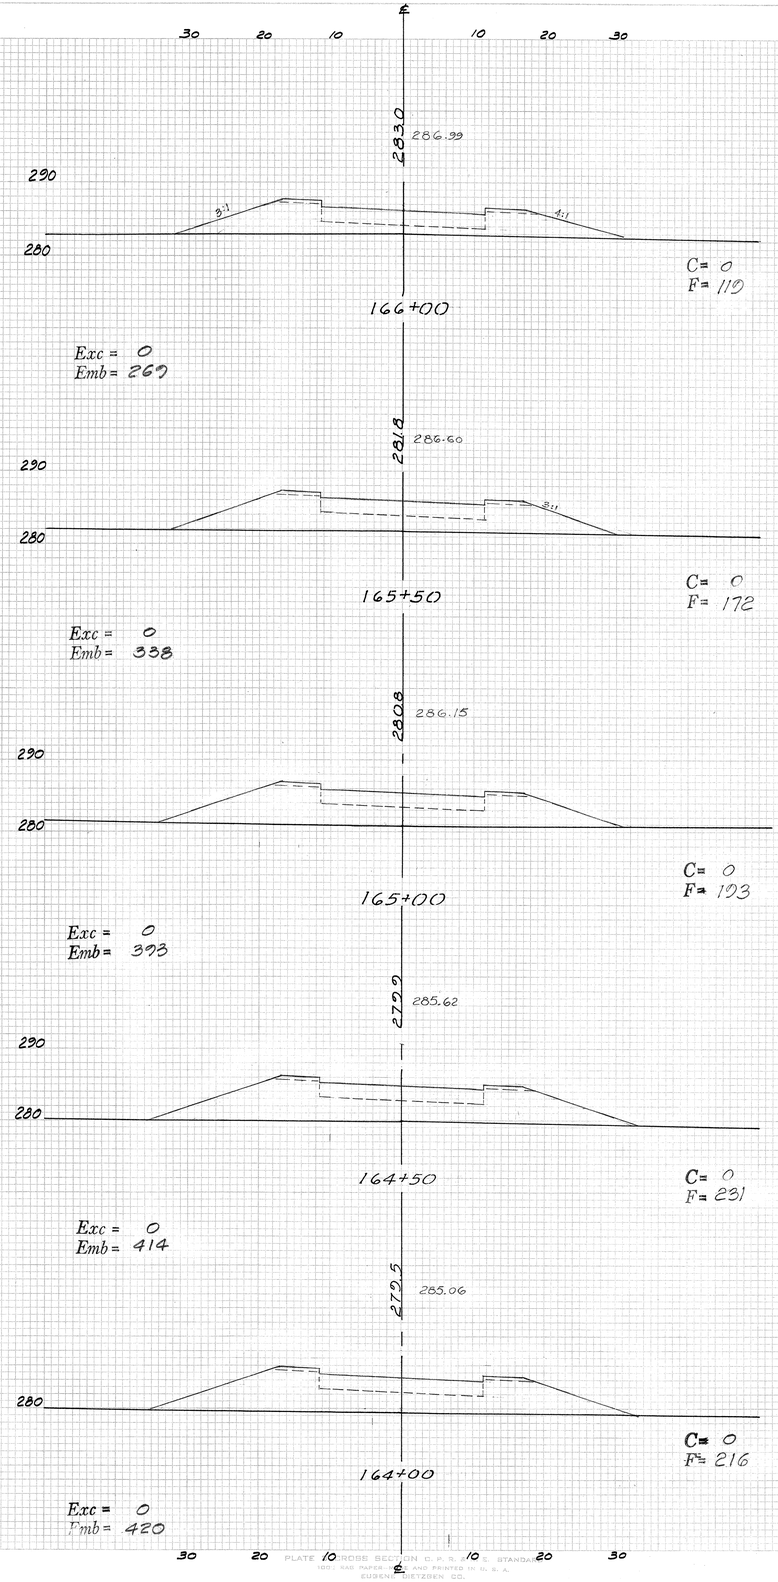

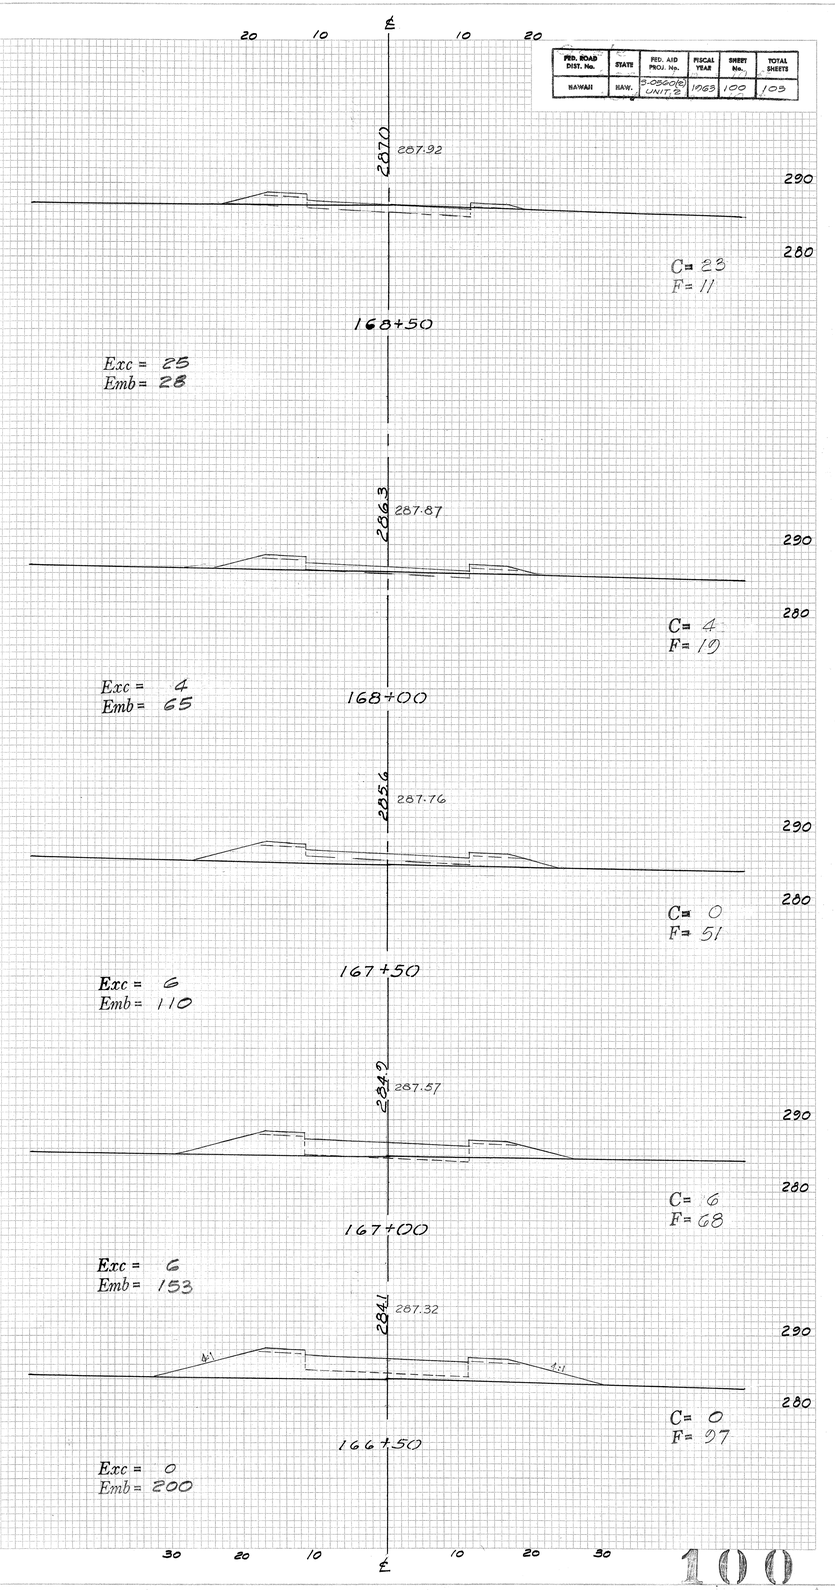

PLATE 10 CROSS SECTION C. P. S. 2 S. STANDARD
100% RAG PAPER MADE AND PRINTED IN U. S. A.
EUGENE DIETZGEN CO.

FED. ROAD DIST. No.	STATE	FED. AID PROJ. No.	FISCAL YEAR	SHEET No.	TOTAL SHEETS
HAWAII	HAW.	S-0560(10) UNIT 2	1963	101	105

FINAL SURVEY — NOTE BOOK — NO. — SURVEYED — PLOTTED — TEMPLATE — AREAS — AREAS CHECKED — BY — DATE

ORIGINAL SURVEY — NOTE BOOK — NO. — SURVEYED — PLOTTED — TEMPLATE — AREAS — AREAS CHECKED — BY — DATE

20 10 ℄ 10 20

286.0 287.15 — 290 — 280

C= 20
F= 5

171+00

Exc = 35
Emb = 9

286.9 287.44 — 290 — 280

C= 18
F= 5

170+50

Exc = 42
Emb = 12

287.0 287.67 — 290 — 280

C= 27
F= 8

170+00

Exc = 41
Emb = 12

287.0 287.82 — 290 — 280

C= 17
F= 5

169+50

Exc = 31
Emb = 10

286.8 287.91 — 290 — 280

C= 16
F= 6

169+00

Exc = 36
Emb = 16

20 10 ℄ 10 20

30 20 10 ℄ 10 20

282.6 284.68 — 290 — 280

C= 14
F= 12

173+50

Exc = 25
Emb = 24

284.3 285.31 — 290 — 280

C= 13
F= 14

173+00

Exc = 33
Emb = 21

285.2 285.88 — 290 — 280

C= 23
F= 9

172+50

Exc = 47
Emb = 11

286.0 286.37 — 290 — 280

C= 28
F= 3

172+00

Exc = 66
Emb = 5

286.5 286.80 — 290 — 280

C= 43
F= 2

171+50

Exc = 58
Emb = 7

20 10 ℄ 10 20

279.2 280.82 — 290 — 280

C= 6
F= 16

176+00

Exc = 16
Emb = 29

280.6 281.62 — 290 — 280

C= 11
F= 15

175+50

Exc = 22
Emb = 28

281.5 282.42 — 290 — 280

C= 13
F= 15

175+00

Exc = 16
Emb = 29

281.6 283.22 — 290 — 280

C= 4
F= 16

174+50

Exc = 23
Emb = 19

282.2 283.99 — 290 — 280

C= 21
F= 5

174+00

Exc = 32
Emb = 16

30 20 10 ℄ 10 20

PLATE CROSS SECTION C.P.R. STANDARD
1961 MADE IN U.S.A. AND PRINTED IN U.S.A.
EUGENE DIETZGEN CO.

PROJ. ROAD DIST. No.	STATE	FED. AID PROJ. No.	FISCAL YEAR	SHEET No.	TOTAL SHEETS
HAWAII	HAW.	S-0560(6) UNIT 2	1963	102	105

ORIGINAL SURVEY — SURVEYED, PLOTTED, TEMPLATE, ISSUED, AREAS CHECKED — NOTE BOOK — NO. — BY — DATE

FINAL SURVEY — SURVEYED, PLOTTED, TEMPLATE, ISSUED, AREAS CHECKED — NOTE BOOK — NO. — BY — DATE

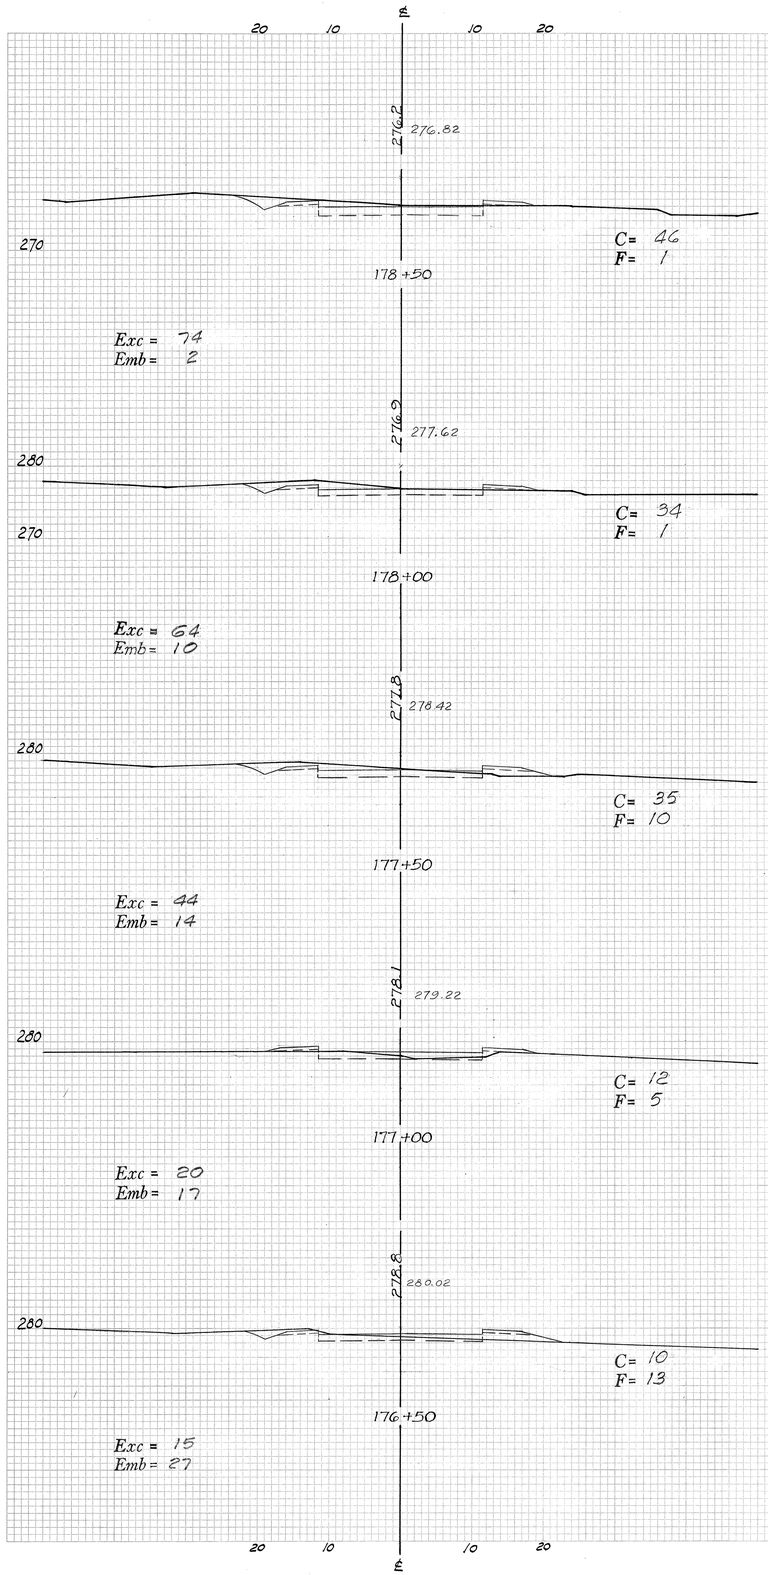

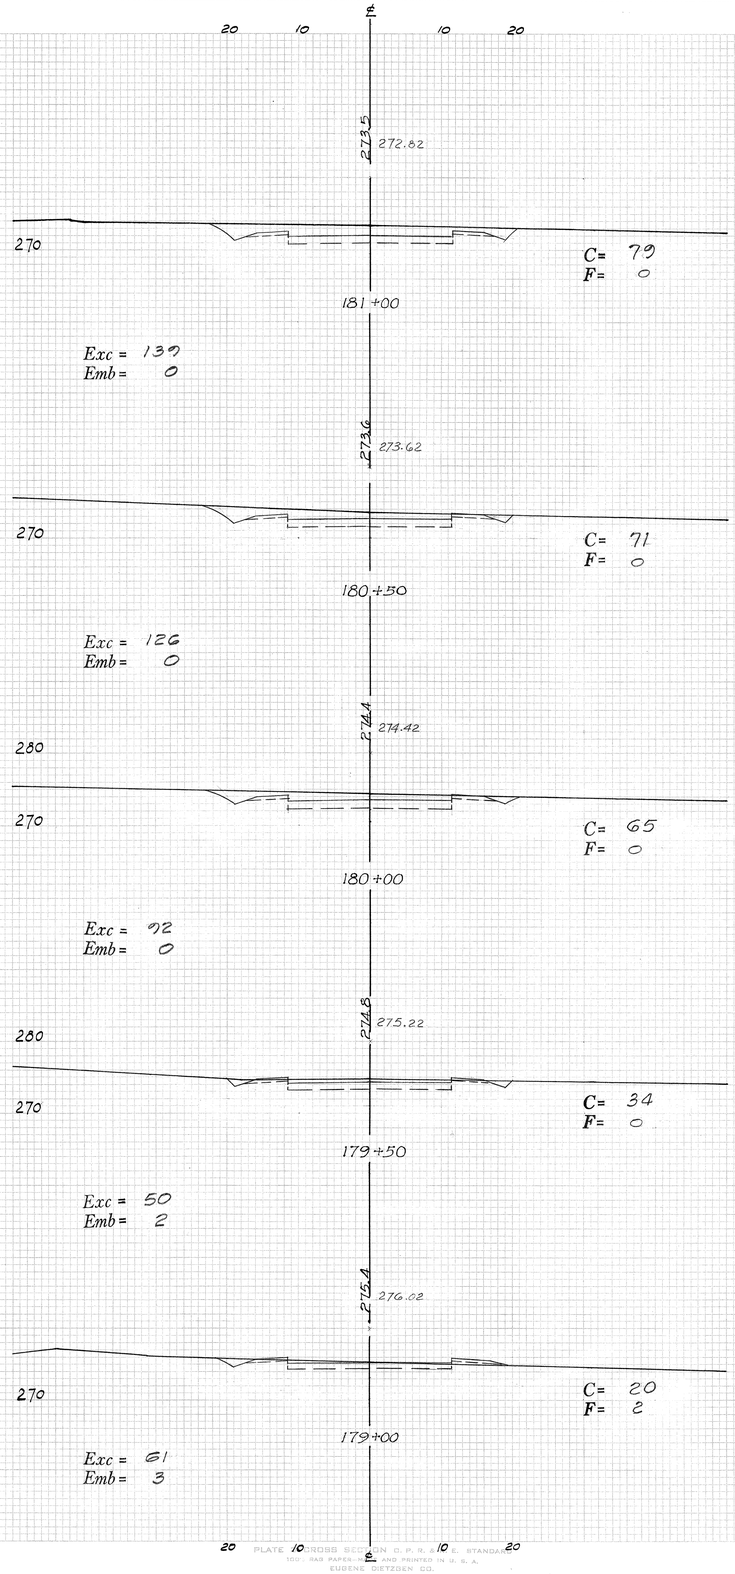

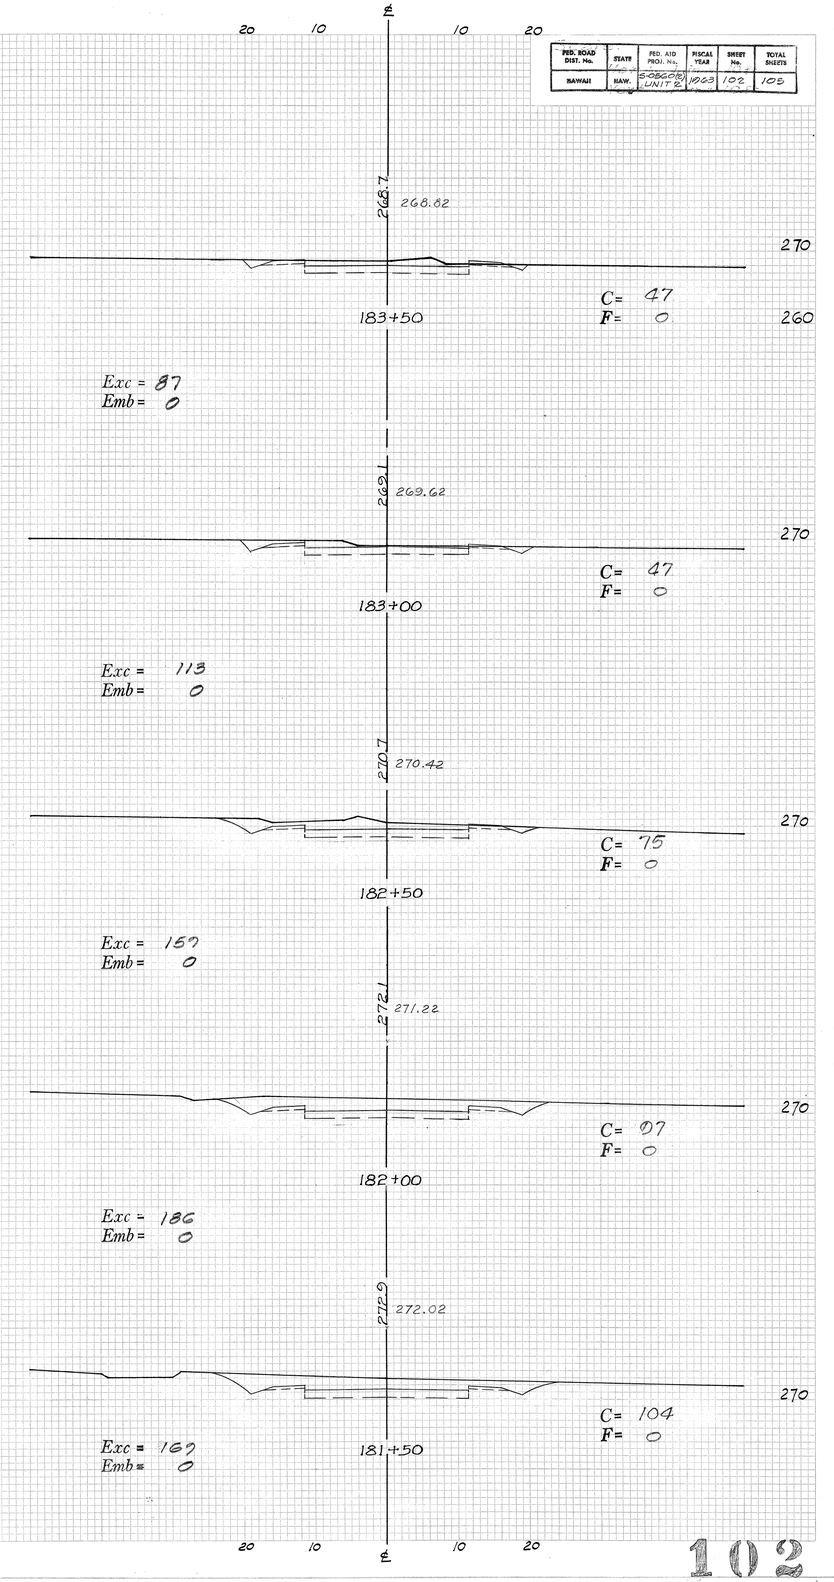

PLATE 1 CROSS SECTION U. P. R. & E. STANDARD
1912 BAR PAPER — MADE AND PRINTED IN U. S. A.
EUGENE DIETZGEN CO.

FED. ROAD DIST. No.	STATE	FED. AID PROJ. No.	FISCAL YEAR	SHEET No.	TOTAL SHEETS
HAWAII	HAW.	F-058(08) UNIT 2	1963	103	105

FINAL SURVEY — SURVEYED, PLOTTED, TEMPLATE, AREAS CHECKED — NOTE BOOK — NO. — BY — DATE

ORIGINAL SURVEY — SURVEYED, PLOTTED, TEMPLATE, AREAS CHECKED — NOTE BOOK — NO. — BY — DATE

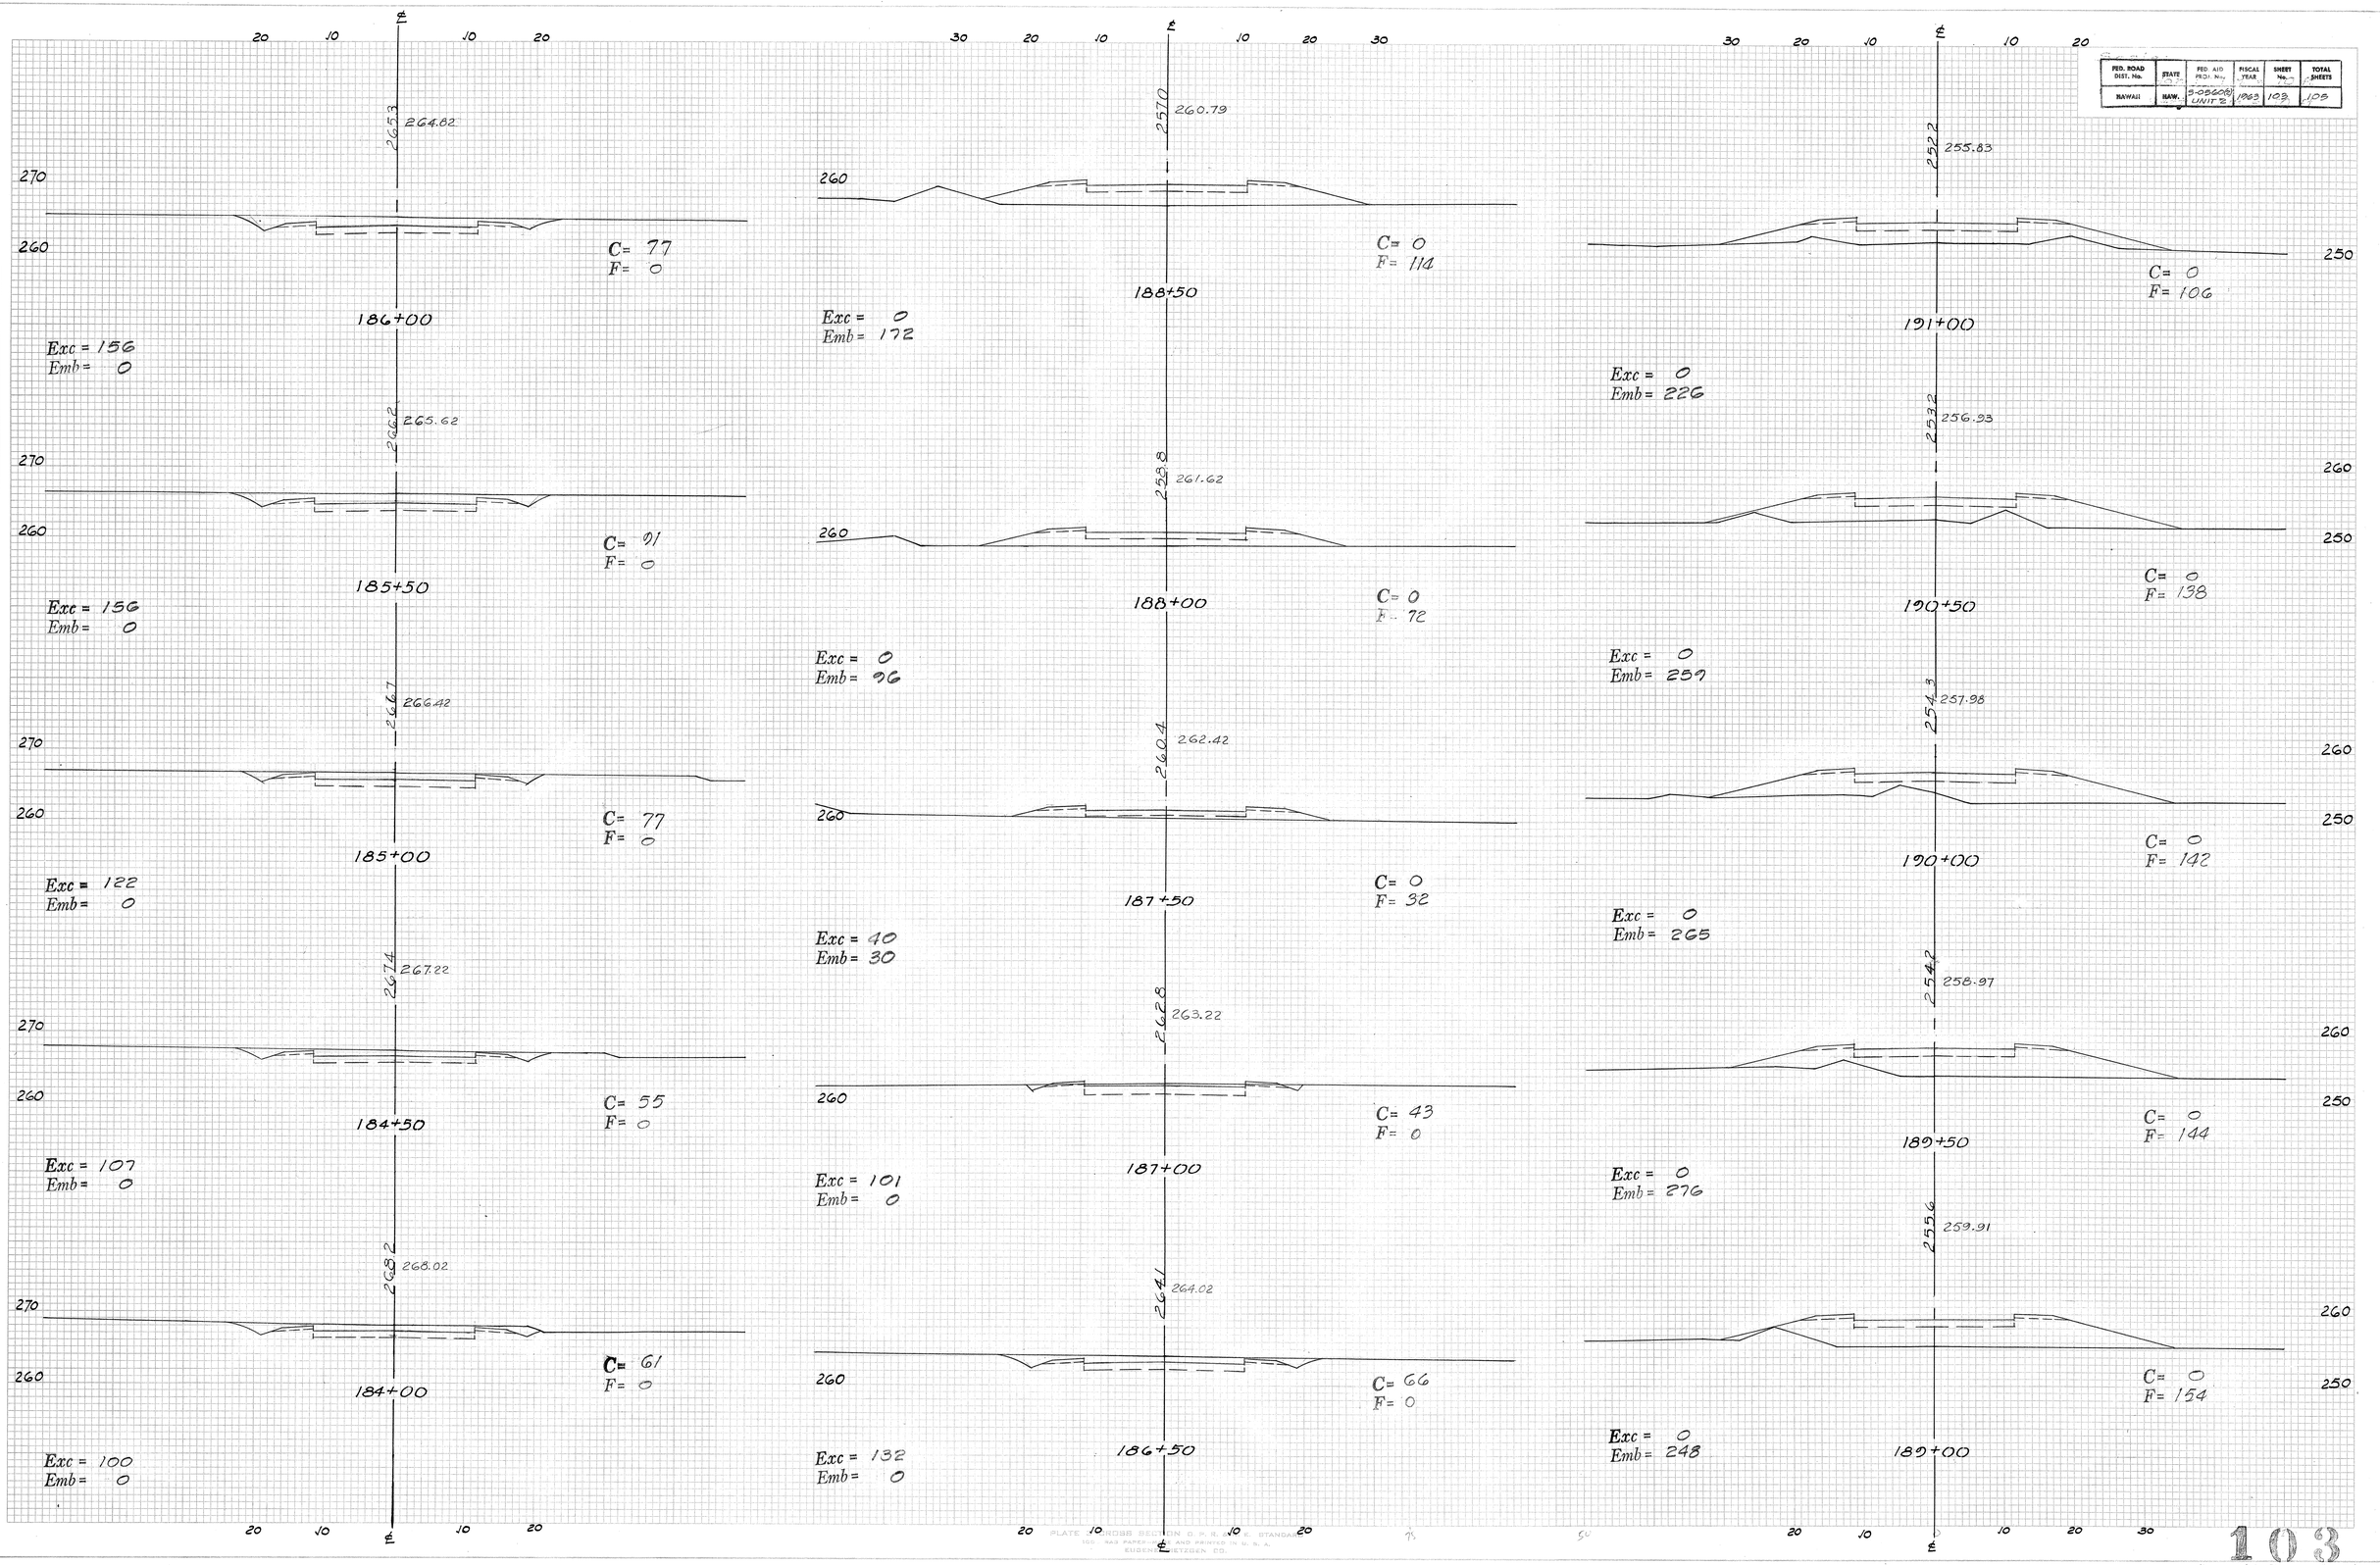

PLATE — CROSS SECTION C. P. R. R. — STANDARD
105 - 943 PAPER MADE AND PRINTED IN U. S. A.
EUGENE DIETZGEN CO.

FED. ROAD DIST. No.	STATE	FED. AID PROJ. No.	FISCAL YEAR	SHEET No.	TOTAL SHEETS
HAWAII	HAW.	S-0560(2) UNIT 2	1963	104	105

FINAL SURVEY — SURVEYED, PLOTTED, TEMPLATE, AREAS CHECKED, NOTE BOOK, NO., BY, DATE

ORIGINAL SURVEY — SURVEYED, PLOTTED, TEMPLATE, AREAS CHECKED, NOTE BOOK, NO., BY, DATE

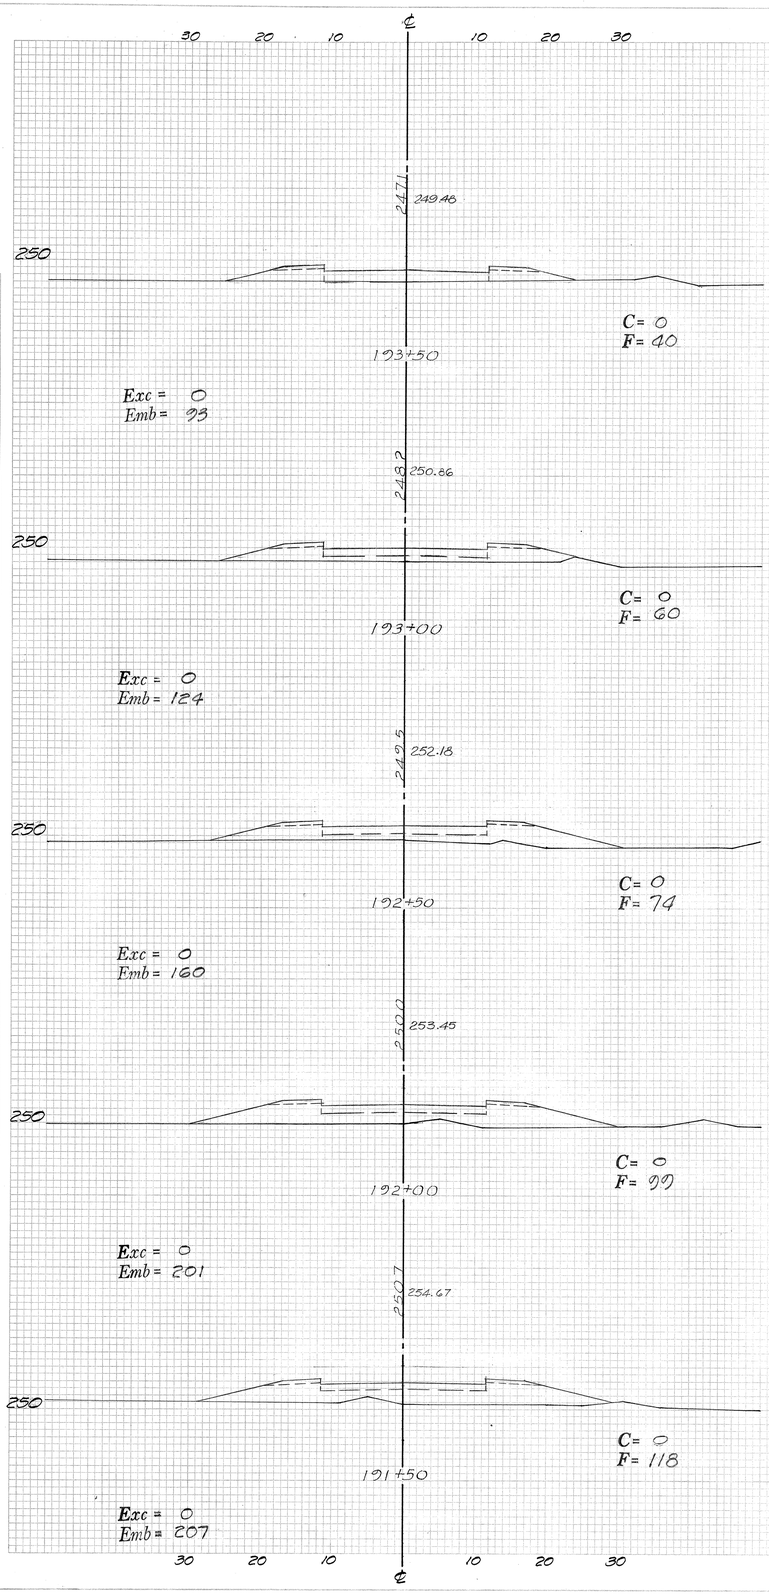

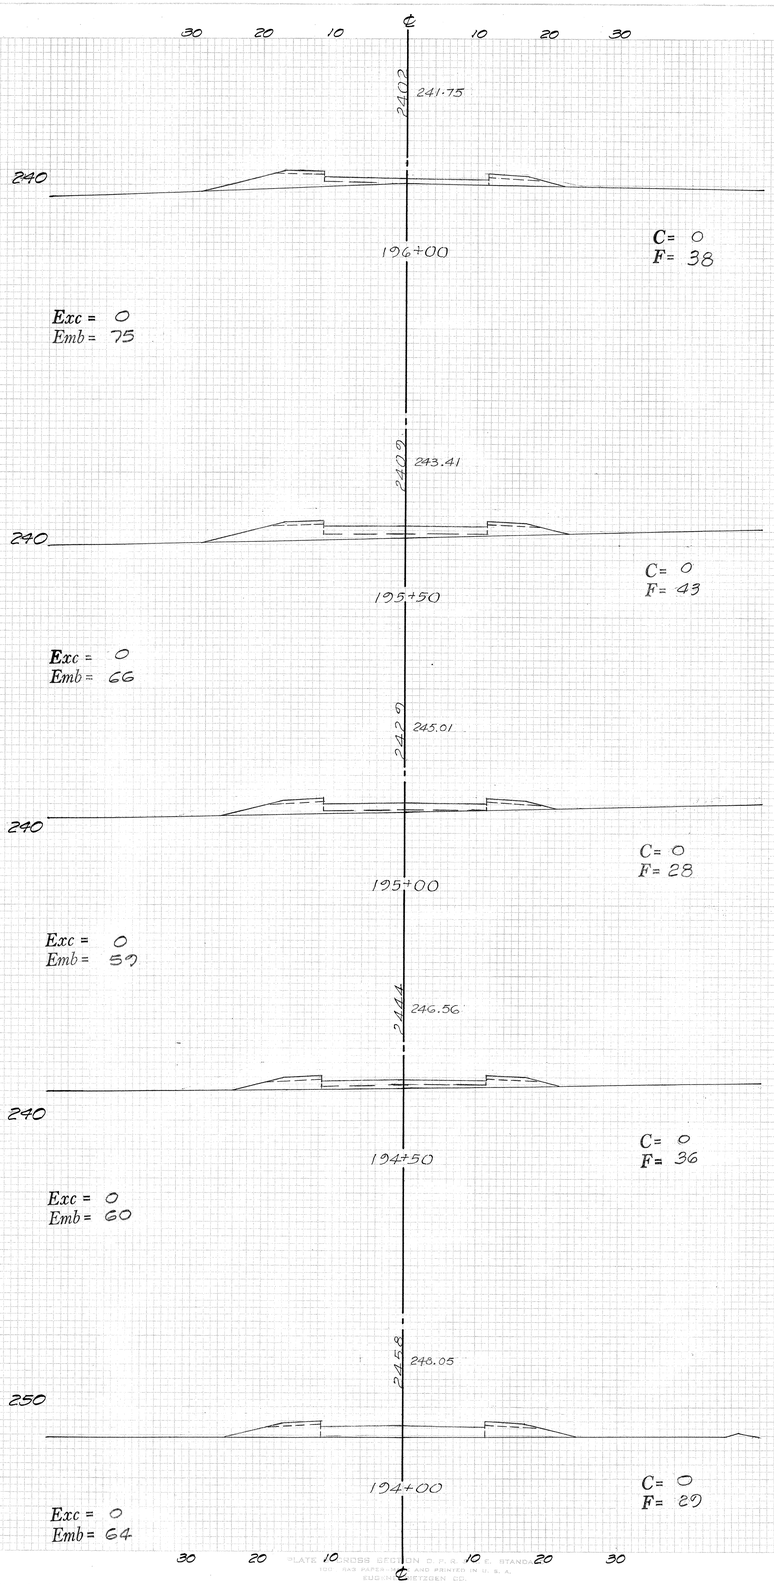

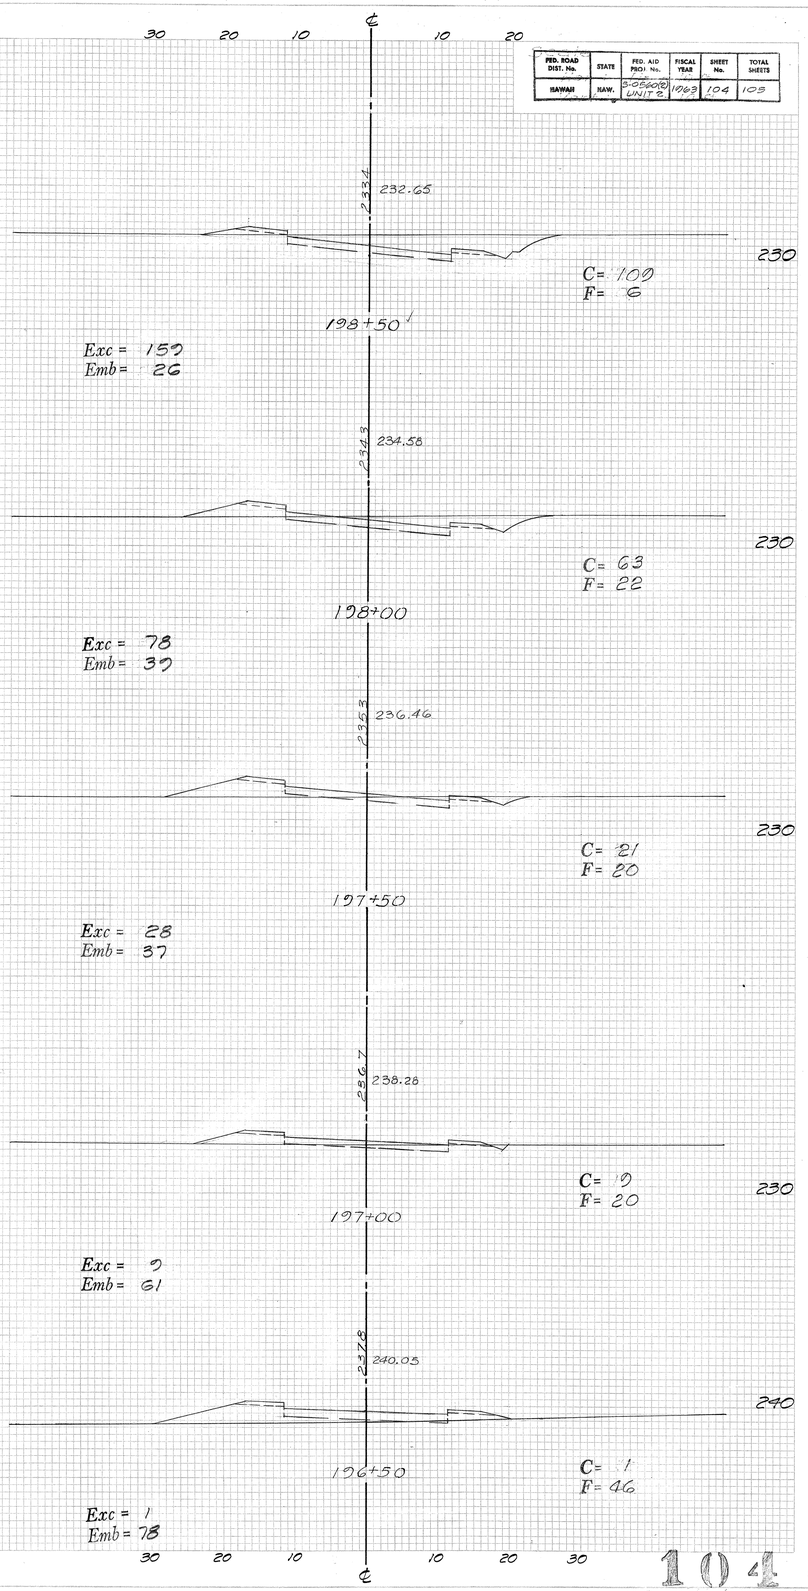

PLATE CROSS SECTION C. P. R. R. E. STANDARD
100 GAS FILTER PAPER MADE AND PRINTED IN U. S. A.
EUGENE DIETZGEN CO.

PED. ROAD DIST. No.	STATE	FED. AID PROJ. No.	FISCAL YEAR	SHEET No.	TOTAL SHEETS
HAWAII	HAW.	S-0660(2) UNIT 2	196	105	705

Scale:

FINAL SURVEY — NOTE BOOK — NO. — SURVEYED — PLOTTED — TEMPLATE — AREAS — CHECKED — BY — DATE

ORIGINAL SURVEY — NOTE BOOK — NO. — SURVEYED — PLOTTED — TEMPLATE — AREAS — CHECKED — BY — DATE

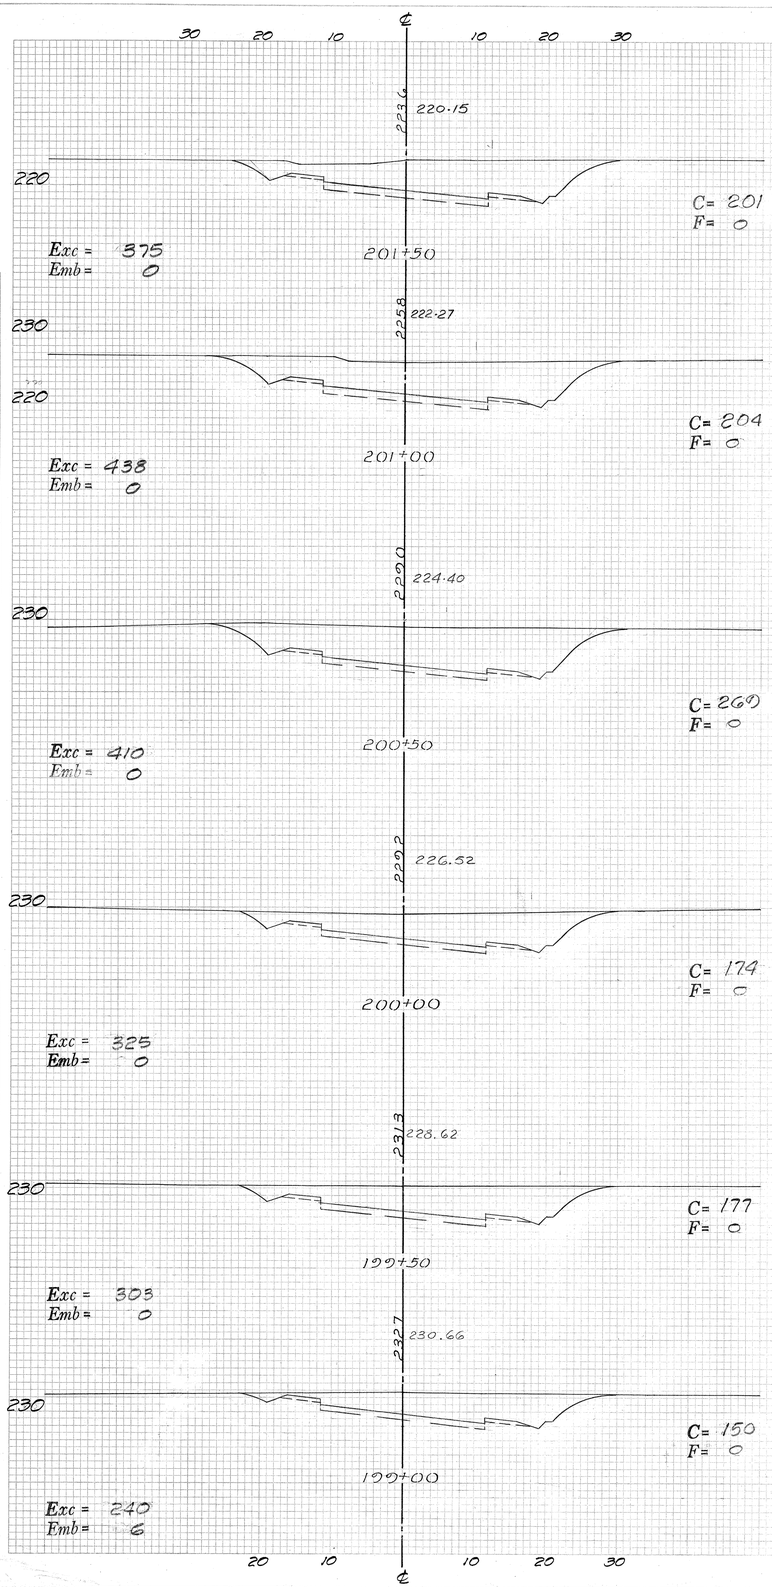

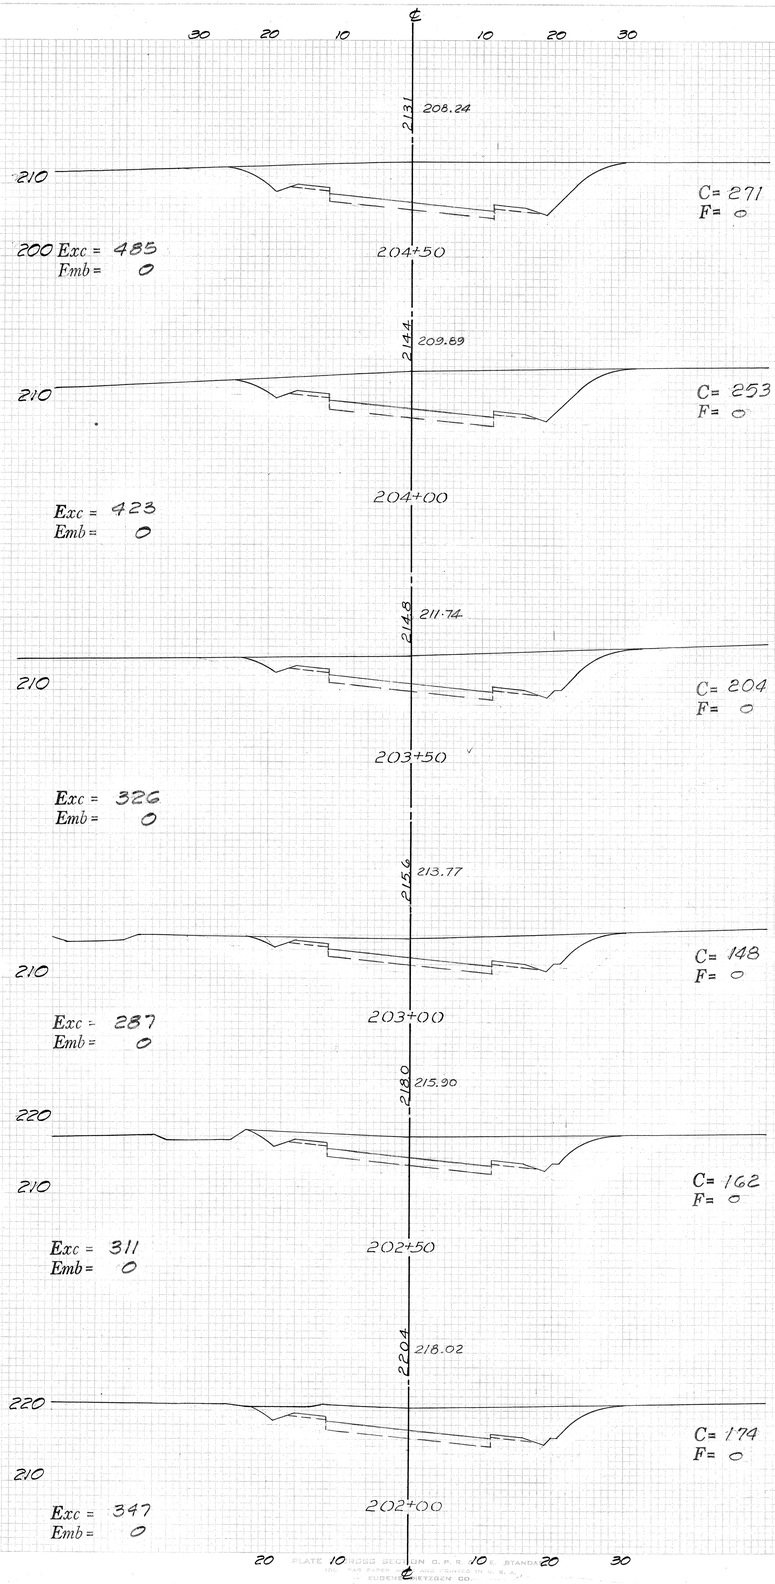

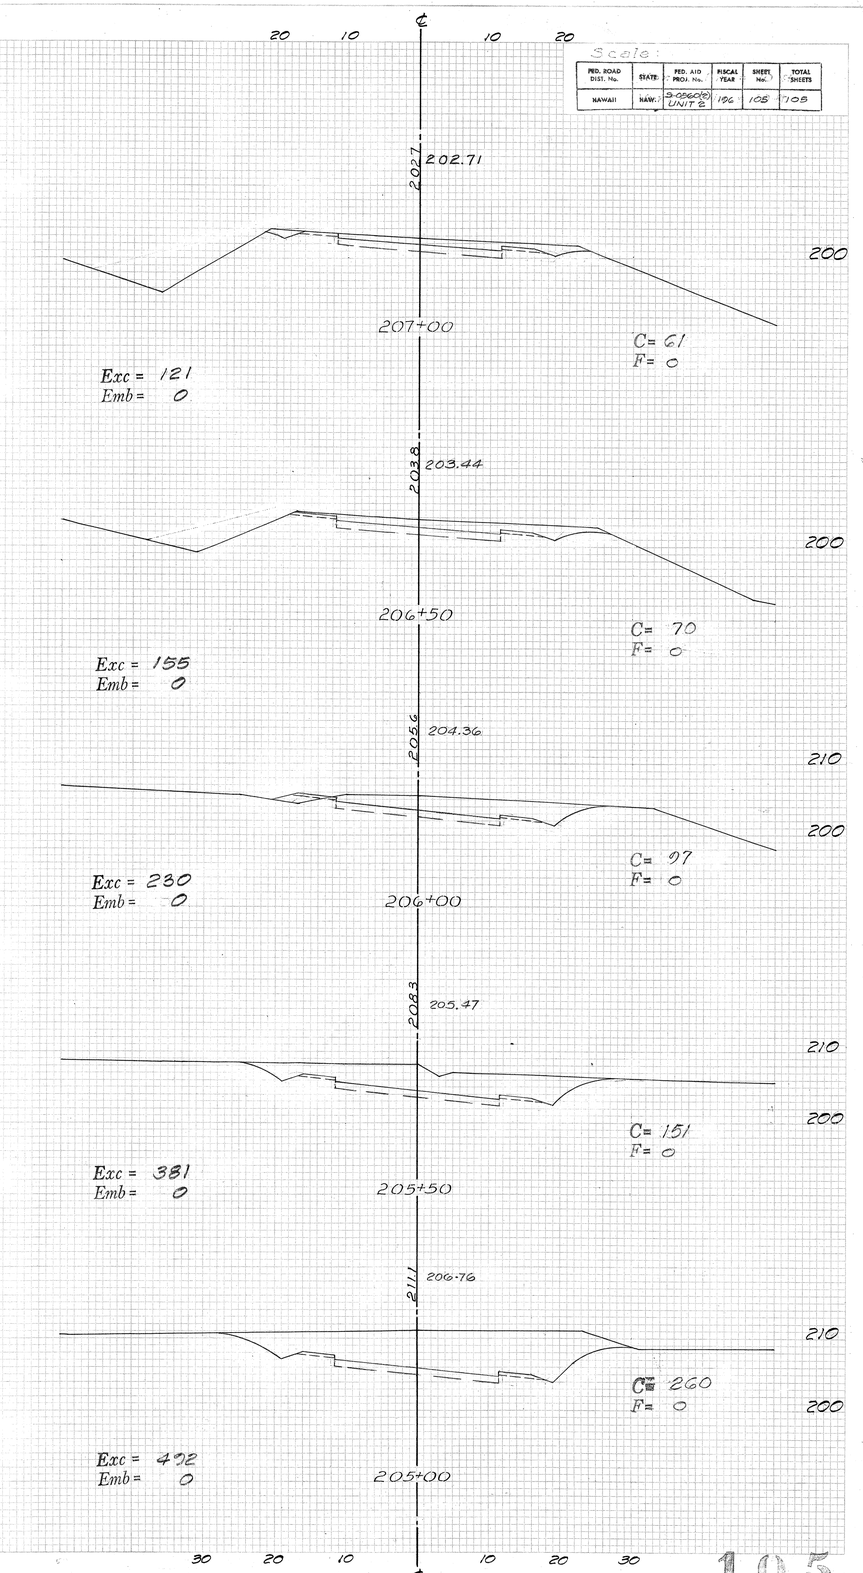

PLATE — ROSS BRAUN O. P. R. — STANDARD — EUGEN NETZEN CO.