FED. ROAD DIST. NO.	STATE	FED. AID PROJ. NO.	FISCAL YEAR	SHEET NO.	TOTAL SHEETS
HAWAII	HAW.	F-056-1(8)	1967	1	64

INDEX TO DRAWINGS

SHEET NO.	DESCRIPTION
1	TITLE SHEET
2	TYPICAL SECTIONS
3-6	PLAN AND PROFILE
7-13	MISC. AND STANDARD DETAILS
14-31	IRRIGATION & DRAINAGE DETAILS
32-33	LANDSCAPE PLANS
34-47	WAIAKALUA STREAM BRIDGE
48-64	CROSS SECTIONS

STATE OF HAWAII

DEPARTMENT OF TRANSPORTATION

HIGHWAYS DIVISION

AS BUILT PLANS FOR

KAUAI BELT ROAD

(KAHILI TO PILAA)

FEDERAL AID PRIMARY PROJECT NO. F-056-1(8)

DISTRICT OF HANALEI

ISLAND OF KAUAI

SCALES

PLAN		1 INCH = 100 FT.
PROFILE	HOR.	1 INCH = 100 FT.
	VER.	1 INCH = 10 FT.
CROSS SECTION	HOR.	1 INCH = 10 FT.
	VER.	1 INCH = 10 FT.

LOCATION OF PROJECT
NO. F-056-1(8)

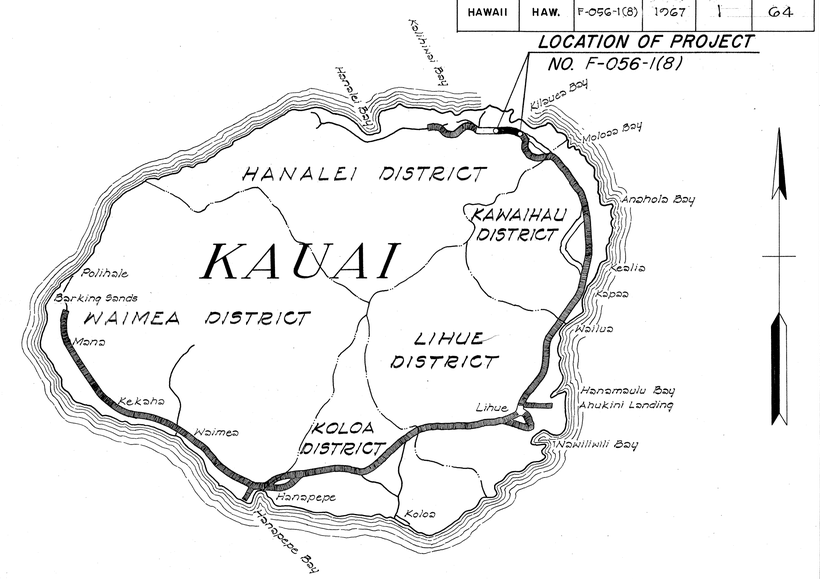

FEDERAL AID PROJECTS PREVIOUSLY CONSTRUCTED OR UNDER CONSTRUCTION

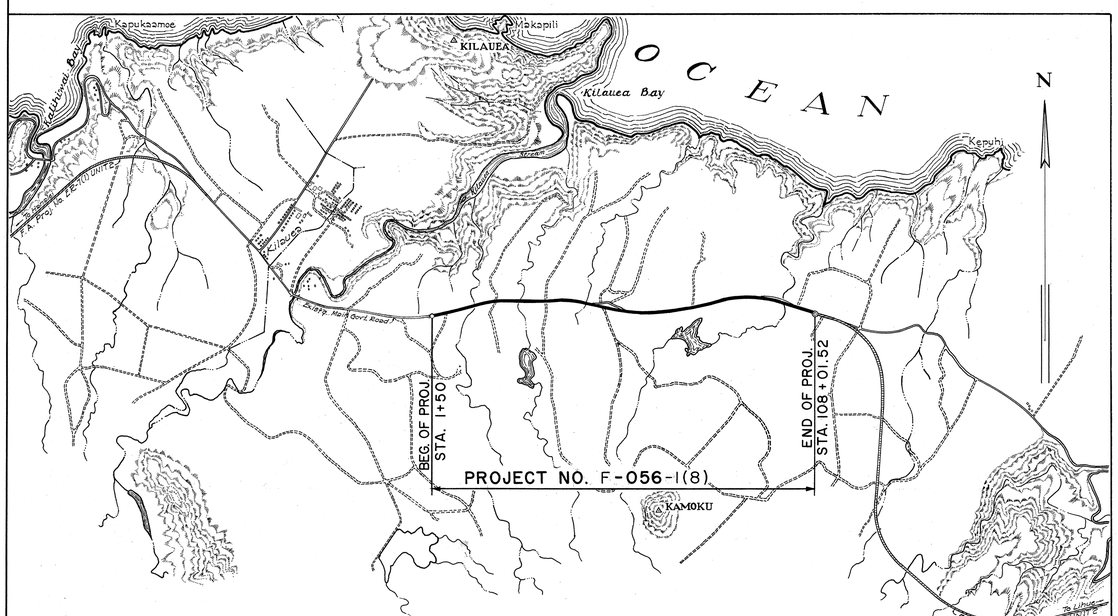

LAYOUT OF PROJECT

SCALE: 1" = 2000'

GROSS LENGTH OF PROJECT	2.019 Mi.
LENGTH OF BRIDGE	0.007 Mi.
NET LENGTH OF PROJECT	2.012 Mi.

DESIGN CLASSIFICATION

ADT (1967)	790
Design ADT (1987)	1280
DHV	150
D	55/45
T	15 %
T_{24}	12 %
V	60 M.P.H.

NOTE:
ALL CHANGES MADE DURING CONSTRUCTION HAVE BEEN NOTED IN RED ON THESE TRACINGS AND CHECKED BY:

Donald Nagamine
PROJECT ENGINEER

8-3-72
DATE

APPROVED: DATE 7/25/67

E. Alvey Wright Jr.
DIRECTOR OF TRANSPORTATION

DEPARTMENT OF TRANSPORTATION
BUREAU OF PUBLIC ROADS
APPROVED:

John M. Stokes
DIVISION ENGINEER

5/15/67
DATE

Designed by: A. Marutani June '67