DIST. NO.	STATE	PROJ. NO.	FISCAL YEAR	SHEET NO.	TOTAL SHEETS
HAWAII	HAW.	56A-02-67 UNIT I	1967	1	10

INDEX TO DRAWINGS

SHEET NO.	DESCRIPTION
1	TITLE SHEET
2	TYPICAL SECTIONS
3	PLAN & PROFILE
4	PAVEMENT MARKER LOCATION AND MISCELLANEOUS DETAILS
5-10	STANDARD DETAILS

STATE OF HAWAII

DEPARTMENT OF TRANSPORTATION

HIGHWAYS DIVISION

"AS BUILT" PLANS FOR

KAUAI BELT ROAD AT KAPAIA

(TRUCK CLIMBING LANE)

PROJECT NO. 56A-02-67 UNIT I

DISTRICT OF LIHUE

ISLAND OF KAUAI

SCALES

PLAN	1 INCH = 100 FT.
PROFILE	HOR. 1 INCH = 100 FT.
	VER. 1 INCH = 10 FT.

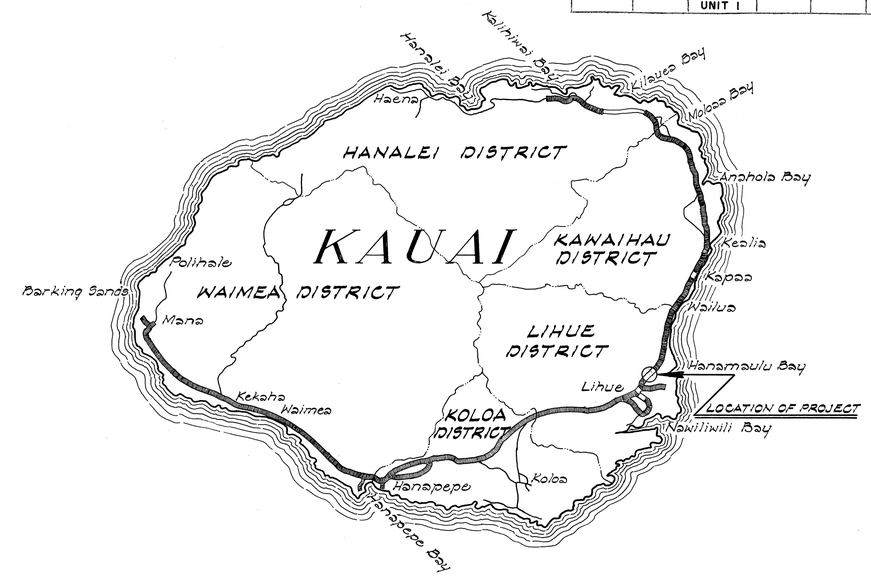

FEDERAL AID PROJECTS PREVIOUSLY CONSTRUCTED OR UNDER CONSTRUCTION

CONVENTIONAL SIGNS

Baseline
Boundary Line
Fences (Named)
Existing Roadway
Pipe Culvert
Box Culvert
Telephone Line & Pole
Electric Line & Pole
Water Main

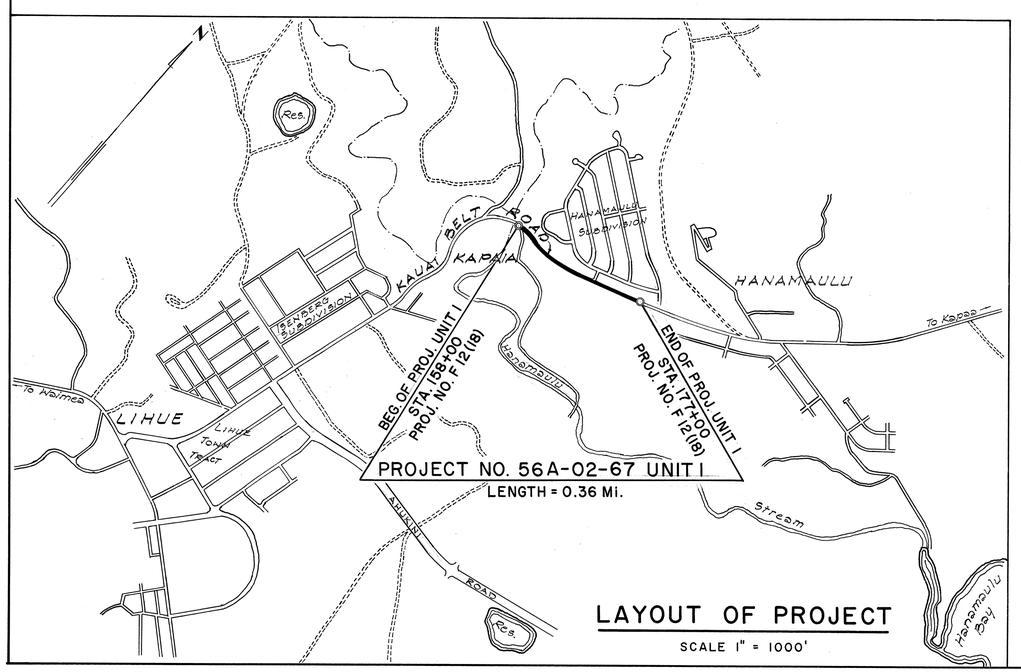

LAYOUT OF PROJECT

SCALE 1" = 1000'

NOTE:

ALL CHANGES MADE DURING CONSTRUCTION HAVE BEEN NOTED IN RED ON THESE TRACINGS AND CHECKED BY:

Masamori Murakami
PROJECT ENGINEER

5/21/68
DATE

APPROVED: DATE 10/16/67

For DIRECTOR OF TRANSPORTATION

A. Marutani
K. Wong
Oct. 1967

VD-D-9-10