FED.ROAD DIST. NO.	STATE	FED. AID PROJ. NO.	FISCAL YEAR	SHEET NO.	TOTAL SHEETS
HAWAII	HAW.	F-056-1(13)	1968	1	10

INDEX TO DRAWINGS

SHEET NO.	DESCRIPTION
1	TITLE SHEET
2-3	TYPICAL SECTION, PLAN & PROFILE
4-5	BOX CULVERT EXTENSION
6-10	STANDARD DETAILS

STATE OF HAWAII

DEPARTMENT OF TRANSPORTATION

HIGHWAYS DIVISION

PLANS FOR

KUHIO HIGHWAY IMPROVEMENTS

WAILUA GOLF COURSE VICINITY

KAUAI BELT ROAD

[F.A.P. PROJECT NO. F-12(18)]

PROJECT NO. F-056-1(13)

DISTRICT OF LIHUE

ISLAND OF KAUAI

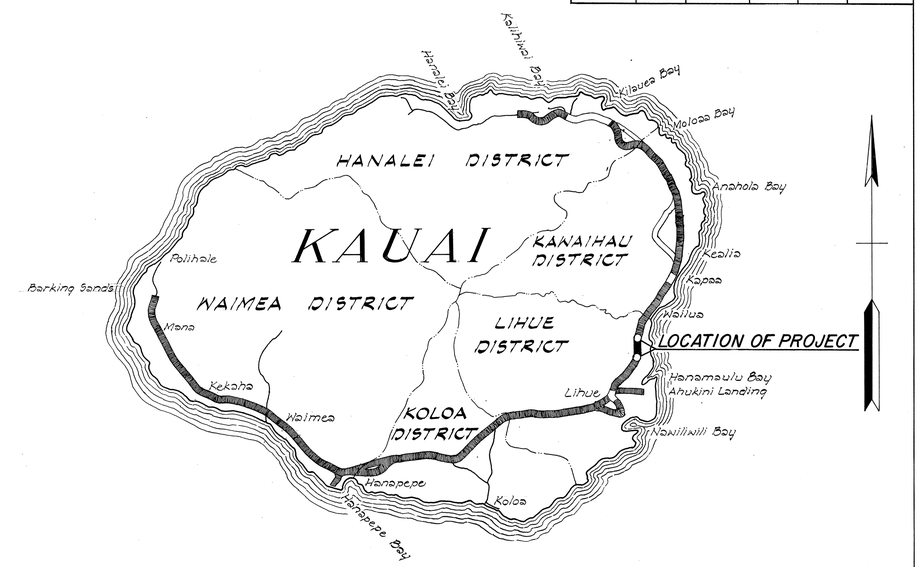

FEDERAL AID PROJECTS PREVIOUSLY CONSTRUCTED OR UNDER CONSTRUCTION

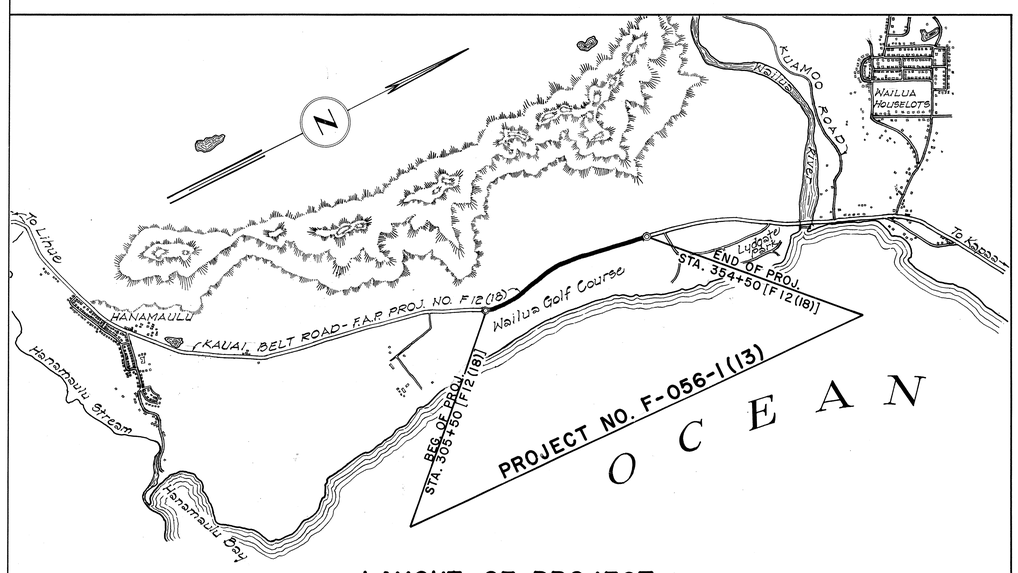

LAYOUT OF PROJECT

SCALE: 1" = 2000'

NO AS-BUILT CHANGES MADE DURING CONSTRUCTION.

Donald Nagamine 8-11-81

PROJECT ENGINEER DATE

APPROVED:

Lujio Matsuda 7 June 68

DIRECTOR OF TRANSPORTATION DATE

DEPARTMENT OF TRANSPORTATION
BUREAU OF PUBLIC ROADS

APPROVED:

Neil Dillaughe 12-17-68

FOR DIVISION ENGINEER DATE

K. WONG