


DIST. NO.	STATE	PROJ. NO.	FISCAL YEAR	SHEET NO.	TOTAL SHEETS
HAWAII	HAW.	56A-04-70	1970	2	7

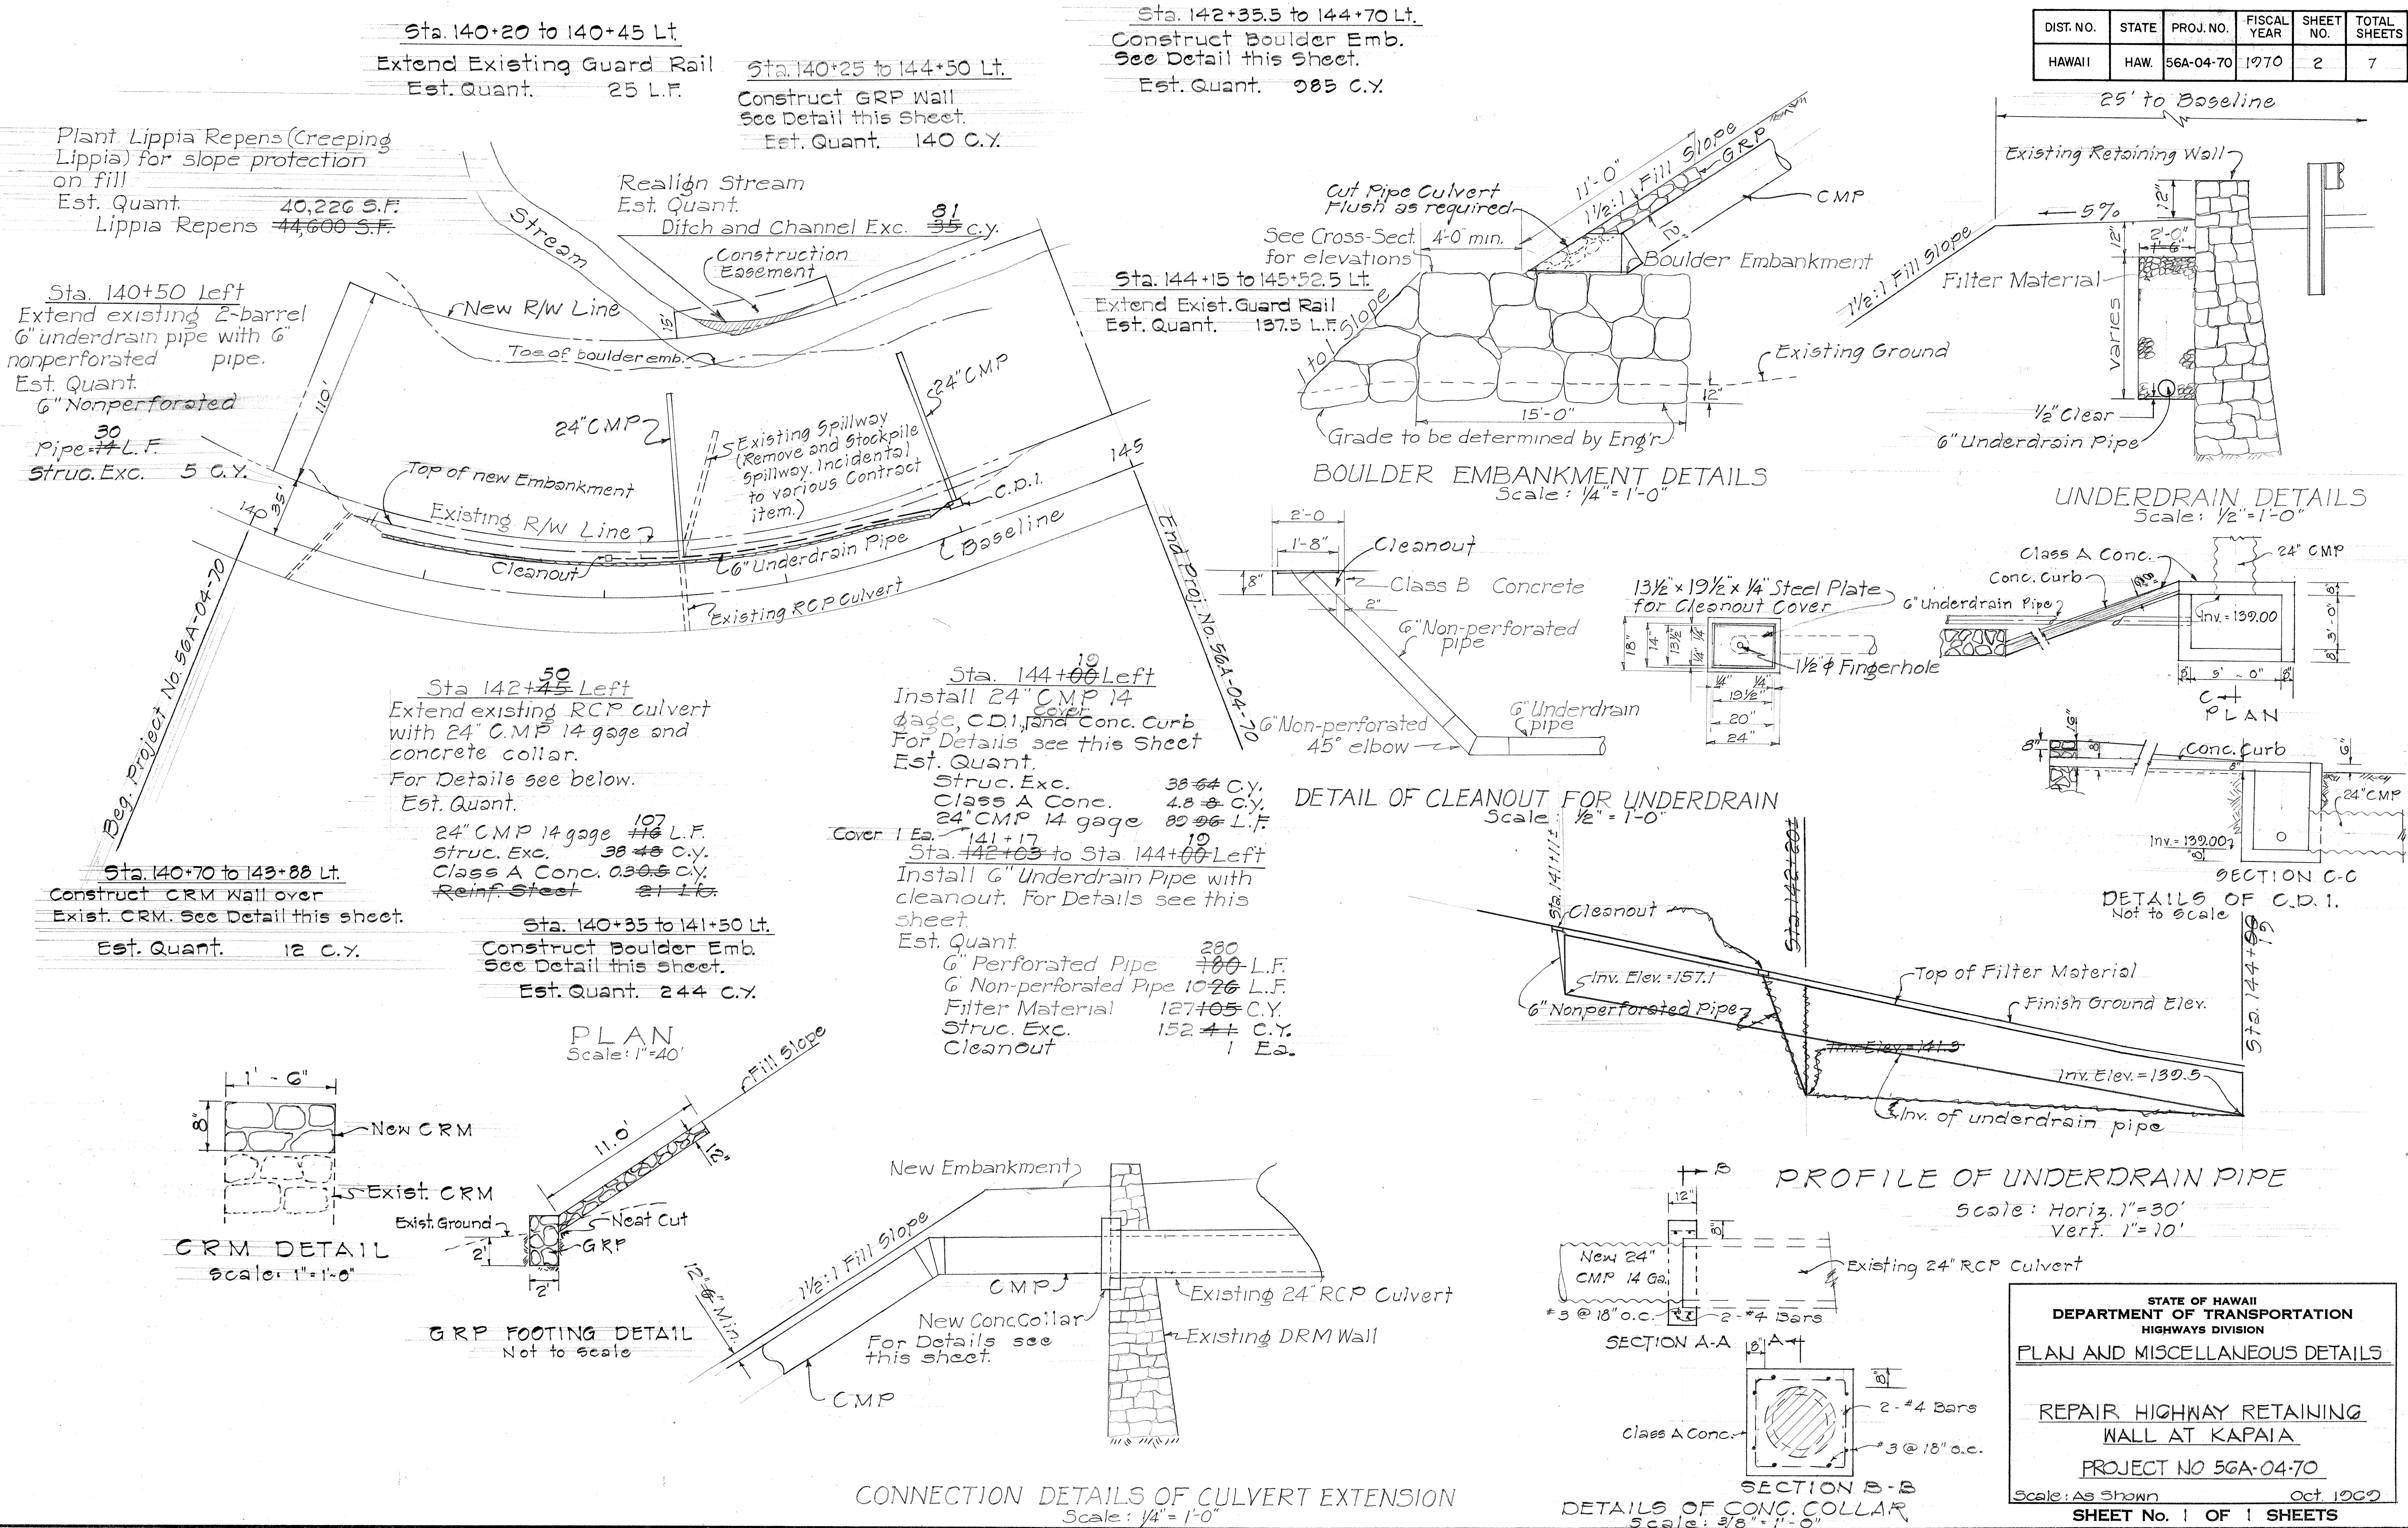

SURVEY PLOTTED BY	DATE
DESIGNED BY	
TRAINED BY	
NOTED BY	
QUANTITIES BY	
CHECKED BY	
ORIGINAL PLAN	
NOTE BOOK	
No.	

STATE OF HAWAII
DEPARTMENT OF TRANSPORTATION
HIGHWAYS DIVISION
PLAN AND MISCELLANEOUS DETAILS

REPAIR HIGHWAY RETAINING WALL AT KAPAIA
PROJECT NO 56A-04-70
Scale: As Shown
OCT 1969
SHEET No. 1 OF 1 SHEETS