FED. ROAD DIST. NO.	STATE	PROJ. NO.	FISCAL YEAR	SHEET NO.	TOTAL SHEETS
HAWAII	HAW.	56A-05-70	1970	1	2

INDEX TO DRAWINGS

SHEET NO.	DESCRIPTION
1	TITLE SHEET
2	PLAN AND DETAILS

STATE OF HAWAII

DEPARTMENT OF TRANSPORTATION

HIGHWAYS DIVISION

PLANS FOR

KUHIO HIGHWAY DRAINAGE IMPROVEMENTS VICINITY OF KUMUKUMU CAMP

PROJECT NO. 56A-05-70

DISTRICT OF KAWAIHAU

ISLAND OF KAUAI

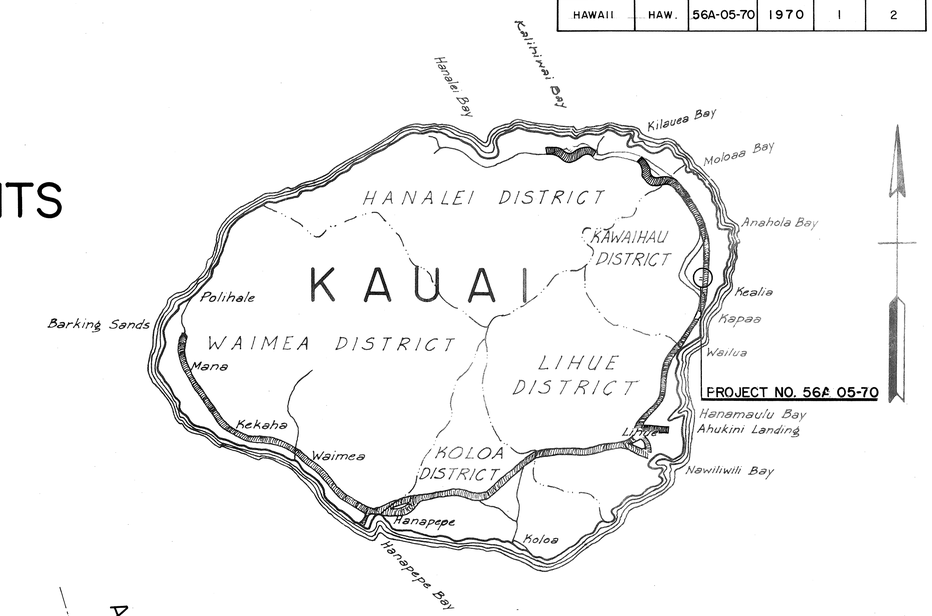

FEDERAL AID PROJECTS PREVIOUSLY CONSTRUCTED OR UNDER CONSTRUCTION

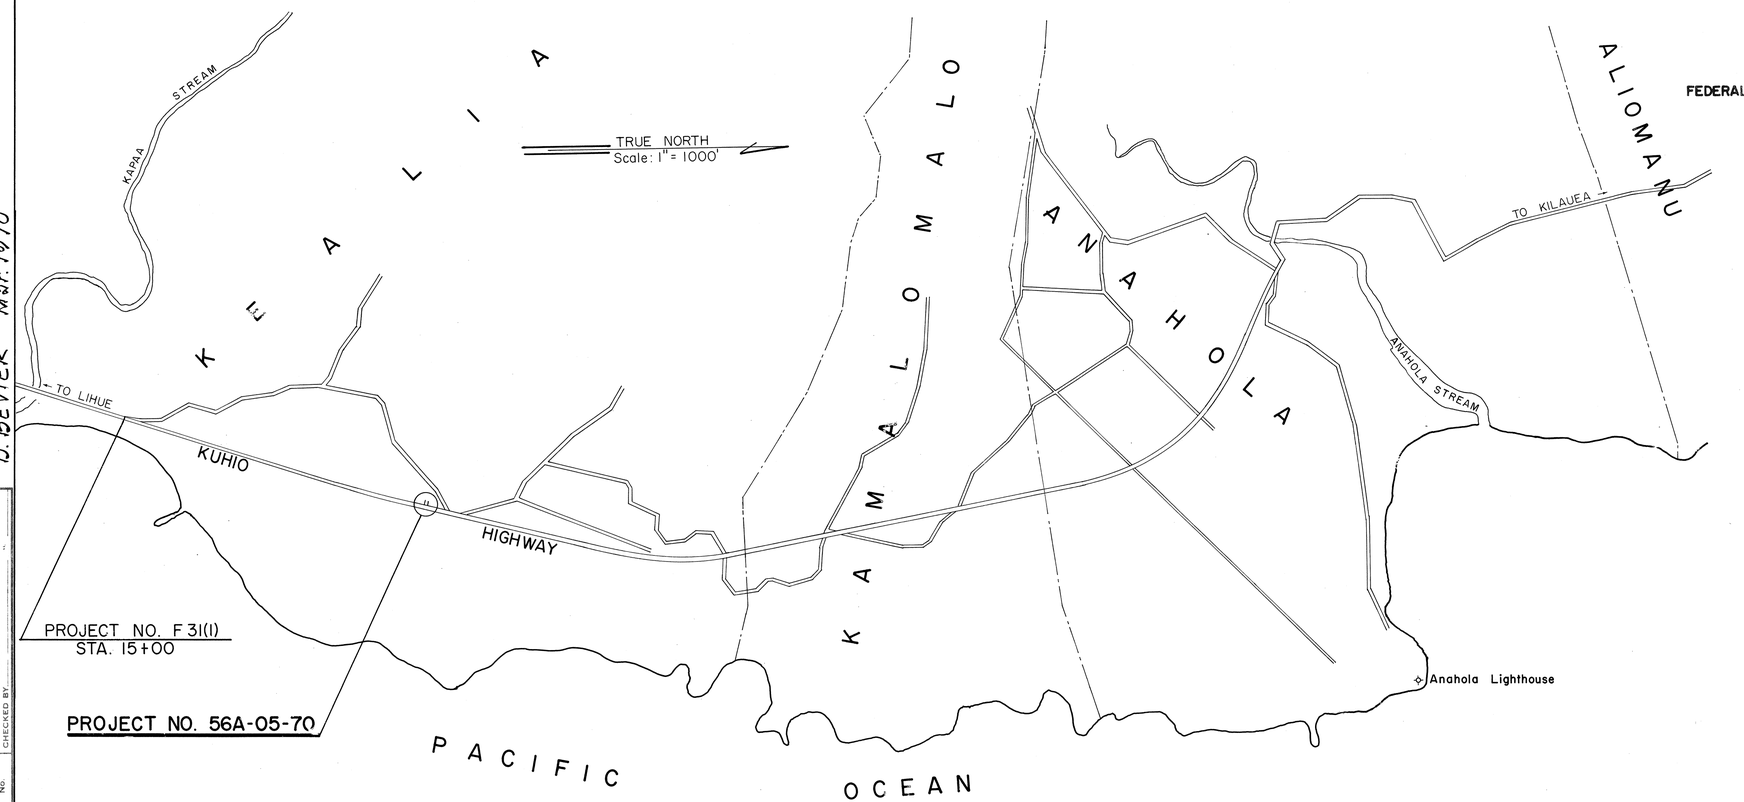

LAYOUT OF PROJECT

NO AS-BUILT CHANGES MADE DURING CONSTRUCTION.

Donald Nagamine 8-11-81

PROJECT ENGINEER DATE

D. BEVIER Mar. 1970

ORIGINAL PLAN	SURVEY PLOTTED BY	DATE
	DESIGNED BY	"
	DRAWN BY	"
	TRACED BY	"
NOTE BOOK No.	QUANTITIES BY	"
	QUANTITIES CHECKED BY	"
	CHECKED BY	"

DEPARTMENT OF TRANSPORTATION
STATE OF HAWAII

APPROVED:

for E. Alvey Wright 5/21/70

DIR. OF TRANSPORTATION DATE

PRINTED ON MILTEGEN 150M AGEPROOF