DIST. NO.	STATE	PROJ. NO.	FISCAL YEAR	SHEET NO.	TOTAL SHEETS
HAWAII	HAW.	BD 69-464	1972	1	23

INDEX TO DRAWINGS

SHEET NO	DESCRIPTION
1	TITLE SHEET
2 - 3	TYPICAL SECTIONS AND DETAILS
4 - 9	PLAN AND PROFILE
10 - 15	STANDARD DETAILS
16 - 23	CROSS SECTIONS

STATE OF HAWAII

DEPARTMENT OF TRANSPORTATION

HIGHWAYS DIVISION

PLANS FOR

CONSTRUCTION OF WALKWAYS, CASTAWAY HOTEL TO LYDGATE RESORT DEVELOPEMENT

PROJECT NO. BD 69-464

DISTRICT OF LIHUE AND KAWAIHAU

ISLAND OF KAUAI

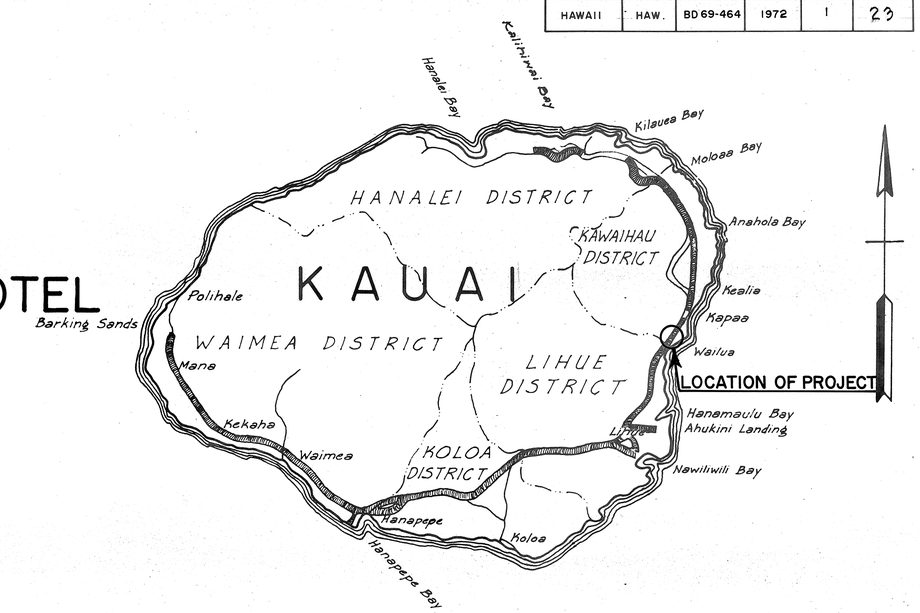

FEDERAL AID PROJECTS PREVIOUSLY CONSTRUCTED OR UNDER CONSTRUCTION

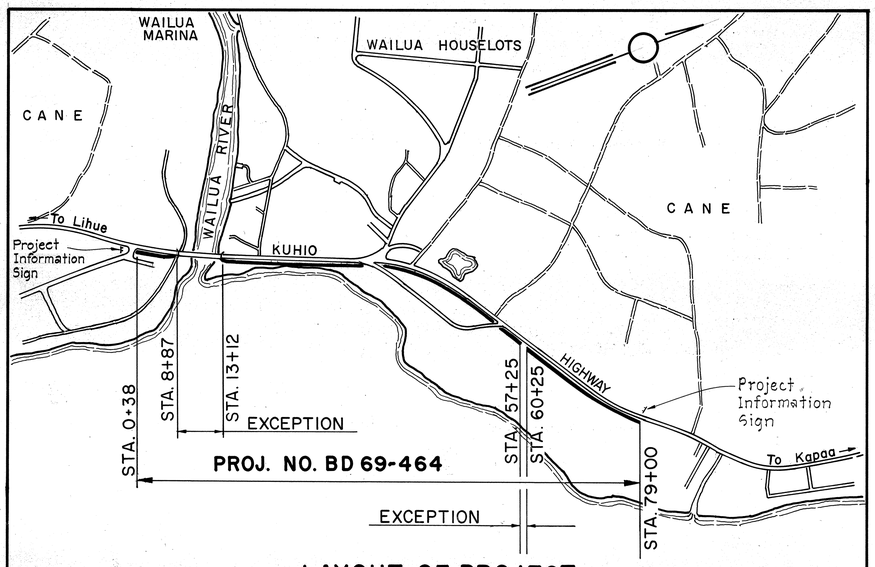

LAYOUT OF PROJECT

Scale: 1" = 1000

June, 1971 — Date

548-7537 — Phone-Loc.

D. Bevier — PS&E By

Kauai District — Designed By

ORIGINAL PLAN		DATE
	SURVEY PLOTTED BY	
	DESIGNED BY	
	DRAWN BY	
	TRACED BY	
NOTE BOOK	QUANTITIES BY	
No.	QUANTITIES CHECKED BY	
	CHECKED BY	

DEPARTMENT OF TRANSPORTATION
STATE OF HAWAII

APPROVED:

for DIR. OF TRANSPORTATION — 6/7/71 DATE

D-9-2

PRINTED ON ULTRAGEN 150M AGEPROOF