FED. ROAD DIST. NO.	STATE	~~FED. AID~~ PROJ. NO.	FISCAL YEAR	SHEET NO.	TOTAL SHEETS
HAWAII	HAW.	56A-01-75	1975	1	5

INDEX TO DRAWINGS

SHEET NO.	DESCRIPTION
1	TITLE SHEET
2	PART LAYOUT PLAN AND SECTION
3	FRAMING PLAN AND DETAILS
4 - 5	SECTIONS AND DETAILS

STATE OF HAWAII

DEPARTMENT OF TRANSPORTATION

HIGHWAYS DIVISION

HONOLULU, HAWAII

"AS BUILT"

PLANS FOR

REPAIRS TO WAILUA BRIDGE, KUHIO HIGHWAY

KAUAI BELT ROAD

PROJECT NO. 56A-01-75

DISTRICT OF LIHUE
ISLAND OF KAUAI

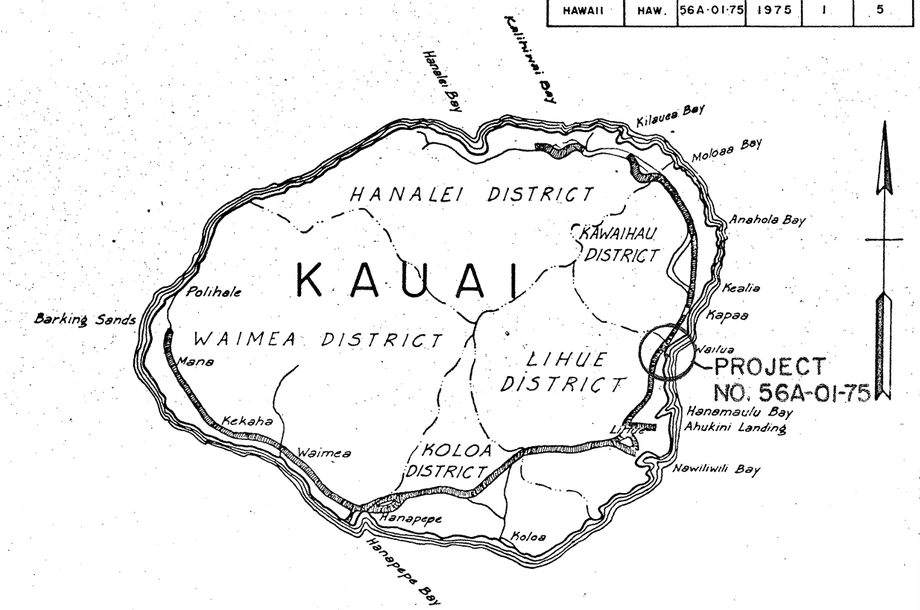

FEDERAL AID PROJECTS PREVIOUSLY CONSTRUCTED OR UNDER CONSTRUCTION

ITEM NO.	*ESTIMATED QUANTITIES
501.91	Structural Steel 20,420.1 ~~19,550~~ Lbs.
647.91	Surface Crack Repairs 16.6 ~~52~~ Lin. Ft.

NOTES:

* All works such as welding, hardware, drill holes, epoxy mortar, adhesive, bearing pads and other items not specifically indicated as pay items shall be incidental to structural steel and will not be paid for separately.

Refer to Sht. #4 for general notes.

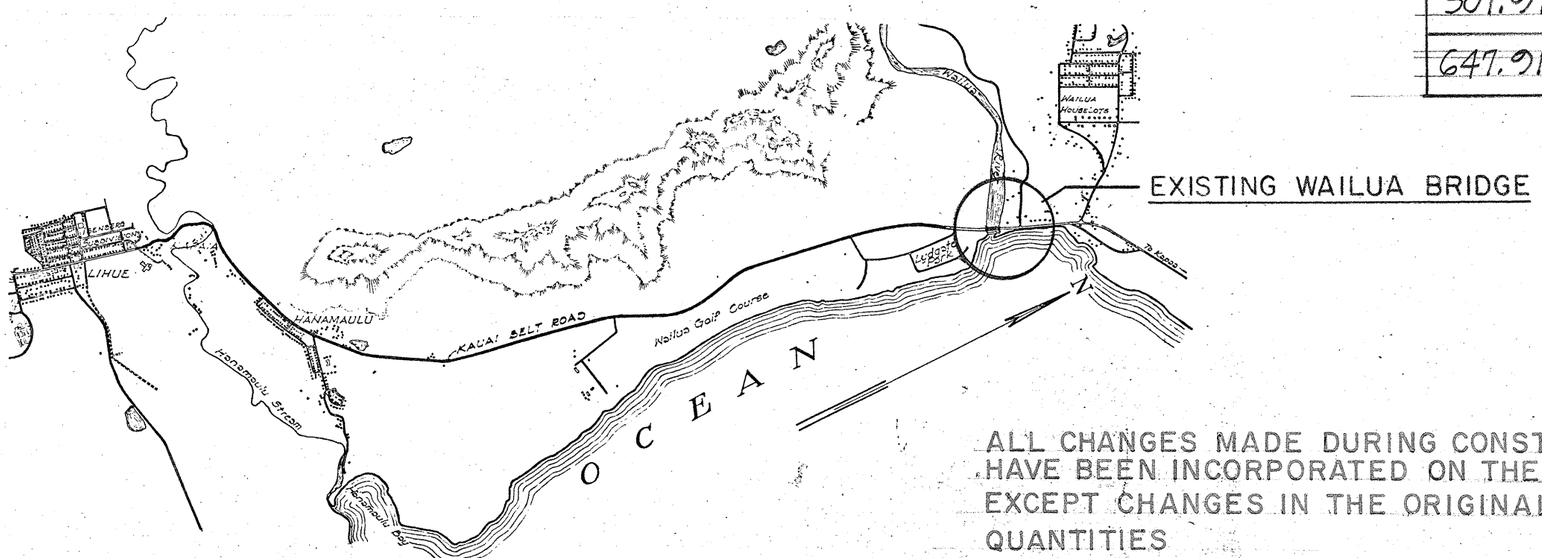

LAYOUT OF PROJECT

SCALE: 1" = 2000'

ALL CHANGES MADE DURING CONSTRUCTION HAVE BEEN INCORPORATED ON THESE PLANS EXCEPT CHANGES IN THE ORIGINAL THEORETICAL QUANTITIES

PROJECT ENGINEER — DATE 1-22-81

ORIGINAL PLAN	SURVEY PLOTTED BY	DATE
	DESIGNED BY	NOV '74
	DRAWN BY	"
	TRACED BY	"
NOTE BOOK	QUANTITIES BY NY	"
No.	QUANTITIES CHECKED BY	"
	CHECKED BY	"

DEPARTMENT OF TRANSPORTATION
STATE OF HAWAII
APPROVED:
Ryokichi Higashiomura 1/23/75
For DIR. OF TRANSPORTATION — DATE

SHEET No. 1 OF 5 SHEETS

6-6-77