FED. ROAD DIST. NO.	STATE	FED. AID PROJ. NO.	FISCAL YEAR	SHEET NO.	TOTAL SHEETS
HAWAII	HAW.	HHS-056-1(22)	1978	1	18

INDEX TO DRAWINGS

SHEET NO.	DESCRIPTION
1	TITLE SHEET
2	TYPICAL SECTION & MISC. DETAILS
3-4	PLAN & PROFILE
5	CONN. OF EXIST'G. PAVED OLD ROAD TO EXIST'G. DIRT ROAD
6	DETAIL - BUS STOP, APPROACH & DRAINAGE SYSTEM
7-16	STANDARD DETAILS
17-18	CROSS SECTIONS

STATE OF HAWAII

DEPARTMENT OF TRANSPORTATION
LAND TRANSPORTATION FACILITIES DIVISION

"AS BUILT"
PLANS FOR

KAUAI BELT ROAD, SAFETY IMPROVEMENTS, VICINITY OF KAUAI HARDWOODS

FEDERAL AID PROJ. NO. HHS-056-1(22)

DISTRICT OF LIHUE

ISLAND OF KAUAI

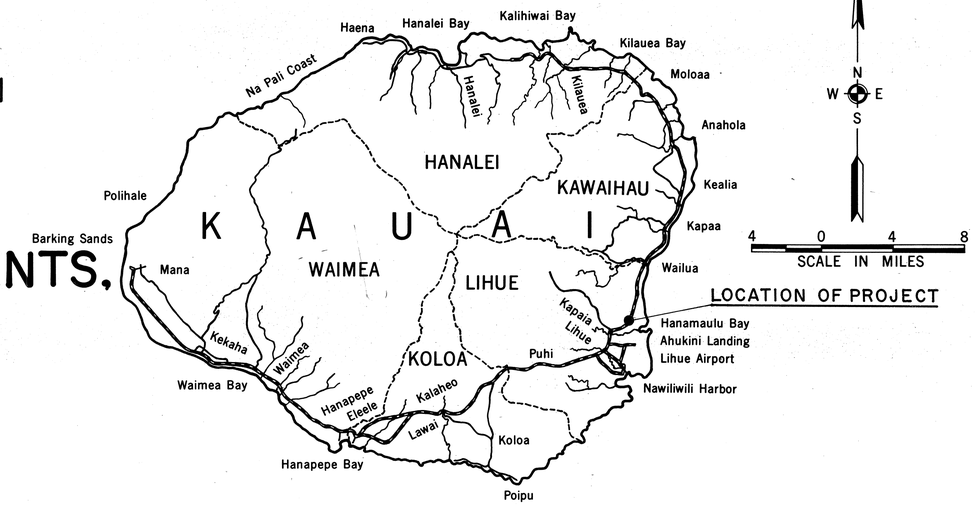

FEDERAL AID PROJECTS PREVIOUSLY CONSTRUCTED OR UNDER CONSTRUCTION

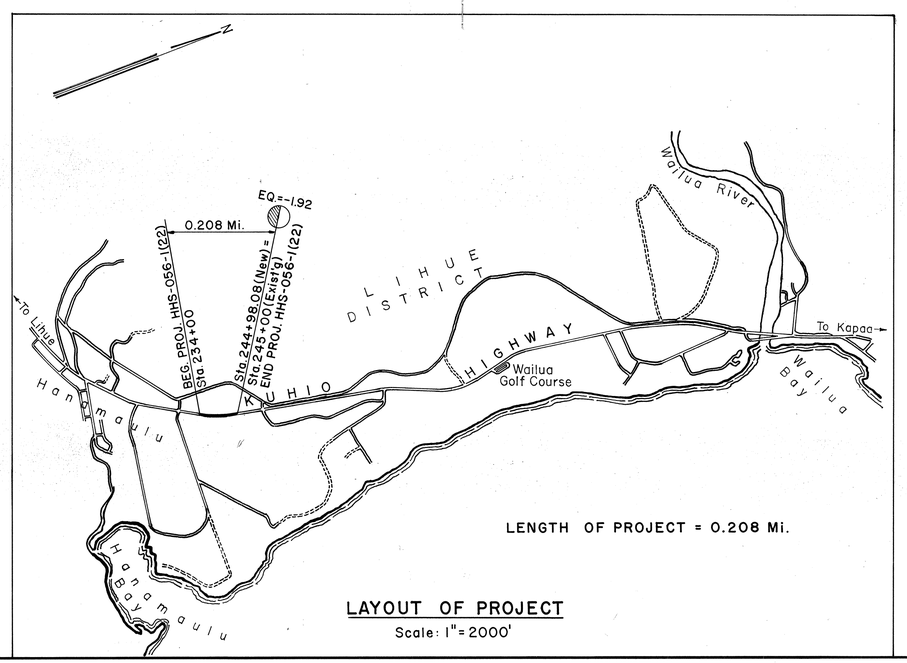

LENGTH OF PROJECT = 0.208 Mi.

LAYOUT OF PROJECT
Scale: 1" = 2000'

DESIGN CLASSIFICATION

ADT (1976) ------ 12,180
ADT (1996) ------ 19,500
DHV ---------- 1,850
T_{24} ---------- 9.5 %
V ---------- 60 MPH

ALL CHANGES MADE DURING CONSTRUCTION HAVE BEEN INCORPORATED ON THESE PLANS IN RED EXCEPT CHANGES IN THE ORIGINAL THEORETICAL QUANTITIES.

PROJECT ENGINEER

7-21-80
DATE

KAUAI DISTRICT
DESIGNED BY

R. MIKAMI
P. S. & E. BY

548-7534
PHONE

2/27/78
DATE

DEPARTMENT OF TRANSPORTATION
FEDERAL HIGHWAY ADMINISTRATION
APPROVED:
DIVISION ADMINISTRATOR — 8-17-78 DATE

DEPARTMENT OF TRANSPORTATION
STATE OF HAWAII
APPROVED:
R. Higashionna — 2/27/78
DIR. OF TRANSPORTATION — DATE