FED. ROAD DIST. NO.	STATE	PROJ. NO.	FISCAL YEAR	SHEET NO.	TOTAL SHEETS
HAWAII	HAW.	56A-01-89M 56B-01-89M	1989	1	12

56

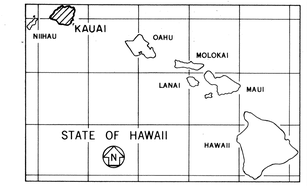

INDEX TO DRAWINGS

SHEET NO.	DESCRIPTION
1	TITLE SHEET
2	STANDARD PLAN SUMMARY
3	GENERAL & PAVEMENT MARKING NOTES
4 - 9	PLANS - LIHUE TOWN SECTION
10	TYPICAL SECTION & DETAILS - KEALIA TO ANAHOLA
11 & 12	PLANS - KEALIA TO ANAHOLA

STATE OF HAWAII

DEPARTMENT OF TRANSPORTATION

HIGHWAYS DIVISION

"AS-BUILT"

PLANS FOR

KUHIO HIGHWAY RESURFACING

LIHUE TOWN SECTION

PROJECT NO. 56A-01-89M

AND

KEALIA TO ANAHOLA

PROJECT NO. 56B-01-89M

DISTRICTS OF LIHUE AND KAWAIHAU

ISLAND OF KAUAI

PROJECT LOCATION
PROJ. NO. 56B-01-89M

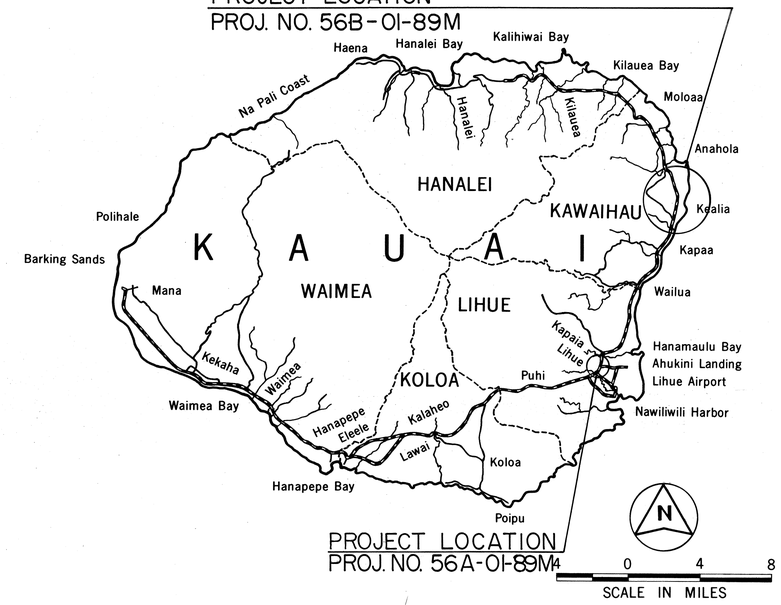

PROJECT LOCATION
PROJ. NO. 56A-01-89M

FEDERAL AID PROJECTS PREVIOUSLY CONSTRUCTED OR UNDER CONSTRUCTION

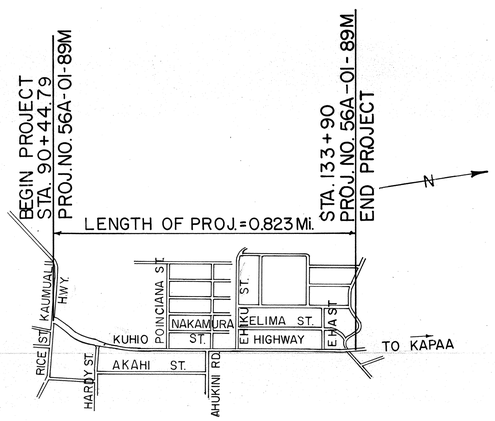

LIHUE TOWN SECTION

LOCATION OF PROJECT

NTS

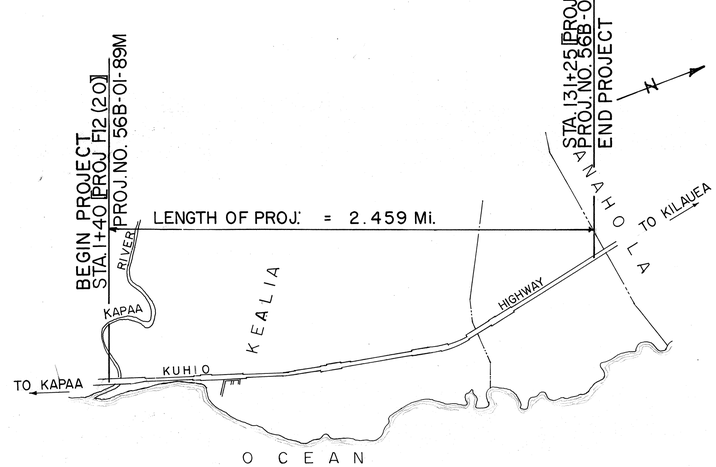

KEALIA TO ANAHOLA

LOCATION OF PROJECT

NTS

CHANGES MADE DURING CONSTRUCTION HAVE BEEN INCORPORATED ON THESE PLANS EXCEPT CHANGES IN THE ORIGINAL THEORETICAL QUANTITIES. FOR ACTUAL QUANTITIES, REFER TO PROJECT LEDGER AND/OR COMPUTATION BOOK.

Darryl H Maeda — RESIDENT ENGINEER — 8/2/89 DATE

DEPARTMENT OF TRANSPORTATION
STATE OF HAWAII

APPROVED:

Edward Hirata — DIR. OF TRANSPORTATION — 11/9/88 DATE

KAUAI DISTRICT — DESIGNED BY
A. YAMAGUCHI — P. S. & E. BY
548-7534 — PHONE
OCT, 1988 — DATE