FED. ROAD DIST. NO.	STATE	PROJ. NO.	FISCAL YEAR	SHEET NO.	TOTAL SHEETS
HAWAII	HAW.	56D–03–08M	2008	1	20

56

INDEX TO DRAWINGS	
SHEET NO.	DESCRIPTION
1	TITLE SHEET
2	STANDARD PLANS SUMMARY
3	GENERAL NOTES AND LEGEND
4 – 5	WATER POLLUTION AND EROSION CONTROL NOTES
6 – 8	TYPICAL SECTIONS
9 – 13	ROADWAY PLAN
14	PAVEMENT MARKING LEGEND, DETAILS AND NOTES
15 – 19	PAVEMENT MARKING AND TRAFFIC SIGNING PLAN
20	LOW SPEED UNDIVIDED HIGHWAY WORK ZONE SIGNING PLAN, NOTES AND DETAILS

STATE OF HAWAII

DEPARTMENT OF TRANSPORTATION

HIGHWAYS DIVISION

HONOLULU, HAWAII

"AS-BUILT"

PLANS FOR

KUHIO HIGHWAY RESURFACING

ANINI VISTA DRIVE TO MILE POST 27.0

PROJECT NO. 56D–03–08M

DISTRICT OF HANALEI

ISLAND OF KAUAI

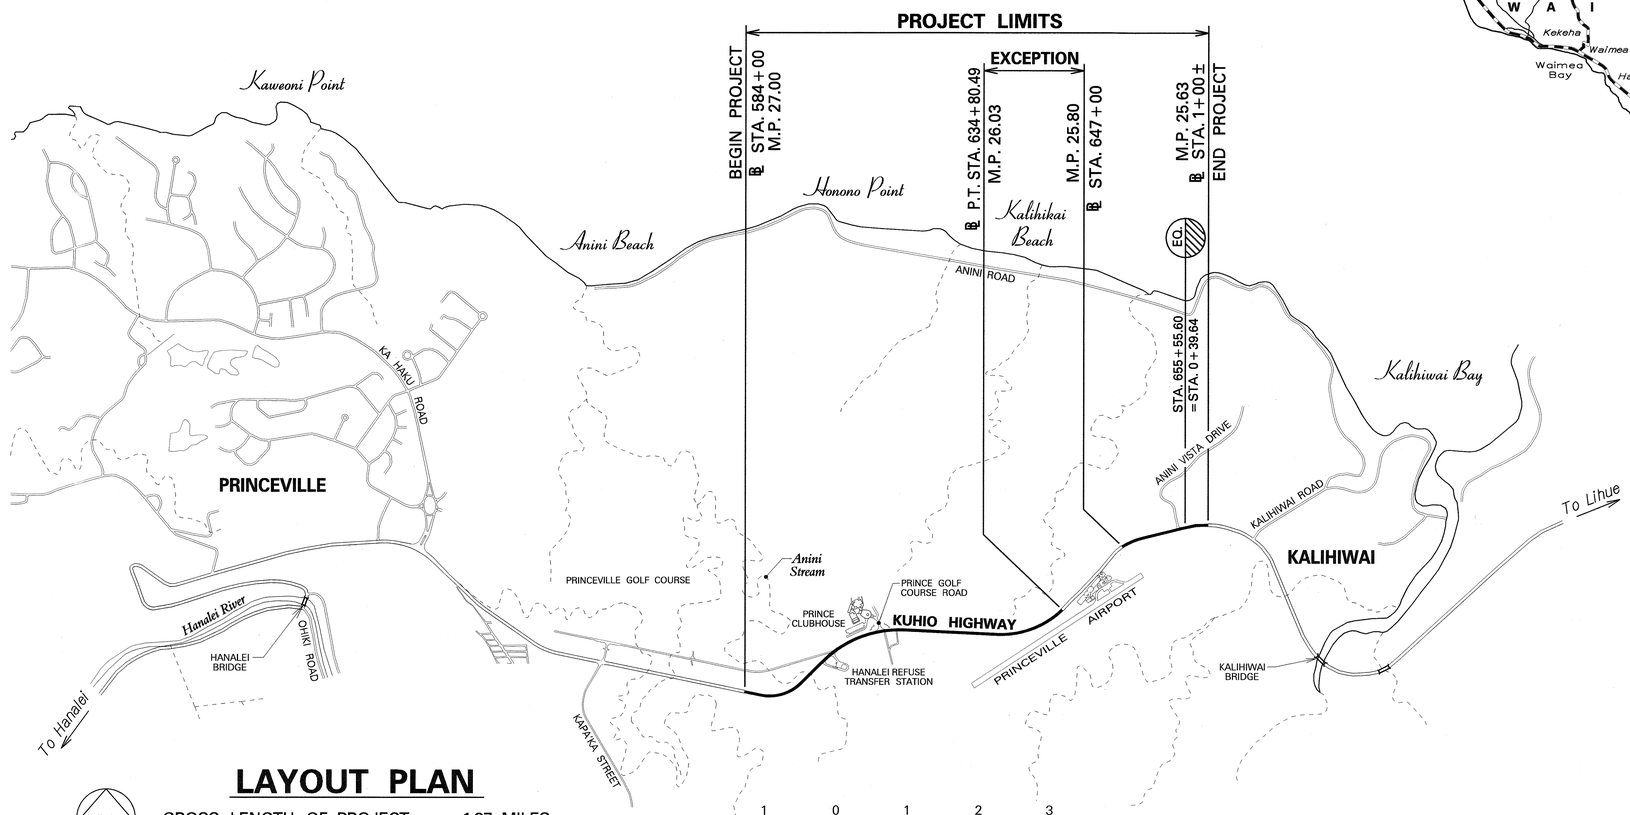

LAYOUT PLAN

GROSS LENGTH OF PROJECT. . . . . 1.37 MILES

NET LENGTH OF PROJECT. . . . . 1.14 MILES

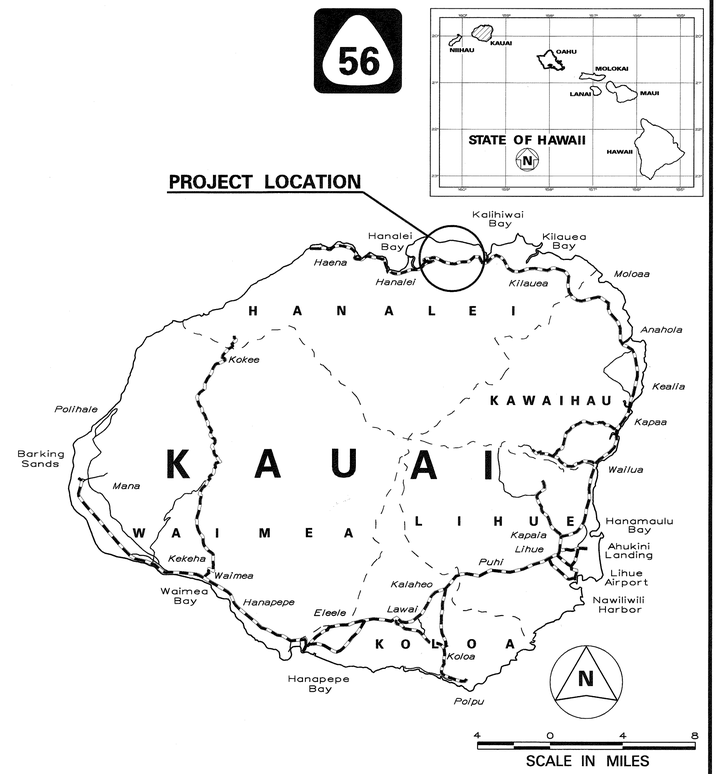

FEDERAL AID PROJECTS PREVIOUSLY CONSTRUCTED OR UNDER CONSTRUCTION

MILE POST 25.63 TO MILE POST 27.00

CHANGES MADE DURING CONSTRUCTION HAVE BEEN INCORPORATED ON THESE PLANS EXCEPT CHANGES IN THE ORIGINAL THEORETICAL QUANTITIES. FOR ACTUAL QUANTITIES, REFER TO PROJECT LEDGER AND/OR COMPUTATION BOOK.

RESIDENT ENGINEER — 5/6/2010 DATE

DEPARTMENT OF TRANSPORTATION
STATE OF HAWAII

APPROVED:

for DIR. OF TRANSPORTATION — 3-7-08 DATE

HWY-K	HWY-KE	241-3000	MAR. 2008
DESIGNED BY	MANAGED BY	PHONE	DATE