FED. ROAD DIST. NO.	STATE	FEDERAL AID PROJ. NO.	FISCAL YEAR	SHEET NO.	TOTAL SHEETS
HAWAII	HAW.	ER-19(007)	2018	13	67

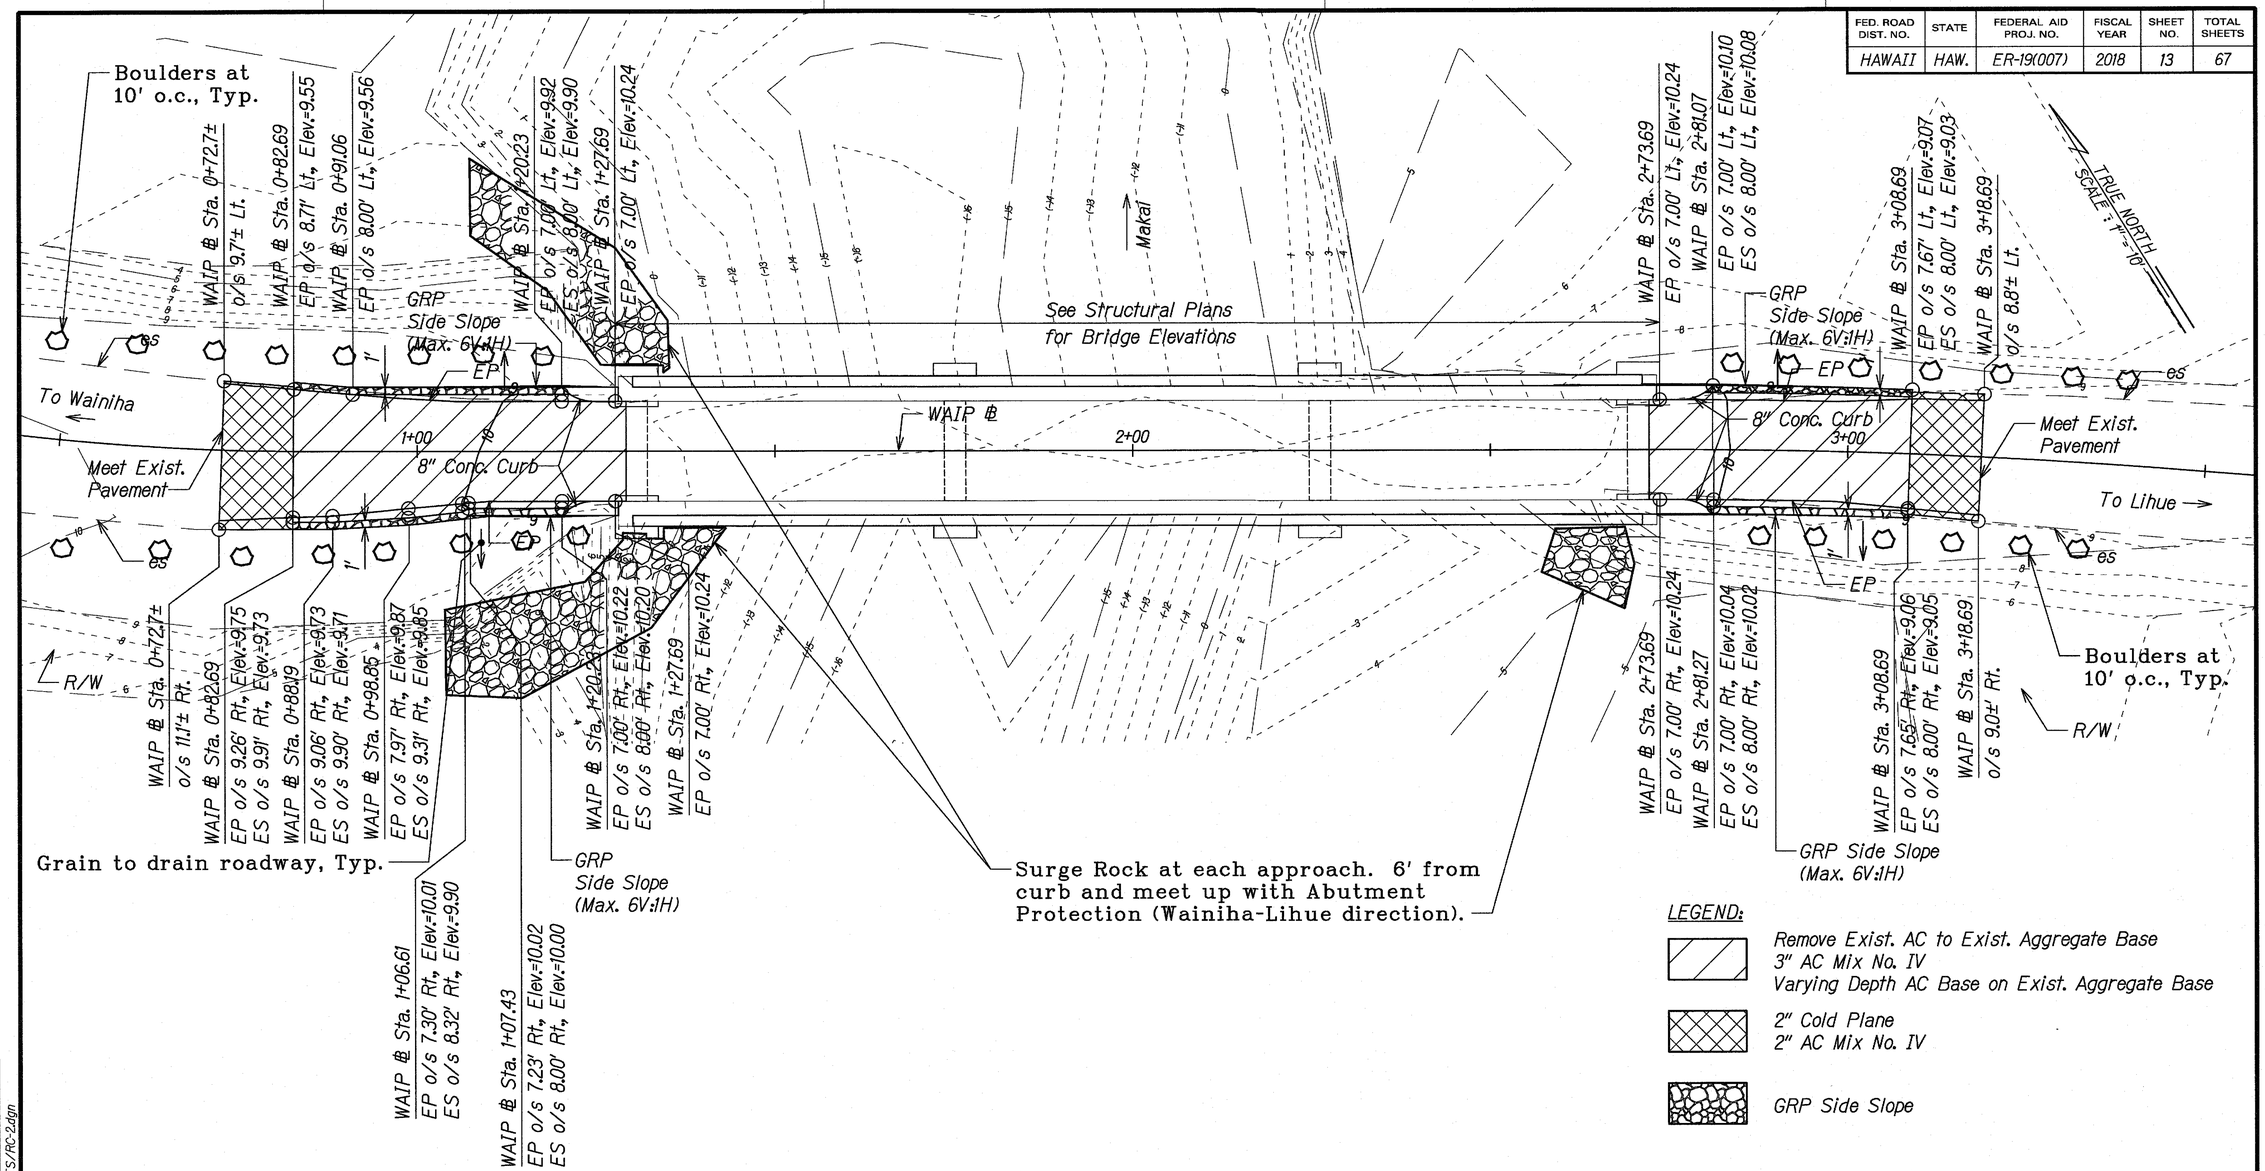

LEGEND:

- Remove Exist. AC to Exist. Aggregate Base
  3" AC Mix No. IV
  Varying Depth AC Base on Exist. Aggregate Base
- 2" Cold Plane
  2" AC Mix No. IV
- GRP Side Slope

LEGEND FOR AS-BUILT POSTINGS

~~	Squiggly line for as-built deletion
~~100.00~~	Double line for as-built deletion
Roadway	Text for as-built posting

GRAPHIC SCALE
10' 5' 0 10' 20'

ORIGINAL PLAN	SURVEY PLOTTED BY	DATE
	DRAWN BY	
NOTE BOOK	TRACED BY	
	DESIGNED BY	
	QUANTITIES BY	
No.	CHECKED BY	

T:/16553A-EMERGENCYFLOODREPAIR/CADD/SHEETS/RC-2.dgn

STATE OF HAWAII
DEPARTMENT OF TRANSPORTATION
HIGHWAYS DIVISION

WAIPA STREAM BRIDGE
ROADWAY PLAN

KAUAI EMERGENCY FLOOD REPAIRS & CLEANUP
At Various Locations April 2018, Rte. 560
Fed. Aid Proj. No. ER-19(007)

Scale: 1"=10' Date: Oct. 2018

SHEET No. R-2 OF 2 SHEETS

"AS-BUILT"