FED. ROAD DIST. NO.	STATE	PROJ. NO.	FISCAL YEAR	SHEET NO.	TOTAL SHEETS
HAWAII	HAW.	56A-02-92	1993	5	5

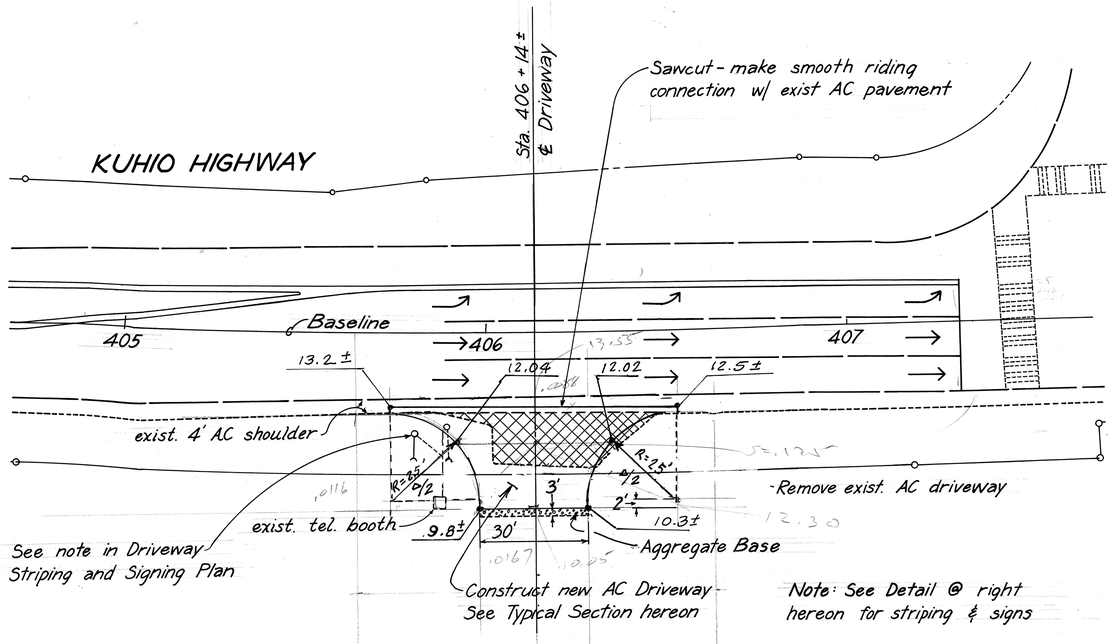

PLAN
DRIVEWAY IMPROVEMENT
Scale: 1" = 20'

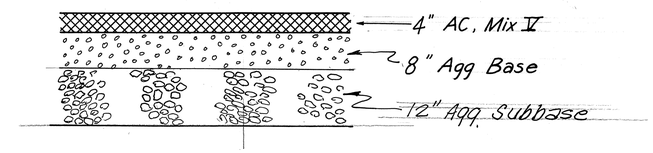

DRIVEWAY PAVEMENT STRUCTURE
No Scale

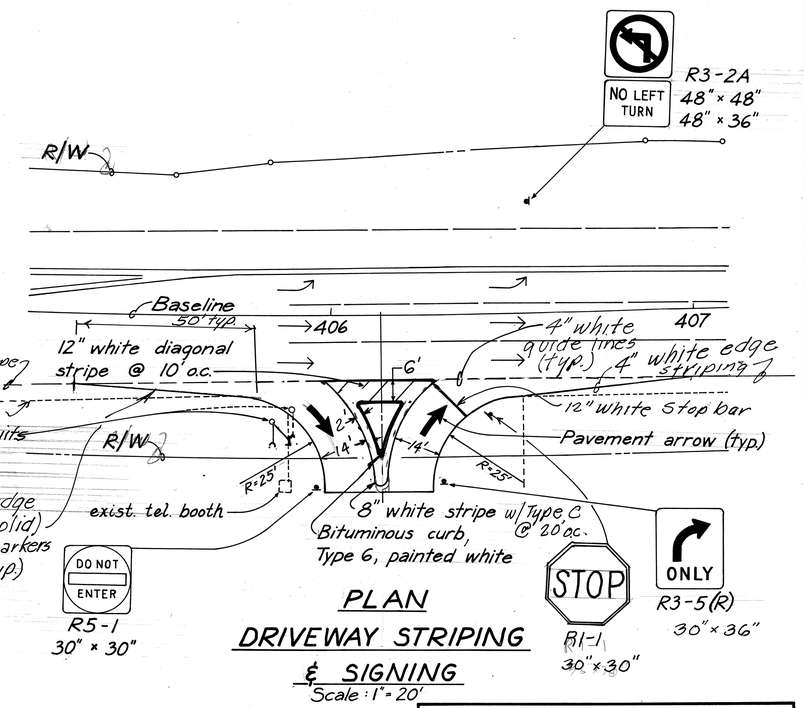

PLAN
DRIVEWAY STRIPING & SIGNING
Scale: 1" = 20'

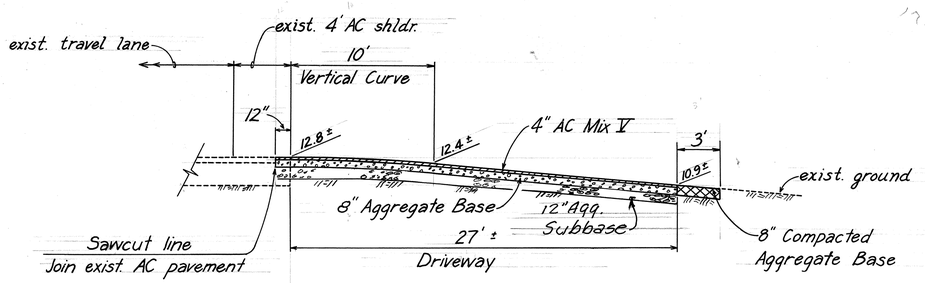

DRIVEWAY PROFILE
Scale: 1" = 5'

ORIGINAL PLAN	SURVEY PLOTTED BY	DATE
	DRAWN BY	
	TRACED BY	
NOTE BOOK	DESIGNED BY	
No.	QUANTITIES BY	
	CHECKED BY	

STATE OF HAWAII
DEPARTMENT OF TRANSPORTATION
HIGHWAYS DIVISION

STRIPING PLAN & DETAILS

KUHIO HIGHWAY SAFETY IMPROVEMENTS
VICINITY OF CDCD PALMS HOTEL
PROJECT NO. 56A-02-92
SCALE: AS SHOWN JAN. 1992

SHEET No. / OF / SHEETS