FED. ROAD DIST. NO.	STATE	FED. AID PROJ. NO.	FISCAL YEAR	SHEET NO.	TOTAL SHEETS
HAWAII	HAW.	ER-23(004), Unit 1	2020	11	15

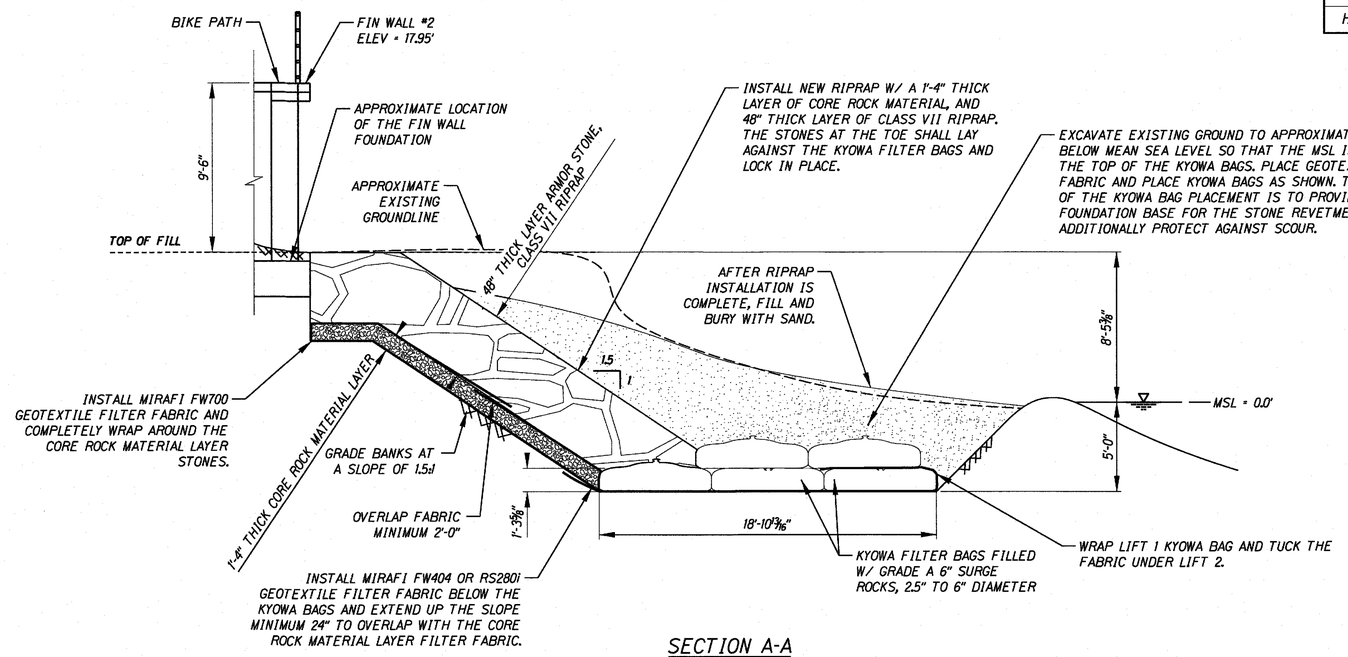

SECTION A-A
(STA. 1+77.62 TO 2+17.85)

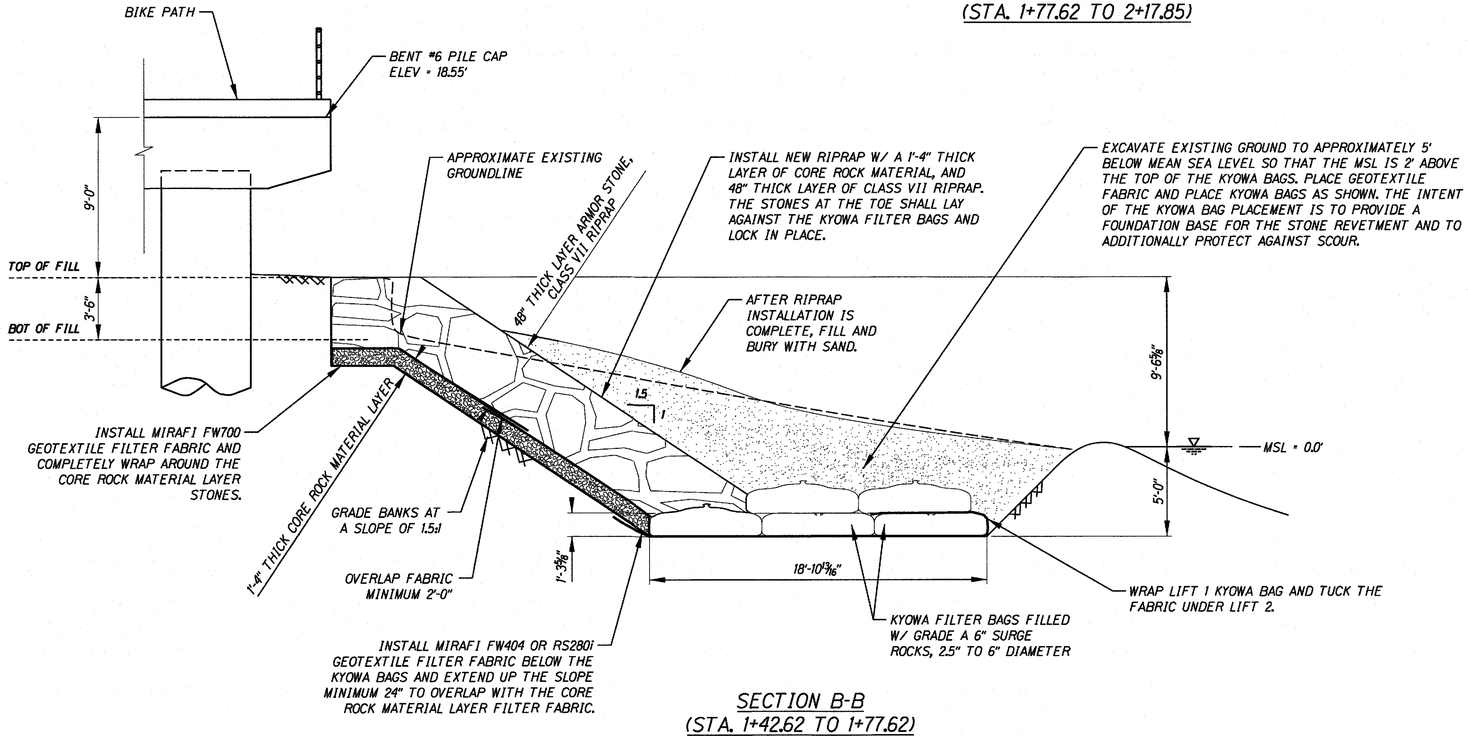

SECTION B-B
(STA. 1+42.62 TO 1+77.62)

AS-BUILT DRAWING

ORIGINAL PLAN	SURVEY PLOTTED BY	DATE
	DRAWN BY	
NOTE BOOK	TRACED BY	
	DESIGNED BY	
No.	QUANTITIES BY	
	CHECKED BY	

JAMES I. KINCAID
LICENSED PROFESSIONAL ENGINEER
No. 12562-CE
HAWAII, U.S.A.

THIS WORK WAS PREPARED BY ME OR UNDER MY SUPERVISION.

SIGNATURE — EXPIRATION DATE OF THE LICENSE: APRIL 30, 2022

STATE OF HAWAII
DEPARTMENT OF TRANSPORTATION
HIGHWAYS DIVISION

RIPRAP REVETMENT - CROSS SECTIONS A-A & B-B

WAILUA RIVER REVETMENT REPAIRS

Proj. No. ER-23(004), Unit 1

Scale: None — Date: AUGUST, 2020