FED. ROAD DIST. NO.	STATE	FED. AID PROJ. NO.	FISCAL YEAR	SHEET NO.	TOTAL SHEETS
HAWAII	HAW.	NH-056-1(063)	2023	ADD.20	43

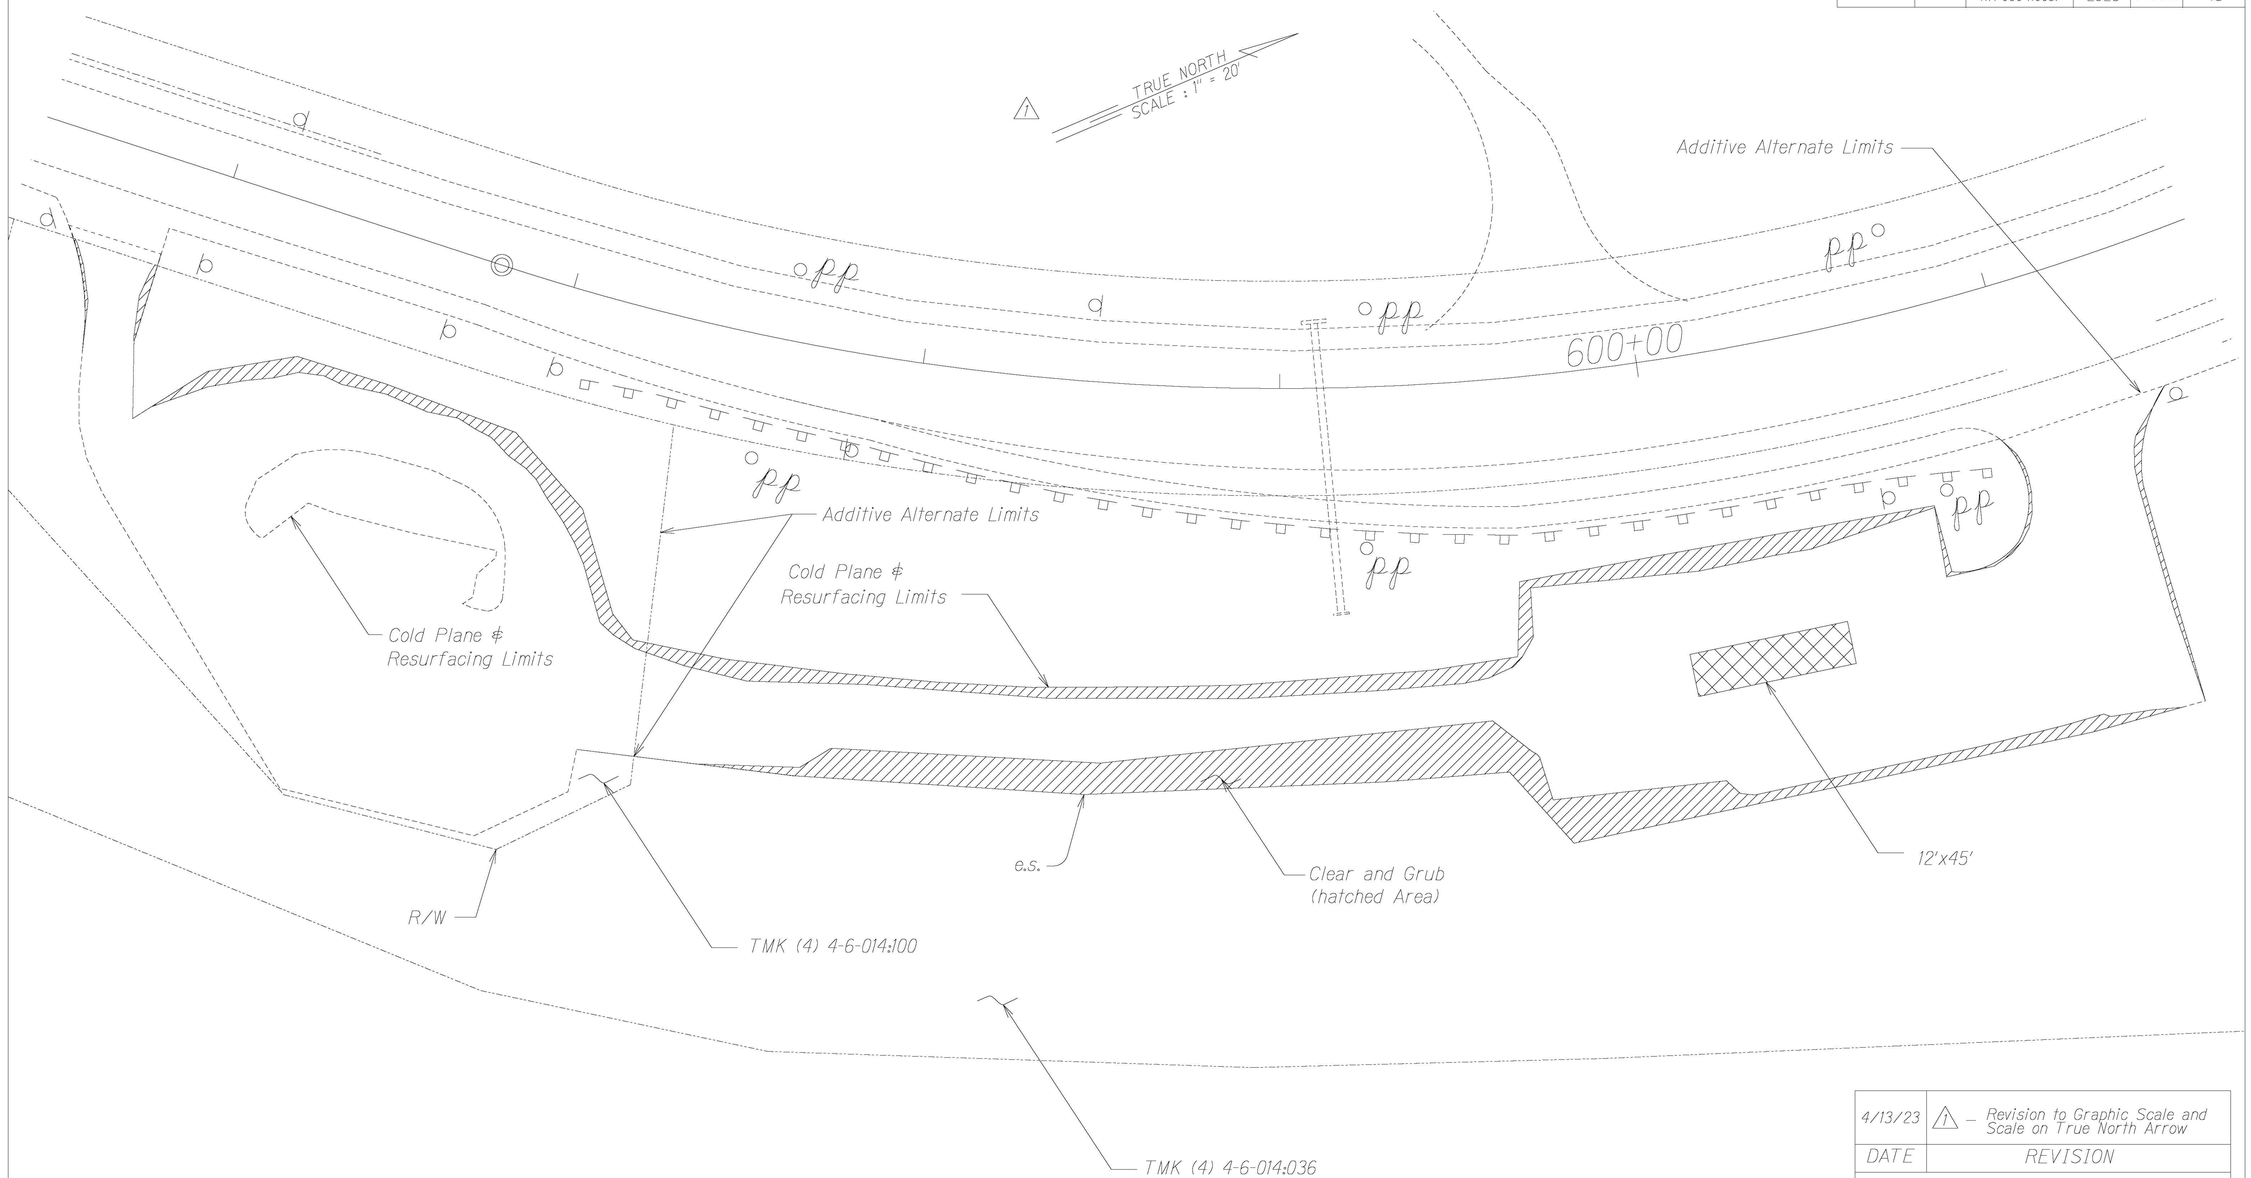

DATE	REVISION
4/13/23	1 – Revision to Graphic Scale and Scale on True North Arrow

STATE OF HAWAII
DEPARTMENT OF TRANSPORTATION
HIGHWAYS DIVISION

ROADWAY PLAN

KUHIO HIGHWAY RESURFACING
Waikaea Bridge to Mailihuna Road
Federal-Aid Project No. NH-056-1(063)

Scale: 1" = 20' Date: Mar. 2023

0 10 20 40

SHEET No. 6 OF 6 SHEETS

ADD.20

ORIGINAL PLAN	SURVEY PLOTTED BY	DATE
	DRAWN BY	"
NOTE BOOK	TRACED BY	"
	DESIGNED BY	"
	QUANTITIES BY	"
	CHECKED BY	"

keijelf
NHHP06.dgn

FED. ROAD DIST. NO.	STATE	FED. AID PROJ. NO.	FISCAL YEAR	SHEET NO.	TOTAL SHEETS
HAWAII	HAW.	NH-056-1(063)	2023	ADD.32	43

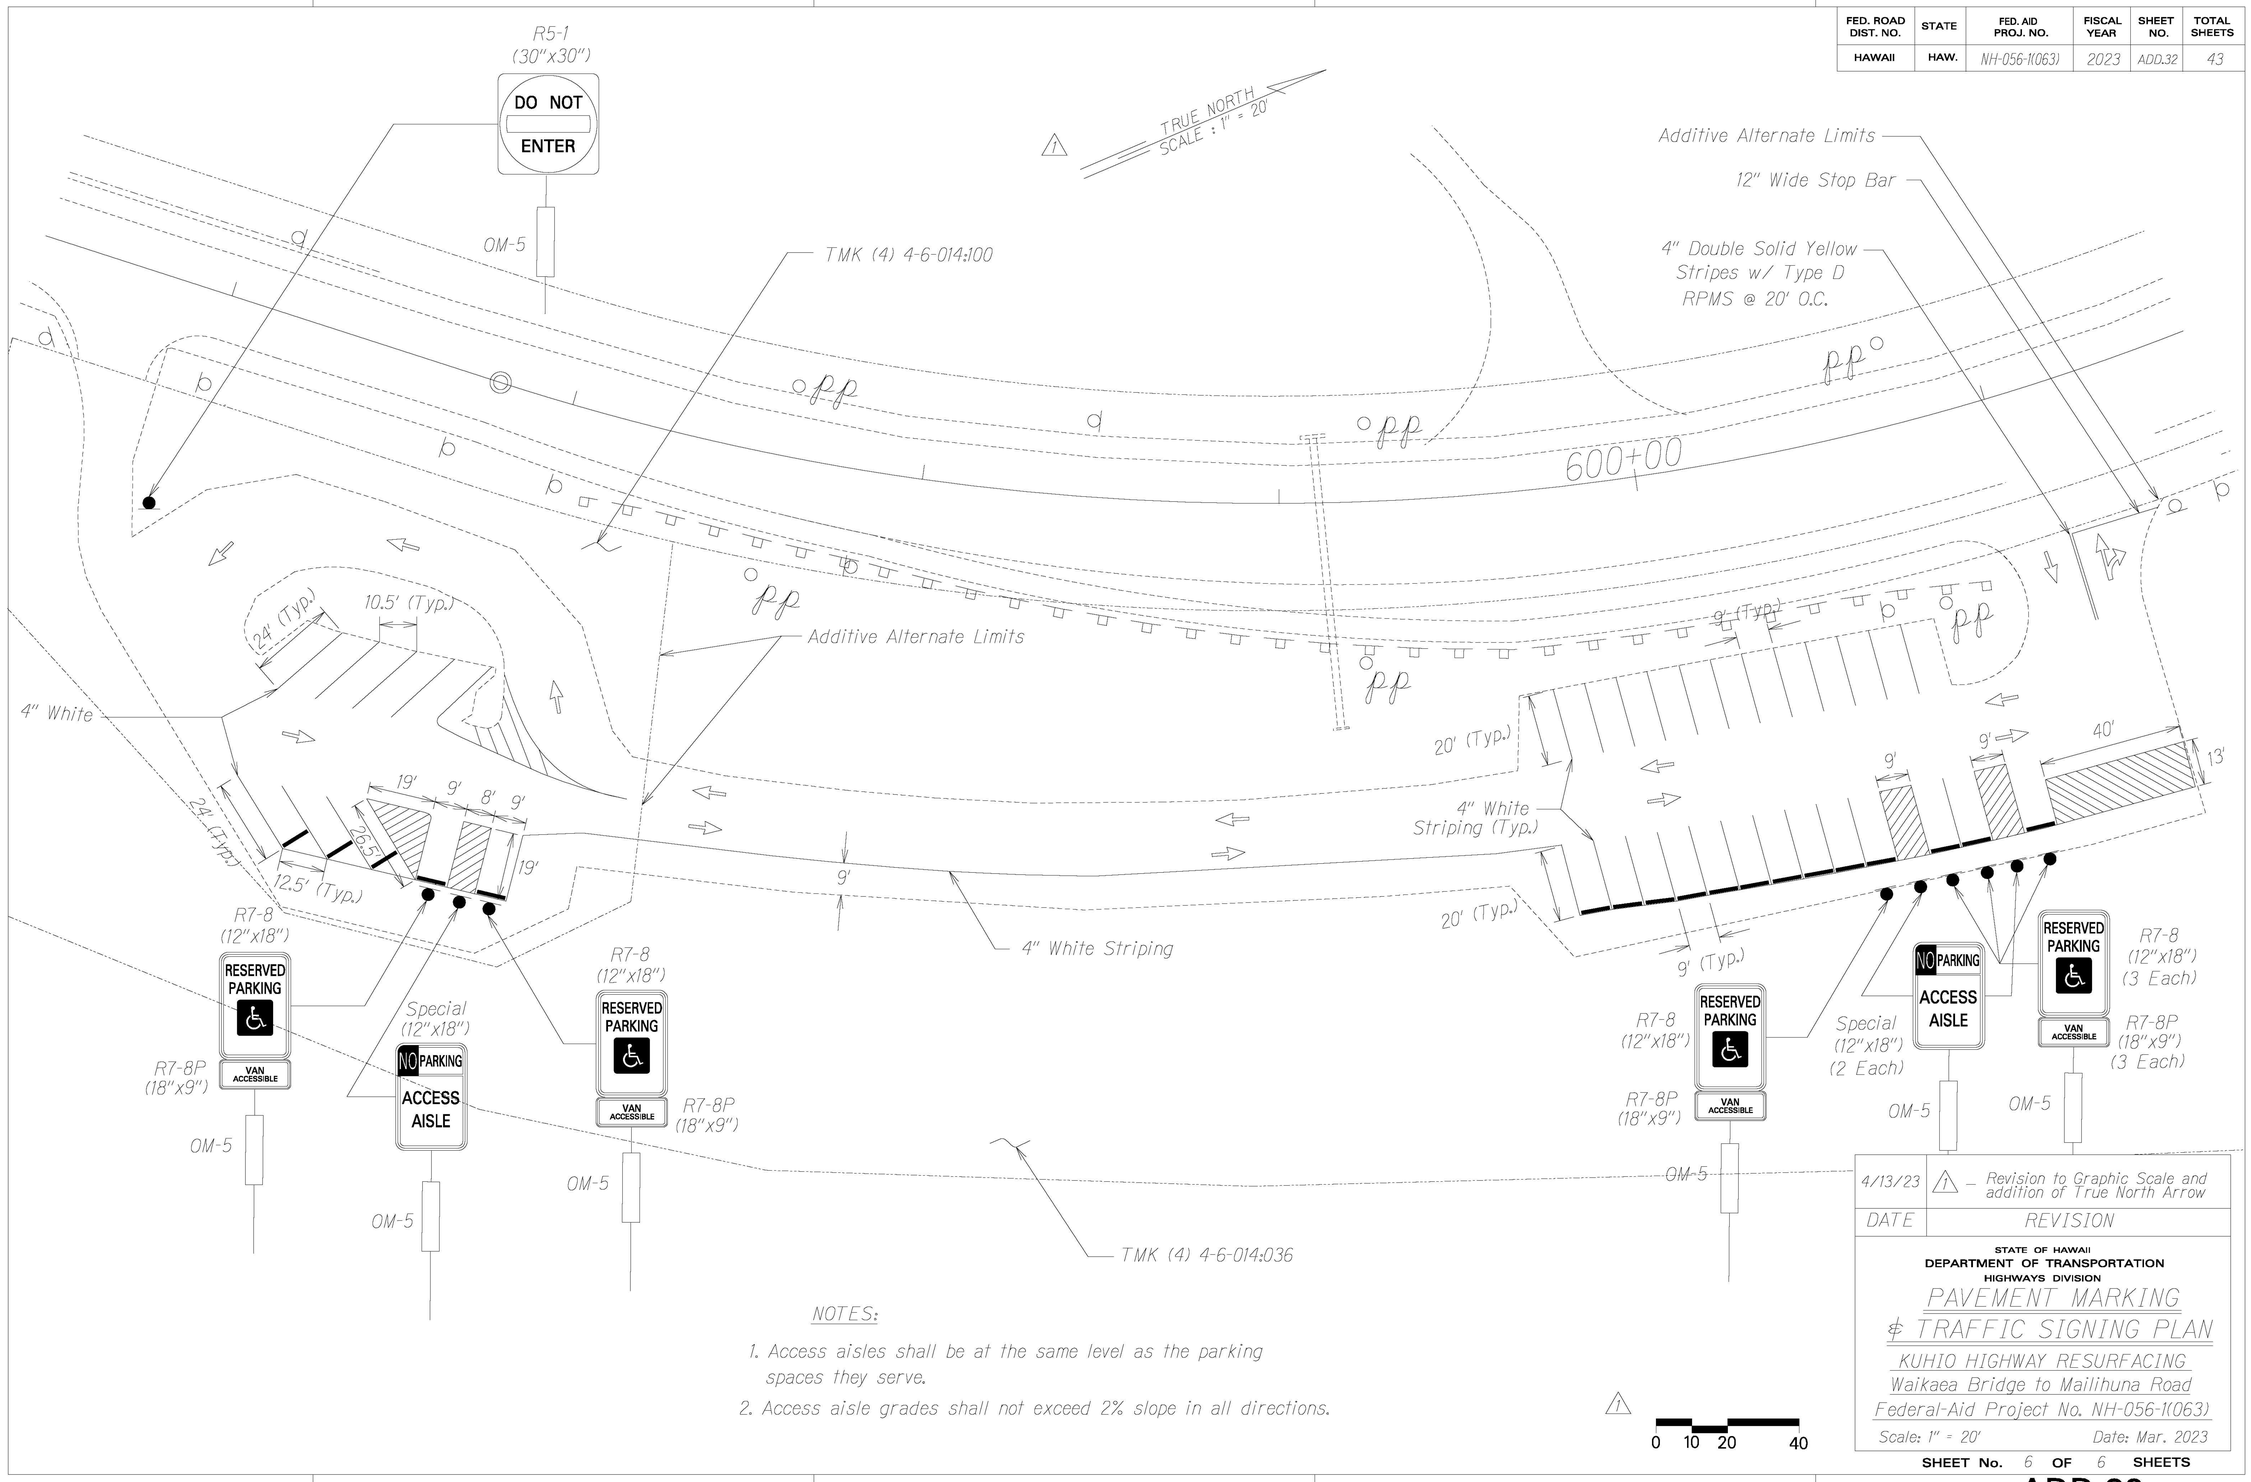

NOTES:

1. Access aisles shall be at the same level as the parking spaces they serve.
2. Access aisle grades shall not exceed 2% slope in all directions.

0 10 20 40

DATE	REVISION
4/13/23	1 – Revision to Graphic Scale and addition of True North Arrow

STATE OF HAWAII
DEPARTMENT OF TRANSPORTATION
HIGHWAYS DIVISION

PAVEMENT MARKING & TRAFFIC SIGNING PLAN

KUHIO HIGHWAY RESURFACING
Waikaea Bridge to Mailihuna Road
Federal-Aid Project No. NH-056-1(063)

Scale: 1" = 20' Date: Mar. 2023

SHEET No. 6 OF 6 SHEETS

ADD.32

ORIGINAL PLAN | SURVEY PLOTTED BY | DRAWN BY | TRACED BY | DESIGNED BY | QUANTITIES BY | CHECKED BY | DATE

NOTE BOOK
ks3.lef
nhi056.dgn