INDEX TO DRAWINGS	
SHEET NO.	DESCRIPTION
1	TITLE SHEET & LAYOUT PLAN
2 - 5	BORING LOCATION PLANS

STATE OF HAWAII

DEPARTMENT OF TRANSPORTATION

HIGHWAYS DIVISION

PLANS OF

SUB-STRATA INVESTIGATION

KAUAI BELT ROAD

(PILAA TO KAHILI)

FEDERAL AID SECONDARY PROJECT NO. S-0560(8) UNIT 1

DISTRICT OF HANALEI

ISLAND OF KAUAI

FISCAL YEAR	PROJECT NO.	SHEET NO.	TOTAL SHEETS
1966	S-0560(8) UNIT 1	1	5

SCALES

PLAN 1 INCH = 100 FT.

PROFILE HOR. 1 INCH = 100 FT.

VER. 1 INCH = 10 FT.

CONVENTIONAL SIGNS

Baseline
Boundary Line
Fences (Named)
Existing Roadway
Pipe Culvert
Box Culvert
Telephone Line & Pole
Electric Line & Pole
Water Main

LOCATION OF PROJECT

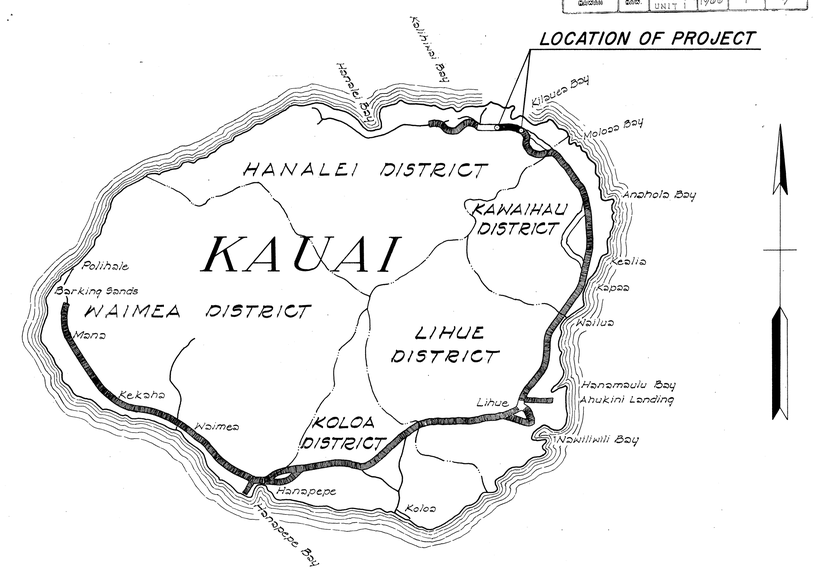

FEDERAL AID PROJECTS PREVIOUSLY CONSTRUCTED OR UNDER CONSTRUCTION

ANTICIPATED CROP DAMAGE AREA DUE TO BORING CONTRACTOR'S OPERATIONS

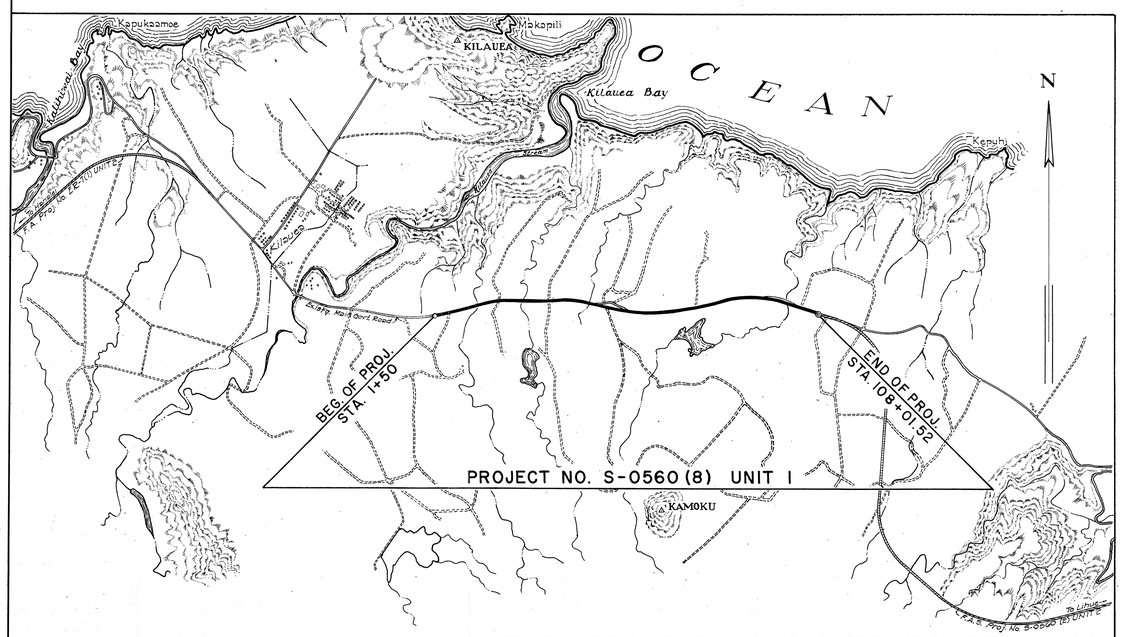

LAYOUT OF PROJECT

SCALE: 1" = 2000'

GROSS LENGTH OF PROJECT 2.019 MI.

NOTE:

All roadway construction notes and data not related to this sub-strata project shall be disregarded.

NOTE:

All changes made during construction are shown in red on these tracings and checked by

Alexander Hiromoto
Project Engineer

3/14/68
Date

APPROVED: DATE 10-3-66

John Hill Lee
for DIRECTOR OF TRANSPORTATION

Designed by: A. Marutani June '66