FED. ROAD DIST. NO.	STATE	FED. AID PROJ. NO.	FISCAL YEAR	SHEET NO.	TOTAL SHEETS
HAWAII	HAW.	STP-056-1(39)	1998	21	28

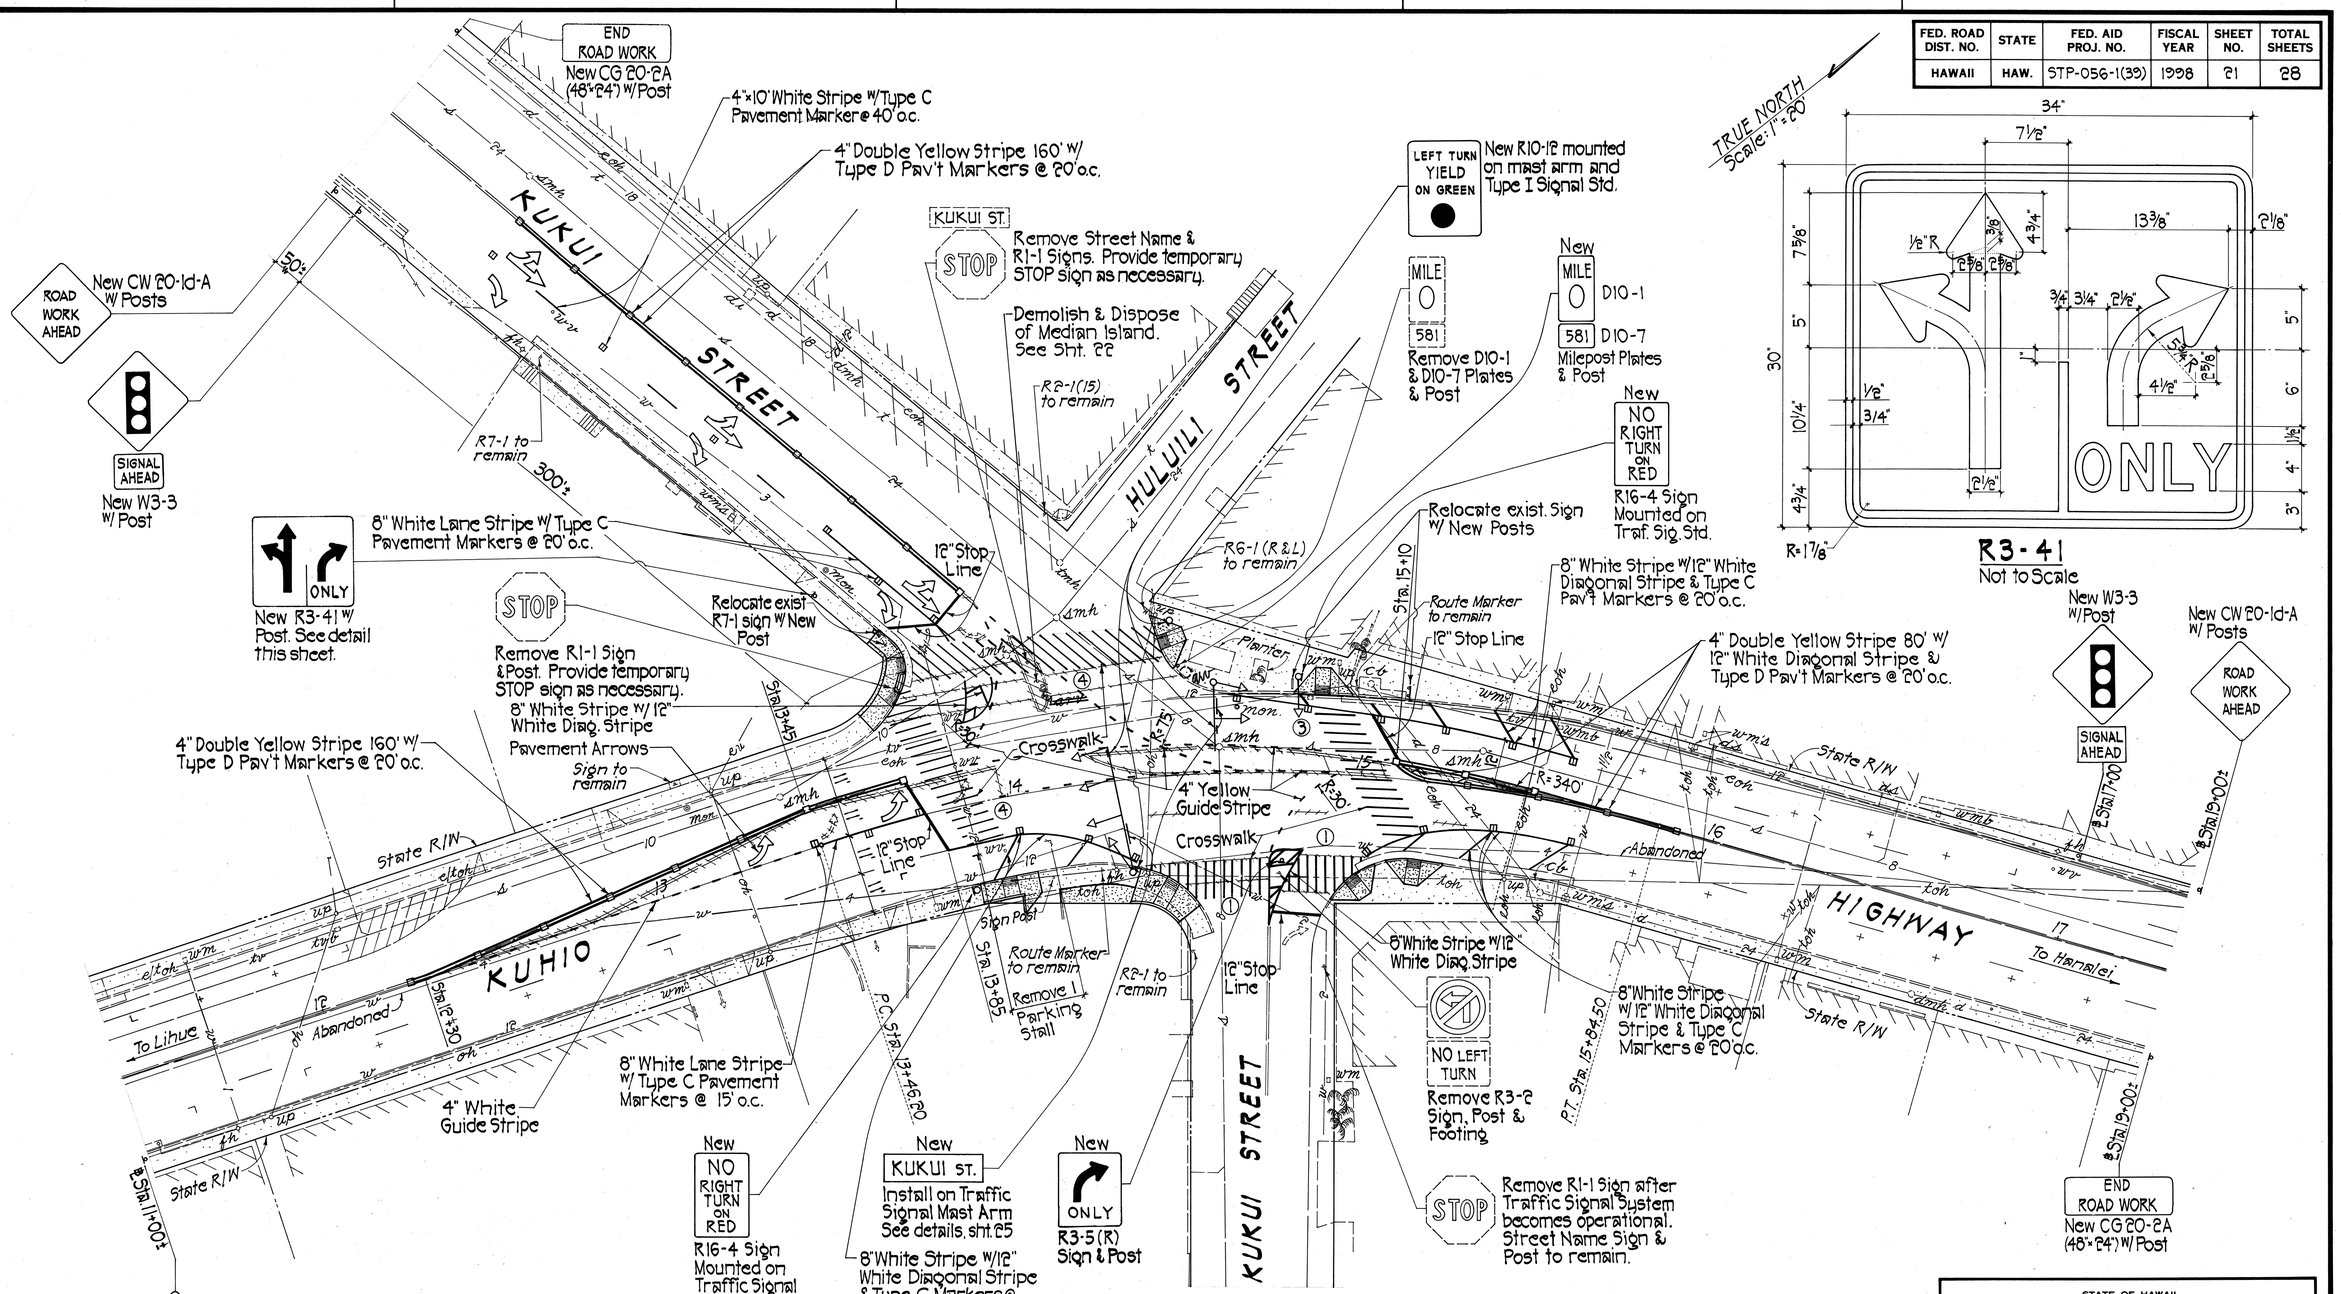

R3-41
Not to Scale

MARKING, STRIPING AND SIGNING PLAN

Scale: 1" = 20'

NOTE: Removal of signs, posts, foundations, striping, temporary traffic control signs & markings, etc., shall not be measured separately for payment but shall be considered incidental to other items of work.

DATE	REVISION
10/8/98	Deleted southbound left turn lane & removed only one parking stall. Added crosswalk, stop line, guide stripes & channelizing striping.

HAROLD T. YOSHIZAKI LICENSED PROFESSIONAL ENGINEER No. 2091-C HAWAII, U.S.A.

THIS WORK WAS PREPARED BY ME OR UNDER MY SUPERVISION

Harold T. Yoshizaki

STATE OF HAWAII
DEPARTMENT OF TRANSPORTATION
HIGHWAYS DIVISION

MARKING, STRIPING & SIGNING PLAN AT KUKUI STREET

KUHIO HIGHWAY
TRAFFIC SIGNAL MODERNIZATION
FEDERAL-AID PROJECT NO. STP-056-1(39)

SCALE: AS SHOWN DATE: June 1997

SHEET No. 1 OF 1 SHEETS

ORIGINAL PLAN
SURVEY PLOTTED BY
DRAWN BY
TRACED BY
DESIGNED BY
QUANTITIES BY
CHECKED BY
DATE
NOTE BOOK
No.

C021