FED. ROAD DIST. NO.	STATE	PROJ. NO.	FISCAL YEAR	SHEET NO.	TOTAL SHEETS
HAWAII	HAW.	56A-01-97	1998	7	8

NOTES:

1. All existing signs to be removed and replaced with new signs except "ADOPT A HIGHWAY" sign assembly, Stop signs, and the conditional parking sign, as shown below.
2. One object marker (OM-11) w/o steel post shall be installed on utility poles that are located within 30 feet from the edge of paved shoulder. Object Markers shall face oncoming traffic.

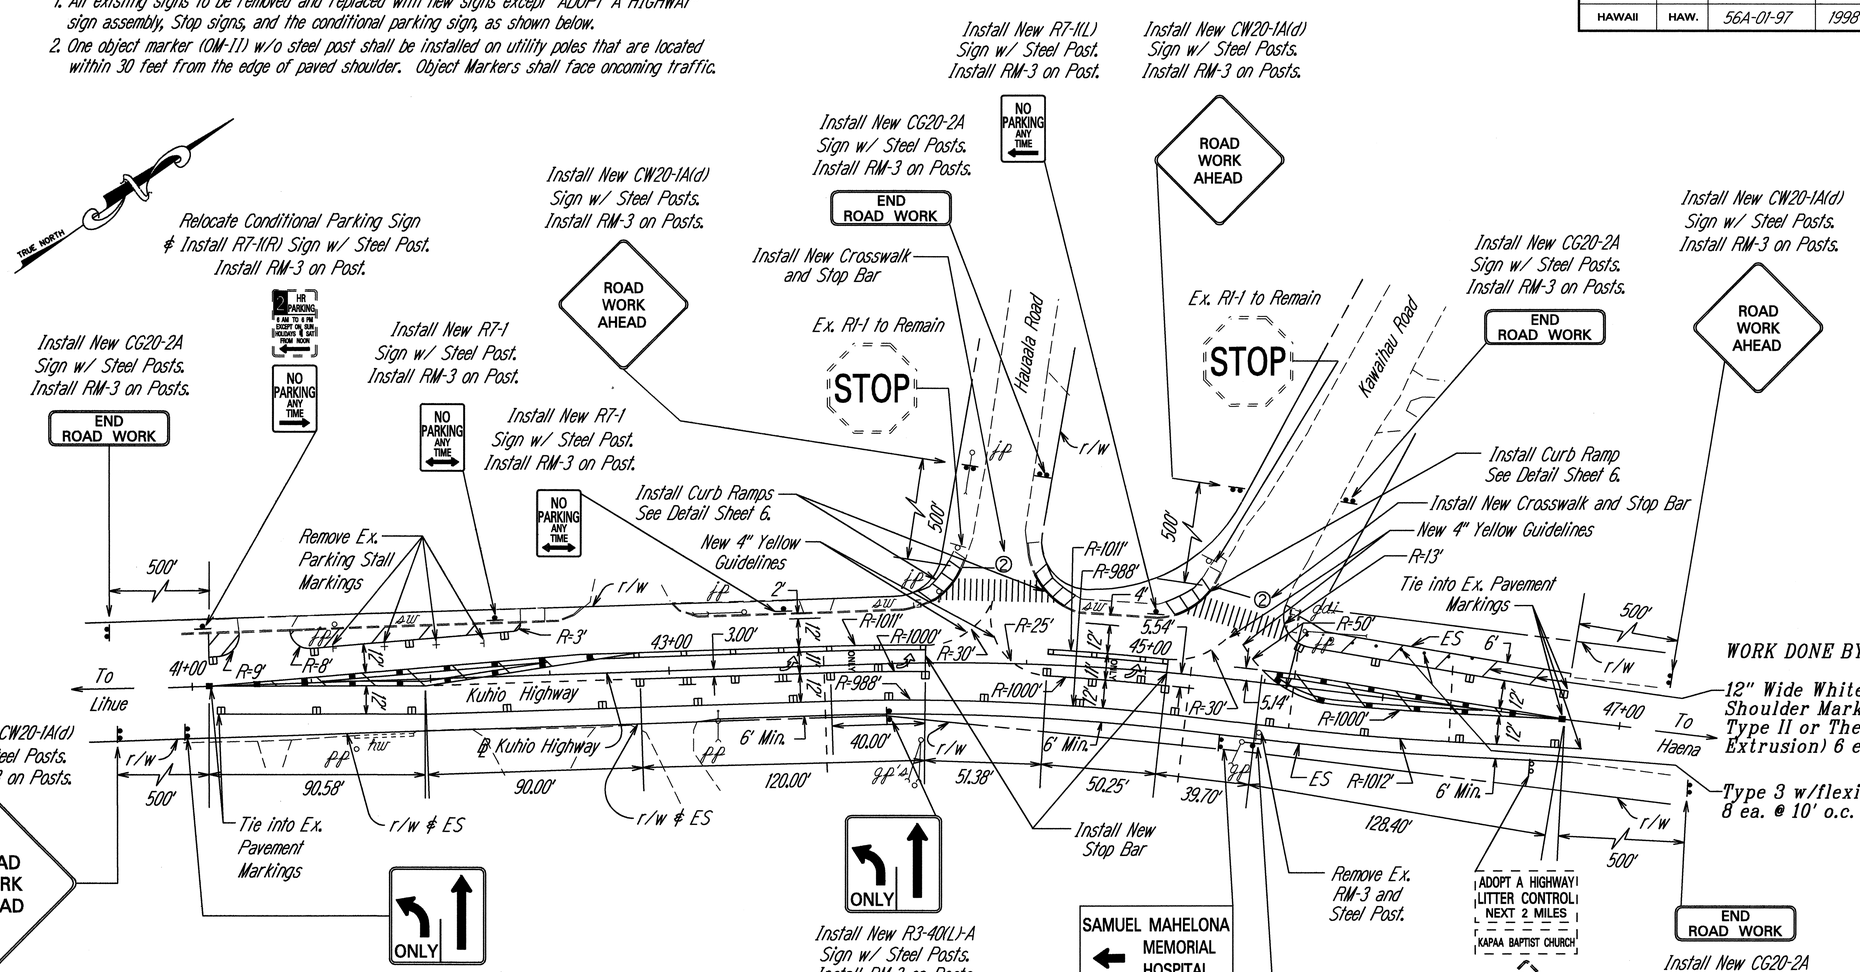

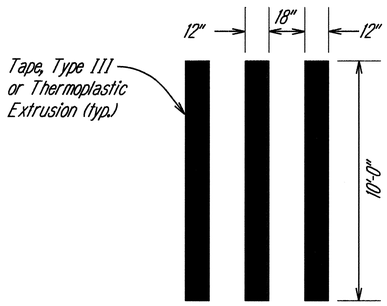

TYPICAL CROSSWALK DETAIL
Not to Scale

LEGEND FOR AS-BUILT POSTINGS	
~~^^^^~~	Squiggly line for as-built deletion
~~100.00~~	Double line for as-built deletion
Roadway	Text for as-built posting

PAVEMENT MARKING AND SIGNING PLAN
Scale: 1" = 30'

SURVEY PLOTTED BY		DATE
DRAWN BY		DATE
TRACED BY		DATE
DESIGNED BY		DATE
QUANTITIES BY		DATE
CHECKED BY		DATE
ORIGINAL PLAN	NOTE BOOK No.	

STATE OF HAWAII
DEPARTMENT OF TRANSPORTATION
HIGHWAYS DIVISION

PAVEMENT MARKING AND SIGNING PLAN

KUHIO HIGHWAY,
LEFT TURN STORAGE LANE TO
HAUAALA ROAD AND KAWAIHAU ROAD
Proj. No. 56A-01-97

Scale: As Shown Date: May, 1998

SHEET No. / OF / SHEETS

AS-BUILT