FED. ROAD DIST. NO.	STATE	FED. AID PROJ. NO.	FISCAL YEAR	SHEET NO.	TOTAL SHEETS
HAWAII	HAW.	BR-STP-056-1(35)	2000	1	70

56

STATE OF HAWAII

DEPARTMENT OF TRANSPORTATION

HIGHWAYS DIVISION

HONOLULU, HAWAII

"AS-BUILT"

PLANS FOR

KUHIO HIGHWAY

WAIKAEA BRIDGE WIDENING

FEDERAL AID PROJECT NO. BR-STP-056-1(35)

DISTRICT OF KAWAIHAU

ISLAND OF KAUAI

INDEX TO DRAWINGS

SHEET NO.	DESCRIPTION
1	TITLE SHEET
2	STANDARD PLAN SUMMARY
3	GENERAL NOTES AND LEGEND
4	BMP DETAIL AND NOTES
5 – 6	TYPICAL SECTIONS
7 – 8	MISCELLANEOUS DETAILS
9	FLEAT-350 DETAILS
10 – 13	GUARDRAIL DETAILS
14	ROADWAY PLAN
15	ROADWAY GRADING PLAN
16 – 49	BRIDGE PLAN, ELEVATIONS, SECTIONS, BORING LOGS, ORIGINAL PLANS, DETAILS AND NOTES
50 – 55	UTILITY RELOCATION AND ADJUSTMENT PLAN, PROFILES, DETAILS AND NOTES
56 – 64	DRAINAGE PLAN, DETAILS AND NOTES
65 – 67	PAVEMENT MARKING AND SIGNING PLANS
68 – 69	CROSS SECTIONS
70	PLANTING AREA RESTORATION PLAN

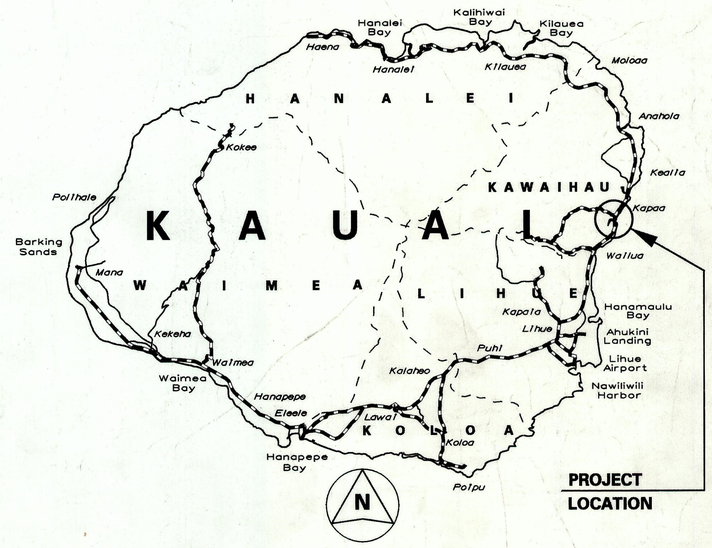

PROJECT LOCATION

SCALE IN MILES

FEDERAL AID PROJECTS PREVIOUSLY CONSTRUCTED OR UNDER CONSTRUCTION

MILE POST 8.02 TO MILE POST 8.19

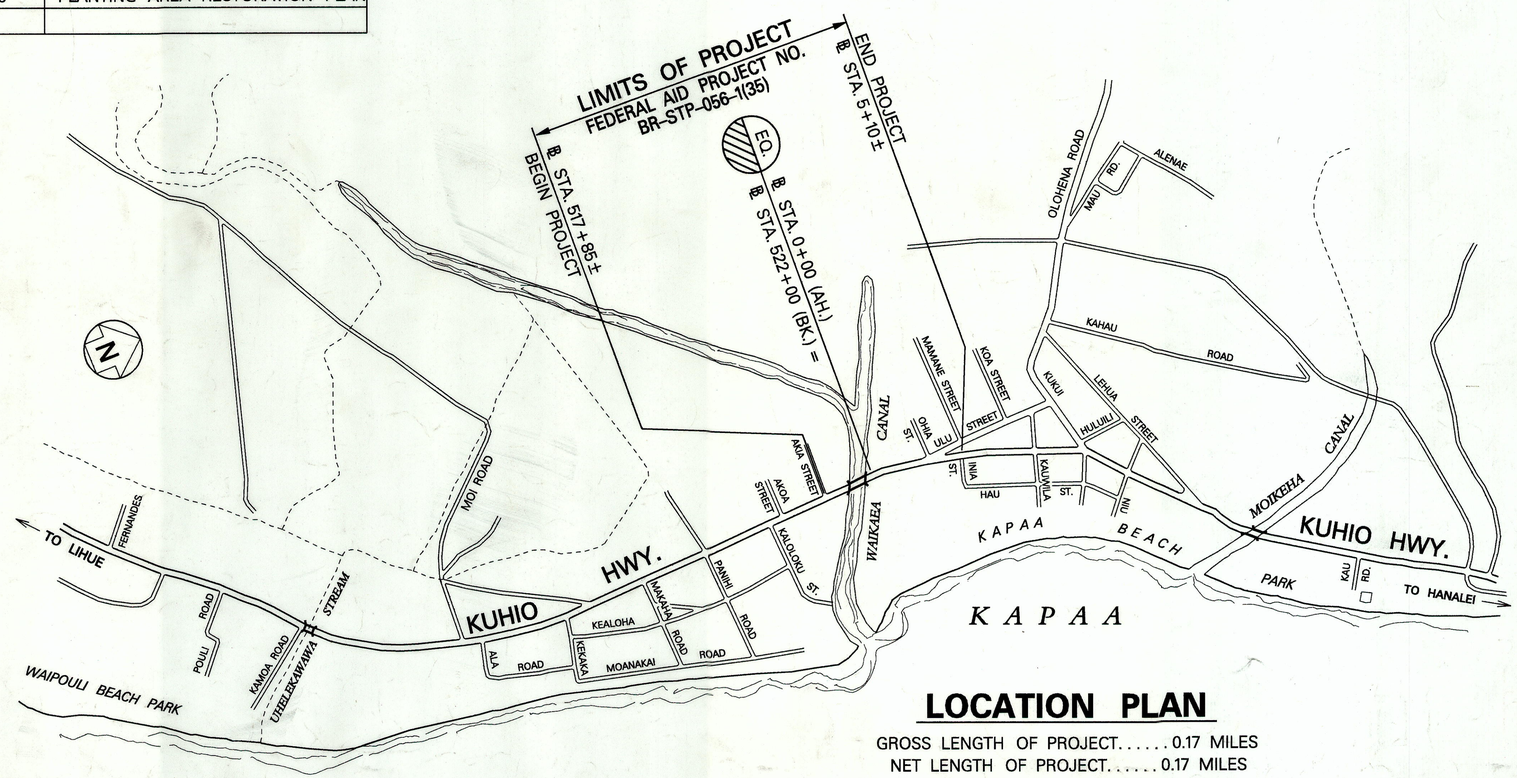

LOCATION PLAN

GROSS LENGTH OF PROJECT..... 0.17 MILES

NET LENGTH OF PROJECT..... 0.17 MILES

5 0 5 10 15

SCALE IN HUNDRED FEET

DESIGN DESIGNATION

ADT (1995).....26,800

ADT (2015).....34,100

DHV 2,900

D 55/45

T .....2.5 %

V .....45 M.P.H.

CHANGES MADE DURING CONSTRUCTION HAVE BEEN INCORPORATED ON THESE PLANS EXCEPT CHANGES IN THE ORIGINAL THEORETICAL QUANTITIES. FOR ACTUAL QUANTITIES, REFER TO PROJECT LEDGER AND/OR COMPUTATION BOOK.

for RESIDENT ENGINEER — 2/10/15 DATE

DEPARTMENT OF TRANSPORTATION
STATE OF HAWAII

APPROVED:

DIR. OF TRANSPORTATION — 8/8/99 DATE

UNIT "C"	R. HIRONAKA	692-7575	AUG., 1999
DESIGNED BY	P. S. & E. BY	PHONE	DATE

4kuhdtsht.dgn loglin sean r4-8-94

4kuhdtsht.dgn loglin sean r3-4-96