FED. ROAD DIST. NO.	STATE	FED. AID PROJ. NO.	FISCAL YEAR	SHEET NO.	TOTAL SHEETS
HAWAII	HAW.	56D-01-99	2001	23	27

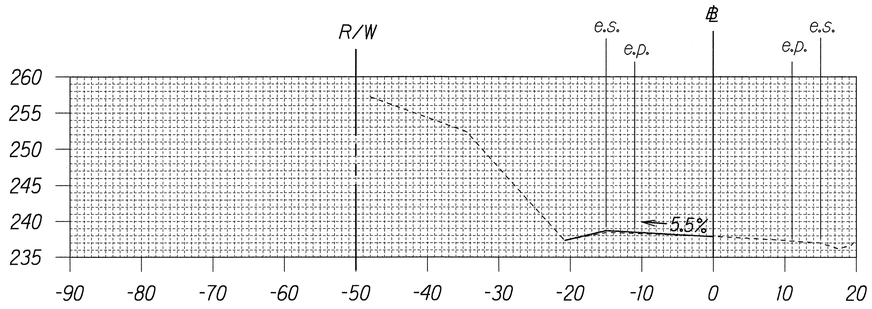

C = 0 s.f.
F = 1 s.f.

2+50

Exc = 0 c.y.
Emb = 1 c.y.

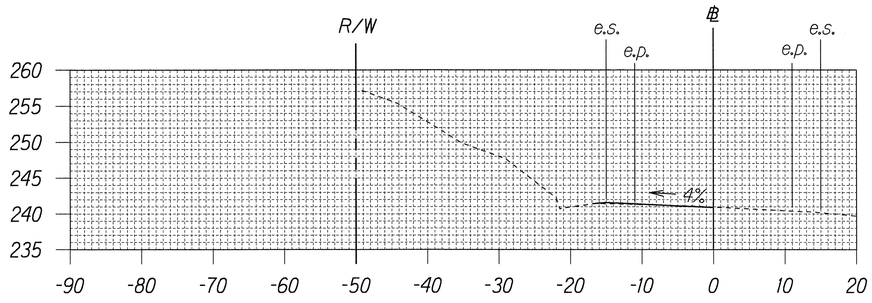

C = 0 s.f.
F = 0 s.f.

2+00

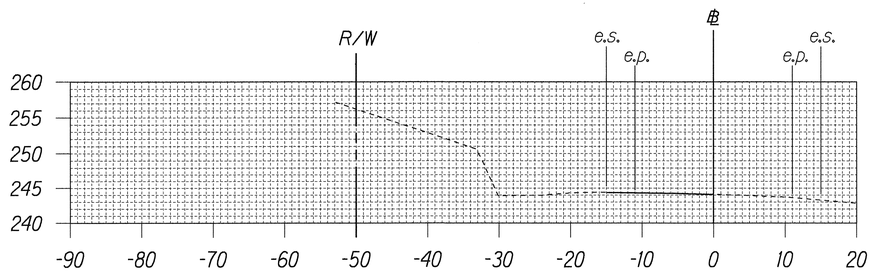

1+50

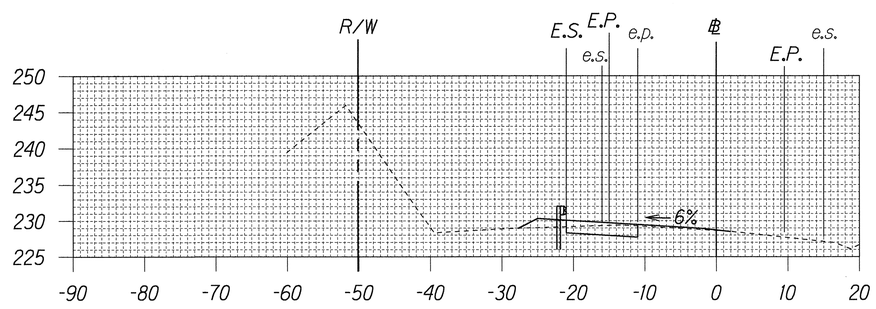

C = 14 s.f.
F = 5 s.f.

4+00

Exc = 18 c.y.
Emb = 8 c.y.

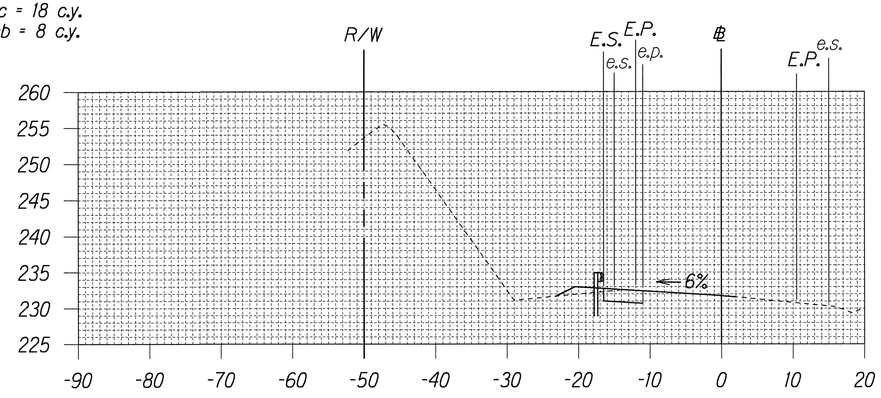

C = 5 s.f.
F = 3 s.f.

3+50

Exc = 5 c.y.
Emb = 4 c.y.

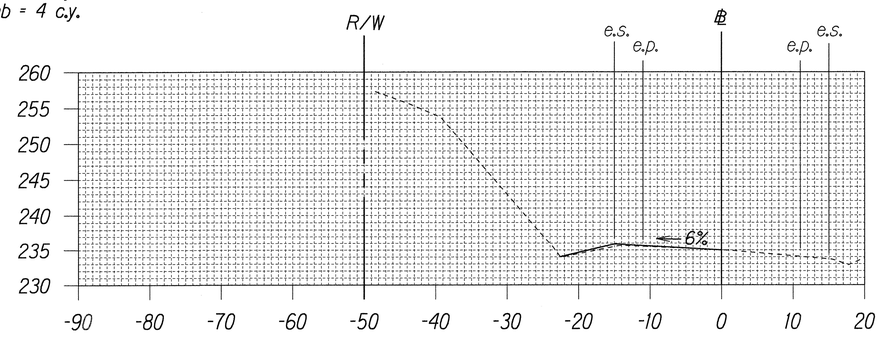

C = 0 s.f.
F = 1 s.f.

3+00

Exc = 0 c.y.
Emb = 1 c.y.

Legend: WF Wastefill

Scale: Vert.: 1" = 10'
Horiz.: 1" = 10'

ORIGINAL PLAN	SURVEY PLOTTED BY	DATE 12-14-99
	DRAWN BY MH	
NOTE BOOK dp.mp	TRACED BY LH	
	DESIGNED BY	
NO.	QUANTITIES BY	
	CHECKED BY	

SHEET No. 1 OF 5 SHEETS

FED. ROAD DIST. NO.	STATE	PROJ. NO.	FISCAL YEAR	SHEET NO.	TOTAL SHEETS
HAWAII	HAW.	56D-01-99	2001	24	27

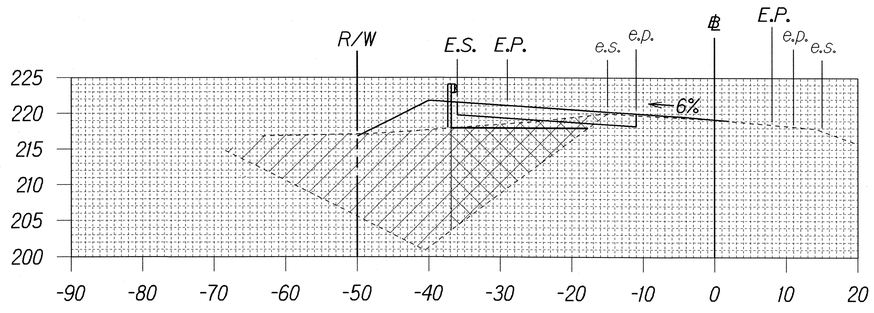

5+50

C = 309 s.f.
F = 340 s.f.

Exc = 374 c.y.
Emb = 405 c.y.

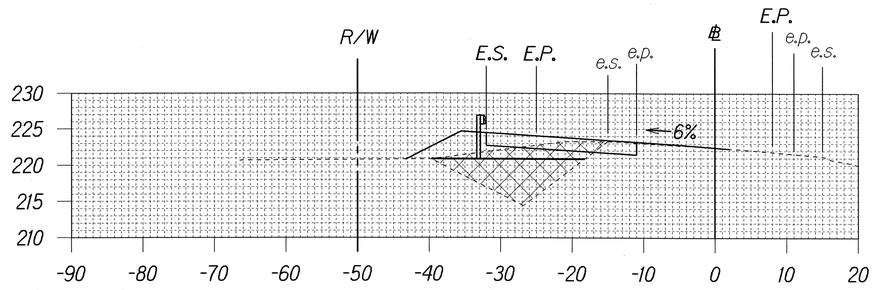

5+00

C = 95 s.f.
F = 97 s.f.

Exc = 109 c.y.
Emb = 105 c.y.

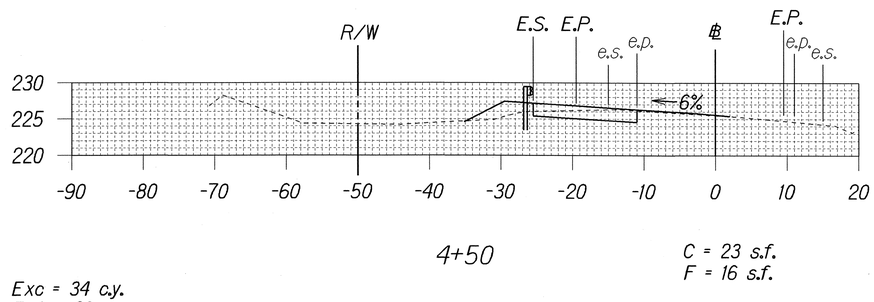

4+50

C = 23 s.f.
F = 16 s.f.

Exc = 34 c.y.
Emb = 20 c.y.

Note: Wastefill to be removed limited to 6' below finished grade, or as directed by Engineer.

Legend: Wastefill

Wastefill to be Removed

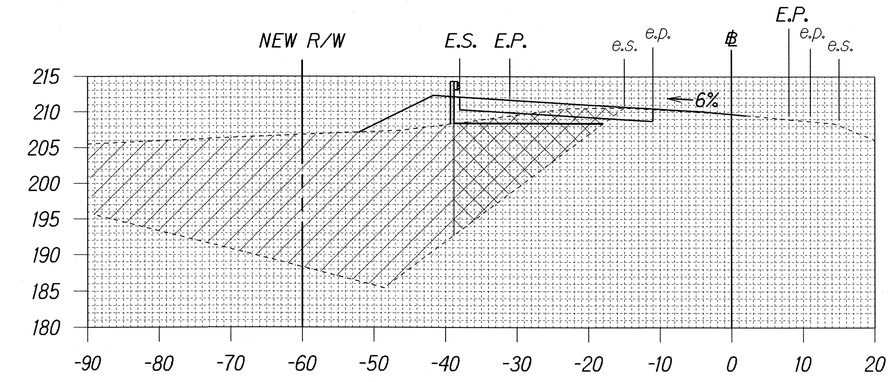

7+00

C = 476 s.f.
F = 501 s.f.

Exc = 801 c.y.
Emb = 842 c.y.

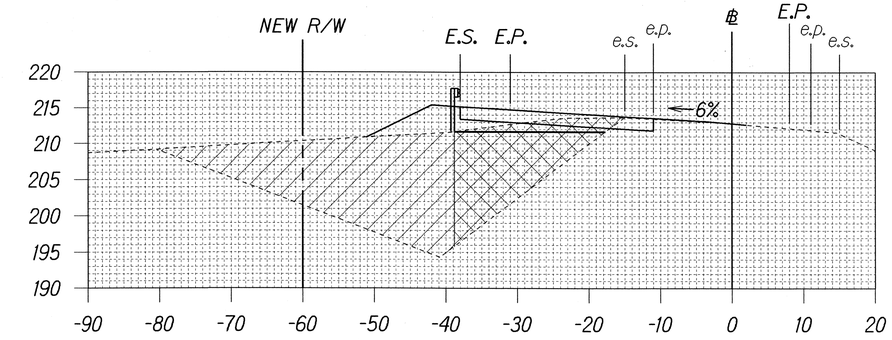

6+50

C = 389 s.f.
F = 408 s.f.

Exc = 671 c.y.
Emb = 716 c.y.

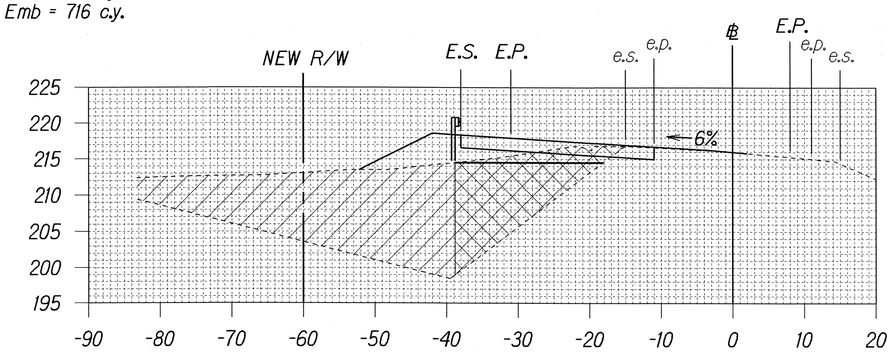

6+00

C = 335 s.f.
F = 366 s.f.

Exc = 597 c.y.
Emb = 653 c.y.

Scale: Vert.: 1" = 10'
Horiz.: 1" = 10'

ORIGINAL PLAN	SURVEY PLOTTED BY	DATE 12/5/00
	DRAWN BY MD JP	
NOTE BOOK dtd.mm dtd.mm2.dgn	TRACED BY JP	
	DESIGNED BY	
	QUANTITIES BY	
	CHECKED BY	

SHEET No. 2 OF 5 SHEETS

"AS-BUILT"

FED. ROAD DIST. NO.	STATE	FED. AID PROJ. NO.	FISCAL YEAR	SHEET NO.	TOTAL SHEETS
HAWAII	HAW.	56D-01-99	2001	25	27

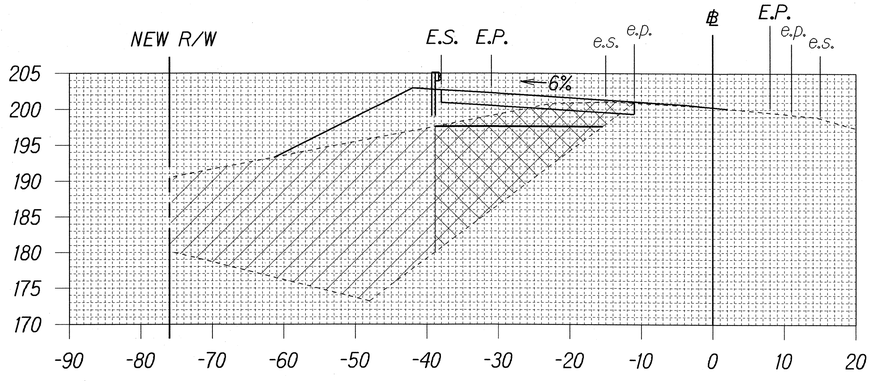

8+50

C = 397 s.f.
F = 462 s.f.

Exc = 799 c.y.
Emb = 879 c.y.

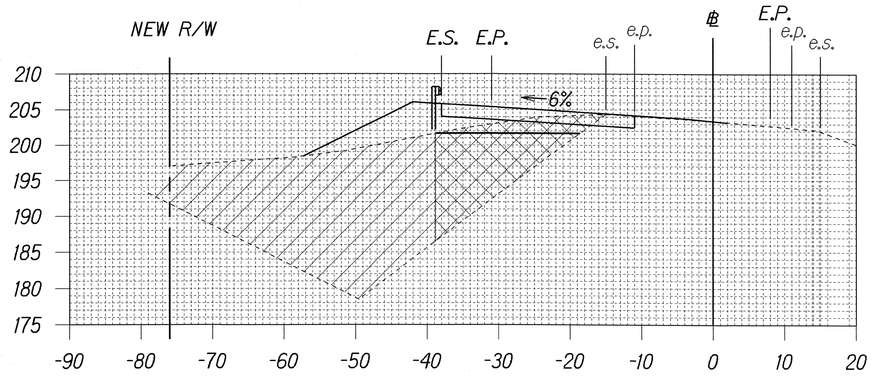

8+00

C = 467 s.f.
F = 488 s.f.

Exc = 928 c.y.
Emb = 983 c.y.

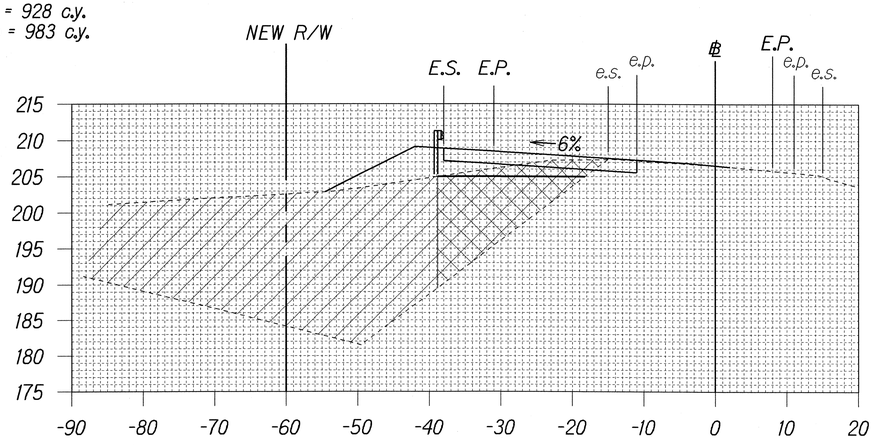

7+50

C = 536 s.f.
F = 573 s.f.

Exc = 936 c.y.
Emb = 995 c.y.

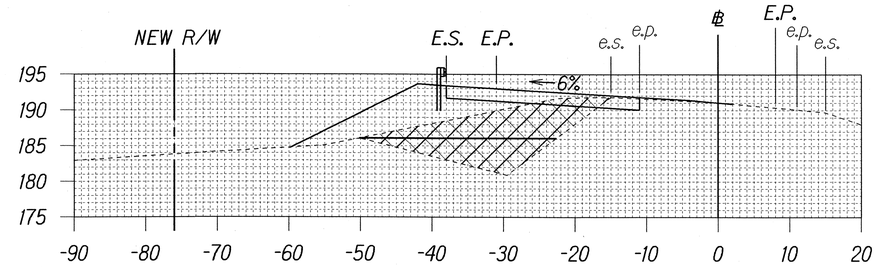

10+00

C = 165 s.f.
F = 243 s.f.

Exc = 465 c.y.
Emb = 596 c.y.

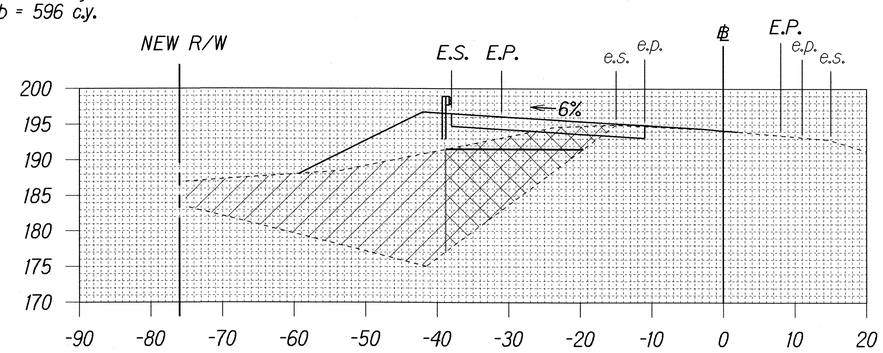

9+50

C = 337 s.f.
F = 401 s.f.

Exc = 643 c.y.
Emb = 780 c.y.

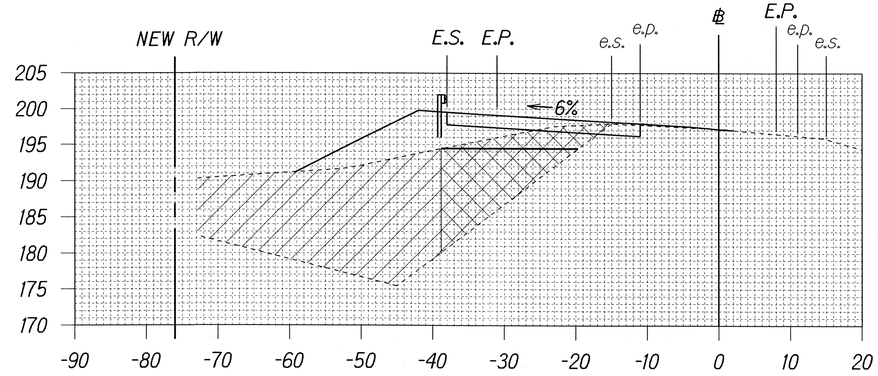

9+00

C = 357 s.f.
F = 441 s.f.

Exc = 698 c.y.
Emb = 836 c.y.

Legend: Wastefill

Wastefill to be Removed

Scale: Vert.: 1" = 10'
Horiz.: 1" = 10'

Note: Wastefill to be removed limited to 6' below finished grade, or as directed by Engineer.

ORIGINAL PLAN	SURVEY PLOTTED BY	DATE 6/5/00
	DRAWN BY MD	
NOTE BOOK dg4.mb dg4hbs3.dgn	TRACED BY HT	
	DESIGNED BY	
	QUANTITIES BY	
	CHECKED BY	

SHEET No. 3 OF 5 SHEETS

"AS-BUILT"

FED. ROAD DIST. NO.	STATE	FED. AID PROJ. NO.	FISCAL YEAR	SHEET NO.	TOTAL SHEETS
HAWAII	HAW.	56D-01-99	2001	26	27

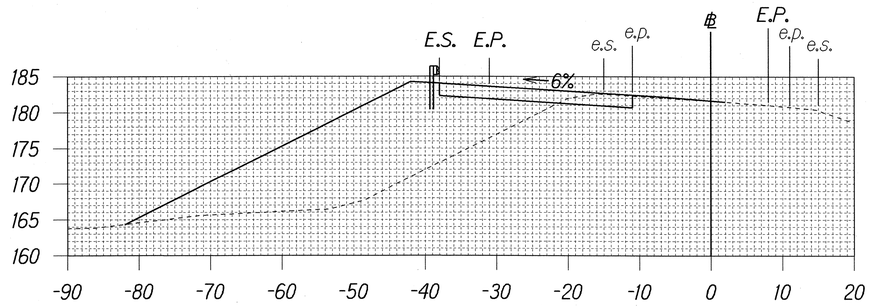

C = 10 s.f.
F = 358 s.f.

11+50

Exc = 9 c.y.
Emb = 331 c.y.

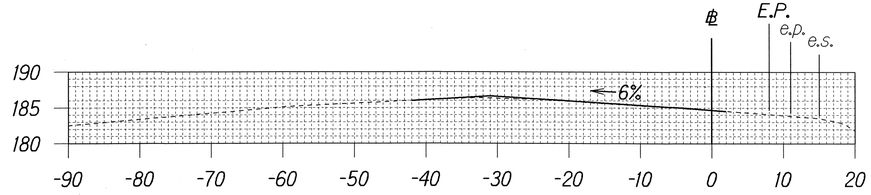

C = 0 s.f.
F = 0 s.f.

11+00

Exc = 352 c.y.
Emb = 381 c.y.

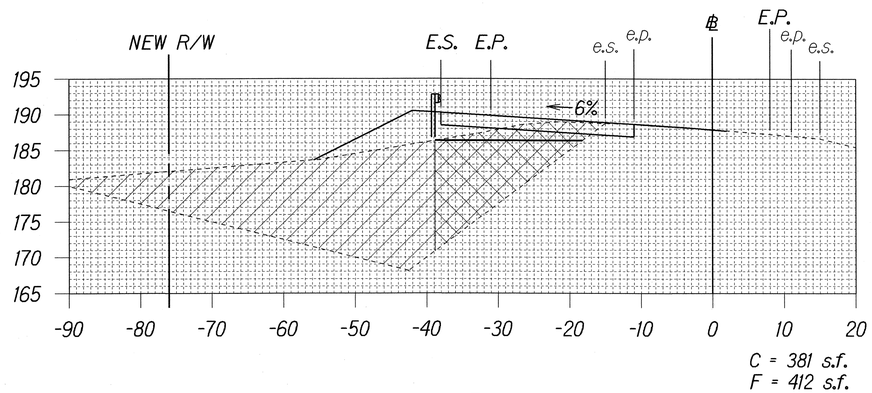

C = 381 s.f.
F = 412 s.f.

10+50

Exc = 505 c.y.
Emb = 606 c.y.

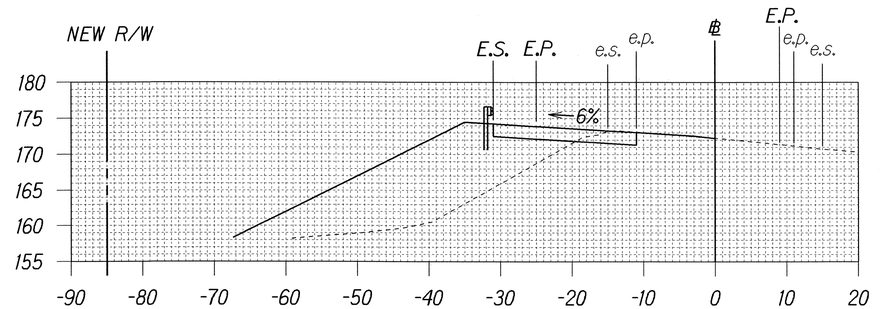

C = 7 s.f.
F = 263 s.f.

13+00

Exc = 13 c.y.
Emb = 539 c.y.

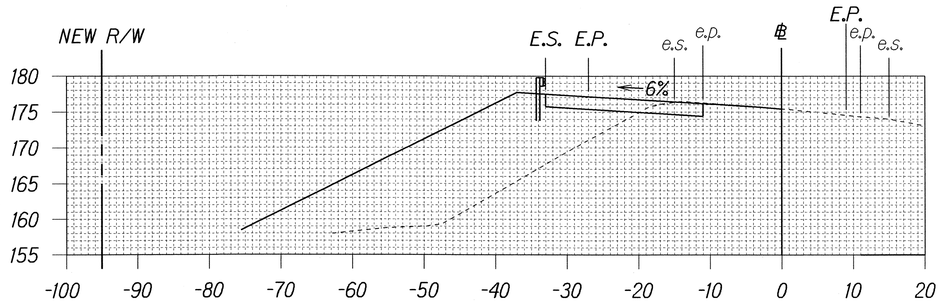

C = 7 s.f.
F = 319 s.f.

12+50

Exc = 10 c.y.
Emb = 761 c.y.

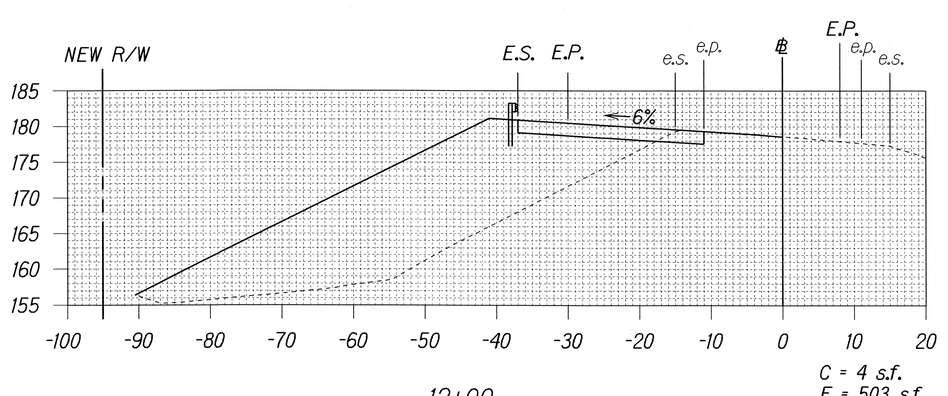

C = 4 s.f.
F = 503 s.f.

12+00

Exc = 13 c.y.
Emb = 797 c.y.

Legend: Wastefill

Wastefill to be Removed

Scale: Vert.: 1" = 10'
Horiz.: 1" = 10'

Note: Wastefill to be removed limited to 6' below finished grade, or as directed by Engineer.

ORIGINAL PLAN	SURVEY PLOTTED BY	DATE 6/5/00
	DRAWN BY MD	
NOTE BOOK dated	TRACED BY JH	
	DESIGN BY JH	
	QUANTITIES BY	
	CHECKED BY	

SHEET No. 4 OF 5 SHEETS

"AS-BUILT"

FED. ROAD DIST. NO.	STATE	PROJ. NO.	FISCAL YEAR	SHEET NO.	TOTAL SHEETS
HAWAII	HAW.	56D-01-99	2001	27	27

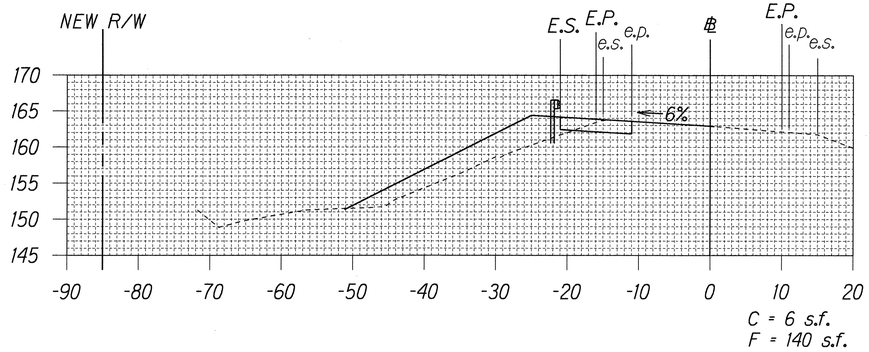

14+50

Exc = 12 c.y.
Emb = 209 c.y.

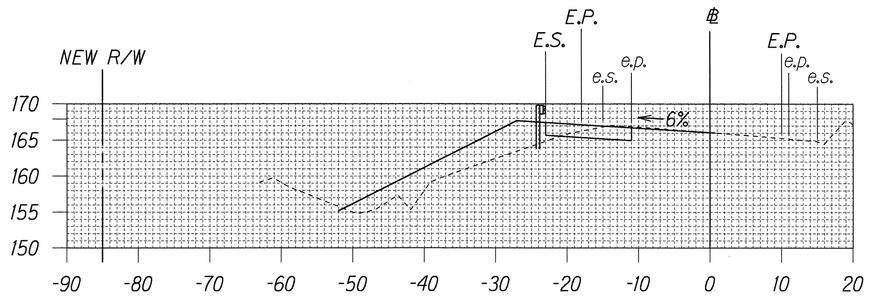

14+00

Exc = 12 c.y.
Emb = 233 c.y.

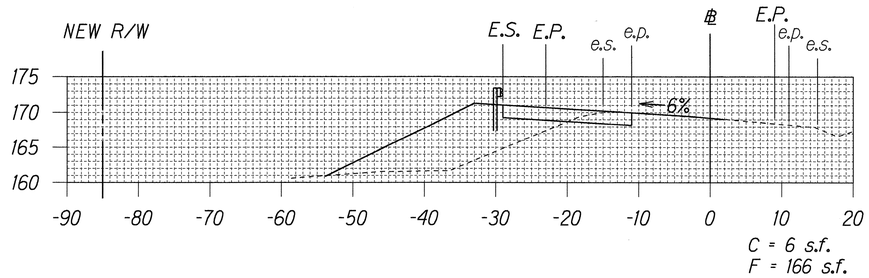

13+50

Exc = 12 c.y.
Emb = 397 c.y.

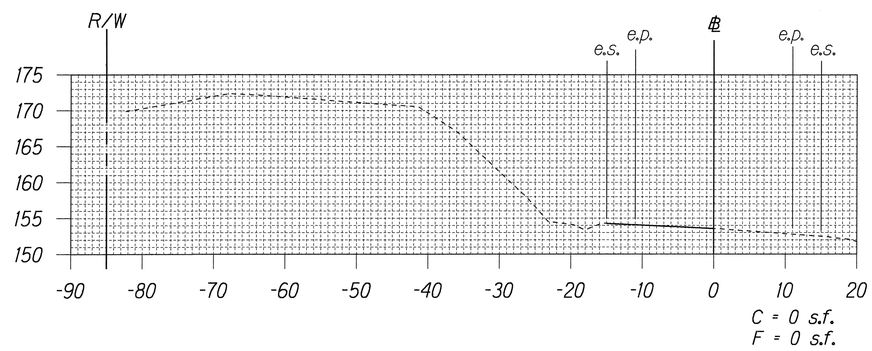

16+00

Exc = 0 c.y.
Emb = 2 c.y.

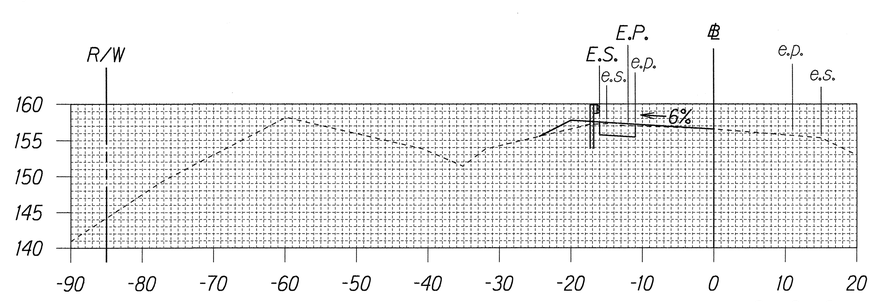

15+50

Exc = 15 c.y.
Emb = 40 c.y.

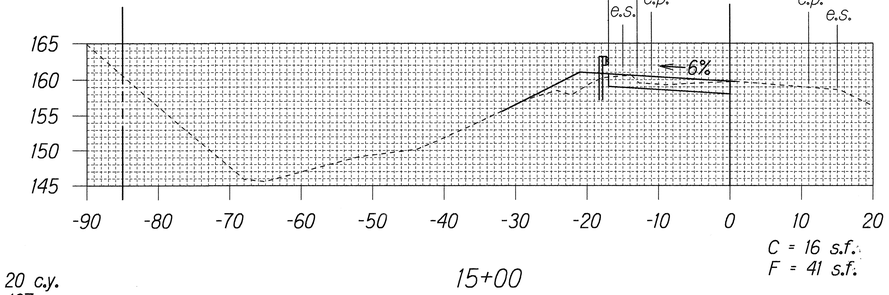

15+00

Exc = 20 c.y.
Emb = 167 c.y.

Exc = 12 c.y.
Emb = 397 c.y.

Legend: Wastefill

Scale: Vert.: 1" = 10'
Horiz.: 1" = 10'

ORIGINAL PLAN	SURVEY PLOTTED BY	DATE 12-14-99
	DRAWN BY MD	
NOTE BOOK dgn/nb/dgn	TRACED BY HY	
	DESIGNED BY	
	QUANTITIES BY	
	CHECKED BY	

SHEET No. 5 OF 5 SHEETS