FED. ROAD DIST. NO	STATE	FEDERAL AID PROJ. NO.	FISCAL YEAR	SHEET NO.	TOTAL SHEETS
HAWAII	HAW.	ER-14(1)	2006	28	34

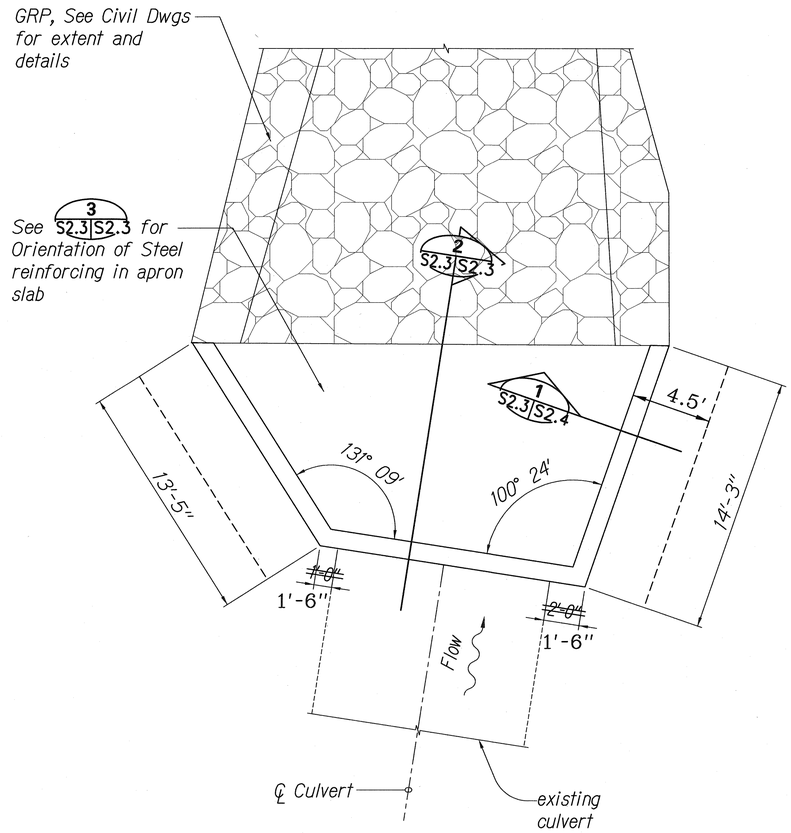

OUTLET STRUCTURE PLAN - VIEW (1 S2.1 S2.3)

Scale: 1/4" = 1'-0"

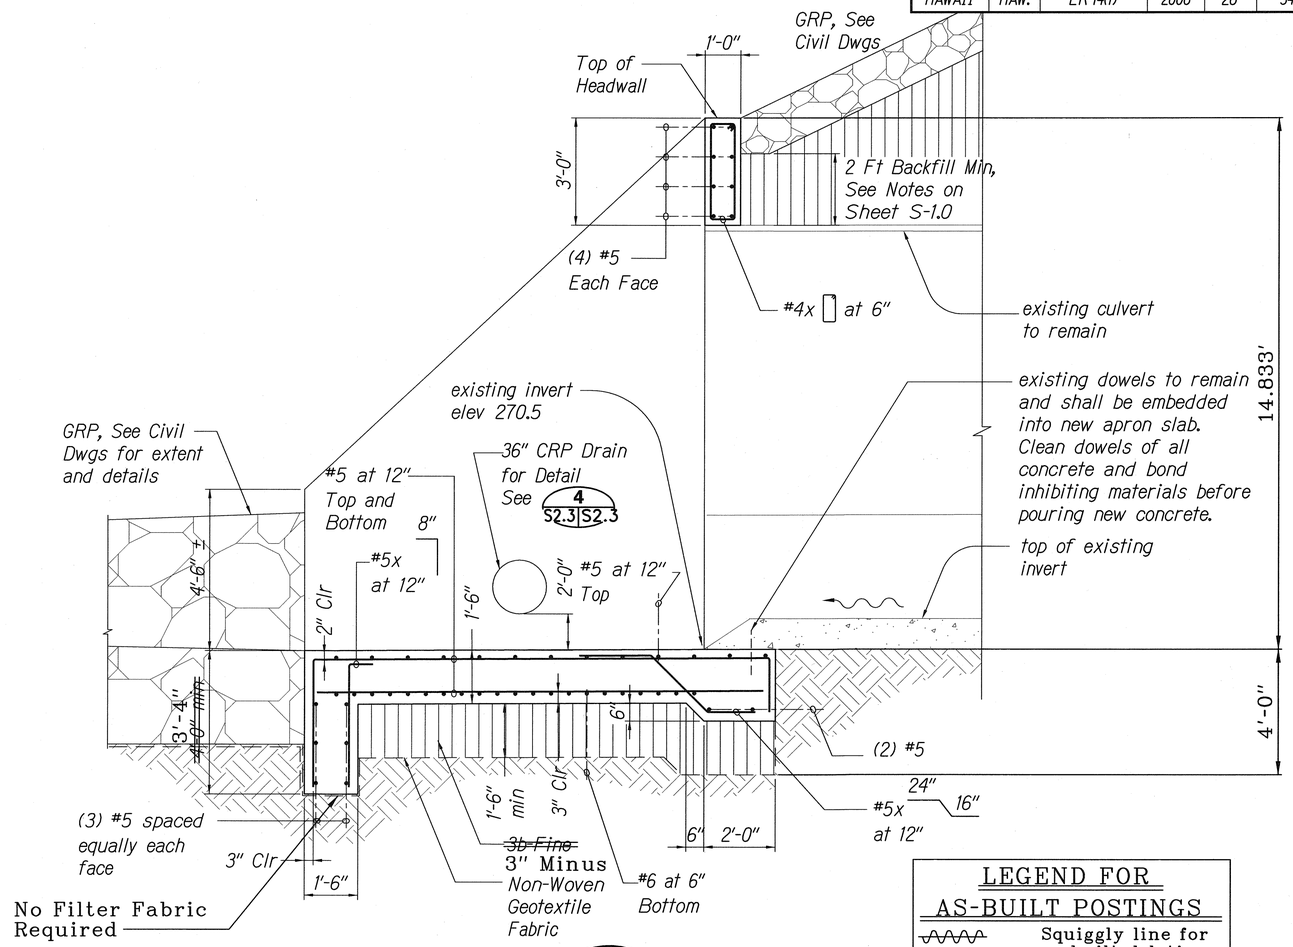

SECTION (2 S2.3 S2.3)

Scale: 1/2" = 1'-0"

LEGEND FOR AS-BUILT POSTINGS	
~~WWW~~	Squiggly line for as-built deletion
~~100.00~~	Double line for as-built deletion
Roadway	Text for as-built posting

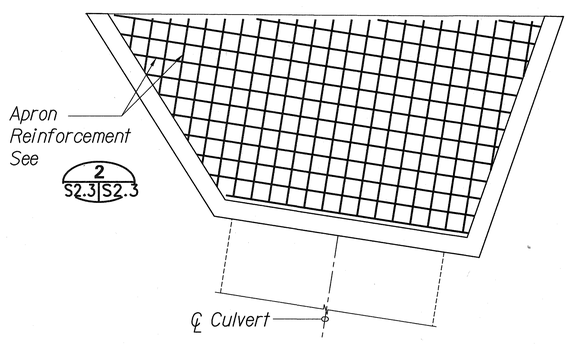

APRON REINFORCEMENT PLAN - VIEW (3 S2.3 S2.3)

Scale: 1/4" = 1'-0"

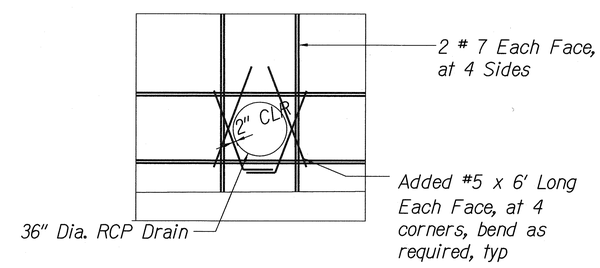

ADDED REINFORCEMENT AT DRAIN PIPE PENETRATION (4 S2.3 S2.3)

Scale: 1/2" = 1'-0"

Date	Revision
4/26/06	Revised Section

STATE OF HAWAII
DEPARTMENT OF TRANSPORTATION
HIGHWAYS DIVISION

OUTLET STRUCTURE PLAN AND SECTION

Kuhio Highway Emergency Repairs
Vicinity of MP 21.7 (Wailapa Stream)
FEDERAL AID PROJECT NO. ER-14(1)

Scale: As shown — Date: April 2006

SHEET No. S2.3 OF 34 SHEETS

ORIGINAL PLAN — SURVEY PLOTTED BY — DRAWN BY — TRACED BY — DESIGNED BY — QUANTITIES BY — CHECKED BY — DATE — NOTE BOOK — No.

"AS-BUILT"

ADD. 28