FED. ROAD DIST. NO.	STATE	FED-AID PROJ. NO.	FISCAL YEAR	SHEET NO.	TOTAL SHEETS
HAWAII	HAW.	56A-03-21	2022	8	11

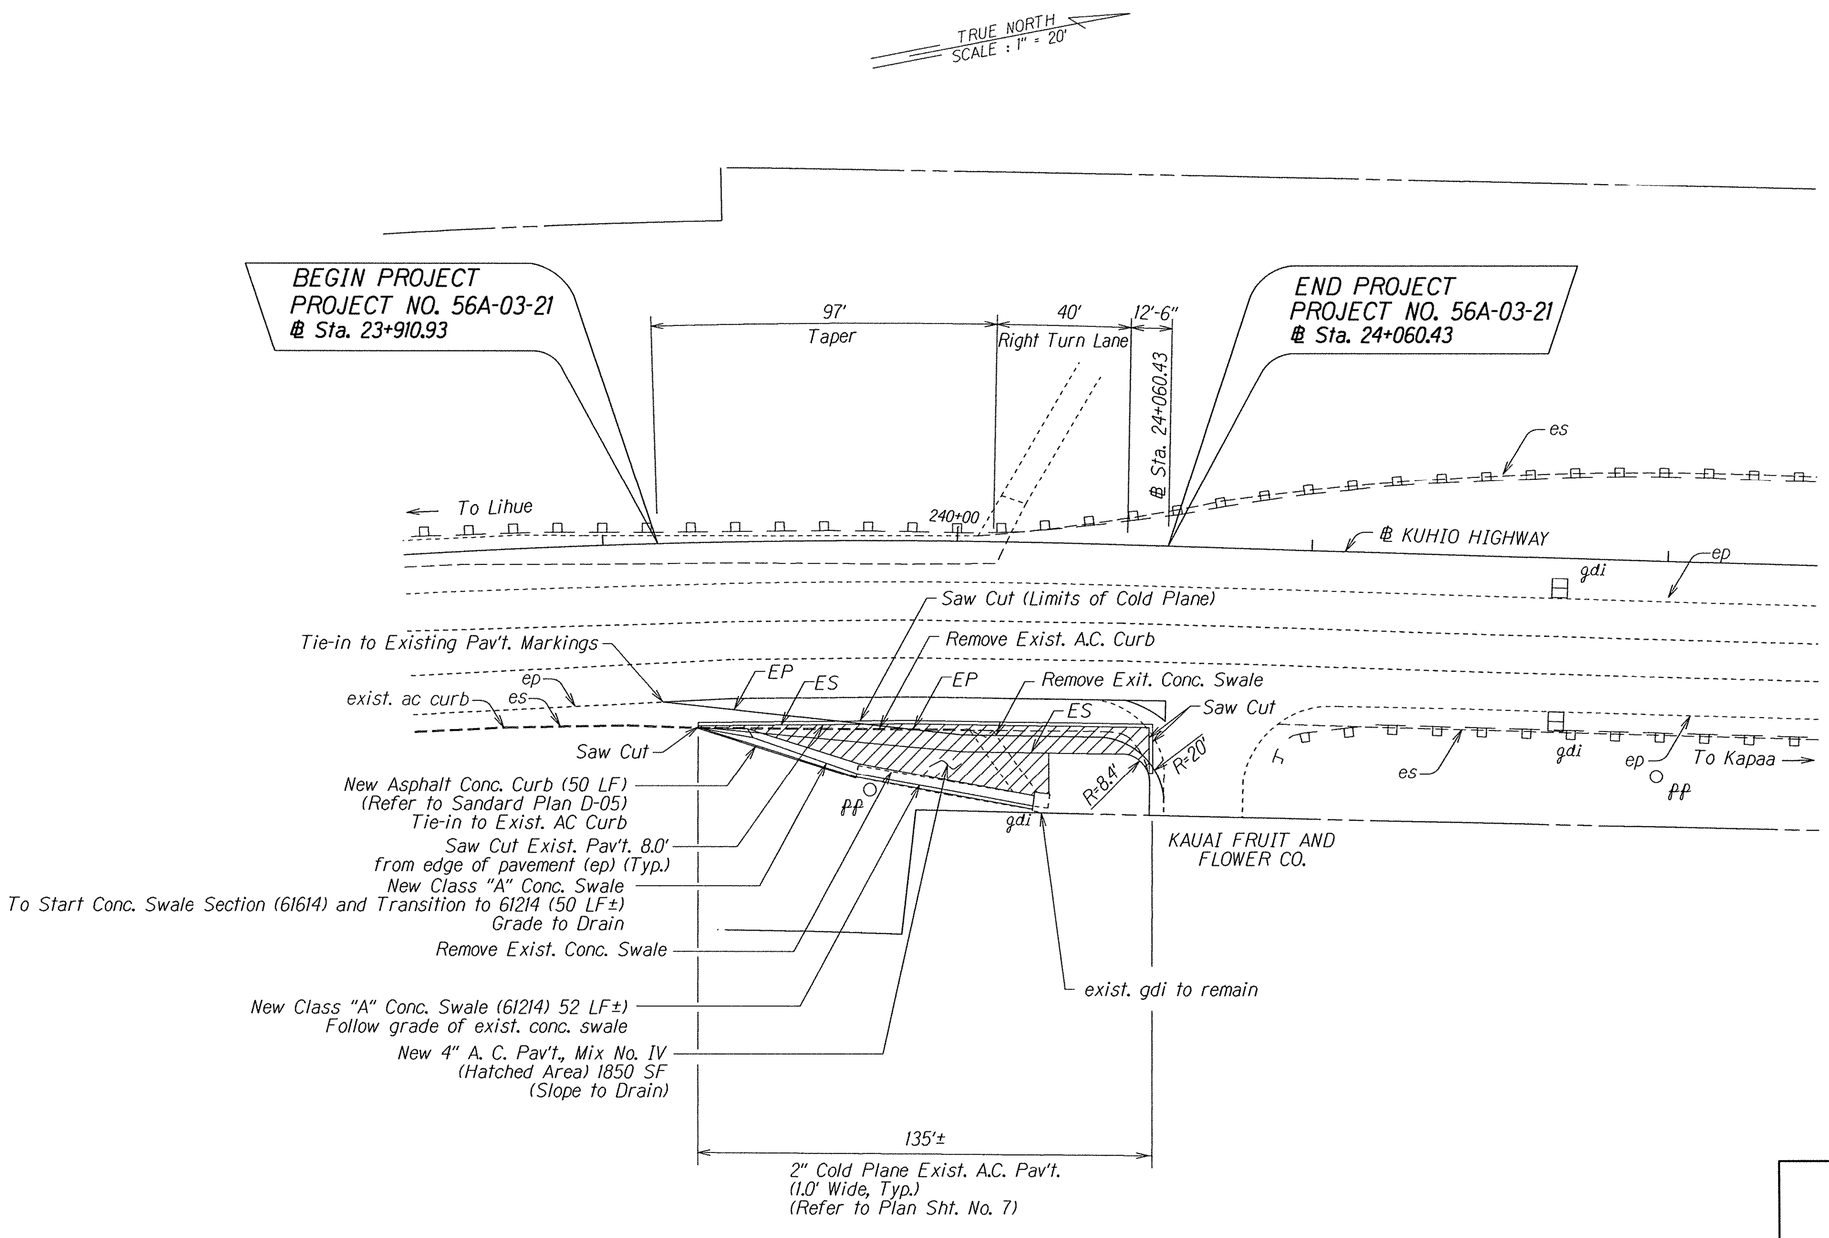

ORIGINAL PLAN	SURVEY PLOTTED BY	DATE
	DRAWN BY x	x
	TRACED BY	
NOTE BOOK	PROOFED BY x	
N.	QUANTITIES BY	
	CHECKED BY	

STATE OF HAWAII
DEPARTMENT OF TRANSPORTATION
HIGHWAYS DIVISION

ROADWAY PLAN

KUHIO HIGHWAY DRAINAGE IMPVT.
Vicinity of Kapule Highway
Project No. 56A-03-21

Scale: 1" = 20' Date: September 2021

SHEET No. 1 OF 1 SHEETS