



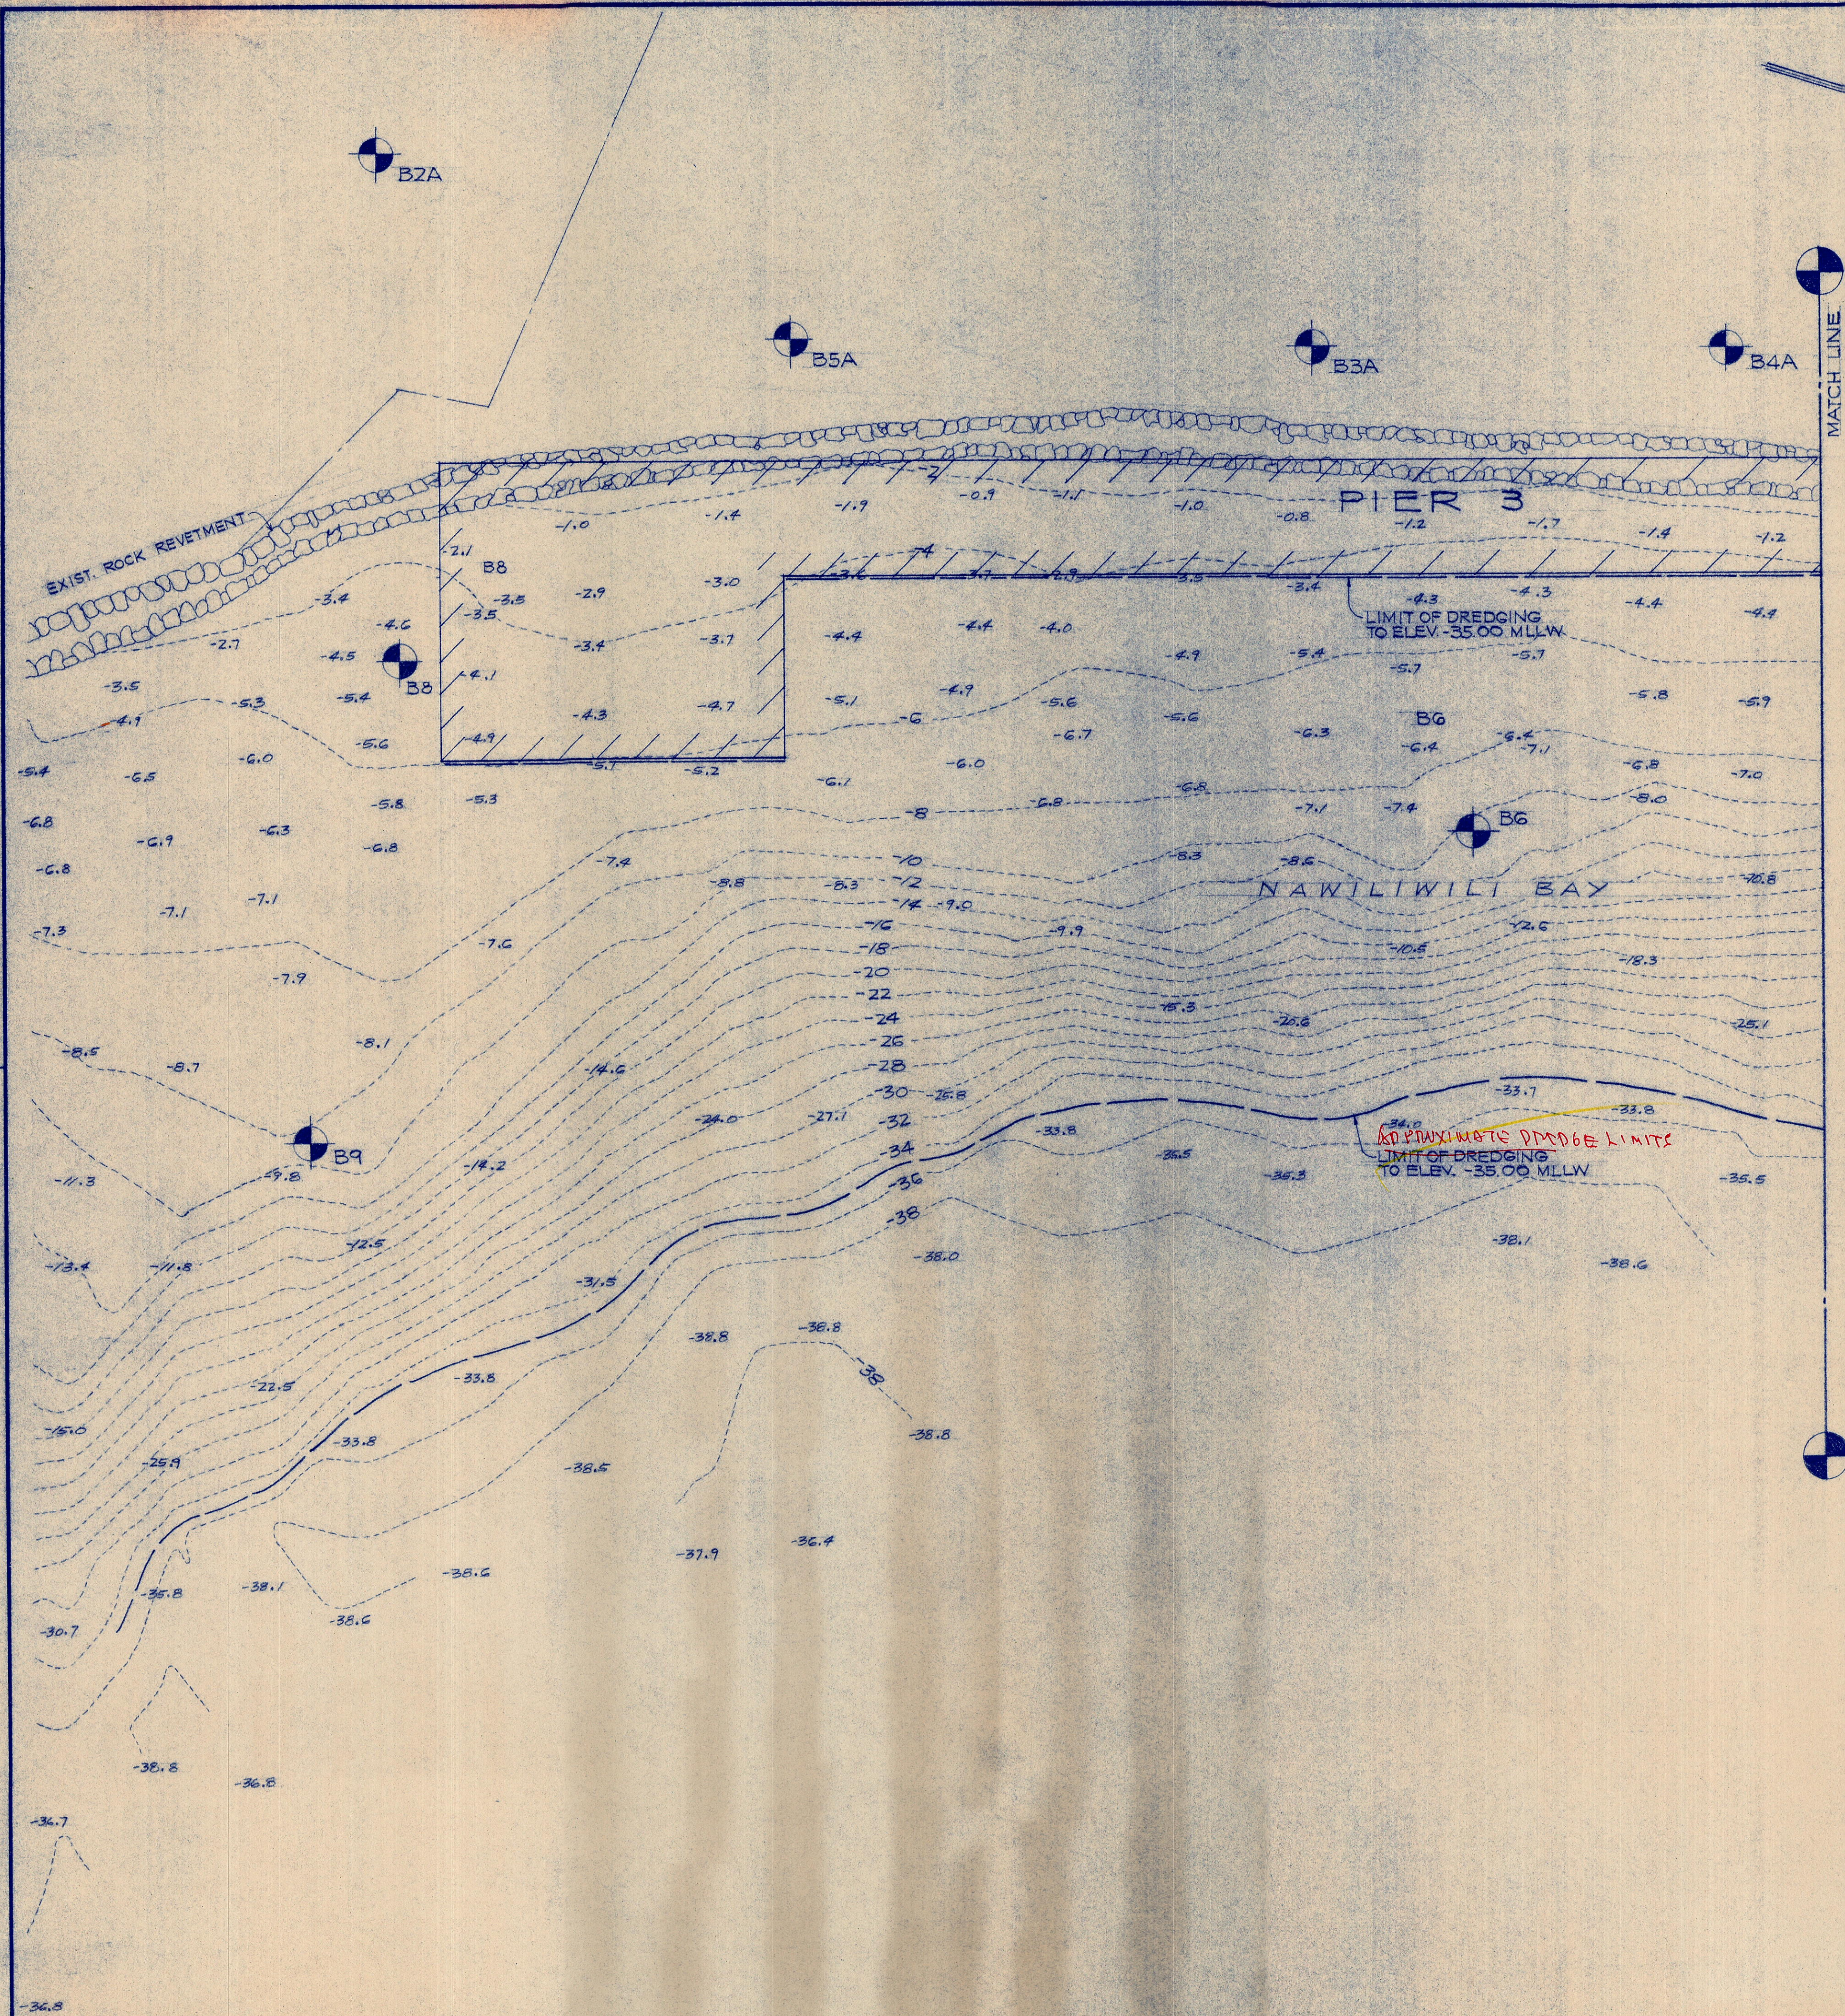

REV	DATE	DESCRIPTION	BY	APPROVED
STATE OF HAWAII DEPARTMENT OF TRANSPORTATION HARBORS DIVISION				
JOB TITLE PIER 3 NAWILIWILI HARBOR KAUAI				
SHEET TITLE HARBOR DREDGING PLAN				
SUBMITTED BY:			RECOMMENDED BY:	
SECTION HEAD			ASSISTANT CHIEF FOR ENGINEERING	
DESIGNED BY:	APPROVED BY:		SHEET	
DRAWN BY:	CHIEF, HARBORS DIVISION		5	
CHECKED BY:	JOB NUMBER			
DATE:	H.C. 7157			
SCALE:			OF SHTS	

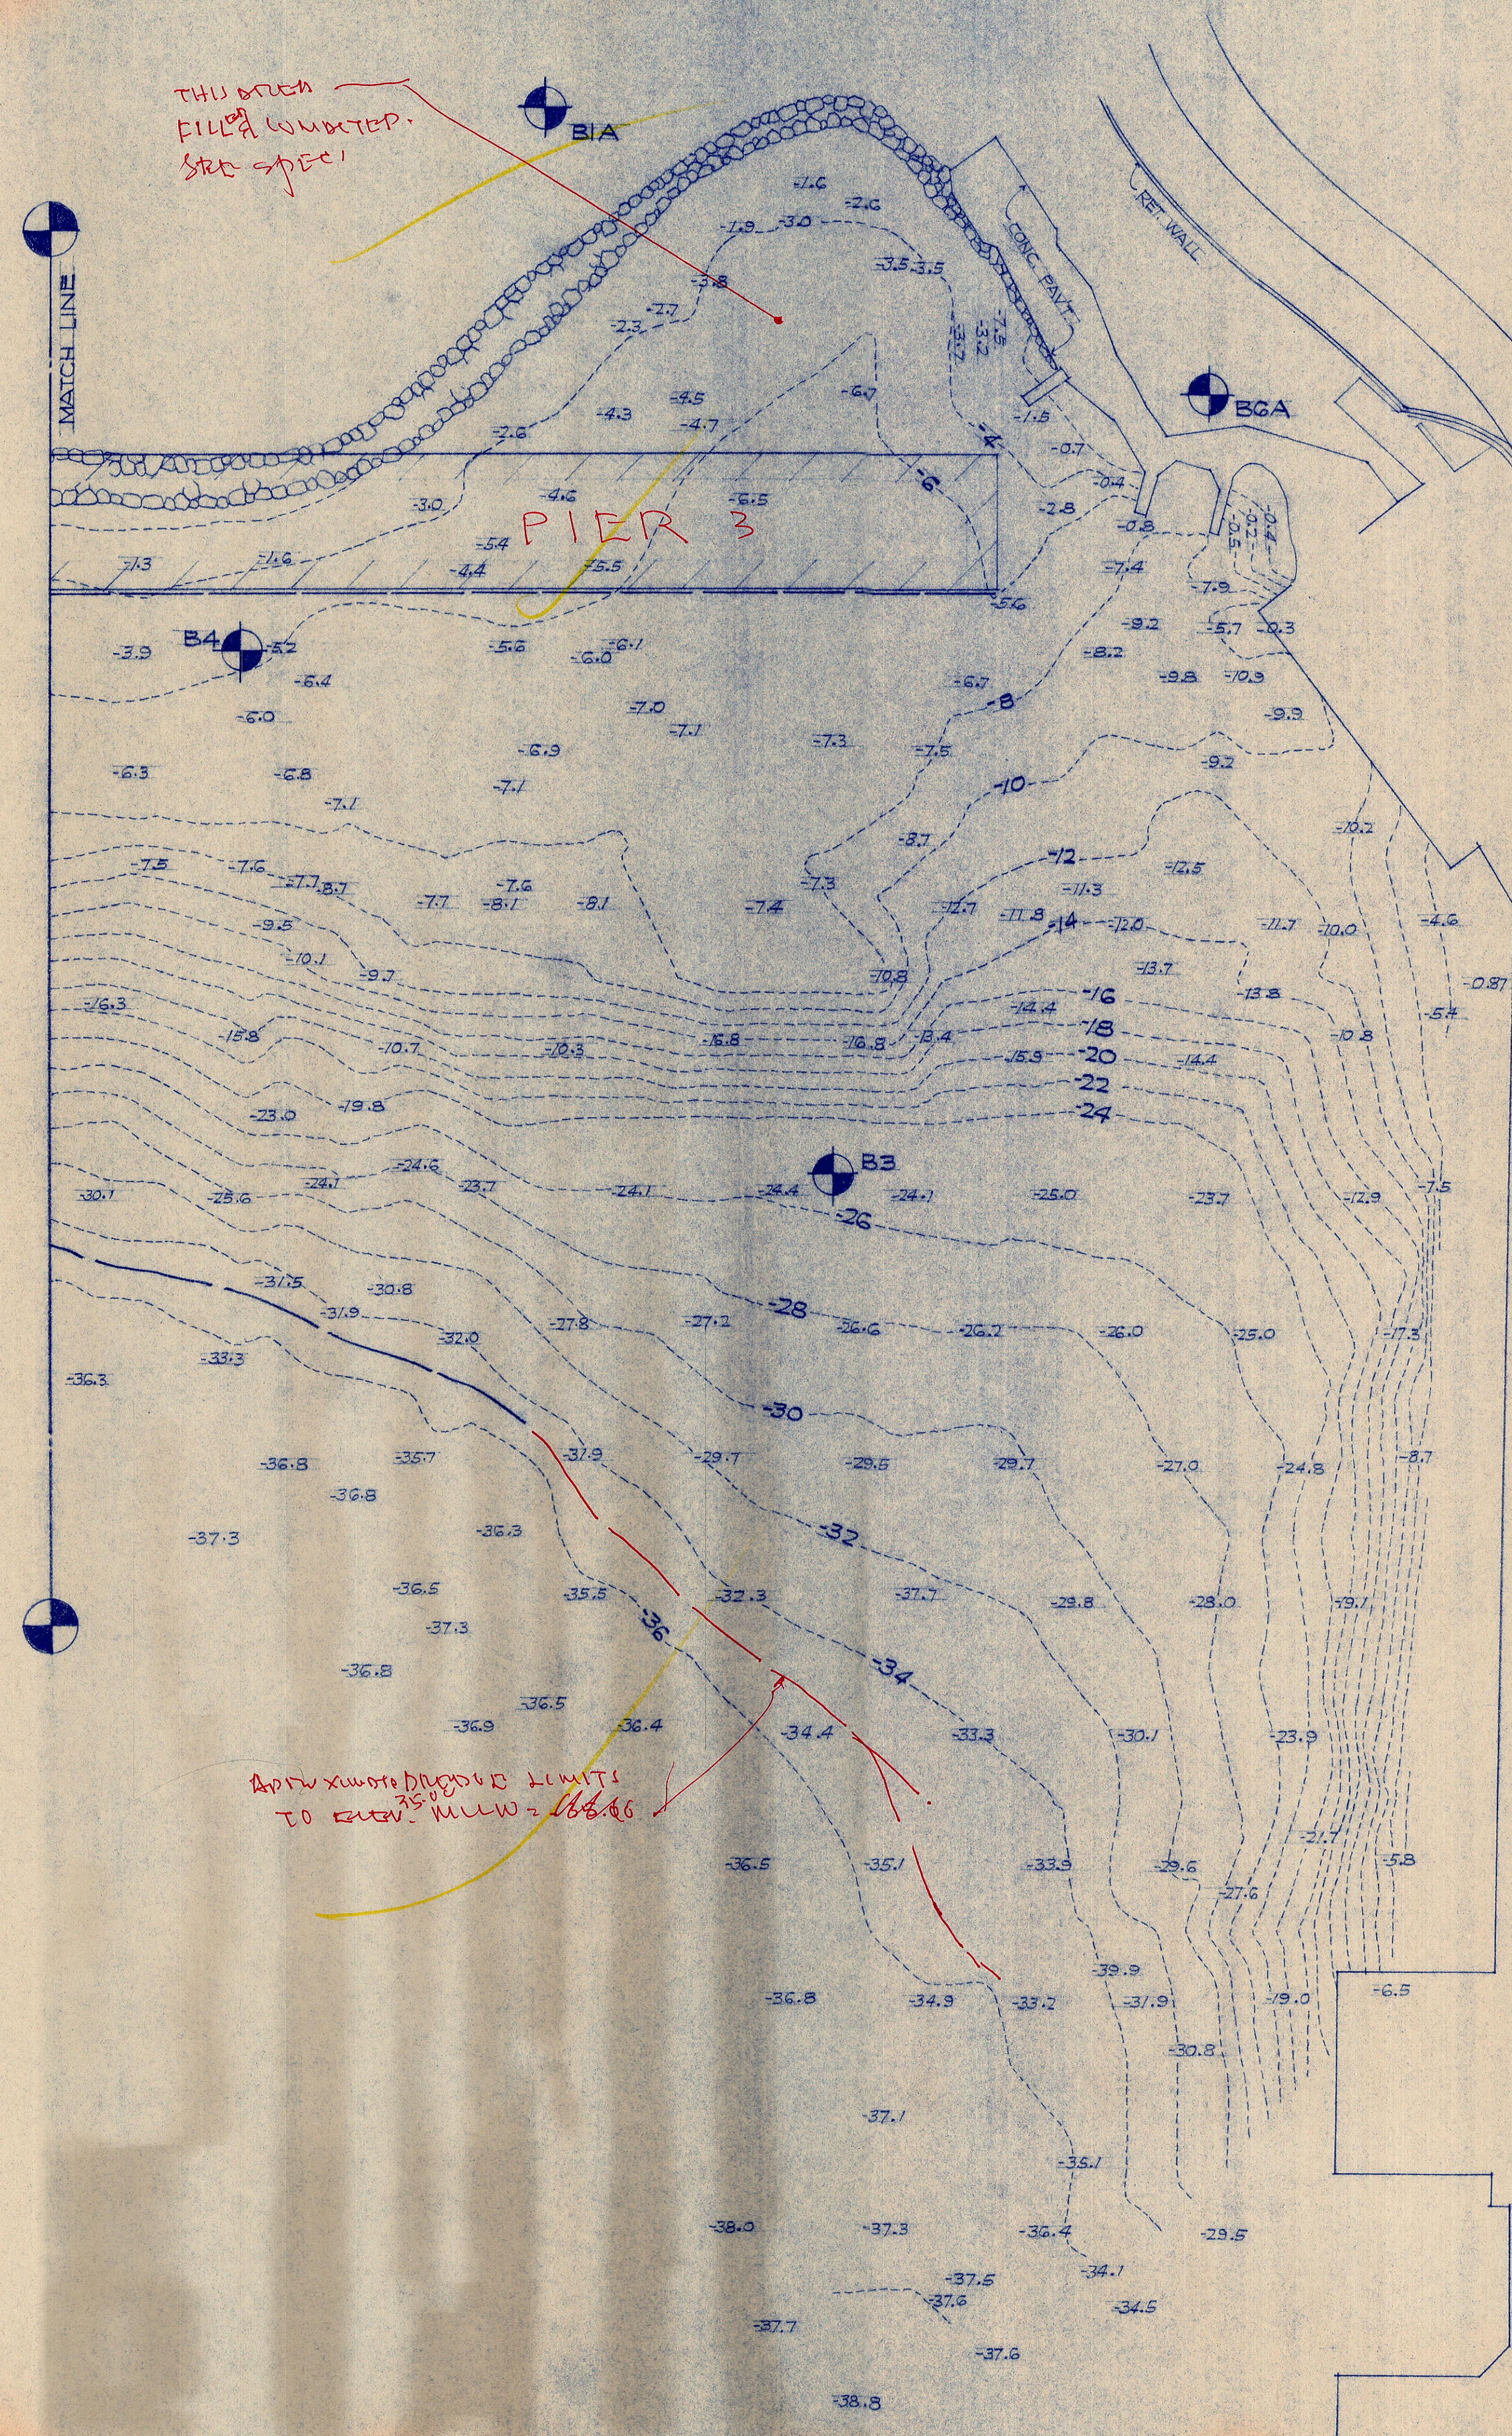

REV	DATE	DESCRIPTION	BY	APPROVED
STATE OF HAWAII DEPARTMENT OF TRANSPORTATION HARBORS DIVISION				
JOB TITLE		PIER 3		
SHEET TITLE		NAWILIWILI HARBOR KAUAI		
SUBMITTED BY:		RECOMMENDED BY:		
DESIGNED BY:		APPROVED BY:		SHEET
DRAWN BY:		CHIEF, HARBORS DIVISION		
CHECKED BY:		JOB NUMBER		
DATE:		H.C. 7157		
SCALE:				OF SHTS.