


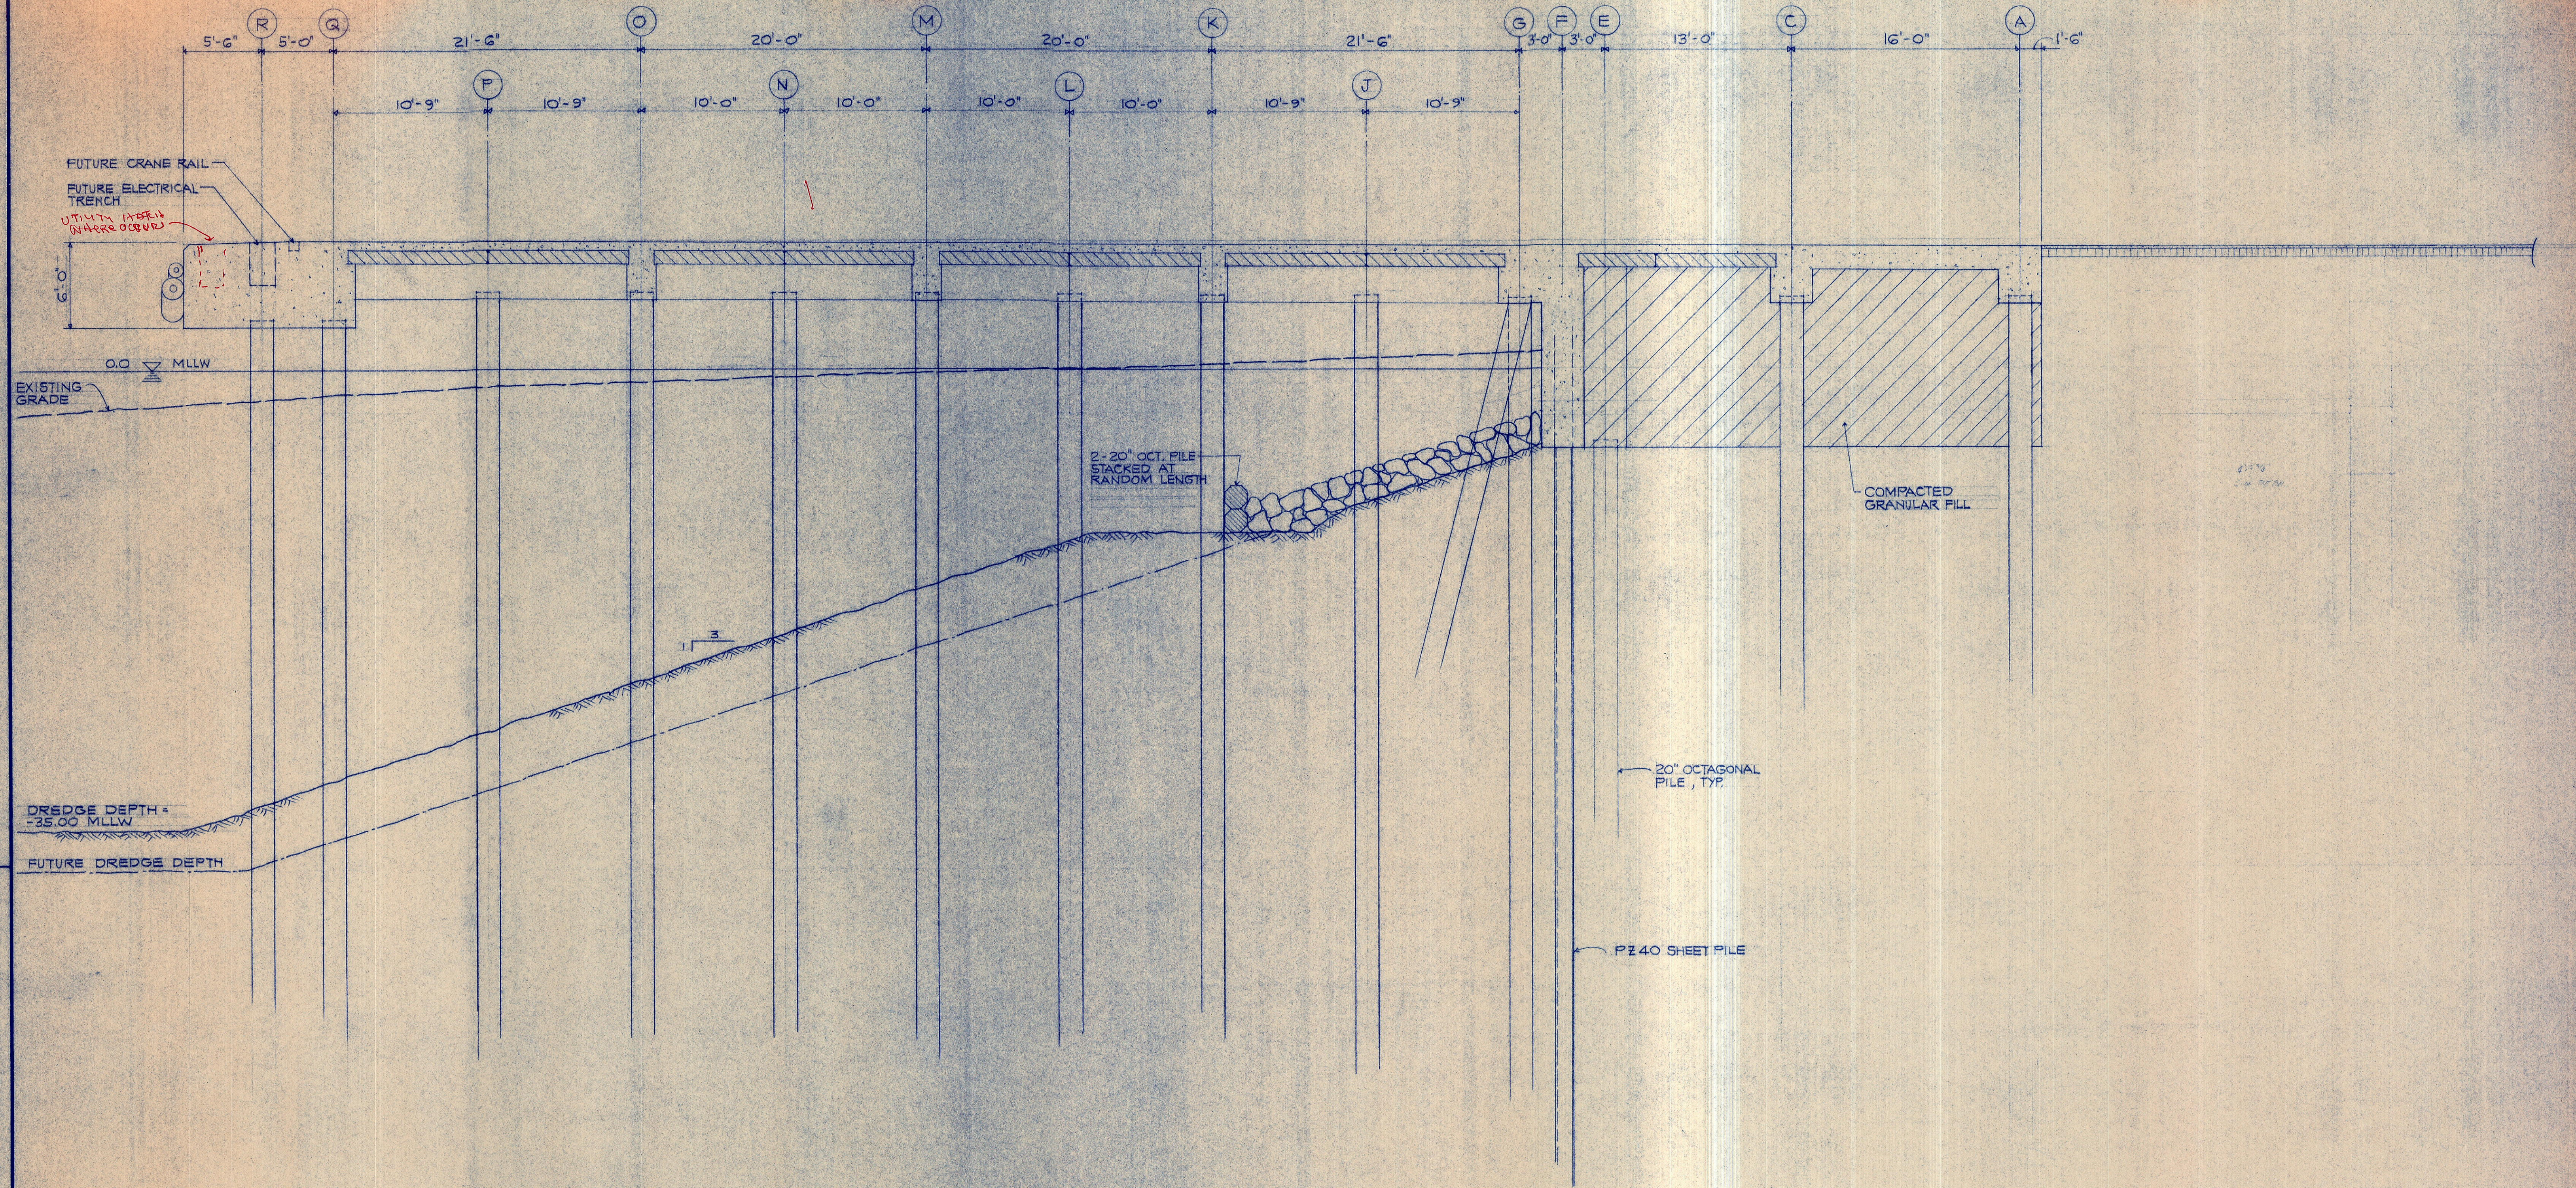

TYPICAL DECK CROSS SECTION

SCALE 3/16" = 1'-0"



REV	DATE	DESCRIPTION	BY	APPROVED
STATE OF HAWAII DEPARTMENT OF TRANSPORTATION HARBORS DIVISION				
JOB TITLE PIER 3				
SHEET TITLE TYPICAL DECK CROSS SECTION (ROLL ON ROLL OFF)				
SUBMITTED BY: SECTION HEAD			RECOMMENDED BY: ASSISTANT CHIEF FOR ENGINEERING	
DESIGNED BY: J.W.		APPROVED BY: CHIEF, HARBORS DIVISION		S-11
DRAWN BY: M.M.		JOB NUMBER H.C. 7157-A		
CHECKED BY: T.N., R.T.		DATE:		
SCALE: AS NOTED		OF _____ SHTS.		