FED. ROAD DIST. NO.	STATE	PROJ. NO.	FISCAL YEAR	SHEET NO.	TOTAL SHEETS
HAWAII	HAW	A-520-01-66 UNIT 1	1969	1	14

INDEX TO DRAWINGS

SHEET NO.	DESCRIPTION
1	TITLE SHEET
2	TYPICAL SECTIONS AND MISC. DETAILS
3-7	PLAN AND PROFILE
8	DETOUR PLAN
9-11	STANDARD DETAILS
12-14	CROSS SECTIONS

STATE OF HAWAII

DEPARTMENT OF TRANSPORTATION

HIGHWAYS DIVISION

"AS BUILT" PLANS FOR

WIDENING, RESURFACING AND REALIGNMENT OF

MALUHIA ROAD

PROJECT NO. A 520-01-66
UNIT I

DISTRICT OF KOLOA

ISLAND OF KAUAI

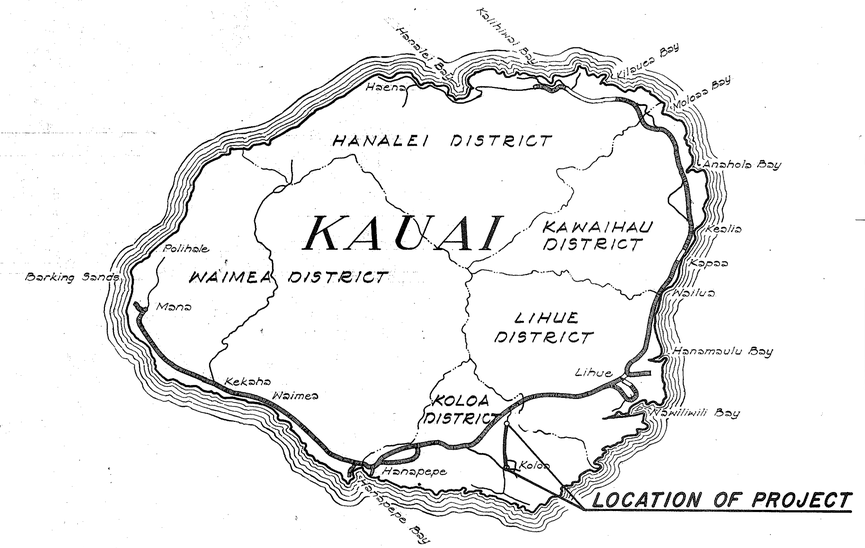

CONVENTIONAL SIGNS

- Baseline (7.5)
- Boundary Line
- Fences (Named)
- Existing Roadway
- Pipe Culvert
- Box Culvert
- Telephone Line & Pole
- Electric Line & Pole
- Water Main

SCALES

PLAN	1 INCH = 100 FT.
PROFILE	HOR. 1 INCH = 100 FT.
	VER. 1 INCH = 10 FT.
CROSS SECTION	HOR. 1 INCH = 10 FT.
	VER. 1 INCH = 10 FT.

FEDERAL AID PROJECTS PREVIOUSLY CONSTRUCTED OR UNDER CONSTRUCTION

GROSS LENGTH OF PROJECT.....2.405 MI.

NOTE:

ALL CHANGES MADE DURING CONSTRUCTION HAVE BEEN NOTED IN RED ON THESE TRACINGS AND CHECKED BY

PROJECT ENGINEER

DATE

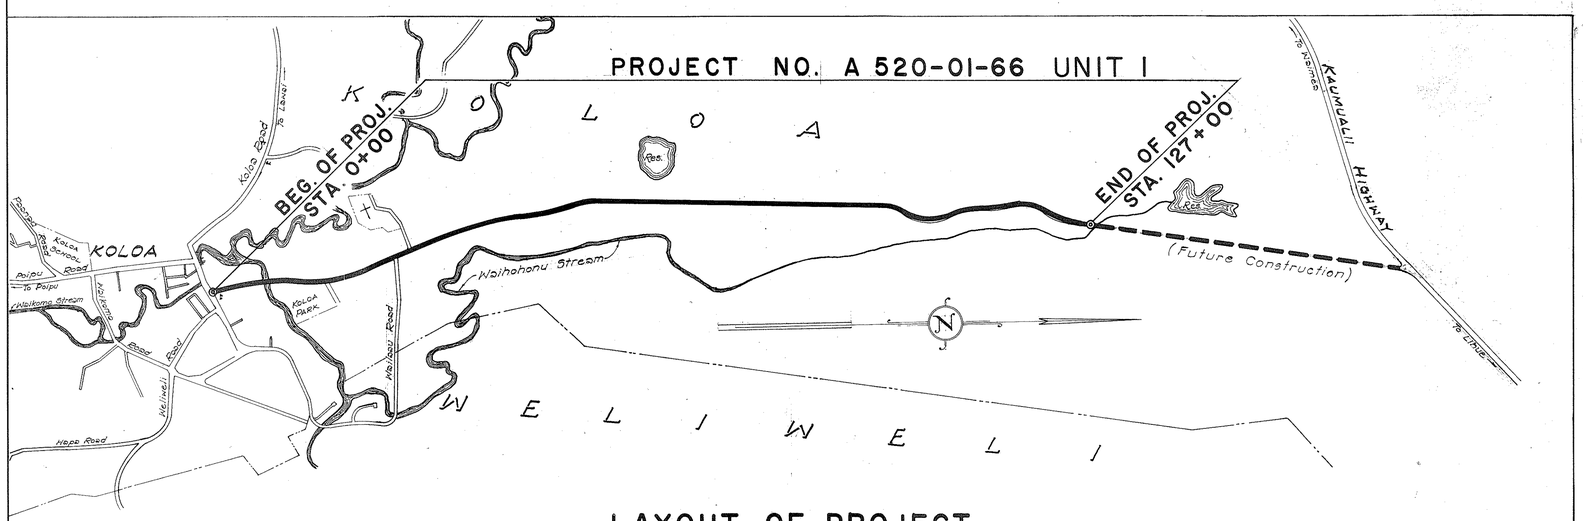

LAYOUT OF PROJECT

SCALE: 1" = 1000'

APPROVED: DATE 27 Nov. 65

DIRECTOR OF TRANSPORTATION