FED. ROAD DIST. NO.	STATE	FED. AID PROJ. NO.	FISCAL YEAR	SHEET NO.	TOTAL SHEETS
HAWAII	HAW	S 5 (3)	1945	1	2

INDEX TO DRAWINGS

SHEET No	DESCRIPTIONS
1	Title Sheet
2	Typical Sections

TERRITORY OF HAWAII

TERRITORIAL HIGHWAY DEPARTMENT

HONOLULU T. H.

PLANS OF

PAVING AND WIDENING OF A PORTION OF

Mc. BRYDE MILL ROAD

FEDERAL AID SECONDARY PROJECT NO. S 5 (3)

DISTRICT OF KOLOA

ISLAND OF KAUAI

NOTE!
ALL CHANGES MADE DURING CONSTRUCTION HAVE BEEN NOTED IN THESE TRACINGS AND CHECKED BY
Tetsuo Yamase
RESIDENT ENGINEER
DATE 8-19-49

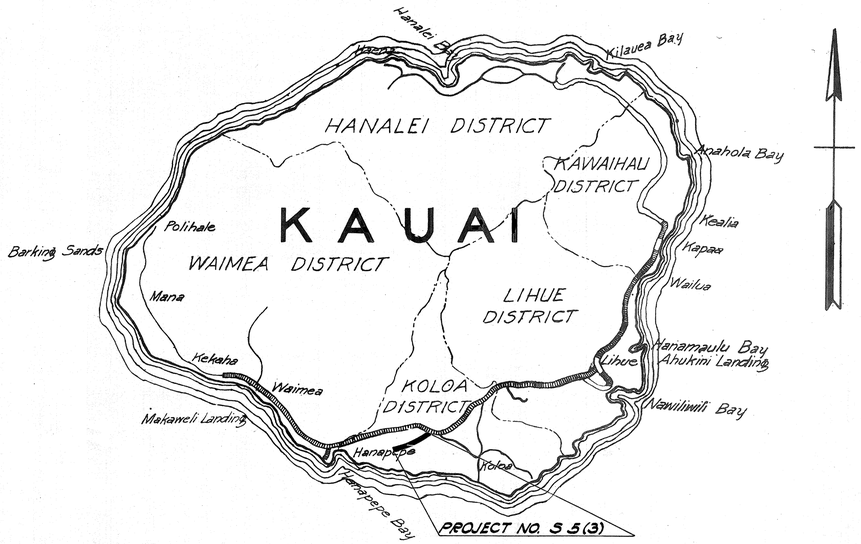

Federal Aid Projects Previously constructed or under construction

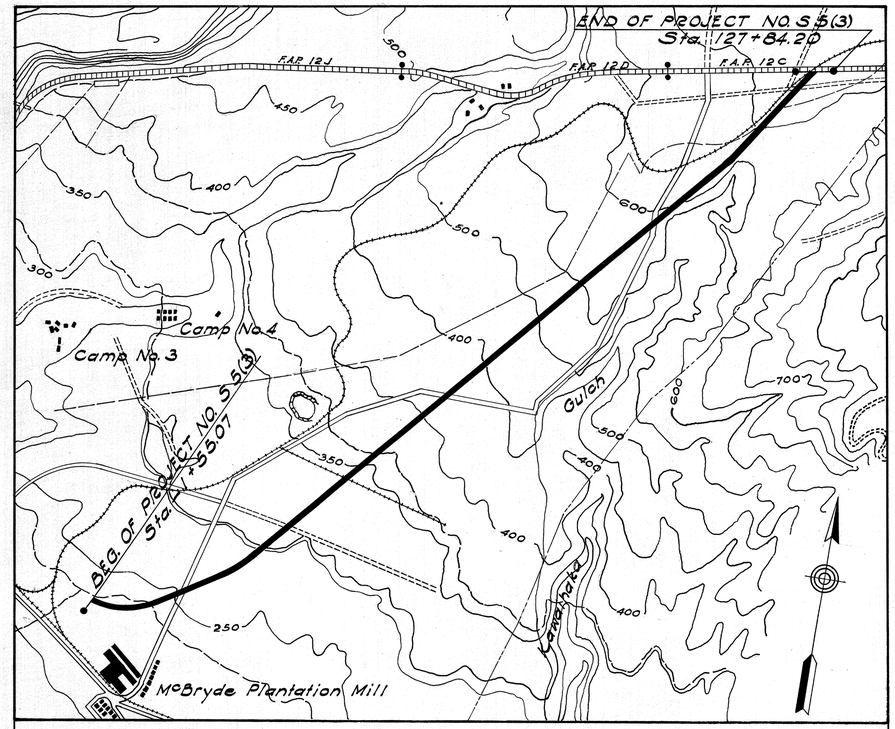

Scale: 1" = 1,000'

LAYOUT OF PROJECT

Gross & Net Length 2.450 Miles

ORIGINAL PLAN	SURVEY PLOTTED BY	DATE
	TRACED BY	"
	DRAWN BY	"
NOTE BOOK	TRACED BY	"
	QUANTITIES BY	"
No.	QUANTITIES CHECKED BY	"
	CHECKED BY	"

APPROVED: DATE 9-14-48
TERRITORIAL HIGHWAY ENGINEER

RECOMMENDED FOR APPROVAL: DATE
DISTRICT ENGINEER
PUBLIC ROADS ADMINISTRATION
FEDERAL WORKS AGENCY

APPROVED: DATE
DIVISION ENGINEER
PUBLIC ROADS ADMINISTRATION
FEDERAL WORKS AGENCY

5305.1