FED. ROAD DIST. NO.	STATE	PROJ. NO.	FISCAL YEAR	SHEET NO.	TOTAL SHEETS
HAWAII	HAW.	56D-01-81M	1981	1	21

56

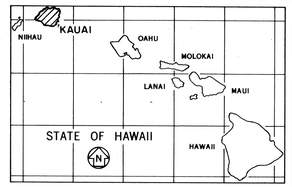

INDEX TO DRAWINGS

SHEET NO.	DESCRIPTION
1	TITLE SHEET
2	GENERAL NOTES
3	PLAN-PRATT TRUSS
4	PLAN-WARREN TRUSS
5 - 6	DETAILS-WARREN TRUSS
7 - 15	DETAILS-PRATT TRUSS
16	PORTAL FRAME DETAILS
17	TRAFFIC CONTROL PLAN
18 - 19	STANDARD DETAILS
20 - 21	BARRICADES

STATE OF HAWAII

DEPARTMENT OF TRANSPORTATION

HIGHWAYS DIVISION

HONOLULU, HAWAII

"AS BUILT"

PLANS FOR

KUHIO HIGHWAY

REPAIRS TO HANALEI BRIDGE

PROJECT NO. 56D-01-81M

DISTRICT OF HANALEI
ISLAND OF KAUAI

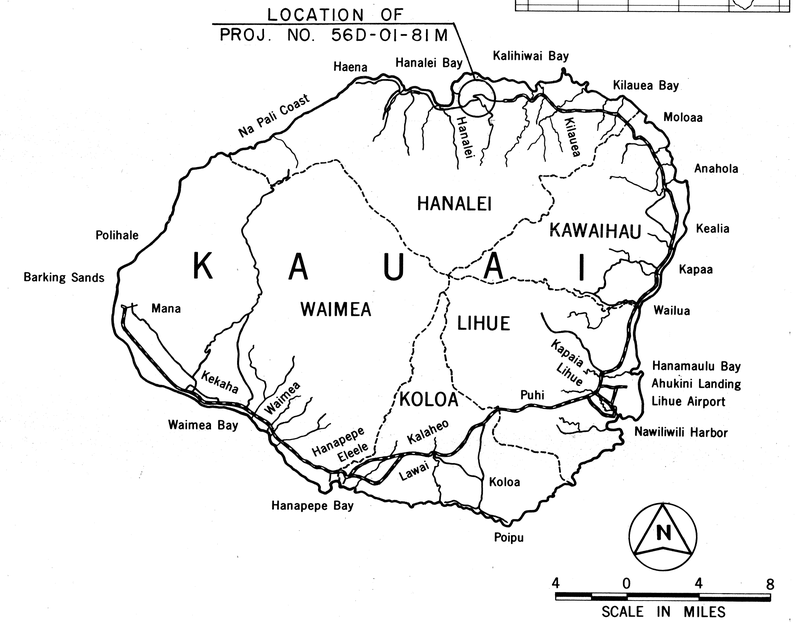

FEDERAL AID PROJECTS PREVIOUSLY CONSTRUCTED OR UNDER CONSTRUCTION

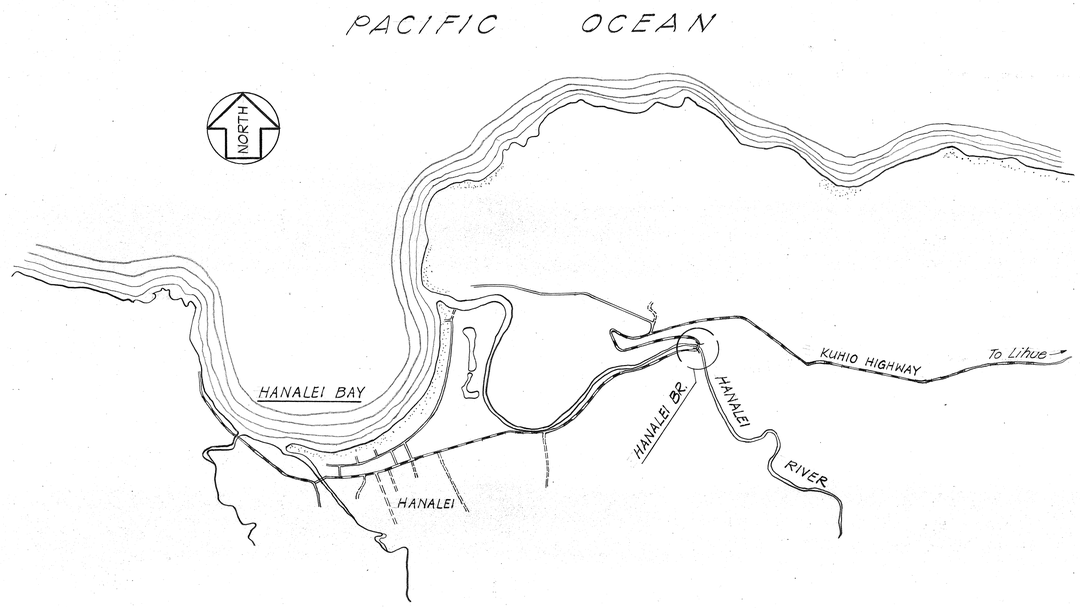

LOCATION PLAN
Not To Scale

ALL CHANGES MADE DURING CONSTRUCTION HAVE BEEN INCORPORATED ON THESE PLANS IN RED EXCEPT CHANGES IN THE ORIGINAL THEORETICAL QUANTITIES. FOR ACTUAL QUANTITIES, REFER TO PROJECT LEDGER AND/OR COMPUTATION BOOK.

Donald Nagamine
for RESIDENT ENGINEER — 10/1/82 DATE

HWY-DB		548-7534	10/23/80
DESIGNED BY	P. S. & E. BY	PHONE	DATE
	R. MIKAMI		

DEPARTMENT OF TRANSPORTATION
STATE OF HAWAII
APPROVED:
James R. Carras 10/23/80
DIR. OF TRANSPORTATION — DATE

0-9-3 6321-2122