FED. ROAD DIST. NO.	STATE	PROJ. NO.	FISCAL YEAR	SHEET NO.	TOTAL SHEETS
HAWAII	HAW.	56D-01-82M	1982	1	11

56

INDEX TO DRAWINGS	
SHEET NO.	DESCRIPTION
1	TITLE SHEET
2 - 5	PLAN - WAIPA BRIDGE
6	PLAN - WAIKOKO BRIDGE
7	GENERAL NOTES AND TYPICAL DETAILS
8	TRAFFIC CONTROL PLAN
9 - 11	STANDARD DETAILS

STATE OF HAWAII

DEPARTMENT OF TRANSPORTATION
HIGHWAYS DIVISION

HONOLULU, HAWAII

"AS BUILT"

PLANS FOR

KAUAI BELT ROAD

REHABILITATION AND REPAIRS TO WAIPA BRIDGE AND WAIKOKO BRIDGE

PROJECT NO. 56D-01-82M

DISTRICT OF HANALEI
ISLAND OF KAUAI

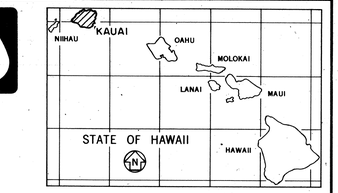

LOCATION OF PROJECT
NO. 56D-01-82M

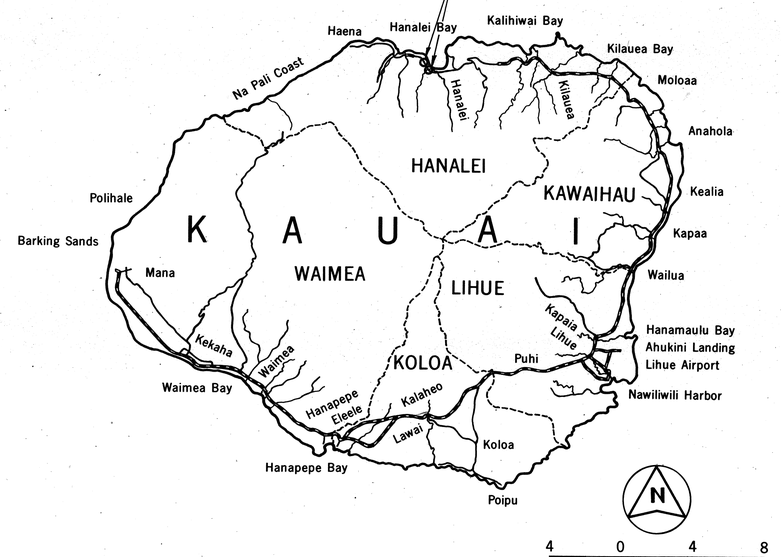

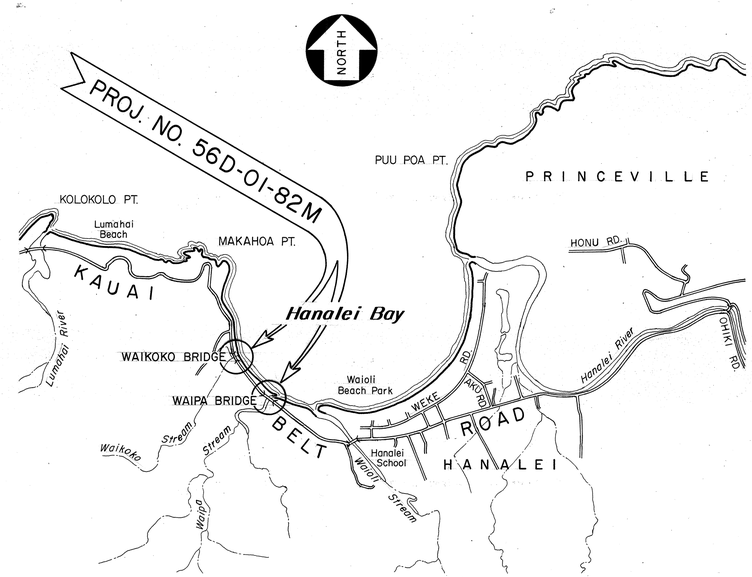

LAYOUT PLAN
SCALE: 1" = 2000'

FEDERAL AID PROJECTS PREVIOUSLY CONSTRUCTED OR UNDER CONSTRUCTION

ALL CHANGES MADE DURING CONSTRUCTION HAVE BEEN INCORPORATED ON THESE PLANS IN RED EXCEPT CHANGES IN THE ORIGINAL THEORETICAL QUANTITIES FOR ACTUAL QUANTITIES, REFER PROJECT LEDGER AND/OR COMPUTATION BOOK

Donald Naganine — RESIDENT ENGINEER
9/22/82 — DATE

DEPARTMENT OF TRANSPORTATION
STATE OF HAWAII
APPROVED:
James R. Carras — DIR. OF TRANSPORTATION
2/19/82 — DATE

Hwy-DB — DESIGNED BY
R. Mikami — P. S. & E. BY
548-7534 — PHONE
DATE

0-10-4