FED. ROAD DIST. NO.	STATE	PROJ. NO.	FISCAL YEAR	SHEET NO.	TOTAL SHEETS
HAWAII	HAW.	560A-01-00M	2000	1	27

560

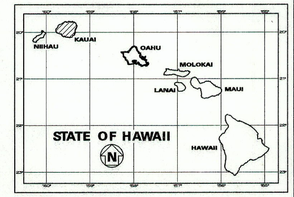

INDEX TO DRAWINGS	
SHEET NO.	DESCRIPTION
1	TITLE SHEET
2	STANDARD PLANS SUMMARY
3	GENERAL NOTES AND LEGENDS
4 – 8	TYPICAL SECTIONS
9 – 13	GUARDRAIL DETAILS & NOTES
14 – 18	ROADWAY PLAN
19	PAVEMENT MARKING LEGEND, DETAILS AND NOTES
20 – 24	PAVEMENT MARKING AND TRAFFIC SIGNING PLAN
25	TRAFFIC SUMMARIES
26	PAVEMENT MARKING SUMMARY
27	SIGN DETAILS

STATE OF HAWAII

DEPARTMENT OF TRANSPORTATION

HIGHWAYS DIVISION

HONOLULU, HAWAII

"AS-BUILT"

PLANS FOR

KUHIO HIGHWAY RESURFACING

VICINITY OF LUMAHAI BRIDGE TO ALEALEA ROAD

PROJECT NO. 560A-01-00M

DISTRICT OF HANALEI

ISLAND OF KAUAI

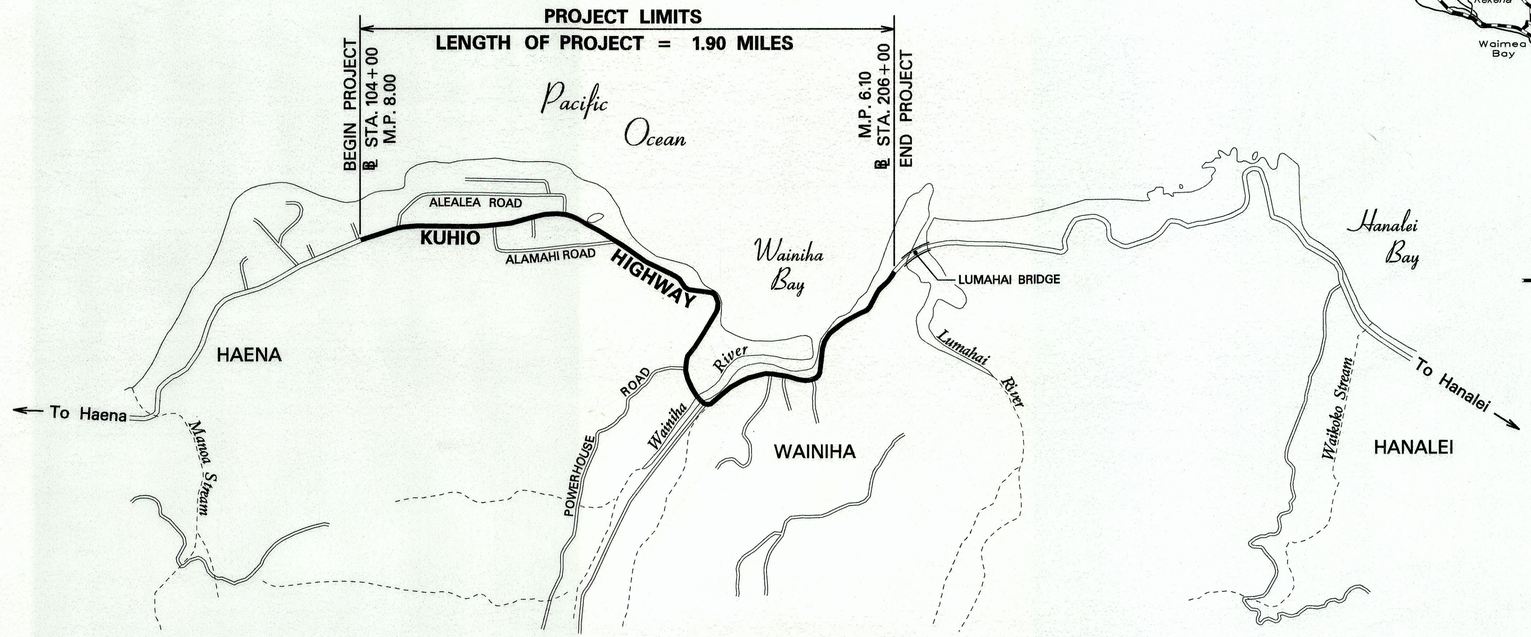

LAYOUT PLAN

GROSS LENGTH OF PROJECT..... 1.9 MILES

NET LENGTH OF PROJECT..... 1.8 MILES

1 0 1 2 3

SCALE IN THOUSAND FEET

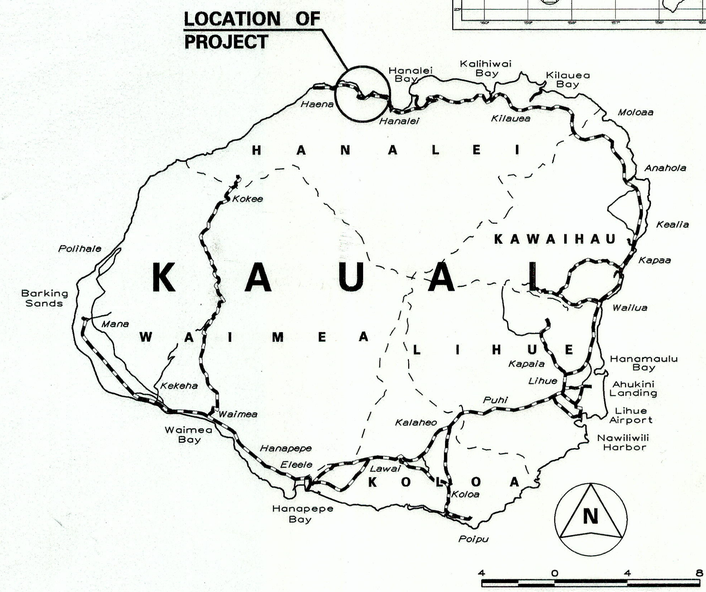

FEDERAL AID PROJECTS PREVIOUSLY CONSTRUCTED OR UNDER CONSTRUCTION

MILE POST 6.1 TO MILE POST 8.0

CHANGES MADE DURING CONSTRUCTION HAVE BEEN INCORPORATED ON THESE PLANS EXCEPT CHANGES IN THE ORIGINAL THEORETICAL QUANTITIES. FOR ACTUAL QUANTITIES, REFER TO PROJECT LEDGER AND/OR COMPUTATION BOOK.

RESIDENT ENGINEER — DATE 2/10/15

DEPARTMENT OF TRANSPORTATION STATE OF HAWAII	
APPROVED: Kazu Hayashida	12/20/99
DIR. OF TRANSPORTATION	DATE

HWY-KE — DESIGNED BY

S. HIRAOKA — P. S. & E. BY

692-7581 — PHONE

DEC. 1999 — DATE