FED. ROAD DIST. NO.	STATE	PROJ. NO.	FISCAL YEAR	SHEET NO.	TOTAL SHEETS
HAWAII	HAW.	560A-03-96	2009	1	27

560

STATE OF HAWAII

DEPARTMENT OF TRANSPORTATION

HIGHWAYS DIVISION

HONOLULU, HAWAII

"AS-BUILT"

PLANS FOR

KUHIO HIGHWAY

RETAINING WALLS AT LUMAHAI AND WAINIHA

PROJECT NO. 560A-03-96

DISTRICT OF HANALEI

ISLAND OF KAUAI

INDEX TO DRAWINGS	
SHEET NO.	DESCRIPTION
1	TITLE SHEET
2	STANDARD PLANS SUMMARY
3	GENERAL NOTES & LEGEND
4 – 5	WATER POLLUTION & EROSION CONTROL NOTES
6 – 7 (1)	ROADWAY PLAN
8 – 9	BORING LOGS
10	BEST MANAGEMENT PRACTICES PLAN & DETAILS
11	STRUCTURAL NOTES
12 (2)	RETAINING WALL SECTIONS AND DETAILS
13 – 14	RETAINING WALL AND CONCRETE RAILING ELEVATIONS
15	METAL RAILING ELEVATION
16	RETAINING WALL AND METAL RAILING ELEVATIONS
17	W-BEAM RAILING DETAILS
18	T-6 RAILING DETAILS
19	T-6 RAILING AND SCUPPER DETAILS
20	W-BEAM TO CONCRETE RAILING CONNECTION DETAILS
21	MODIFIED TYPE "G" TERMINAL END
22	PAVEMENT MARKING LEGEND, DETAILS & NOTES
23	TRAFFIC CONTROL NOTES
24 – 26 (3)	TRAFFIC CONTROL PLAN
27	LOW SPEED UNDIVIDED HIGHWAY WORK ZONE SIGNING PLAN

Sheet Nos. (1) C.0.7S-1 and C.0.7S-2; (2) C.0.12S-1, C.0.12S-2 and C.0.12S-3; (3) C.0.26S-1 are Supplementary Sheets to this Project. Total Sheet Count after "AS-BUILT" Posting 33 Sheets.

PROJECT LOCATION

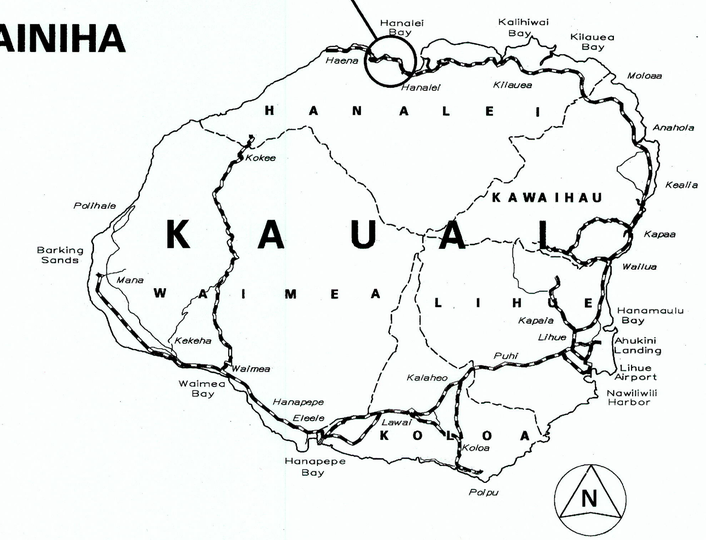

4 0 4 8

SCALE IN MILES

FEDERAL AID PROJECTS PREVIOUSLY CONSTRUCTED OR UNDER CONSTRUCTION

MILE POST 5.00 TO MILE POST 5.16

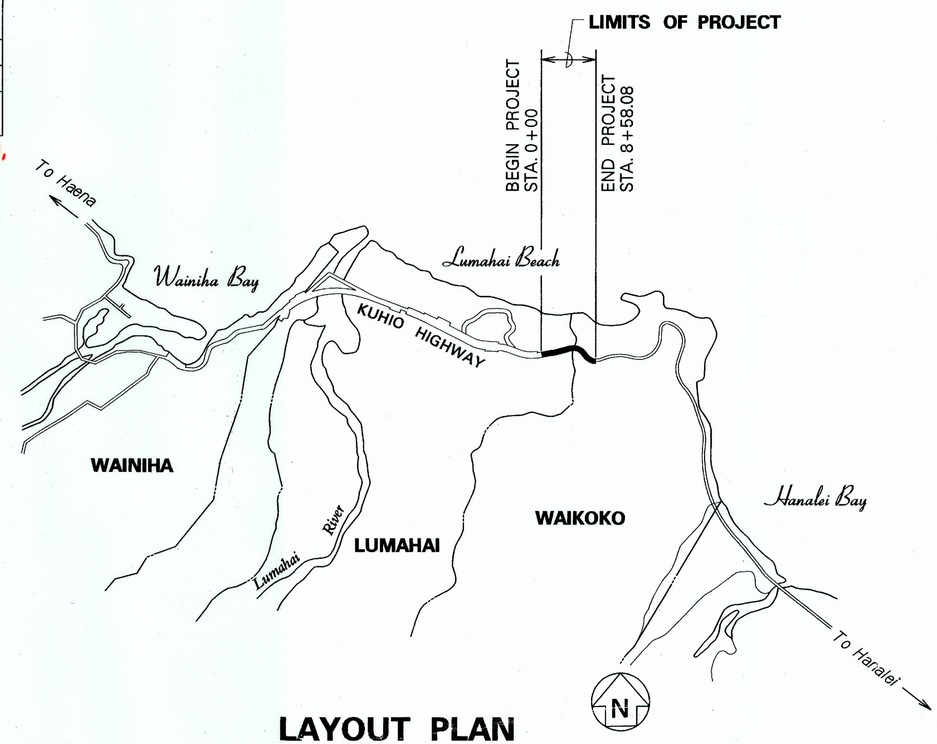

1 0 1 2 3

SCALE IN THOUSAND FEET

LAYOUT PLAN

GROSS LENGTH OF PROJECT.....0.16 MILES

NET LENGTH OF PROJECT.....0.16 MILES

CHANGES MADE DURING CONSTRUCTION HAVE BEEN INCORPORATED ON THESE PLANS EXCEPT CHANGES IN THE ORIGINAL THEORETICAL QUANTITIES. FOR ACTUAL QUANTITIES, REFER TO PROJECT LEDGER AND/OR COMPUTATION BOOK.

RESIDENT ENGINEER — DATE 7-15-11

DEPARTMENT OF TRANSPORTATION
STATE OF HAWAII

APPROVED:

DIR. OF TRANSPORTATION — DATE 4-30-09

NISHIMURA, KATAYAMA & OKI, INC.	DESIGNED BY
HWY-KE	MANAGED BY
241-3000	PHONE
APR. 2009	DATE