


FINAL SURVEY			
NOTE BOOK			
NO. _____			
AREAS CHECKED			
SURVEYED		BY	DATE
PLOTTED			
TEMPLATE			
AREAS			


ORIGINAL SURVEY			
NOTE BOOK			
NO. _____			
AREAS CHECKED			
SURVEYED		BY	DATE
PLOTTED			
TEMPLATE			
AREAS			

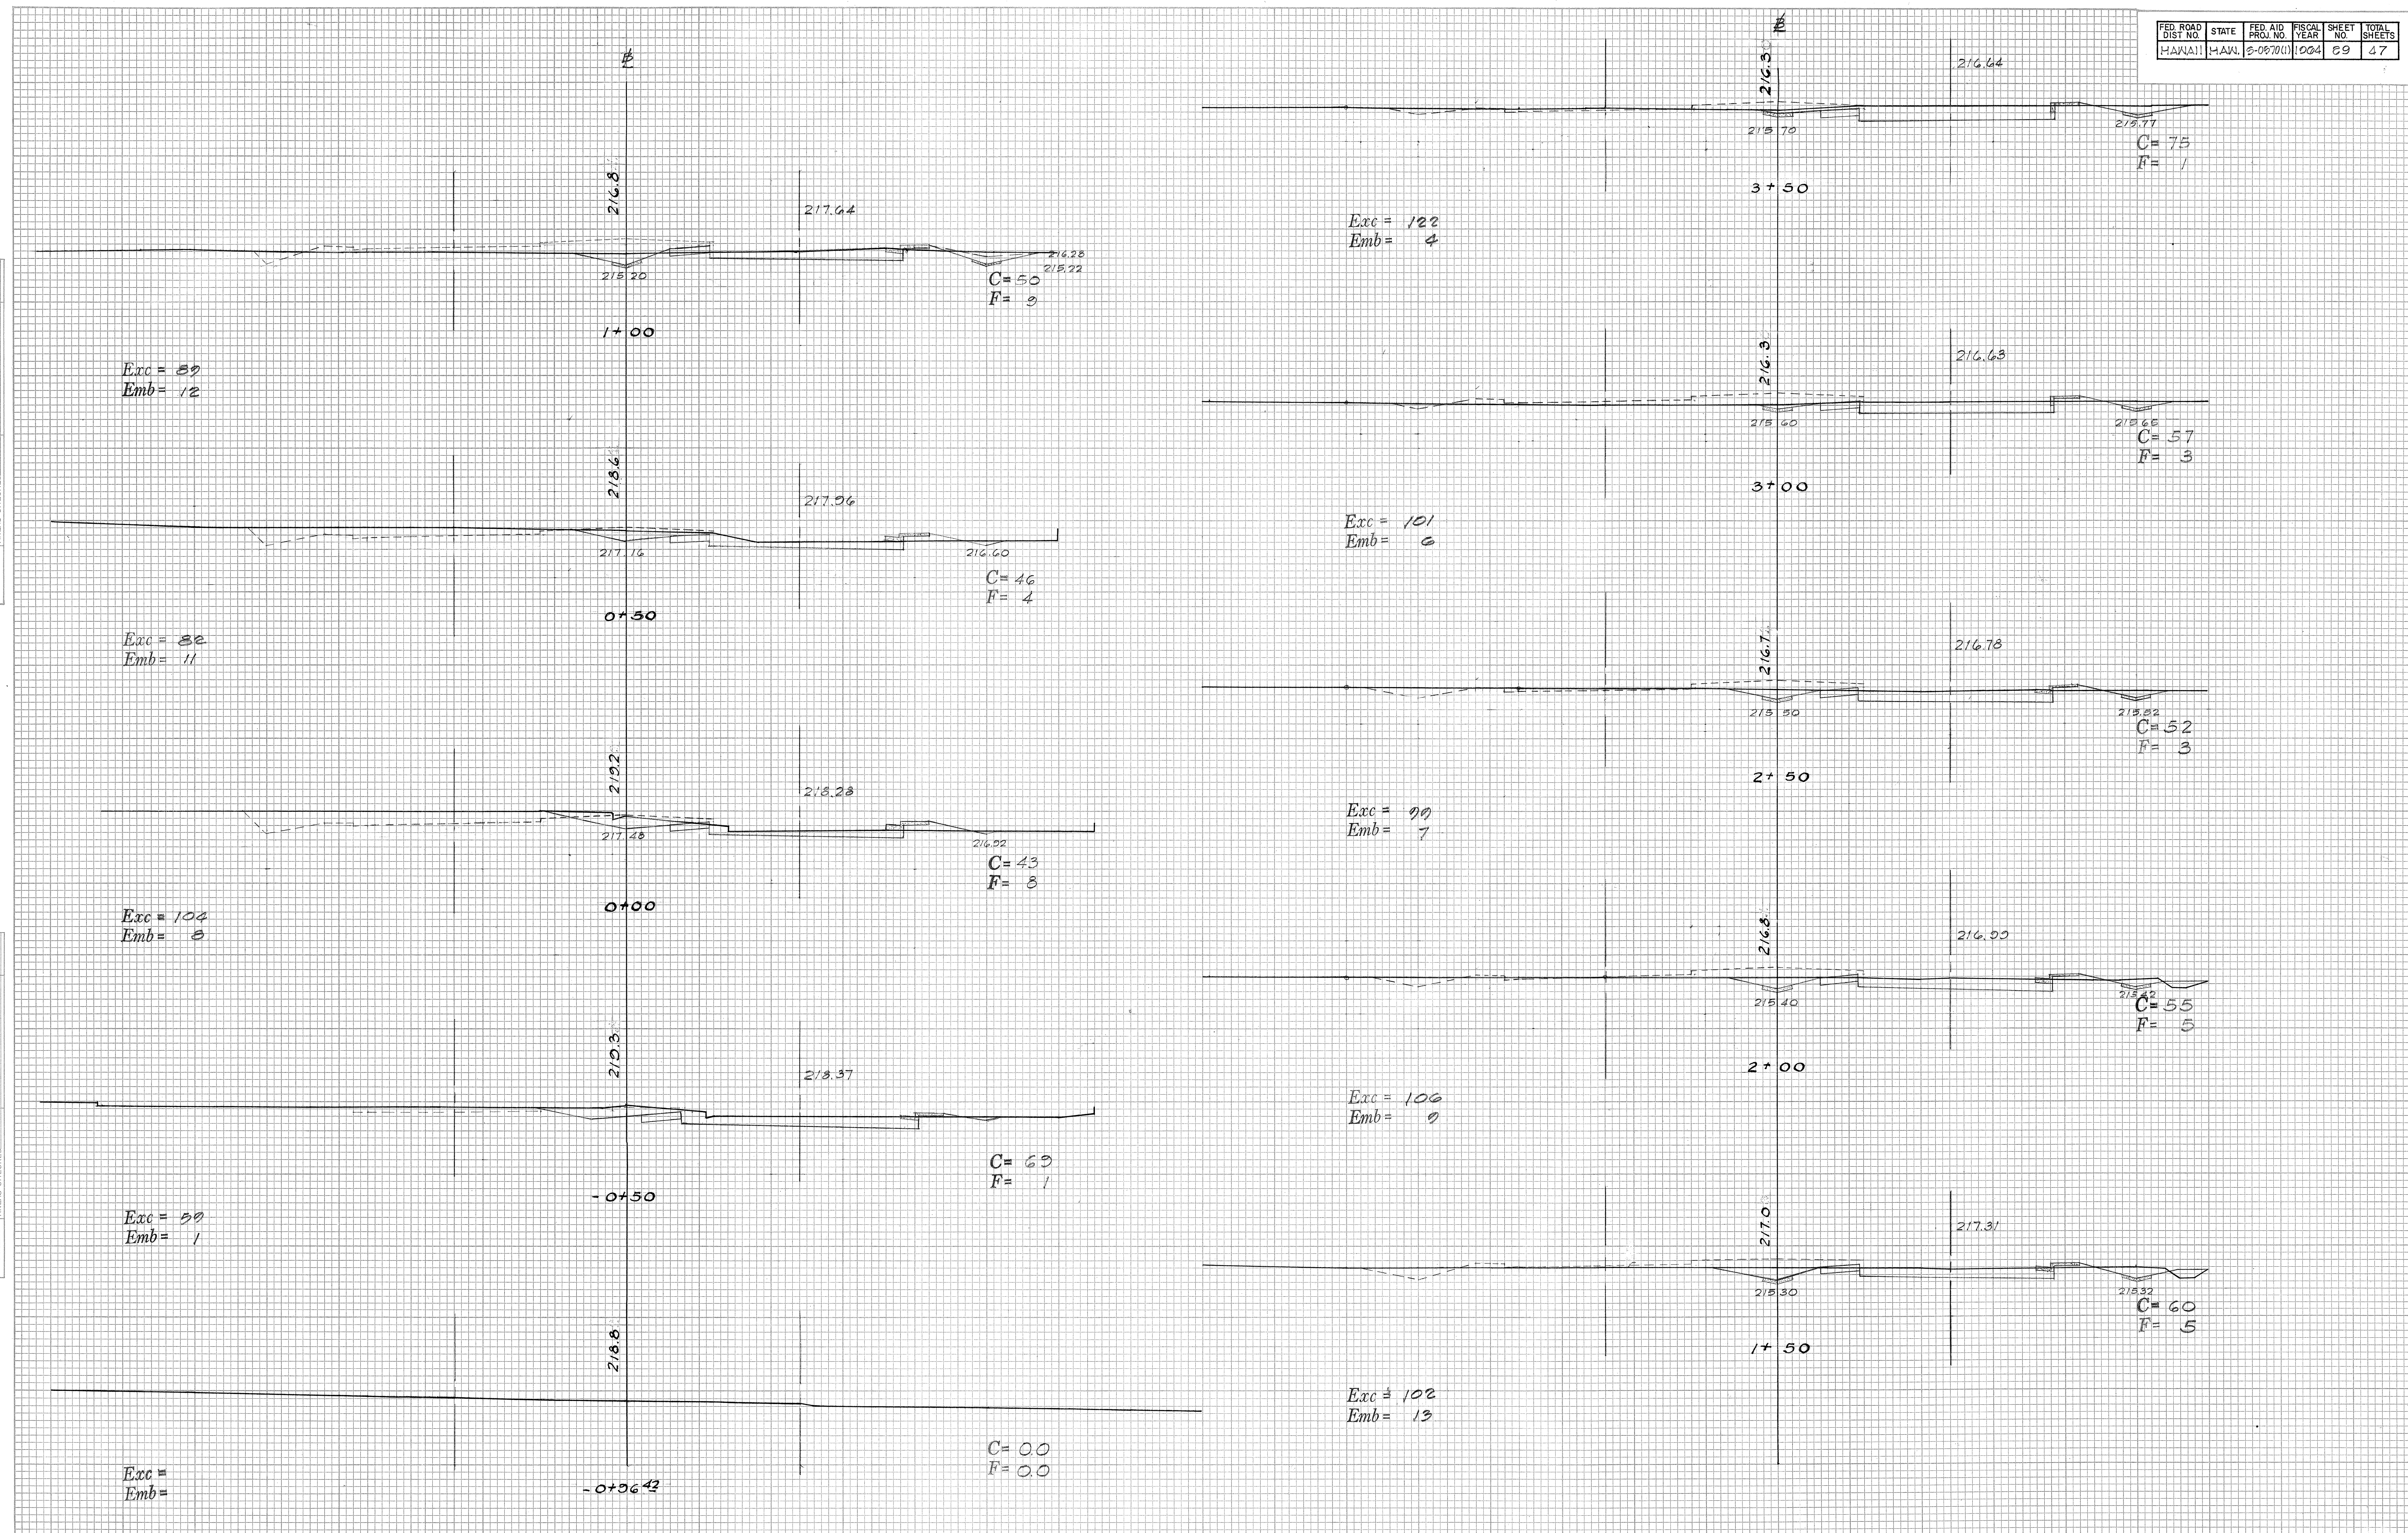

FED. ROAD DIST. NO.	STATE	FED. AID PROJ. NO.	FISCAL YEAR	SHEET NO.	TOTAL SHEETS
HAWAII	HAW.	8-0070(1)	1964	30	47


FINAL SURVEY	SURVEYED	DATE
NOTE BOOK	PLOTTED	BY
NO.	TEMPLATE	
	AREAS CHECKED	

ORIGINAL SURVEY	SURVEYED	DATE
NOTE BOOK	PLOTTED	BY
NO.	TEMPLATE	
	AREAS CHECKED	

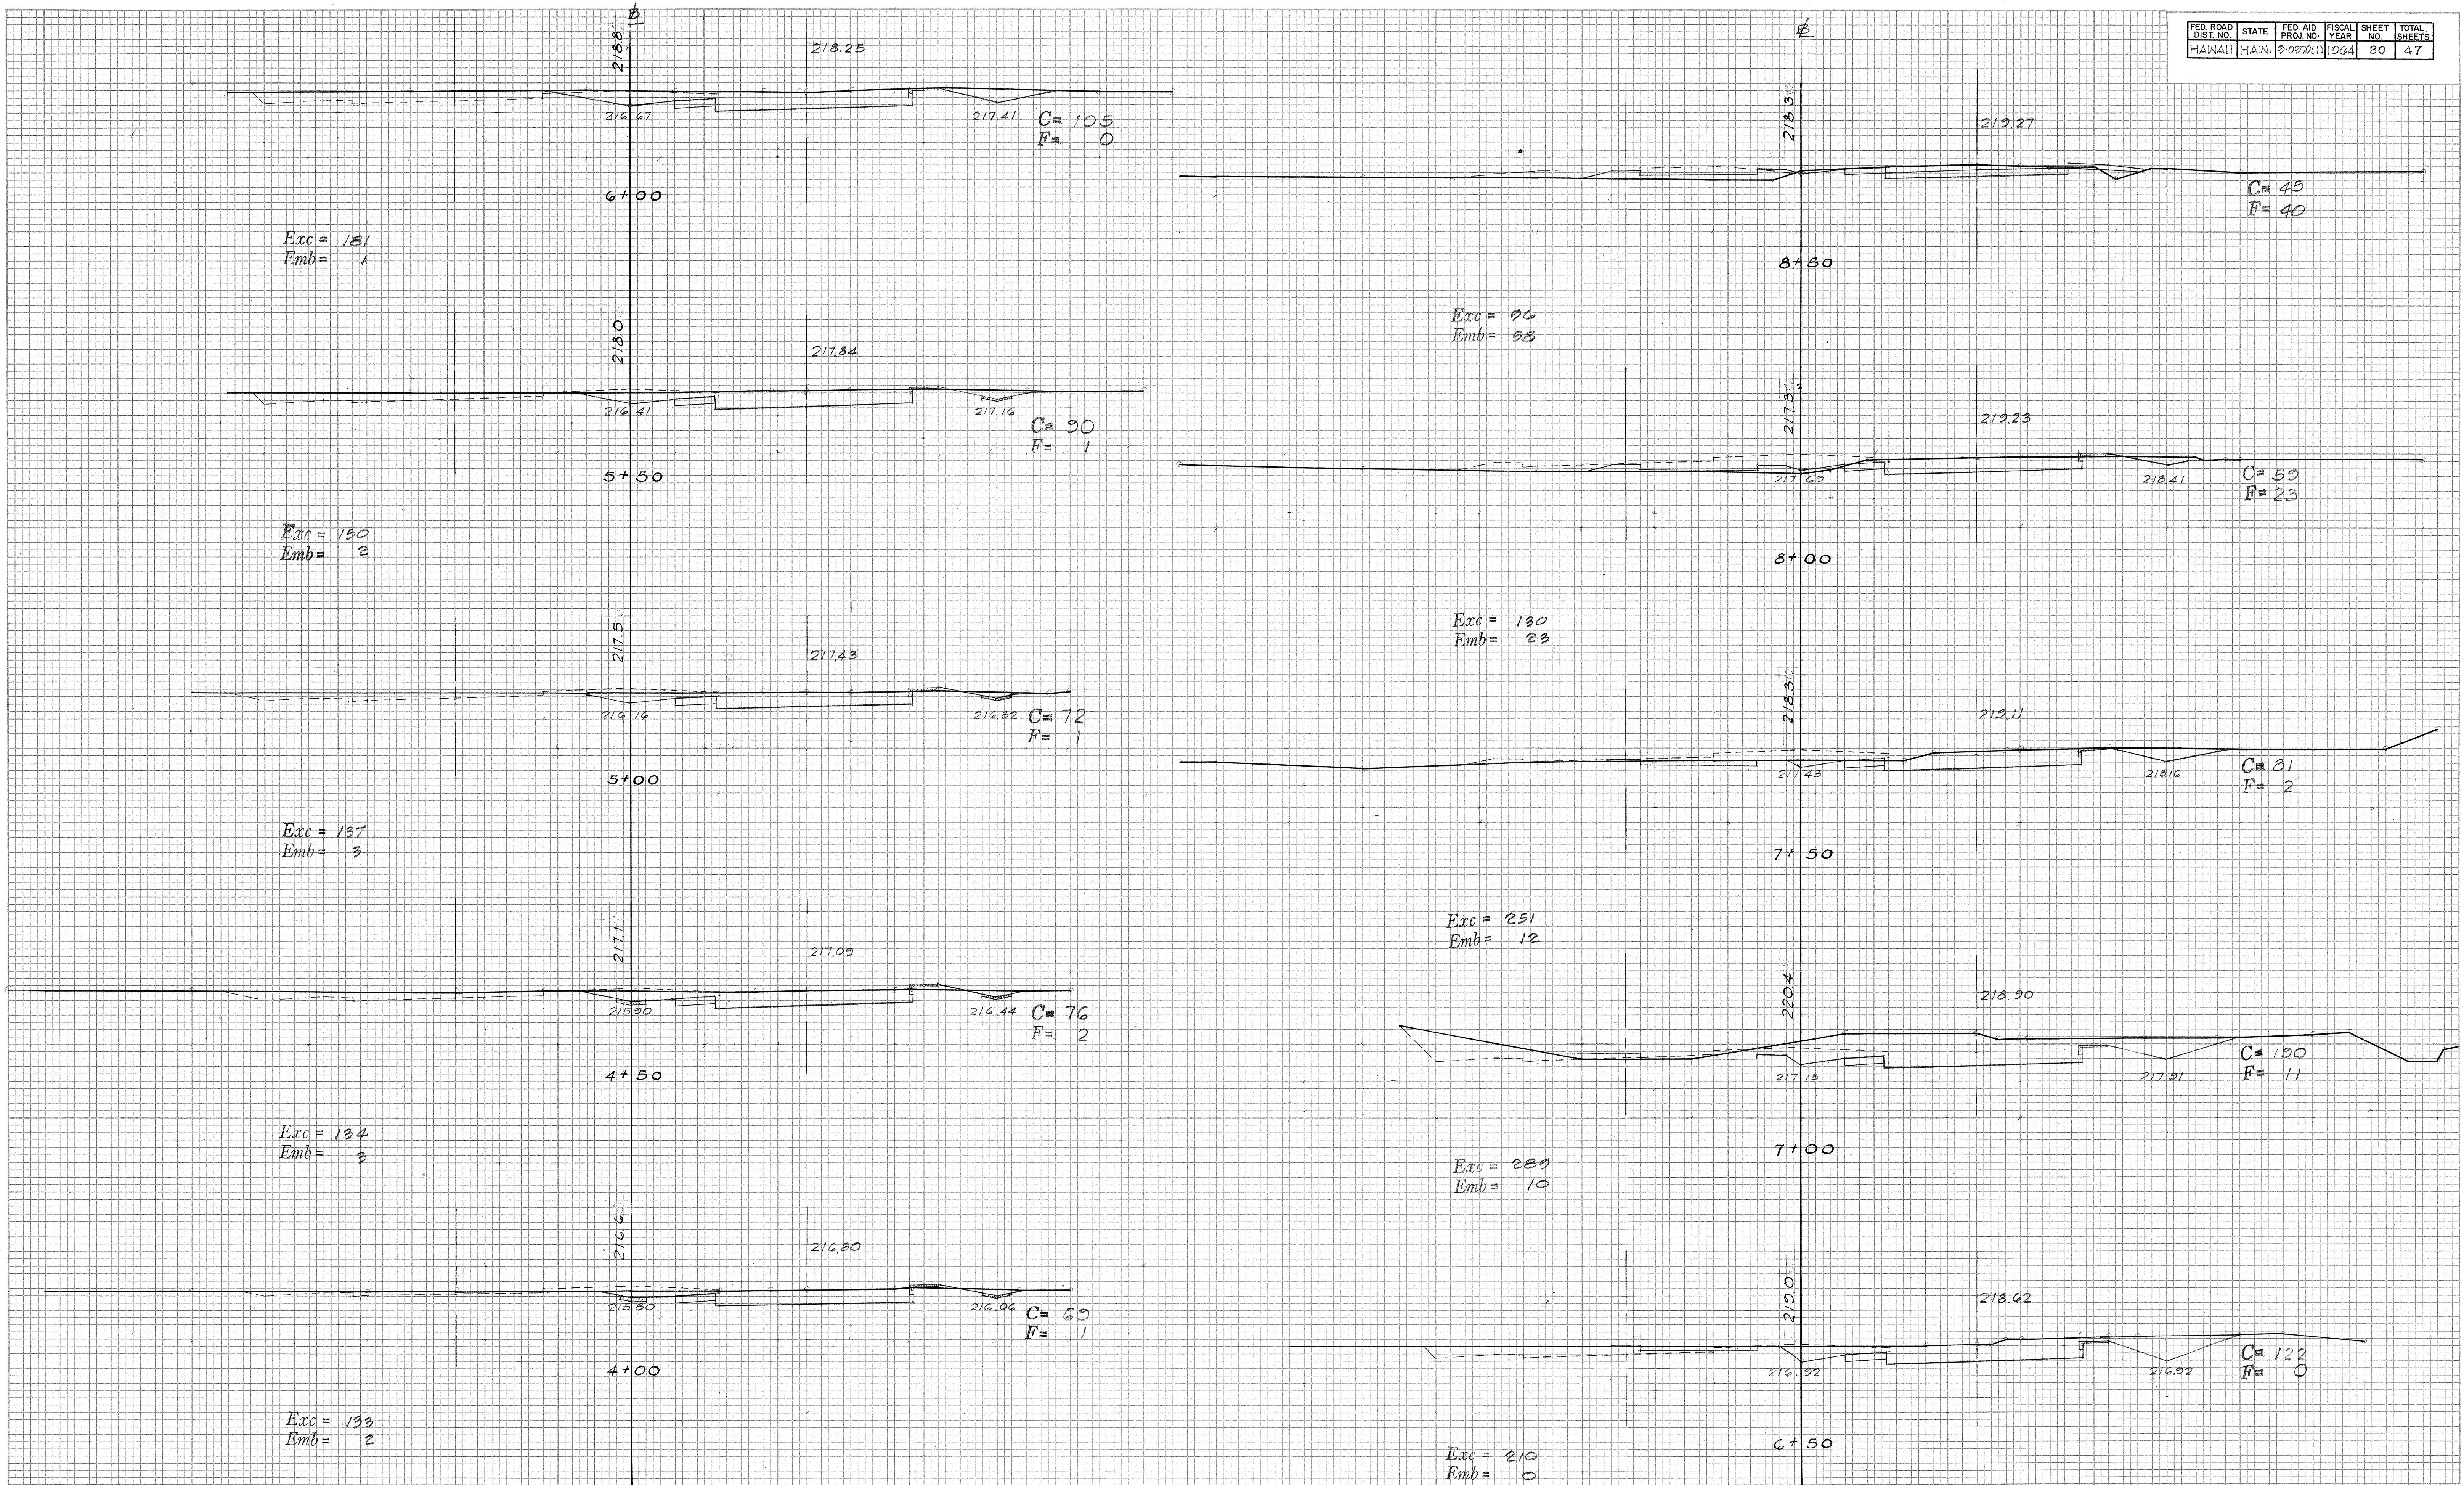

FINAL SURVEY	SURVEYED	DATE
NOTE BOOK	PLOTTED	BY
NO.	TEMP.	
	AREAS CHECKED	


ORIGINAL SURVEY	SURVEYED	DATE
NOTE BOOK	PLOTTED	BY
NO.	TEMP.	
	AREAS CHECKED	

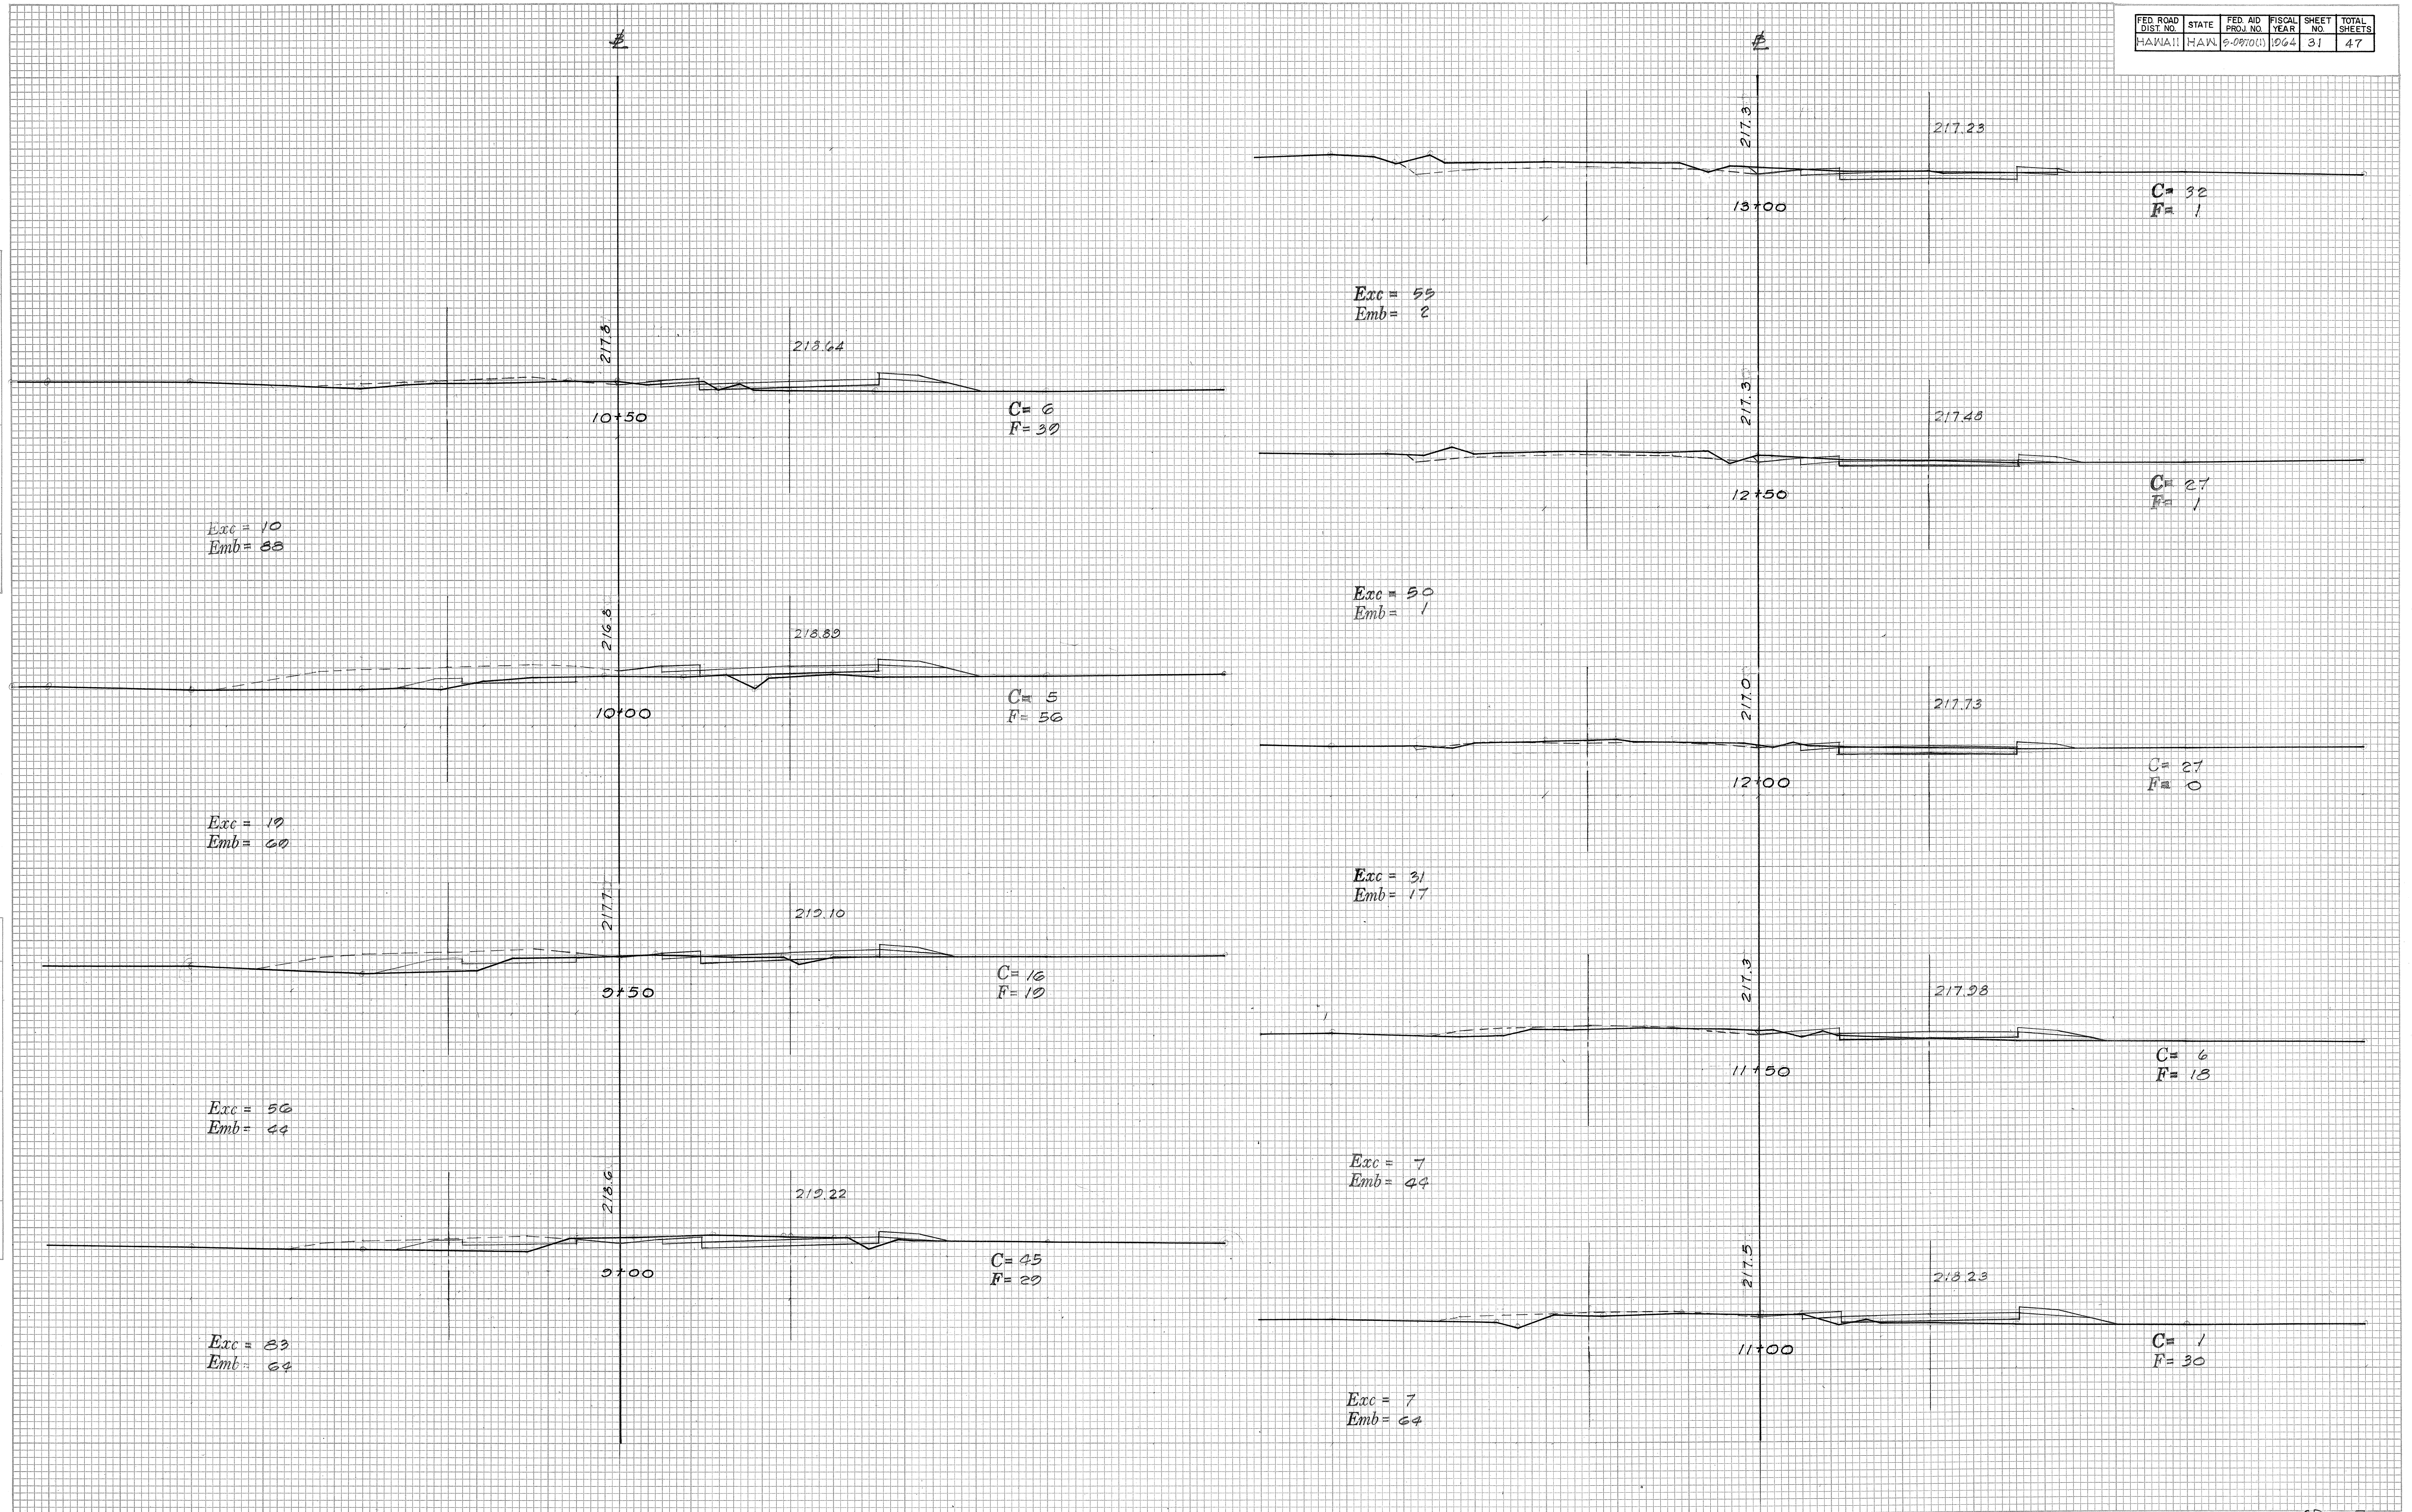

FED. ROAD DIST. NO.	STATE	FED. AID PROJ. NO.	FISCAL YEAR	SHEET NO.	TOTAL SHEETS
HAWAII	HAW.	5-0870(1)	1964	32	47

FINAL SURVEY	DATE
SURVEYED	BY
PLOTTED	
NOTE BOOK	
AREAS CHECKED	
NO.	


ORIGINAL SURVEY	DATE
SURVEYED	BY
PLOTTED	
NOTE BOOK	
AREAS CHECKED	
NO.	

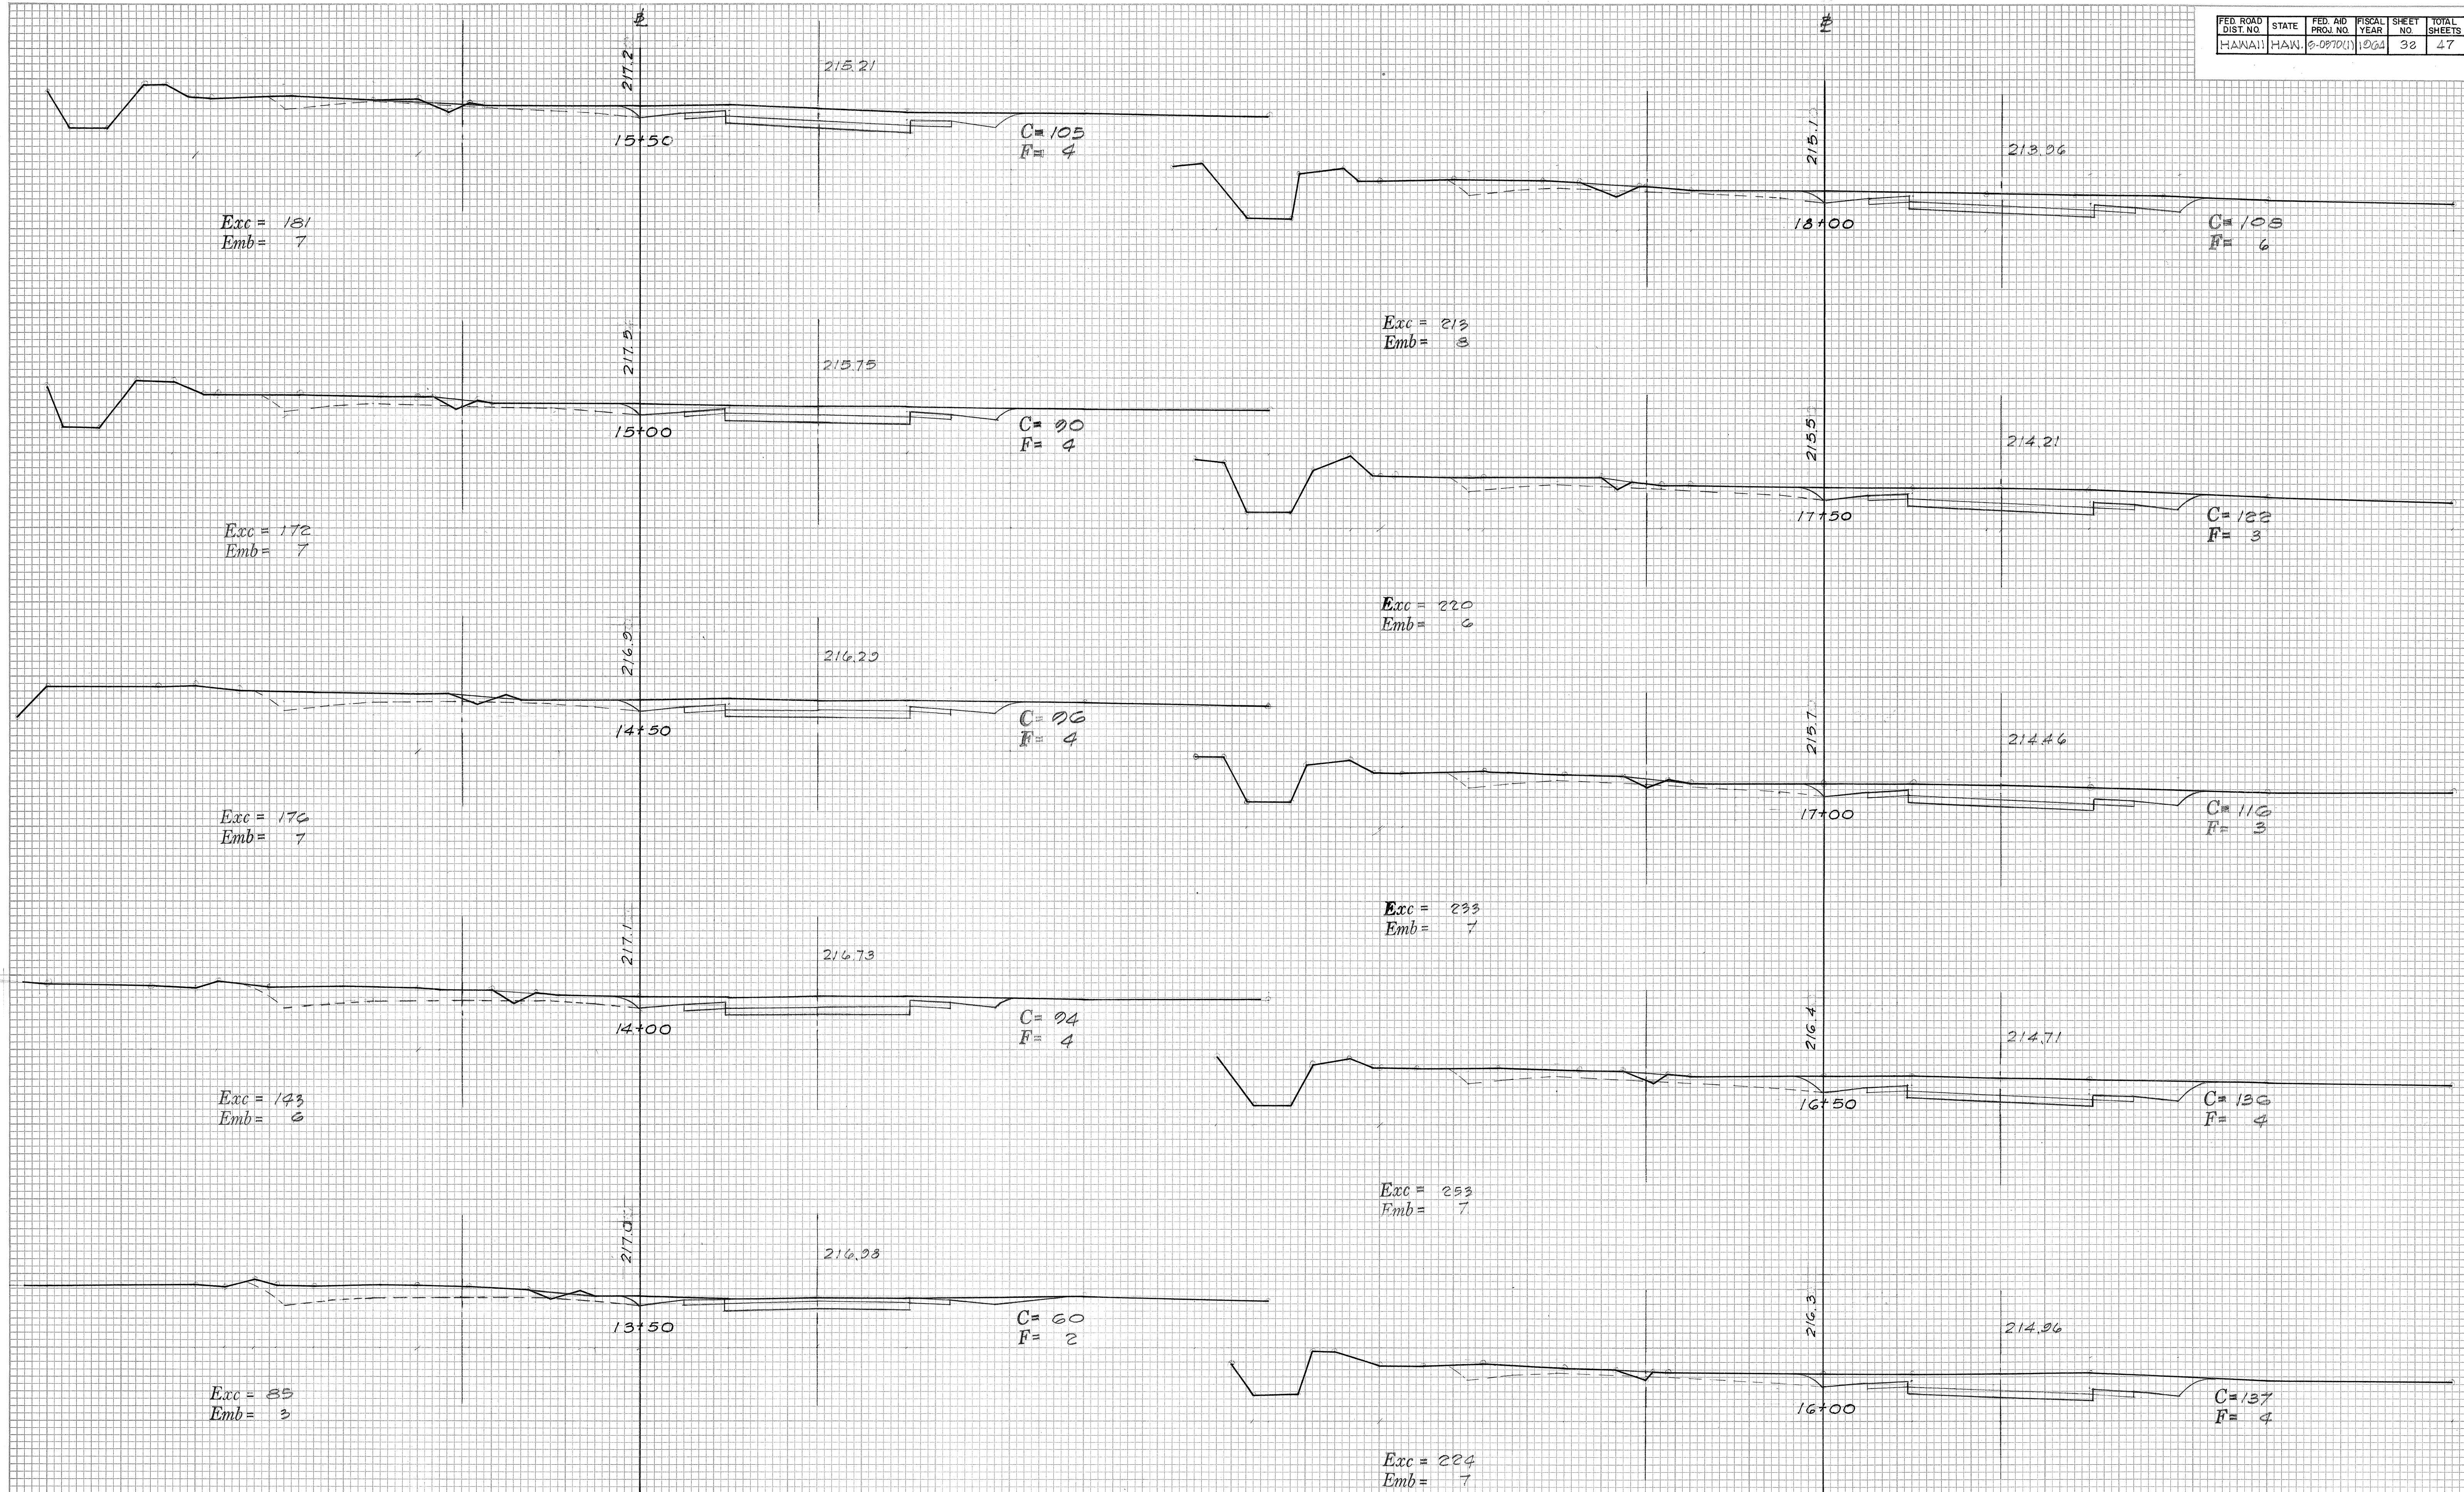

FINAL	SURVEY	DATE
NO.	NO.	BY
NO.	NO.	DATE
NO.	NO.	DATE

ORIGINAL	SURVEY	DATE
NO.	NO.	BY
NO.	NO.	DATE
NO.	NO.	DATE

FED. ROAD DIST. NO.	STATE	FED. AID PROJ. NO.	FISCAL YEAR	SHEET NO.	TOTAL SHEETS
HAWAII	HAW.	8-00700	1964	33	47

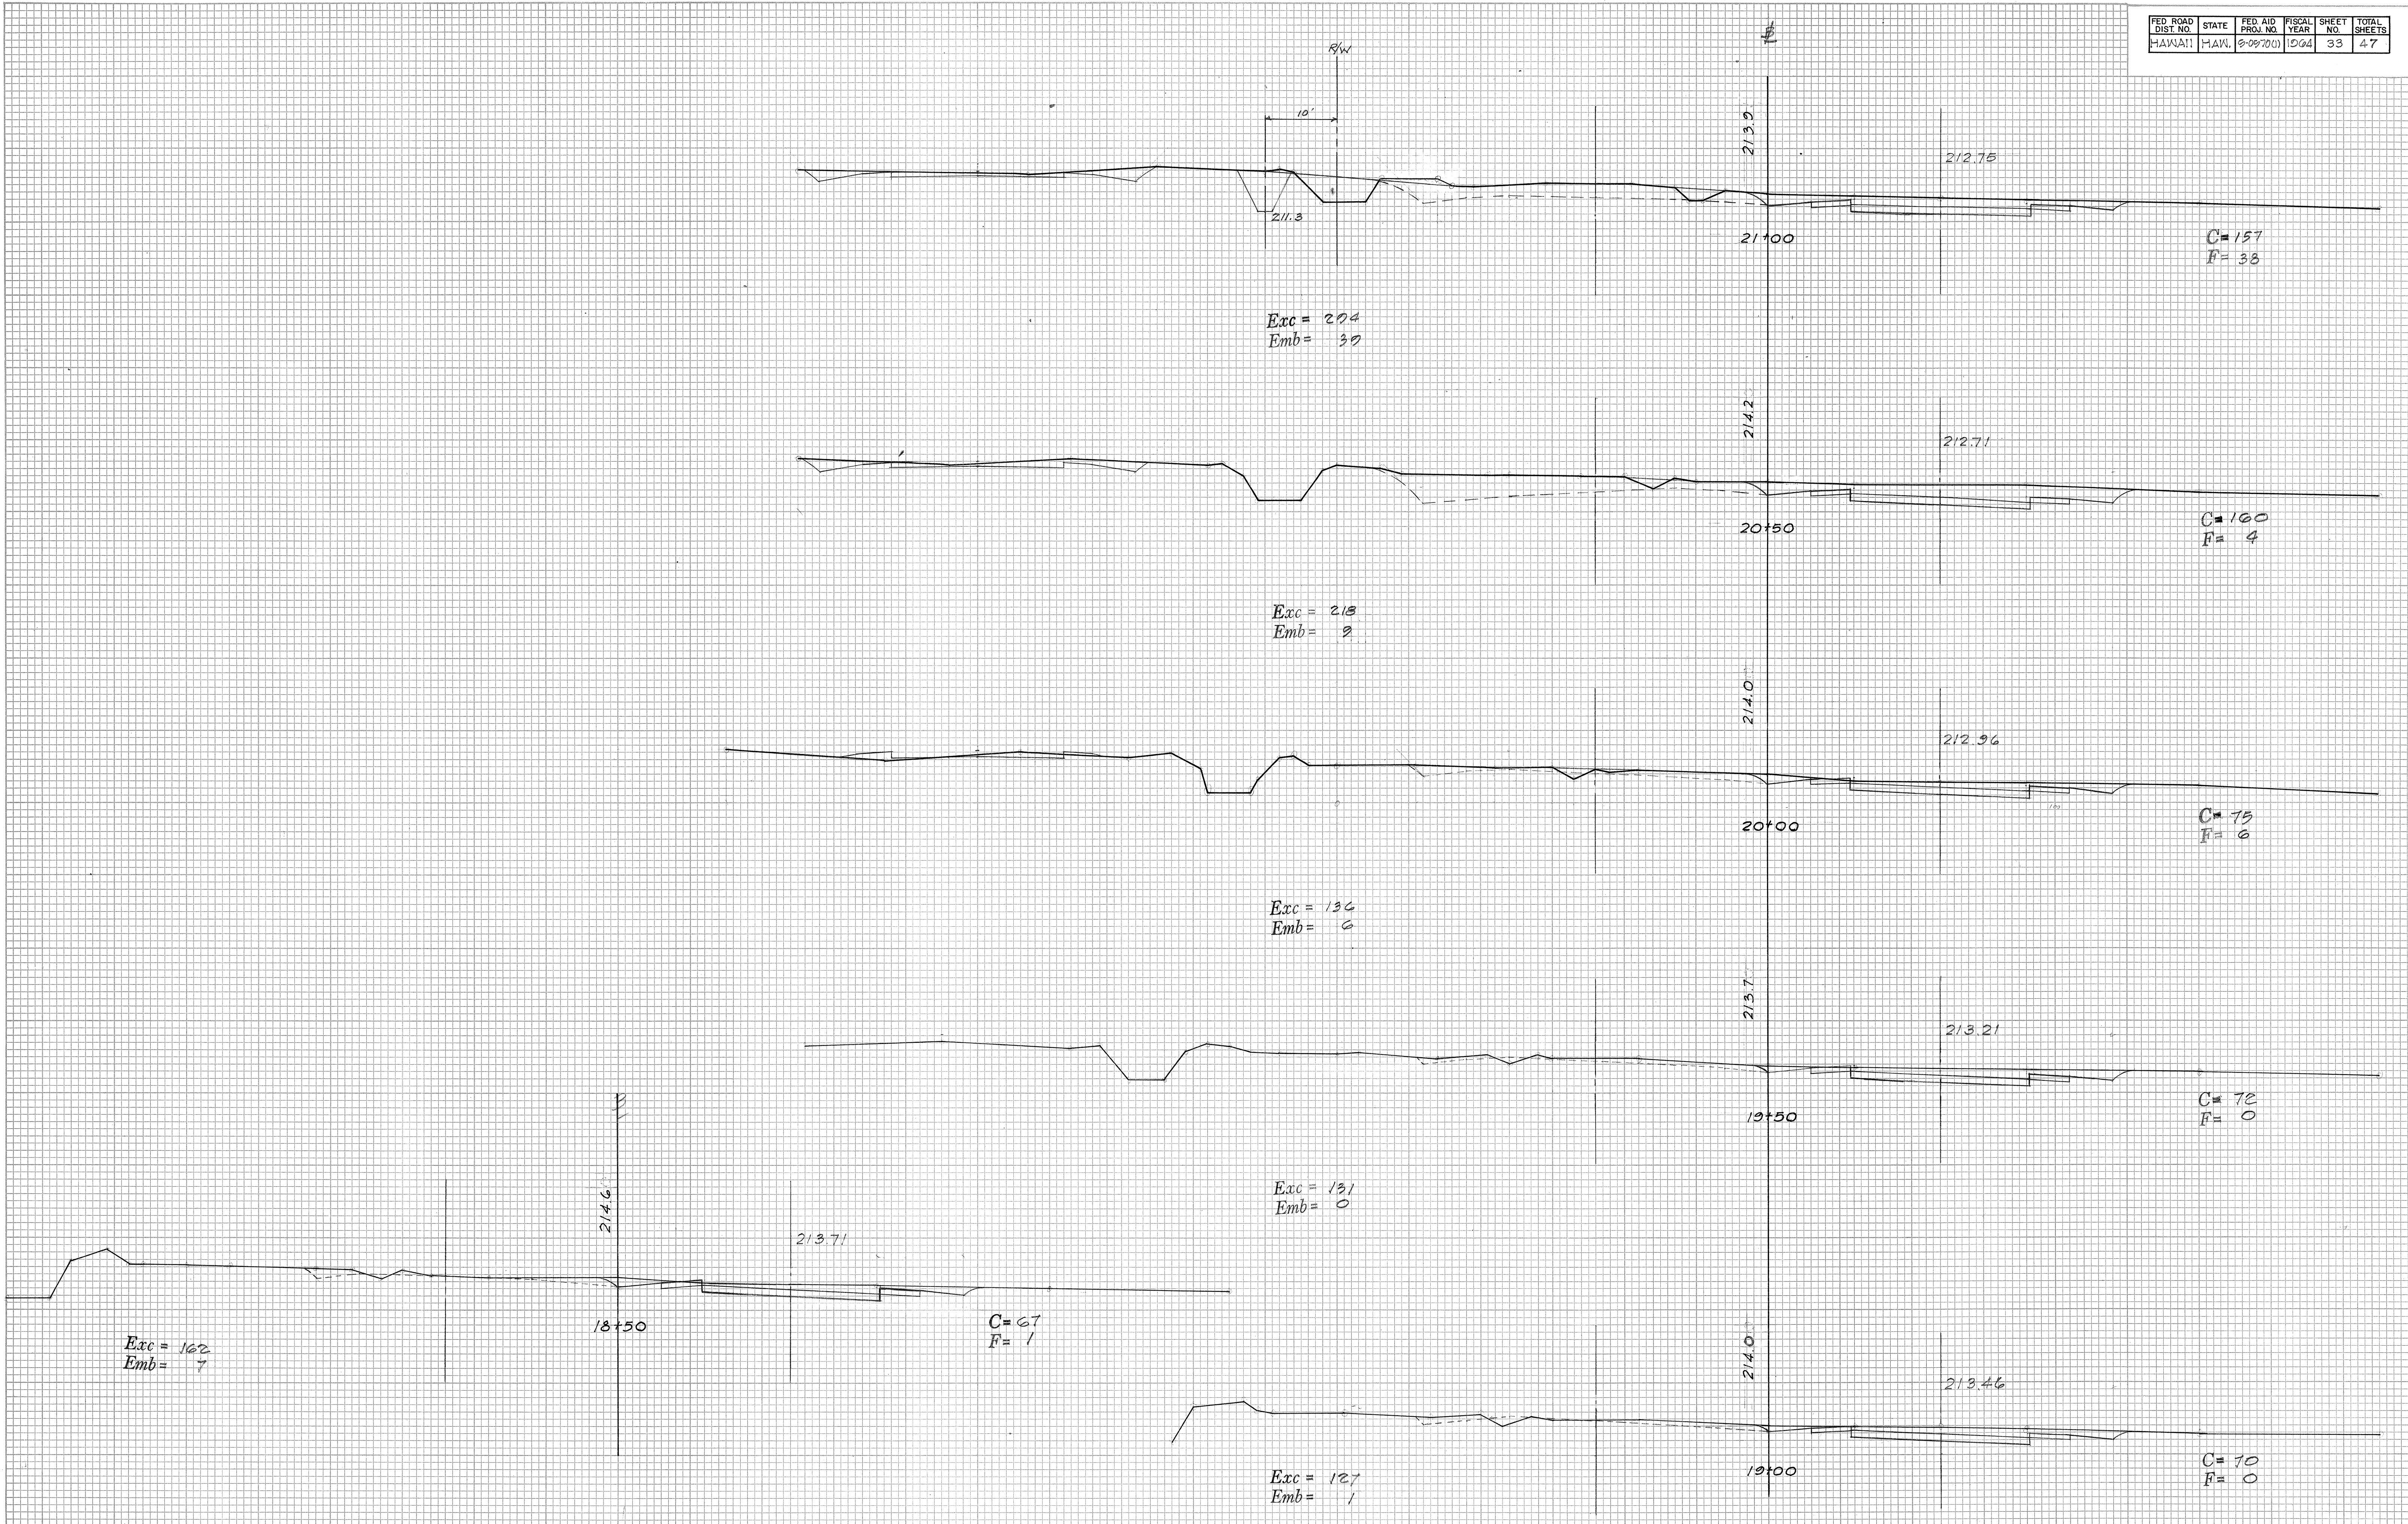

FED. ROAD DIST. NO.	STATE	FED. AID PROJ. NO.	FISCAL YEAR	SHEET NO.	TOTAL SHEETS
1-A-111	HAW.	8-0870(1)	1964	34	47

FINAL SURVEY	DATE
SURVEYED	BY
PLOTTED	
NOTE BOOK	
AREAS	
CHECKED	
NO.	

ORIGINAL SURVEY	DATE
SURVEYED	BY
PLOTTED	
NOTE BOOK	
AREAS	
CHECKED	
NO.	



FED. ROAD DIST. NO.	STATE	FED. AID PROJ. NO.	FISCAL YEAR	SHEET NO.	TOTAL SHEETS
HAWAII	HAWAII	2-08700	1964	35	47




FINAL SURVEY
 DATE _____
 BY _____
 NO. _____
 AREAS CHECKED _____

ORIGINAL SURVEY
 DATE _____
 BY _____
 NO. _____
 AREAS CHECKED _____

FED. ROAD DIST. NO.	STATE	FED. AID PROJ. NO.	FISCAL YEAR	SHEET NO.	TOTAL SHEETS
HAWAII	HAW.	5-0570(1)	1964	36	47

FINAL					
SURVEY				BY	DATE
PLOTTED					
TEMPLATE					
AREAS					
NO. _____					
AREAS CHECKED					


ORIGINAL SURVEY	SURVEYED	BY	DATE
	PLOTTED		
NOTE BOOK	TEMPLATE		
	AREAS		
NO.	AREAS CHECKED		

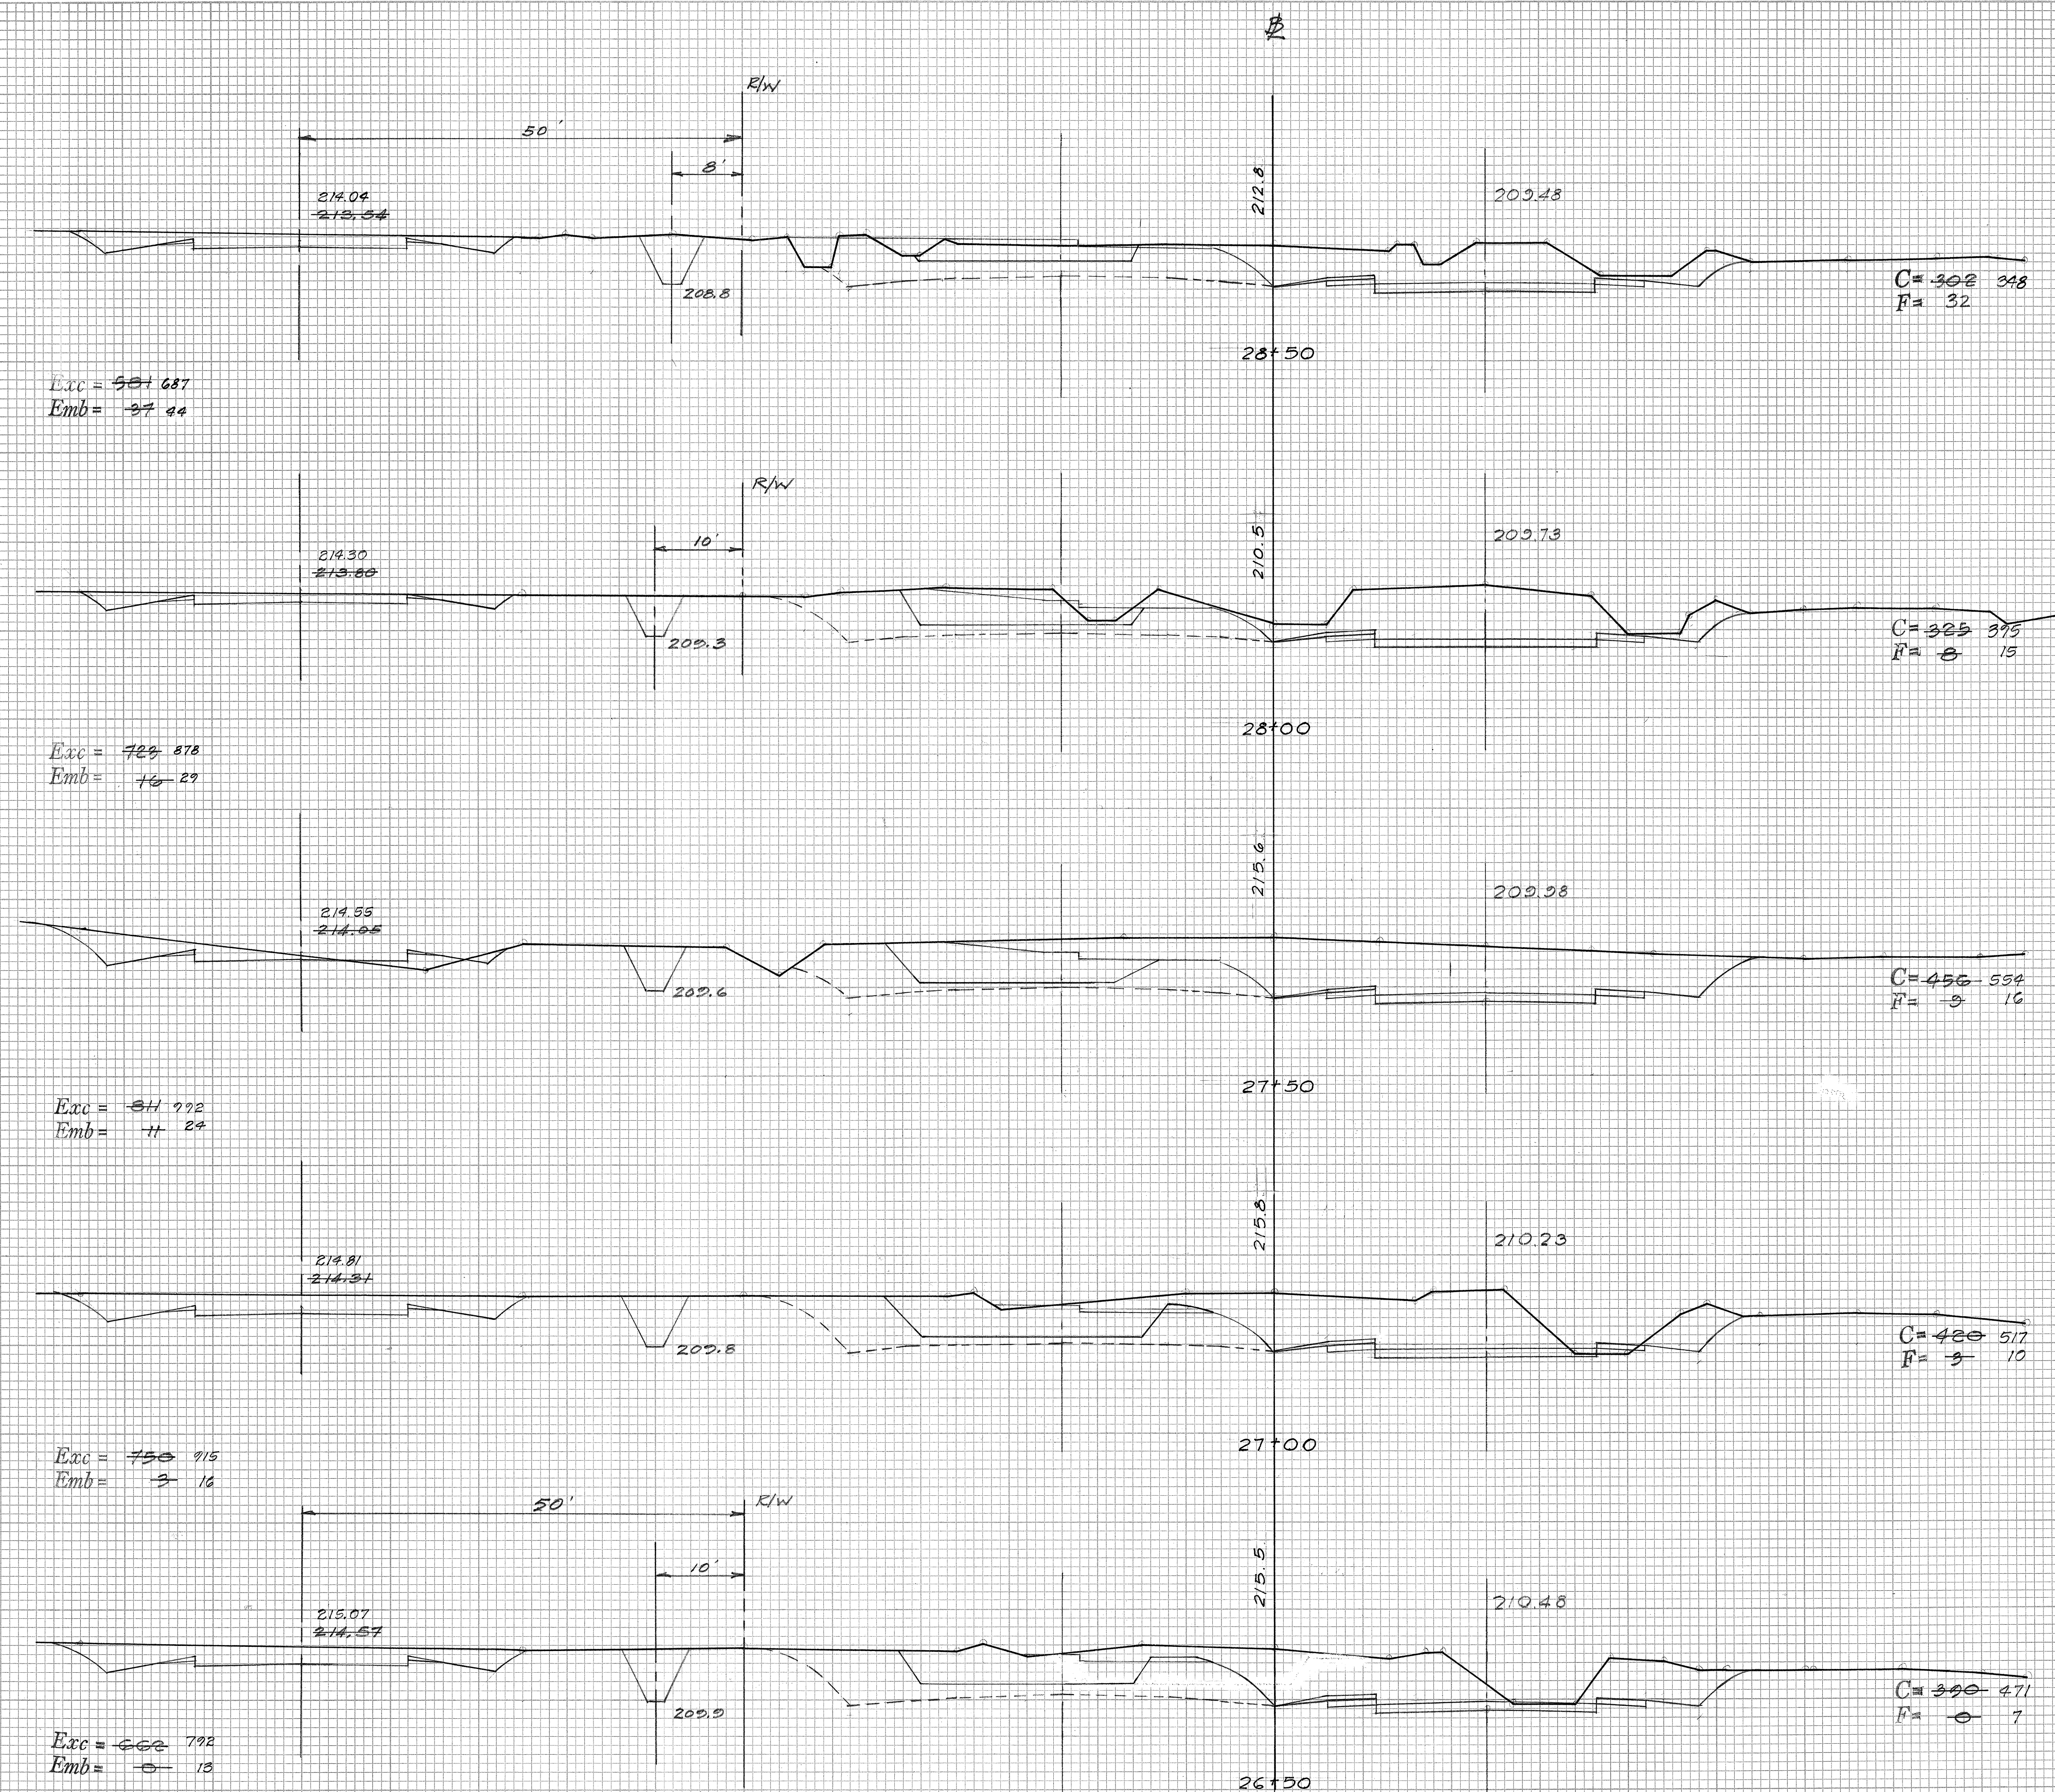

FED. ROAD DIST. NO.	STATE	FED. AID PROJ. NO.	FISCAL YEAR	SHEET NO.	TOTAL SHEETS
HAWAII	HAW.	9-0970(1)	1964	97	47


FINAL SURVEY	SURVEYED _____	BY _____	DATE _____
NOTE BOOK	PLOTTED _____		
	TEMPERATURE _____		
	AREAS _____		
	AREAS CHECKED _____		
NO. _____			

ORIGINAL			
SURVEY	SURVEYED	BY	DATE
	PLOTTED		
	TEMPLATE		
	AREAS		
NO.	AREAS CHECKED		
	NO.		

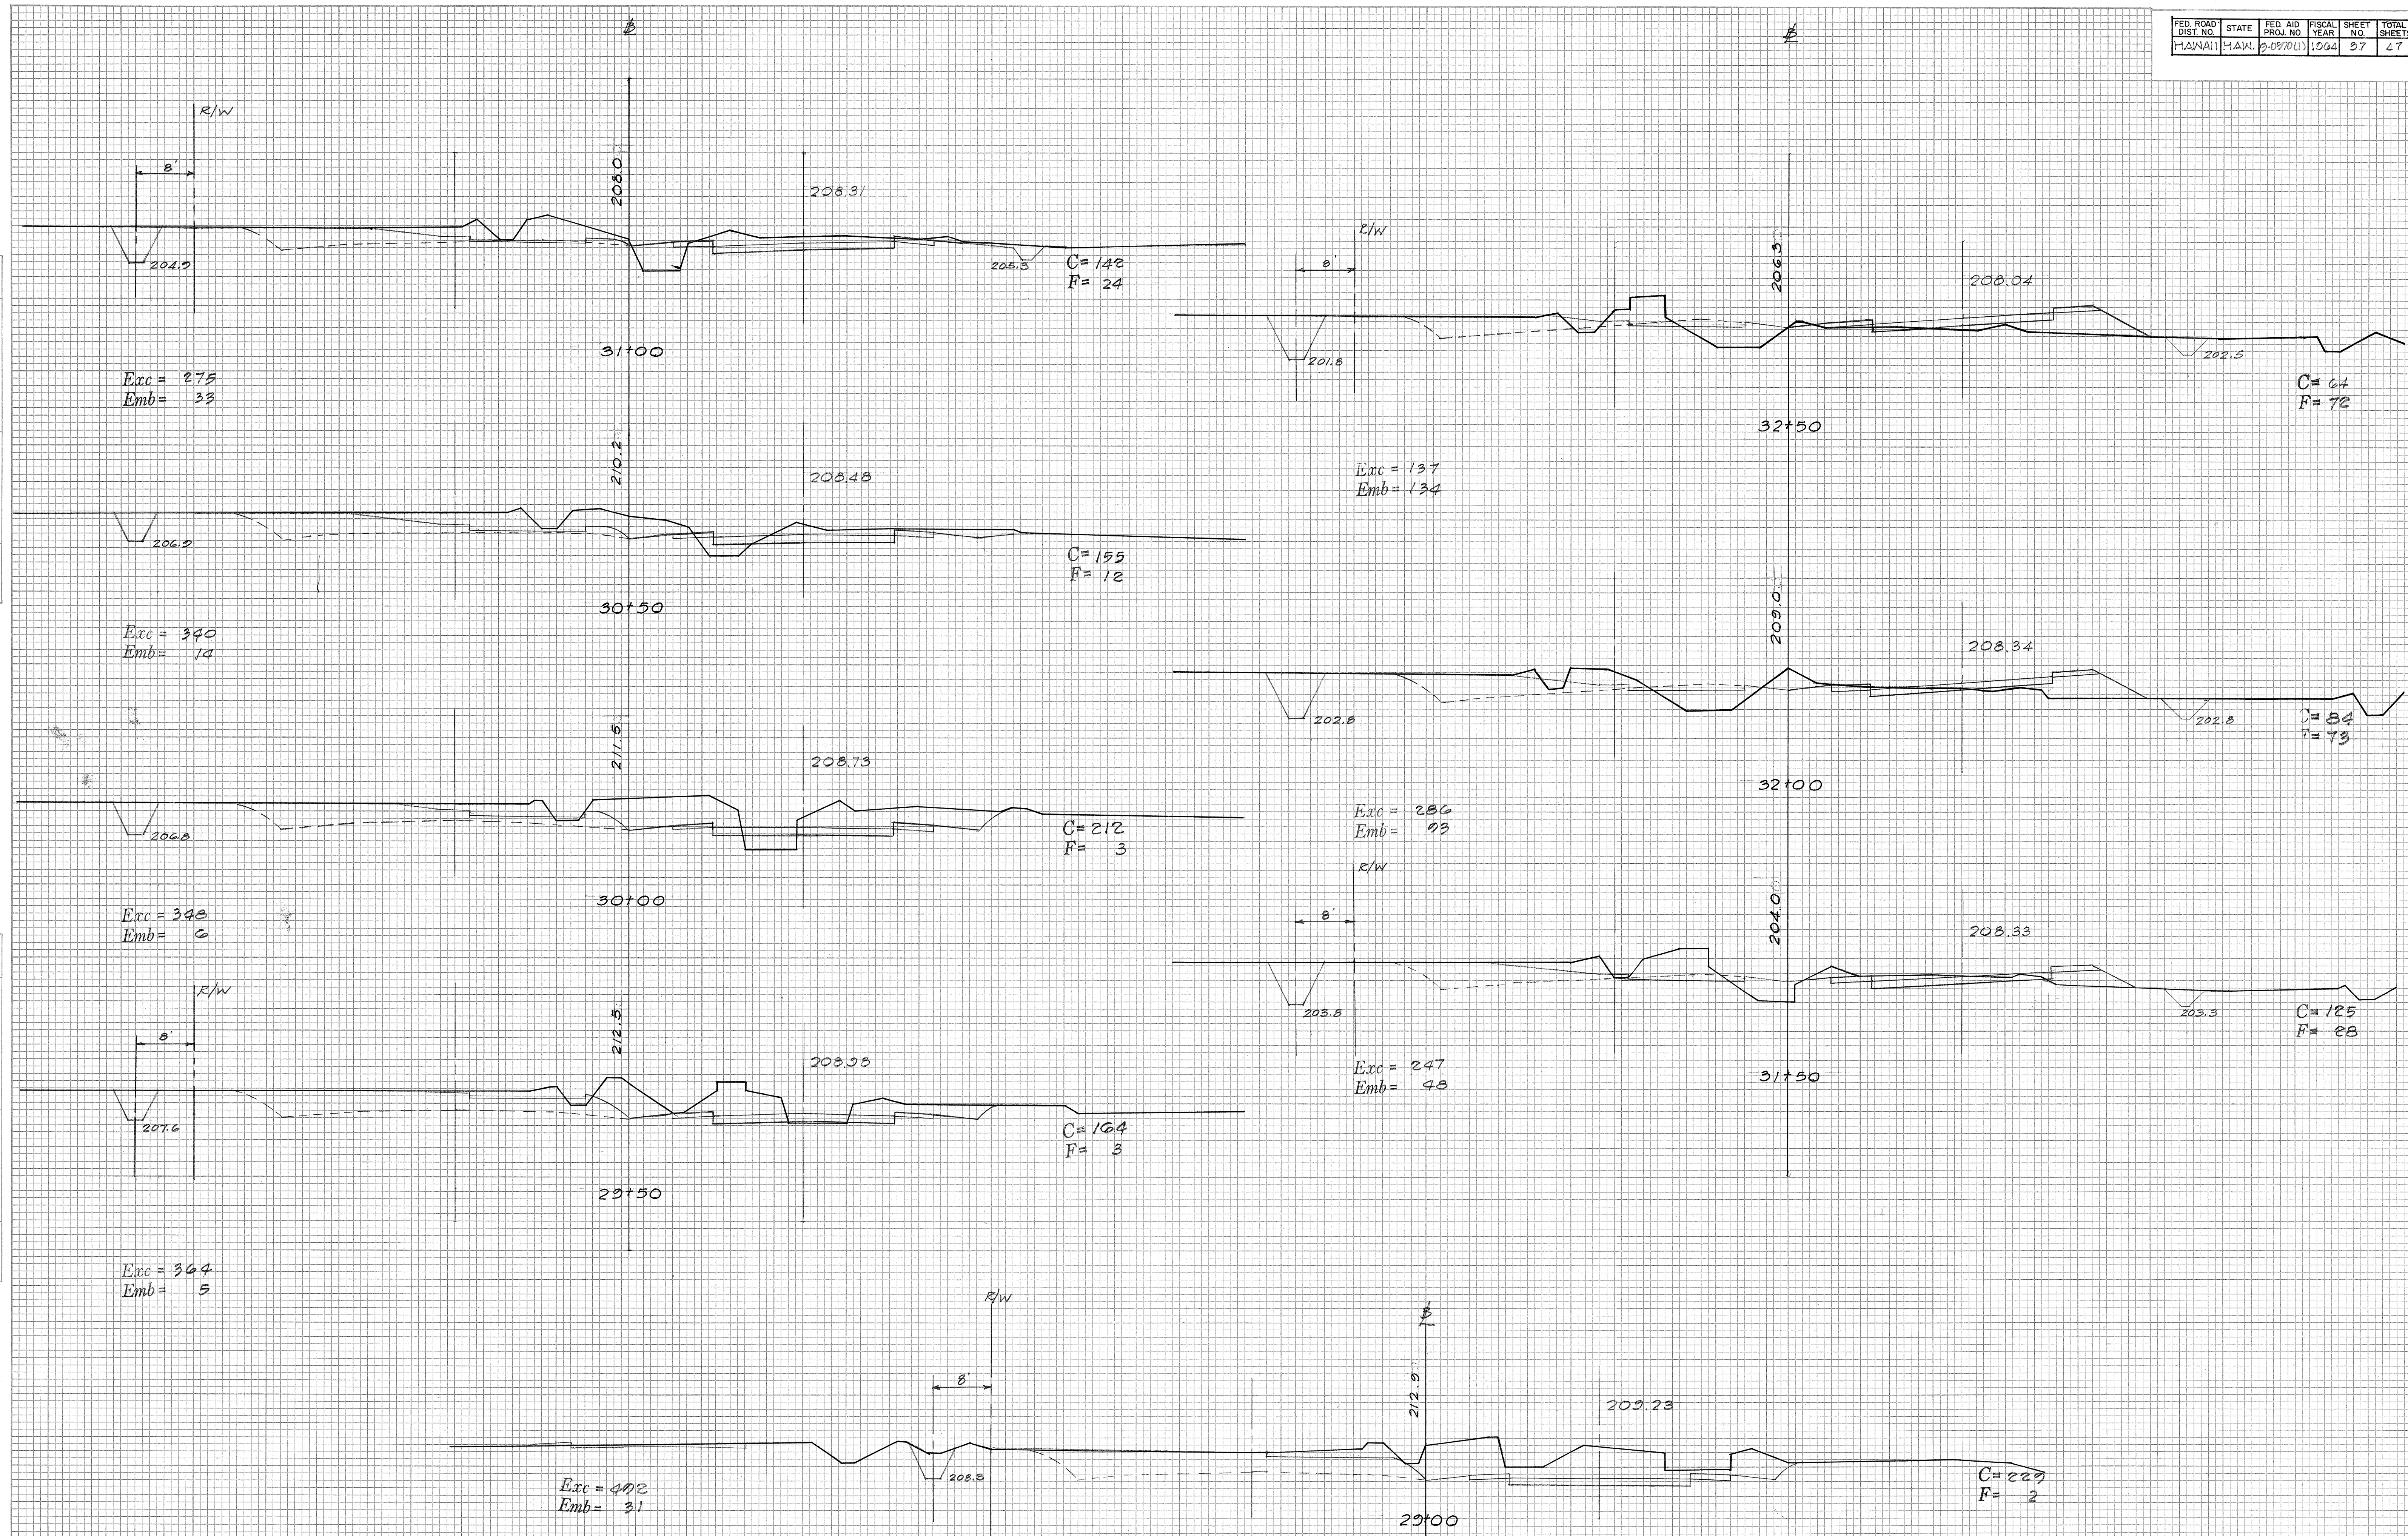

FINAL SURVEY		BY _____	DATE _____
NOTE BOOK	SURVEYED PLOTTED		
NO.	TEMPLATE AREAS		
	AREAS CHECKED		


ORIGINAL SURVEY	SURVEYED _____	BY _____	DATE _____
NOTE BOOK	PLOTTED _____		
NO. _____	TEMPLATE _____		
	AREAS _____		
	AREAS CHECKED _____		

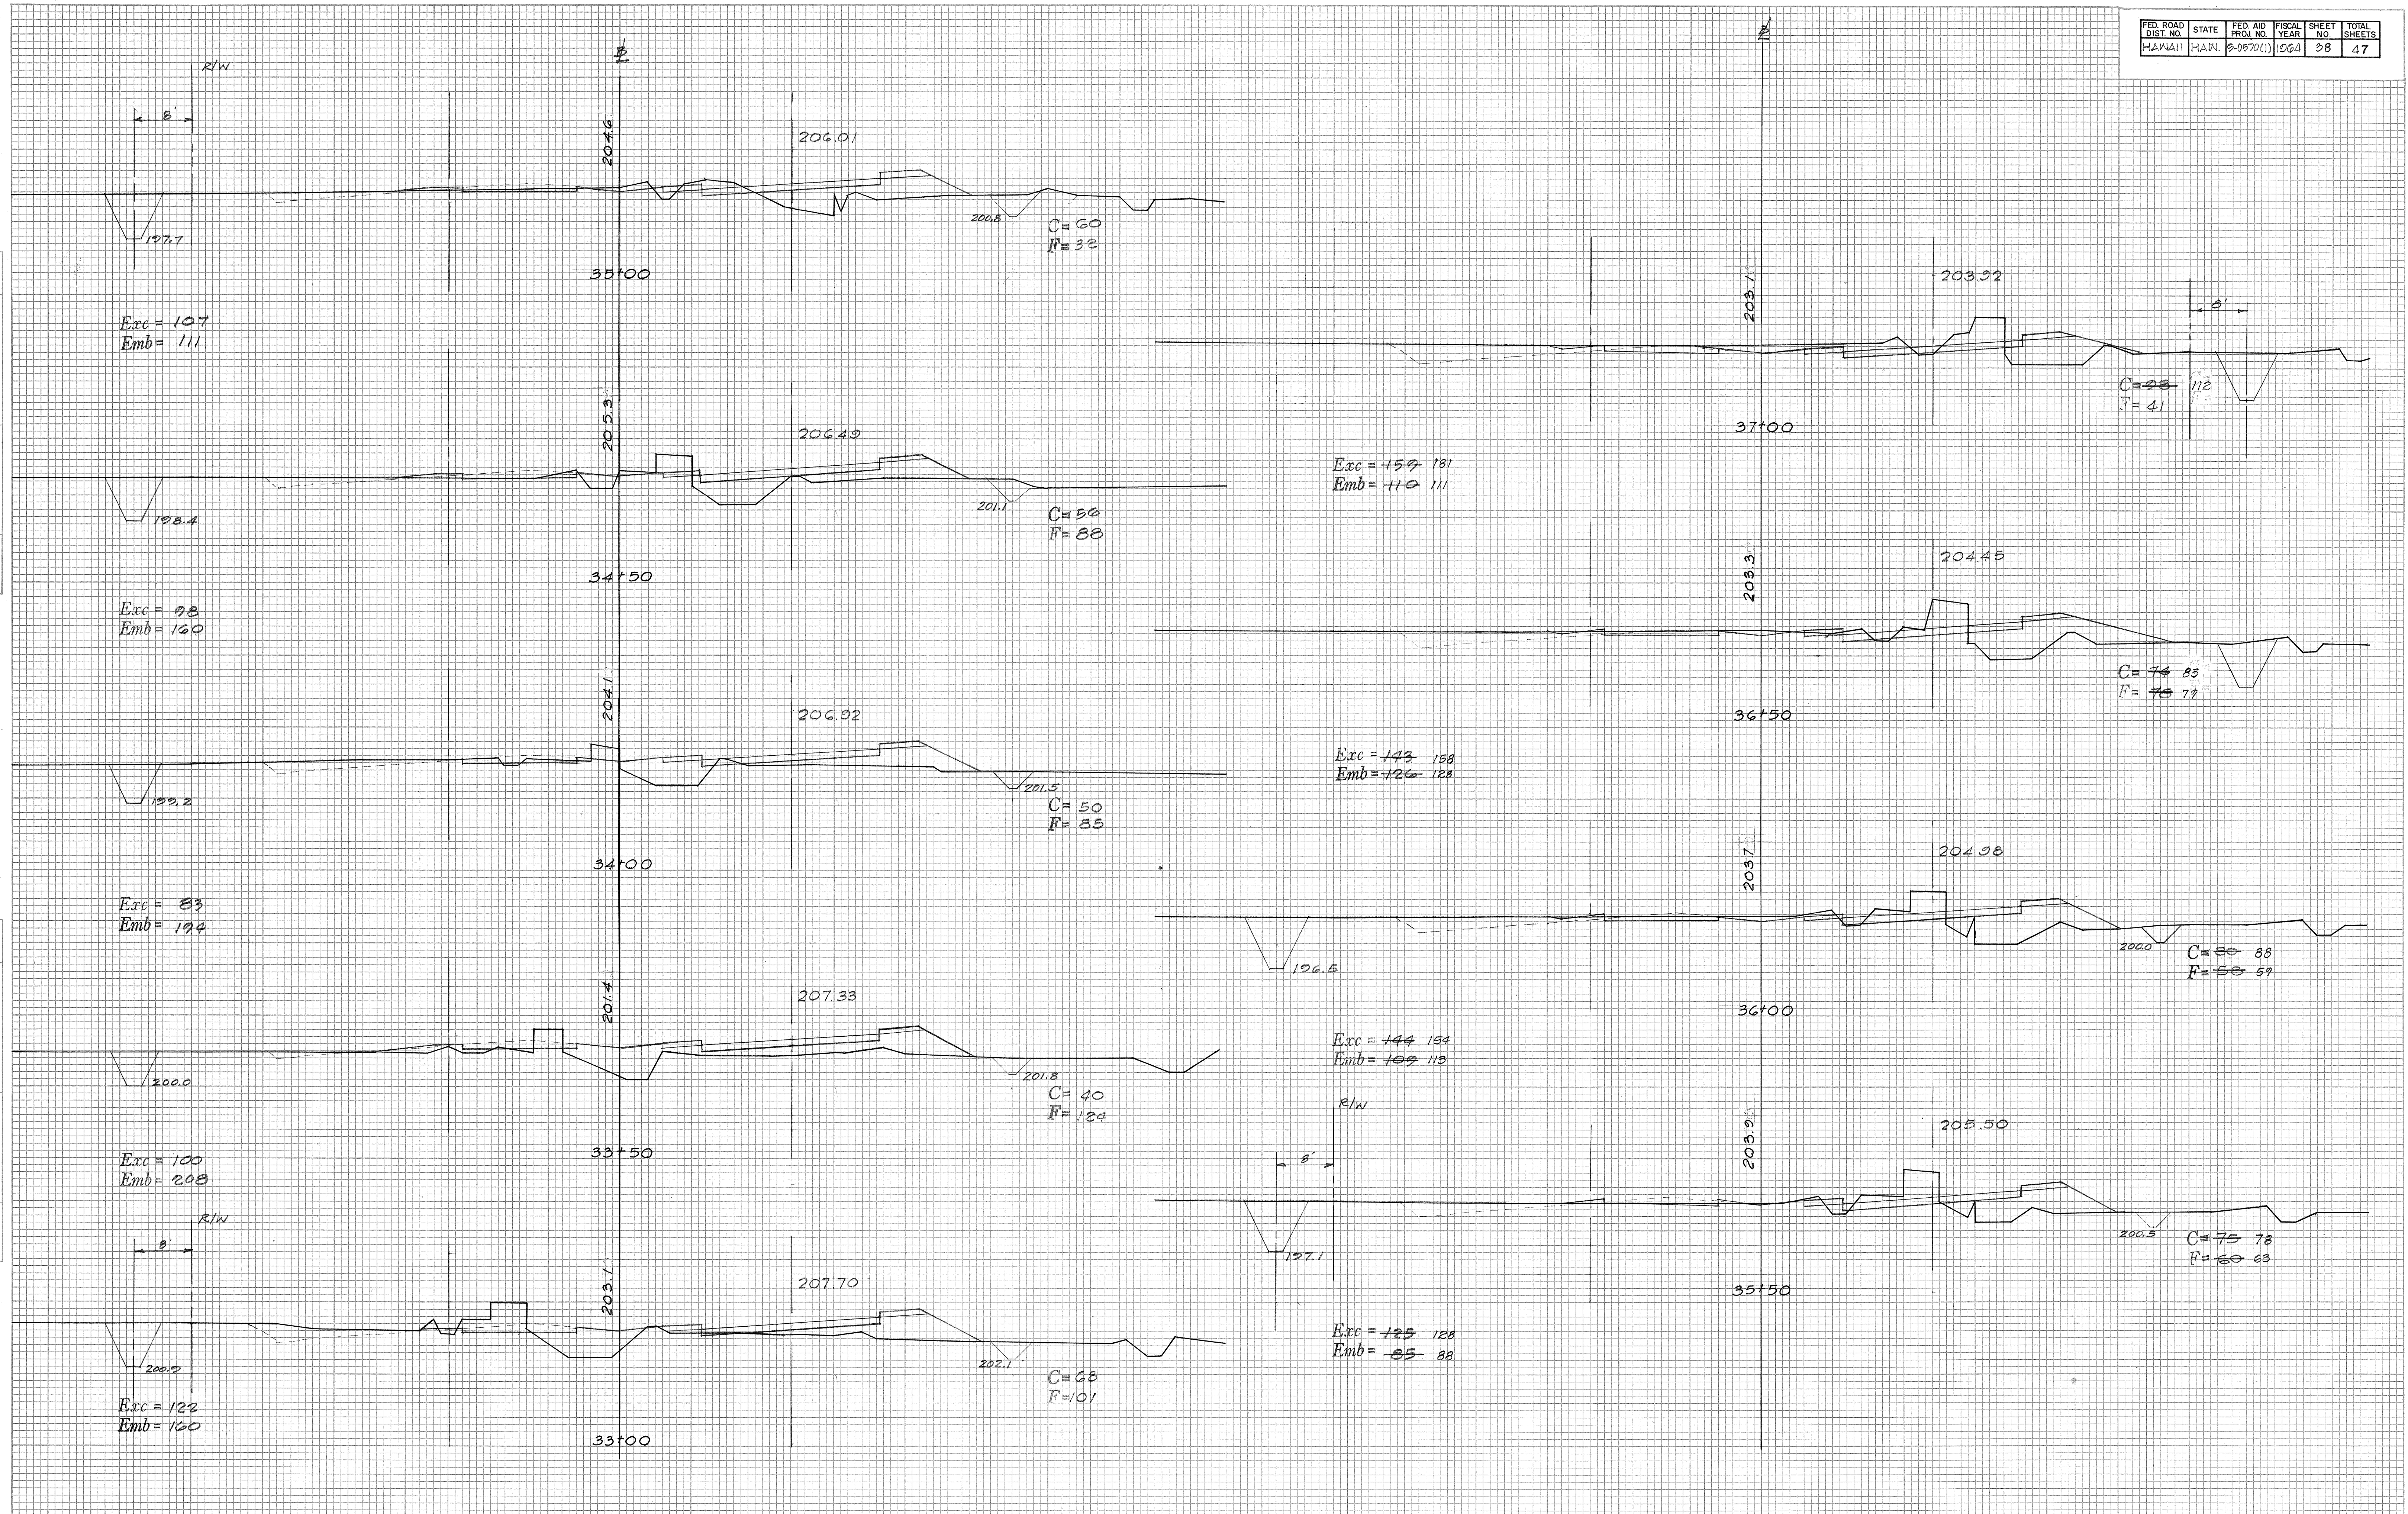

FED. ROAD DIST. NO.	STATE	FED. AID PROJ. NO.	FISCAL YEAR	SHEET NO.	TOTAL SHEETS
HAWAII	HAW.	9-0970(1)	1964	39	47


FINAL SURVEY	SURVEYED.....		BY.....	DATE.....
	PLOTTED.....			
NOTE BOOK	TEMPLATE.....			
NO.....	AREAS.....			
	AREAS CHECKED.....			

ORIGINAL			
SURVEY	SURVEYED	BY	DATE
NOTE BOOK	PLOTTED		
	TEMPLATE		
	AREAS		
NO. _____	AREAS CHECKED		

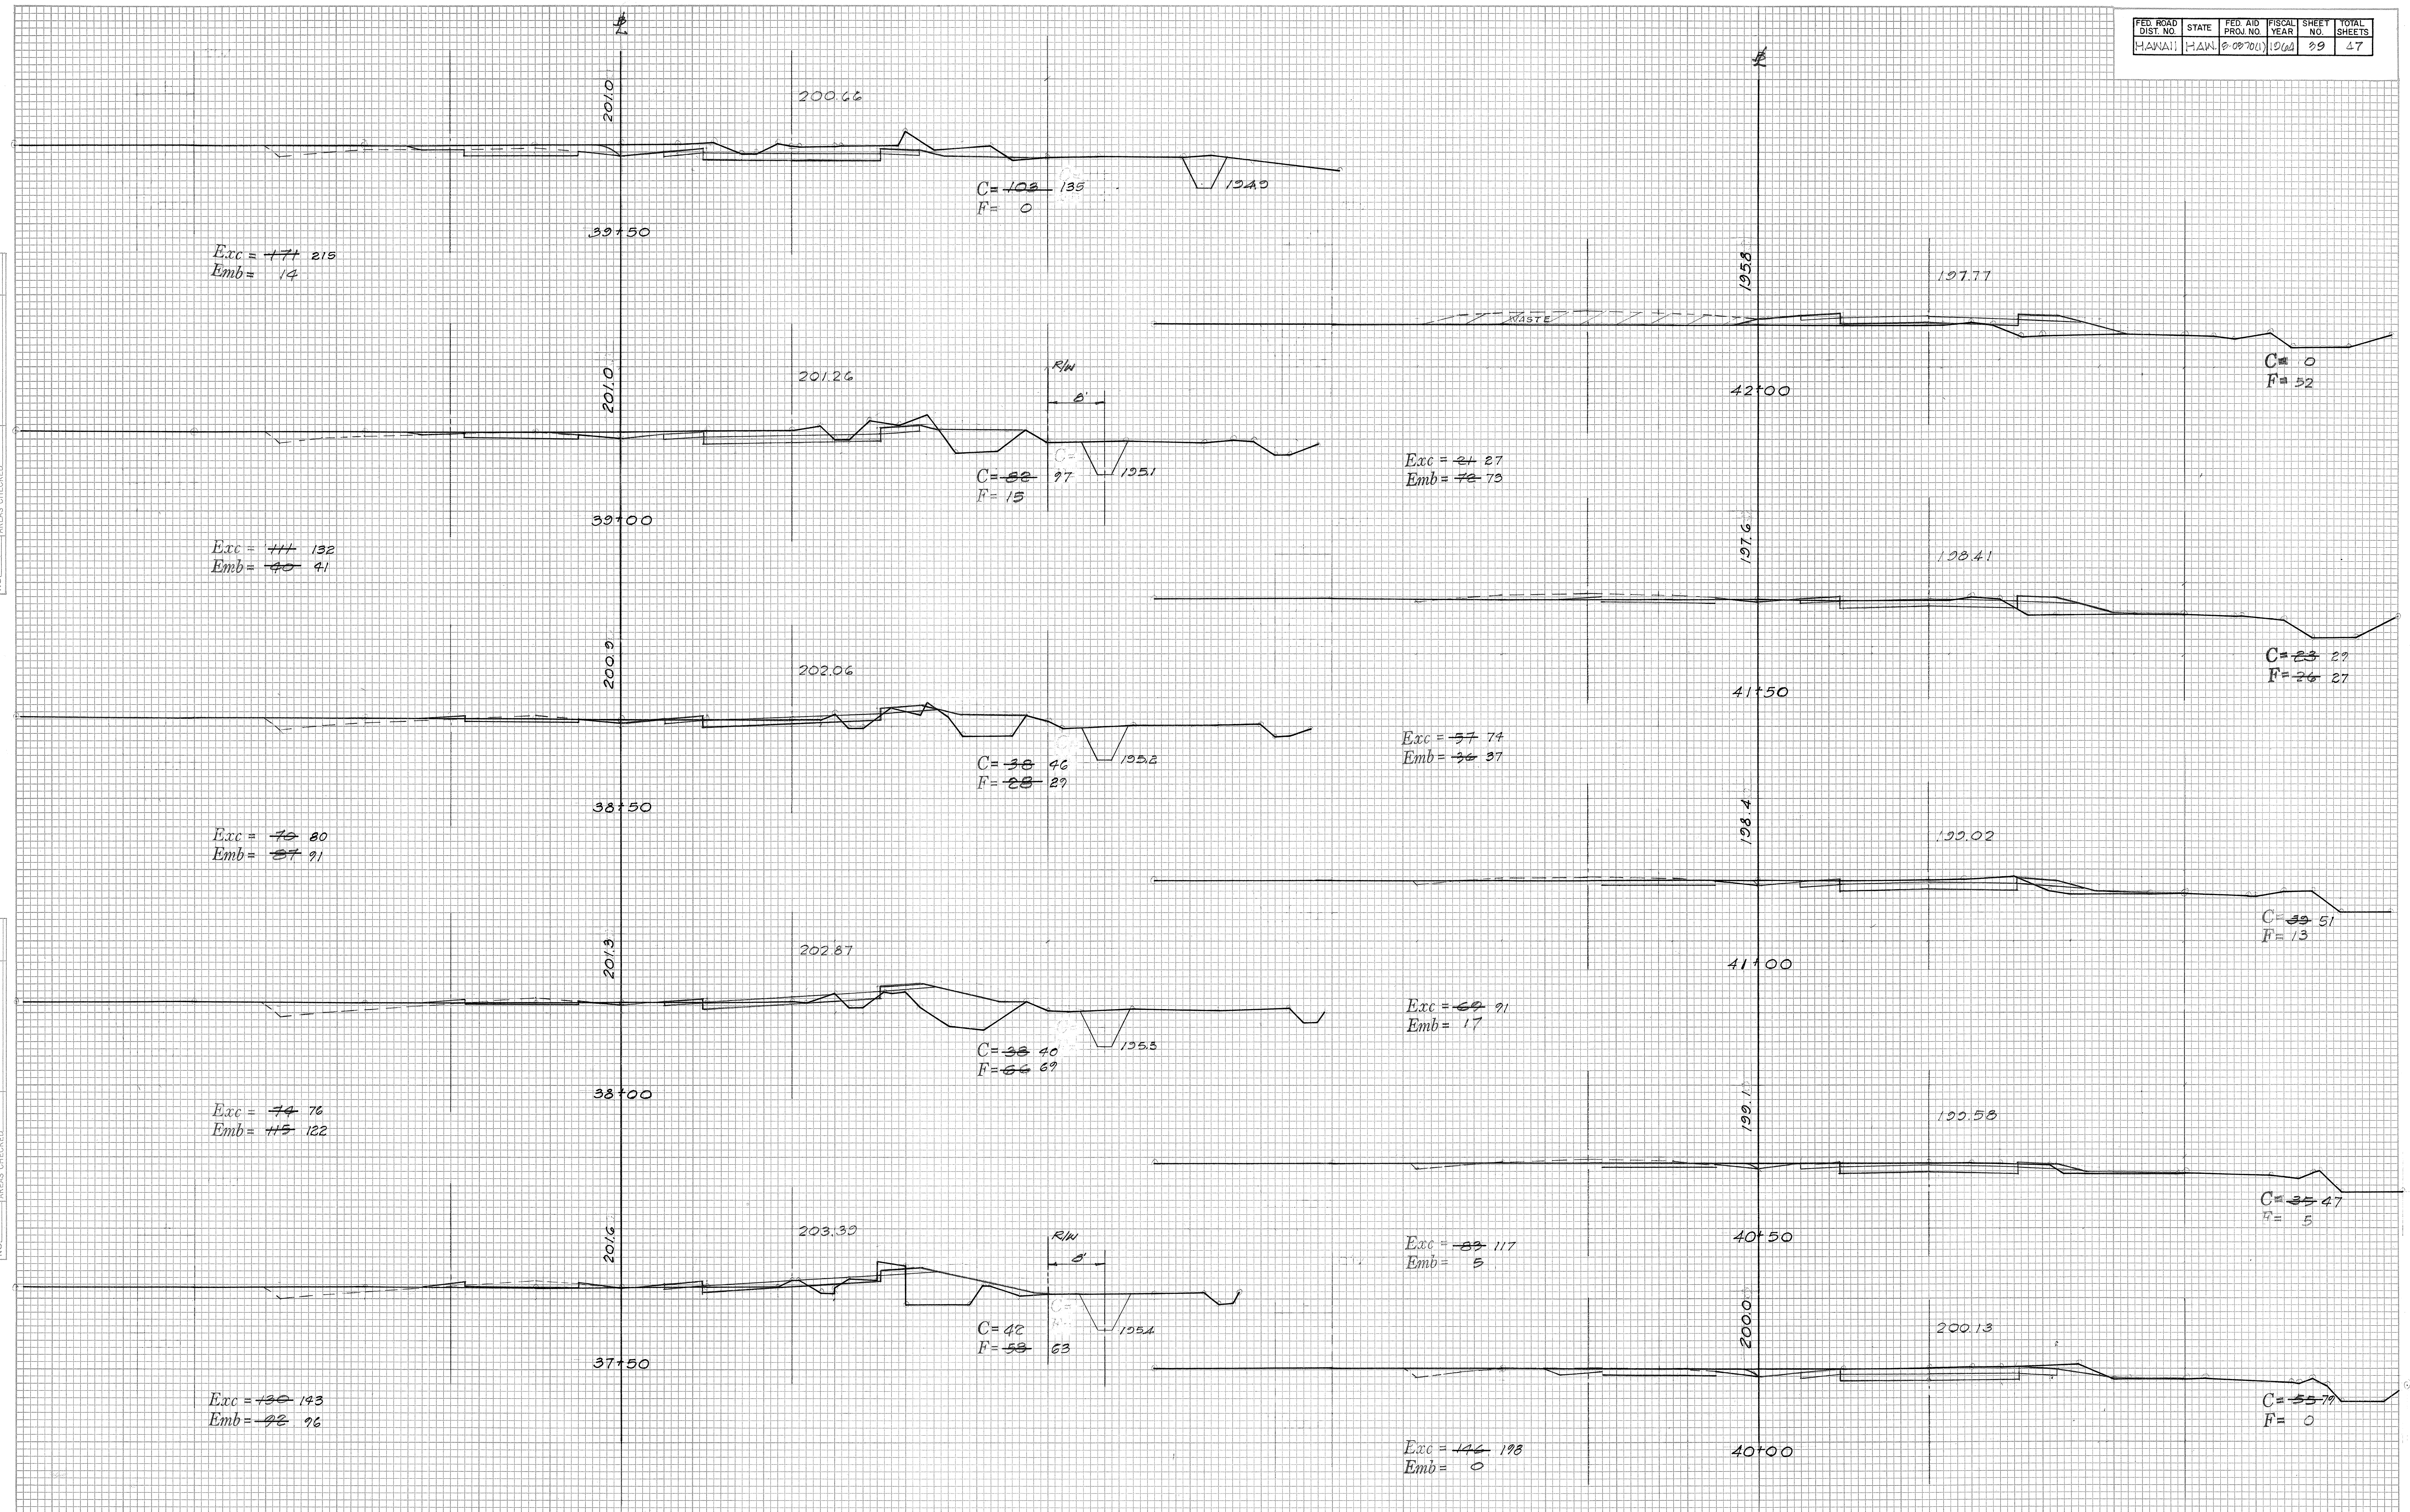

FINAL SURVEY		BY	DATE
NOTE BOOK	SURVEYED _____ PLOTTED _____ TEMPLATE _____ AREAS _____ AREAS CHECKED _____		
NO. _____			


ORIGINAL SURVEY	SURVEYED PLOTTED TEMPLATE	BY	DATE
NOTE BOOK	AREAS		
NO. _____	AREAS CHECKED		

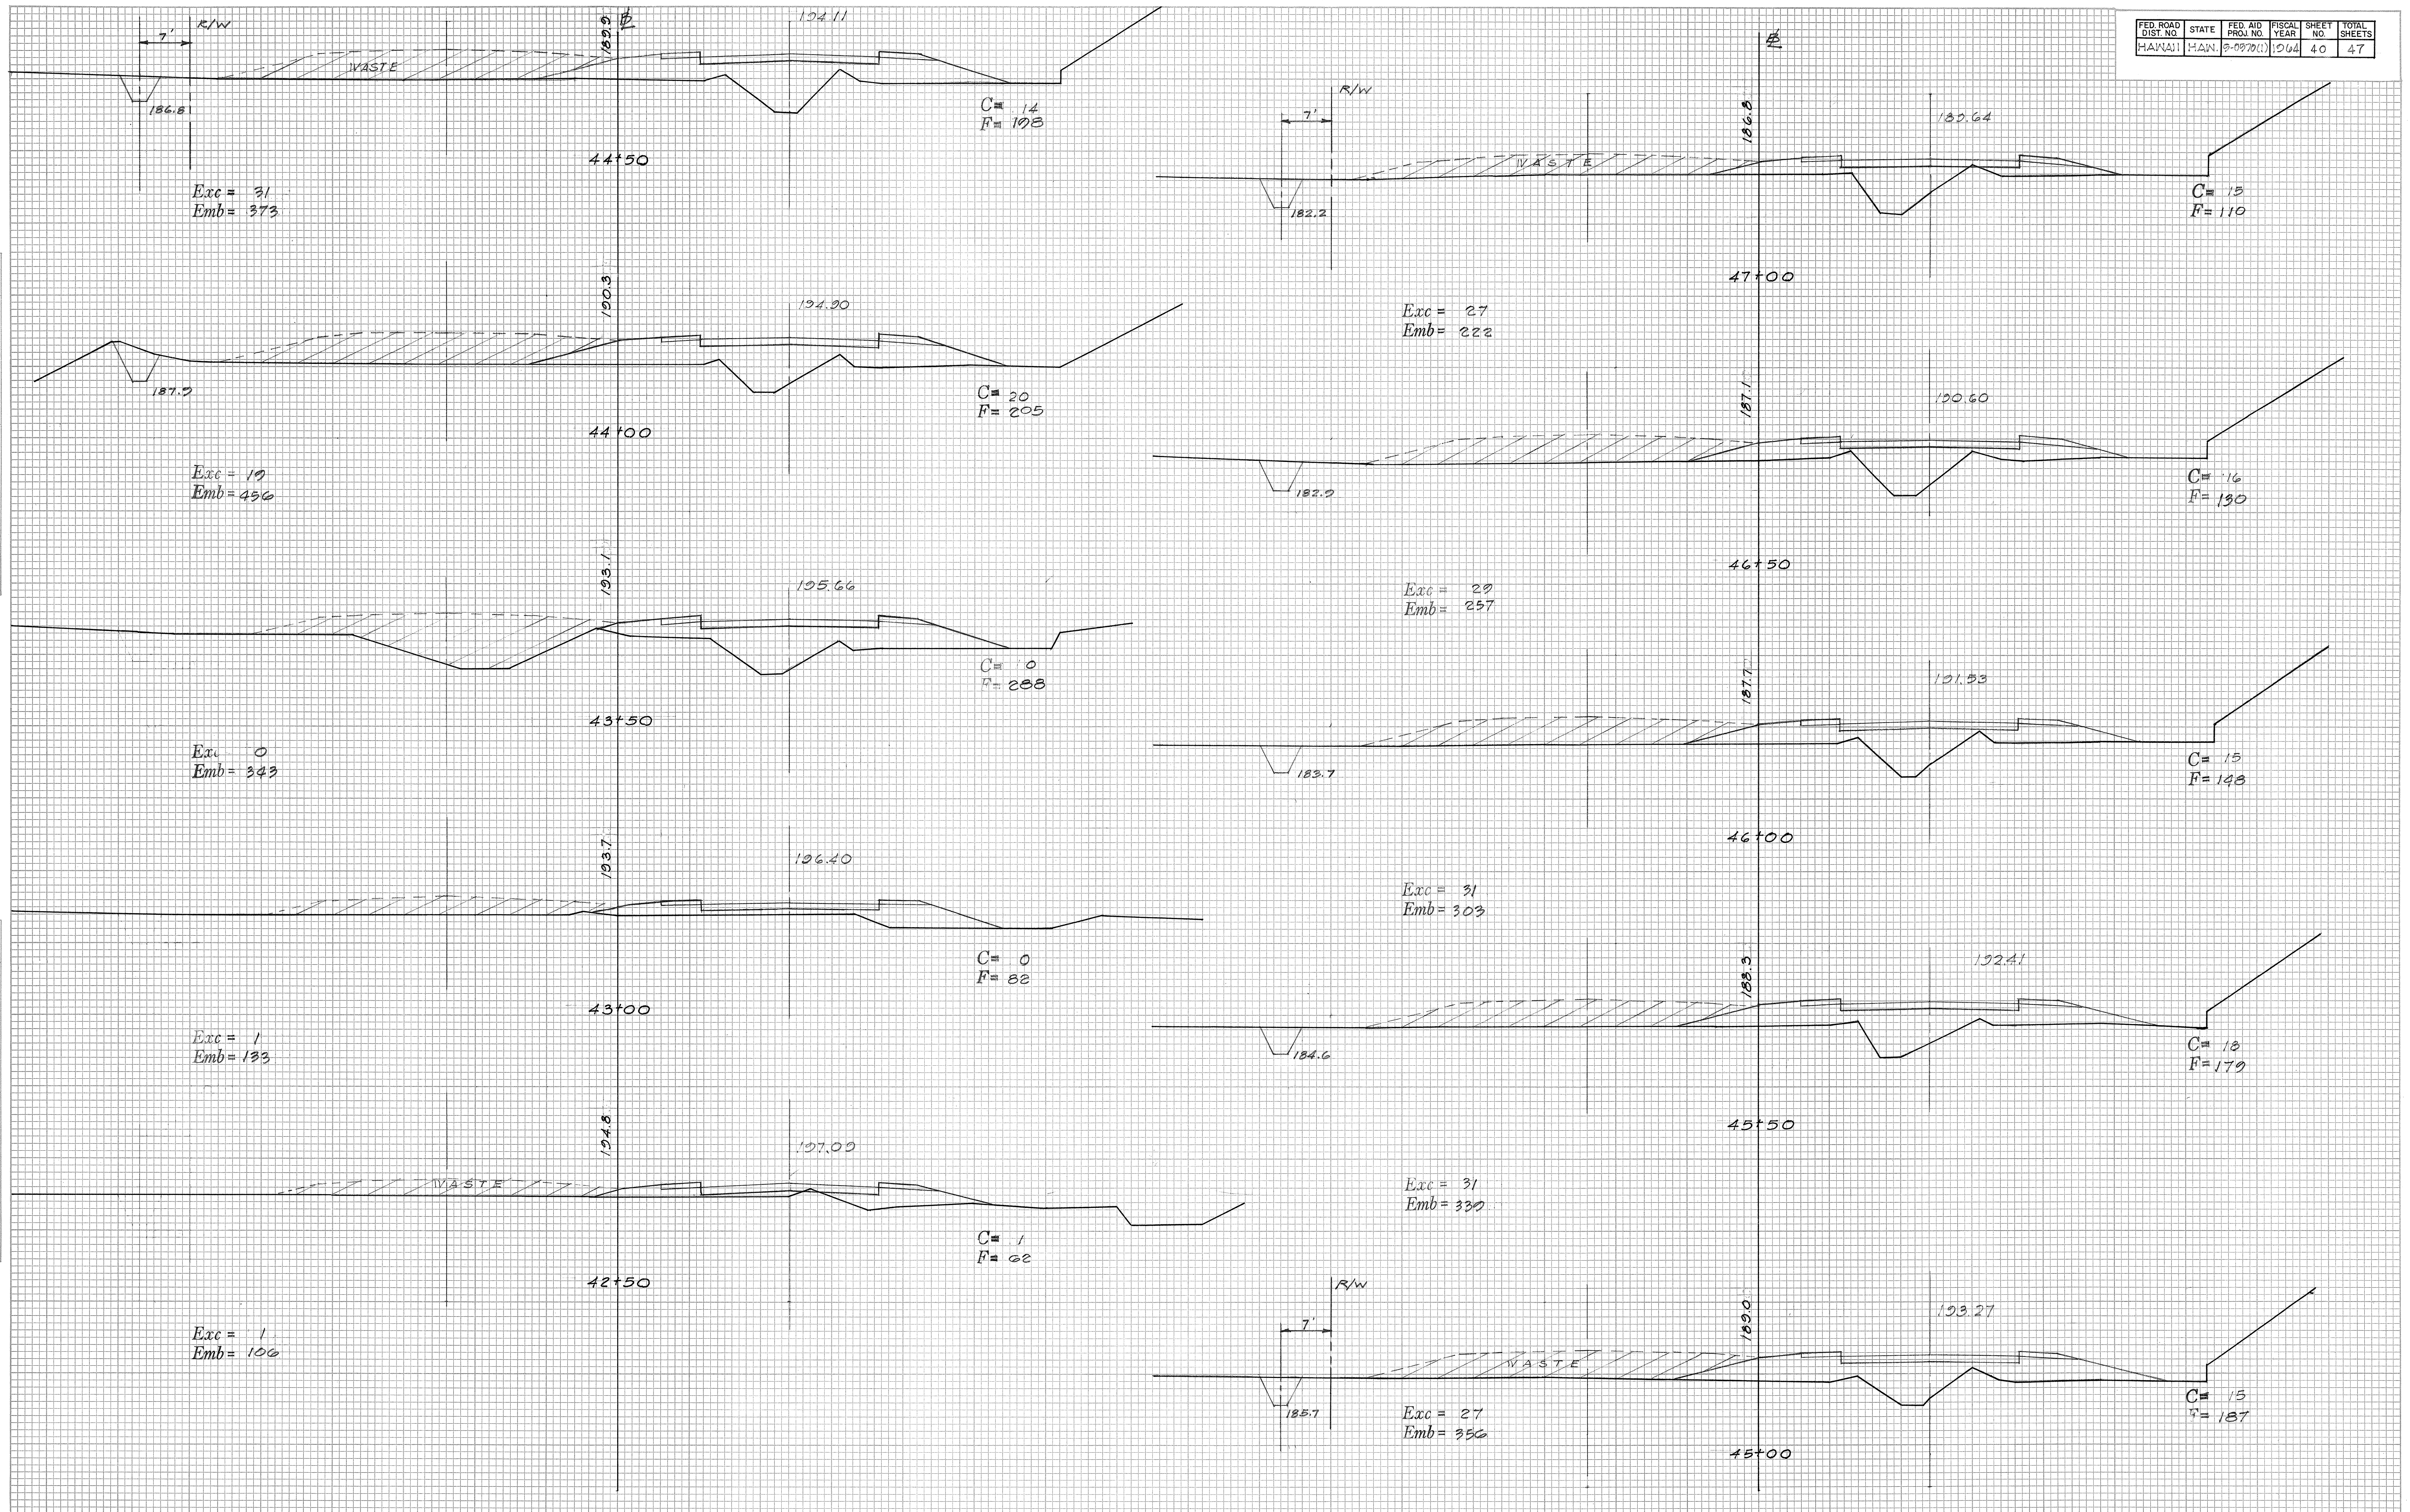

FED. ROAD DIST. NO.	STATE	FED. AID PROJ. NO.	FISCAL YEAR	SHEET NO.	TOTAL SHEETS
HAWAII	HAWAII	50970(1)	1964	41	47


FINAL SURVEY	DATE	BY
SURVEYED		
PLOTTED		
NOTE BOOK		
AREAS		
CHECKED		
NO.		

ORIGINAL SURVEY	DATE	BY
SURVEYED		
PLOTTED		
NOTE BOOK		
AREAS		
CHECKED		
NO.		

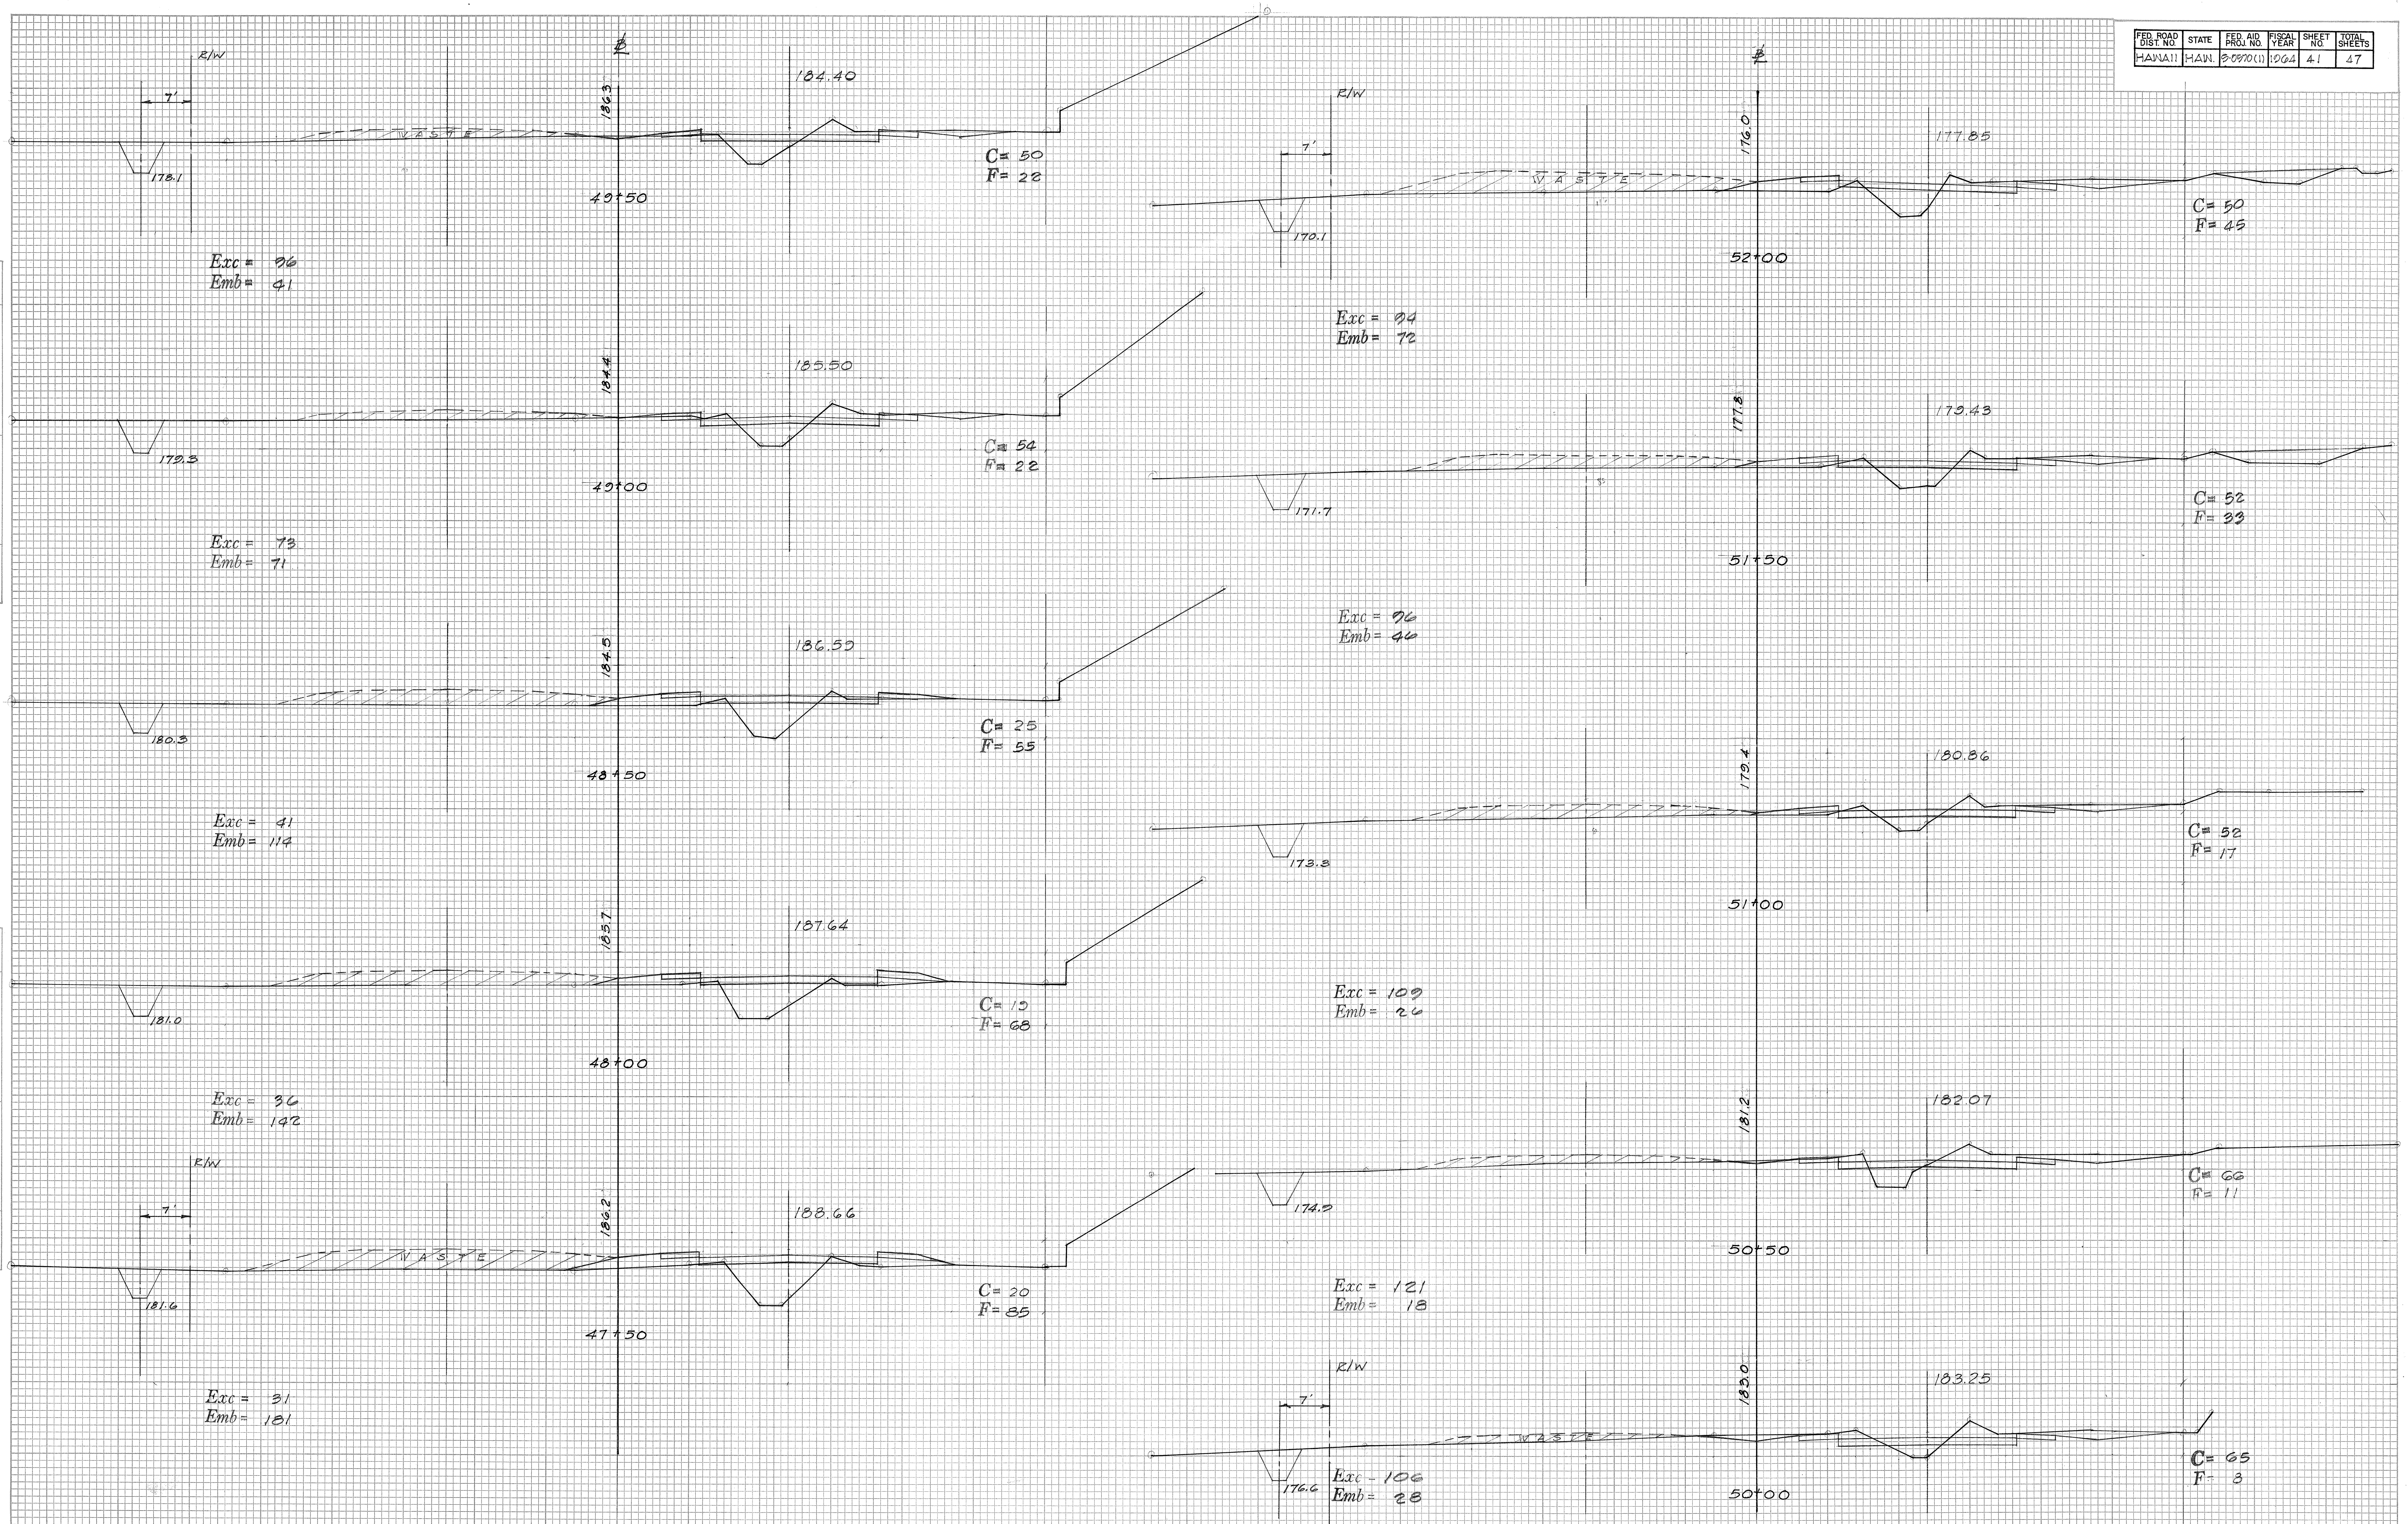

FINAL SURVEY	SURVEYED _____	BY _____	DATE _____
NOTE BOOK	PLOTTED _____		
NO. _____	TEMPLATE _____		
	AREAS _____ AREAS CHECKED _____		


ORIGINAL SURVEY	SURVEYED _____ PLOTTED _____ TEMPLATE _____ AREAS _____ AREAS CHECKED _____	BY _____	DATE _____
NOTE BOOK			
NO.			

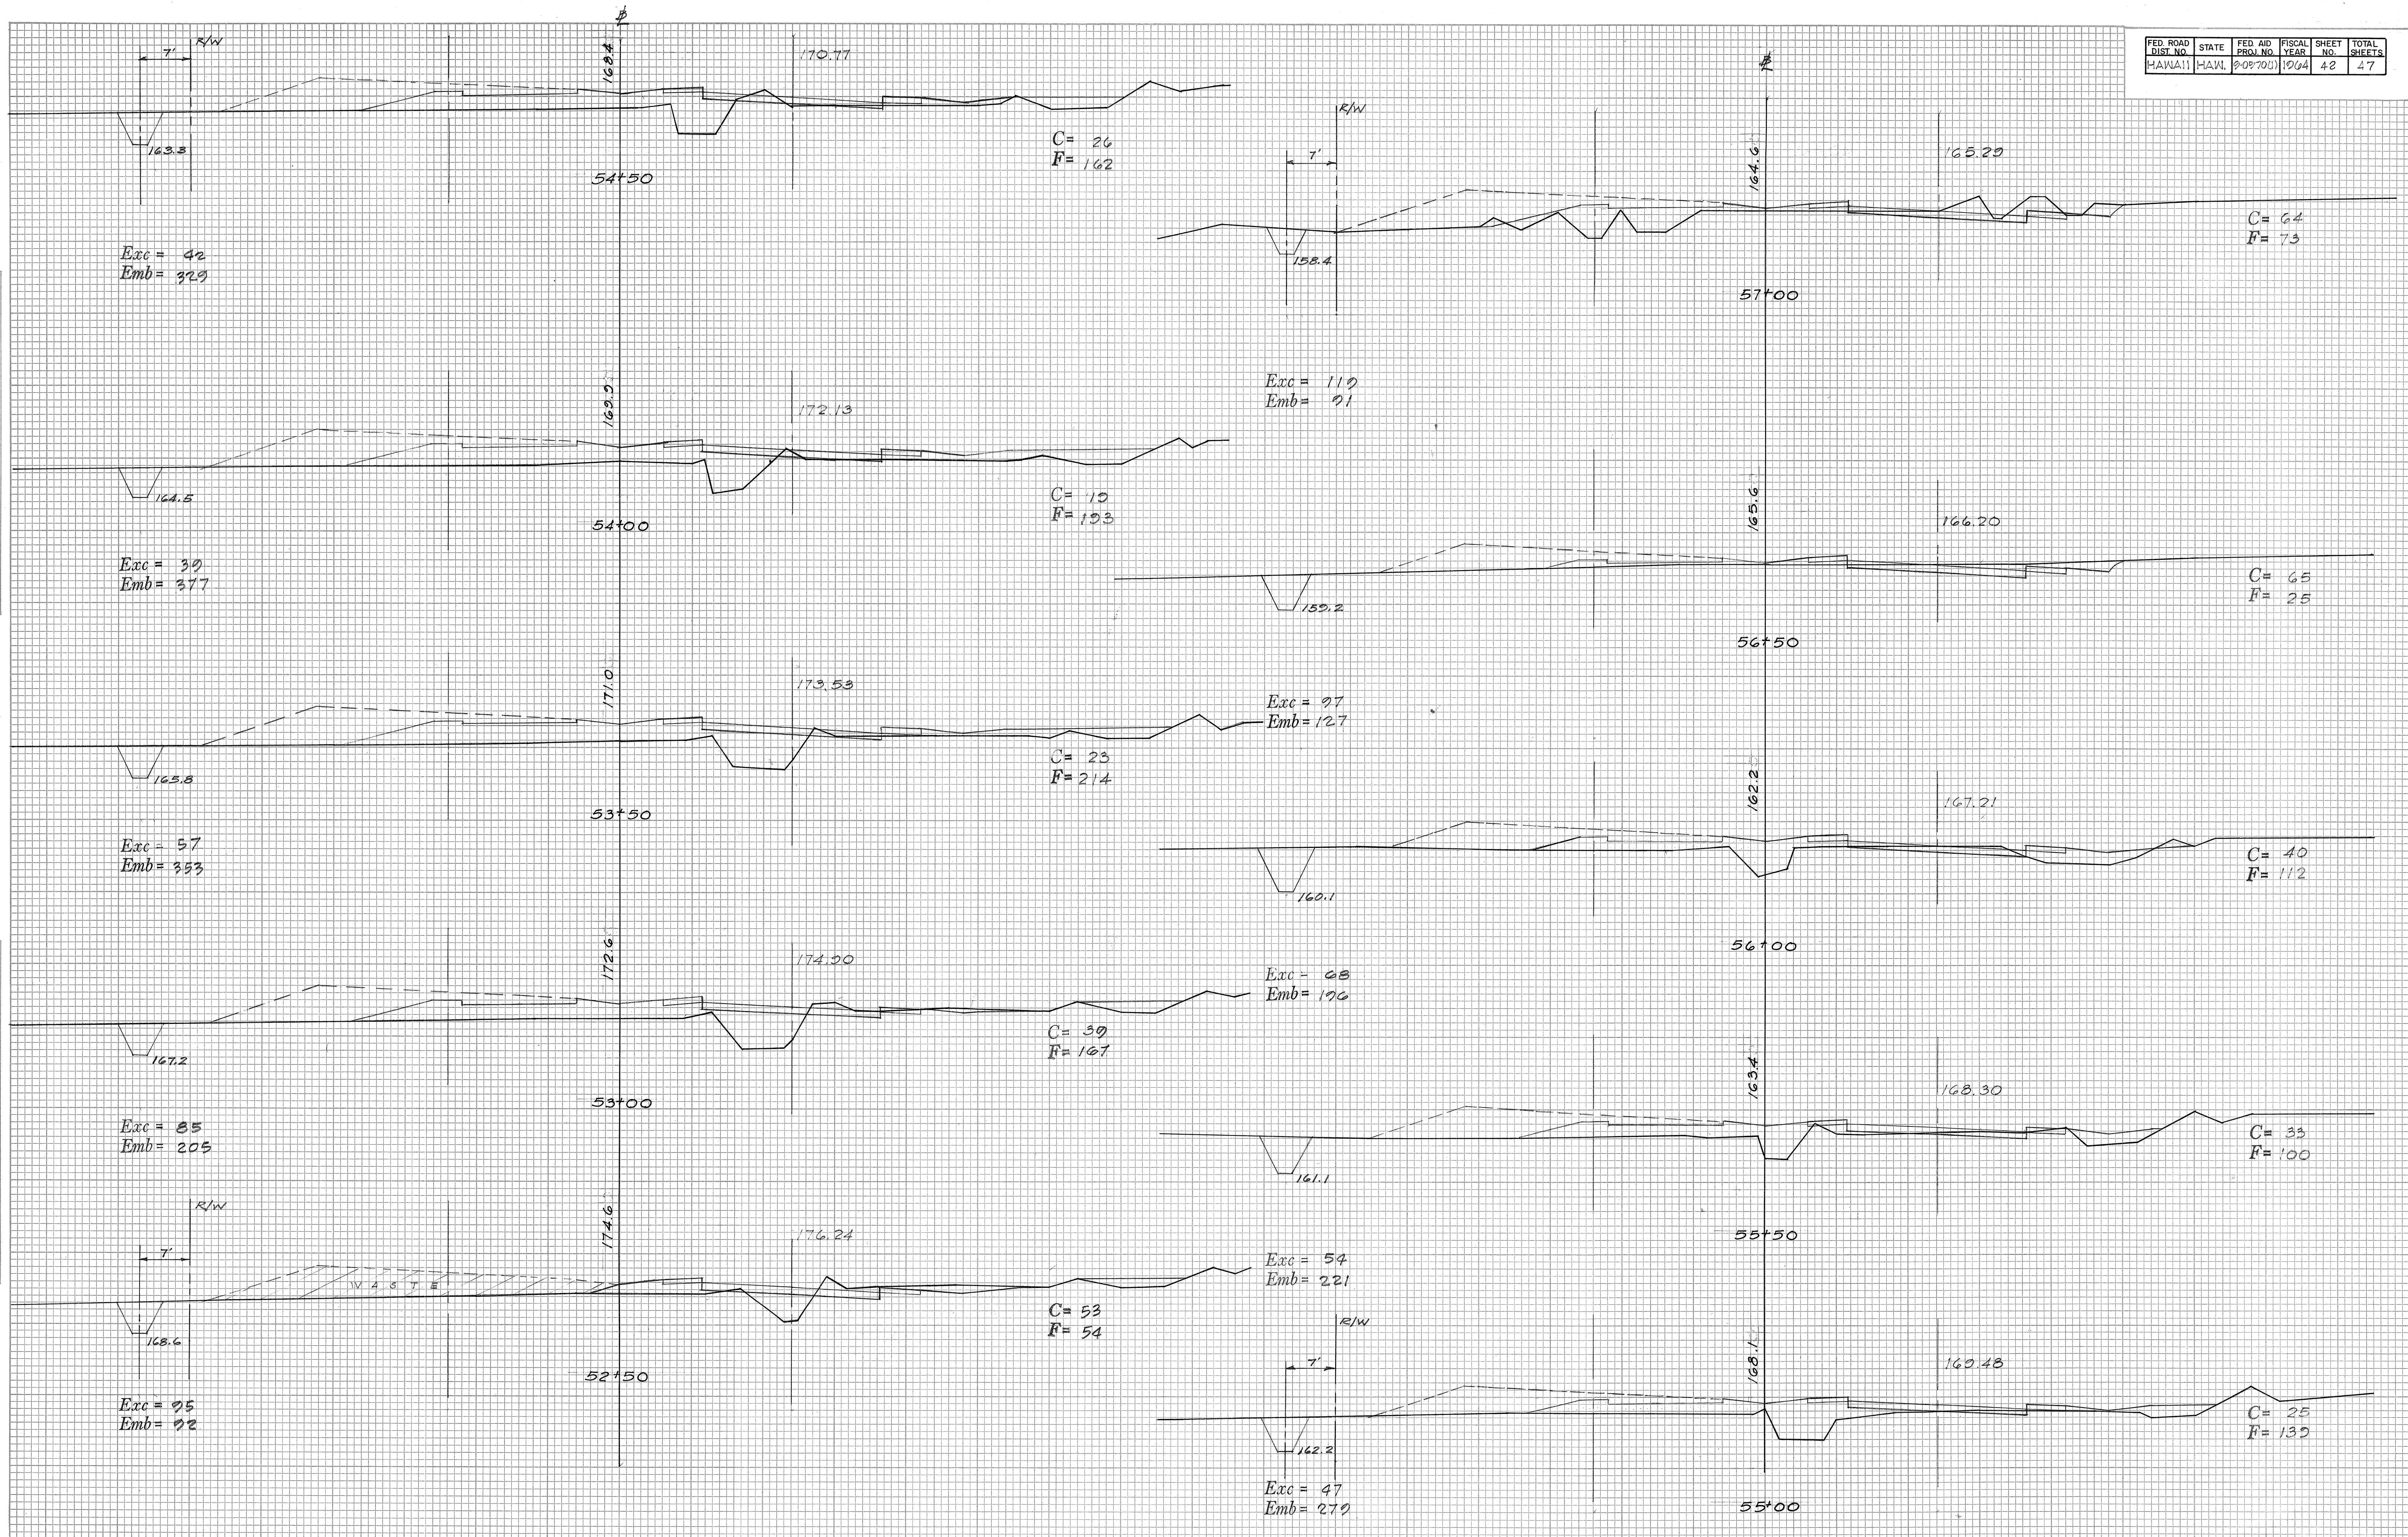

FED. ROAD DIST. NO.	STATE	FED. AID PROJ. NO.	FISCAL YEAR	SHEET NO.	TOTAL SHEETS
HAWAII	HAW.	2-0870(1)	1964	43	47

FINAL SURVEY	DATE
NO.	


ORIGINAL SURVEY	DATE
NO.	

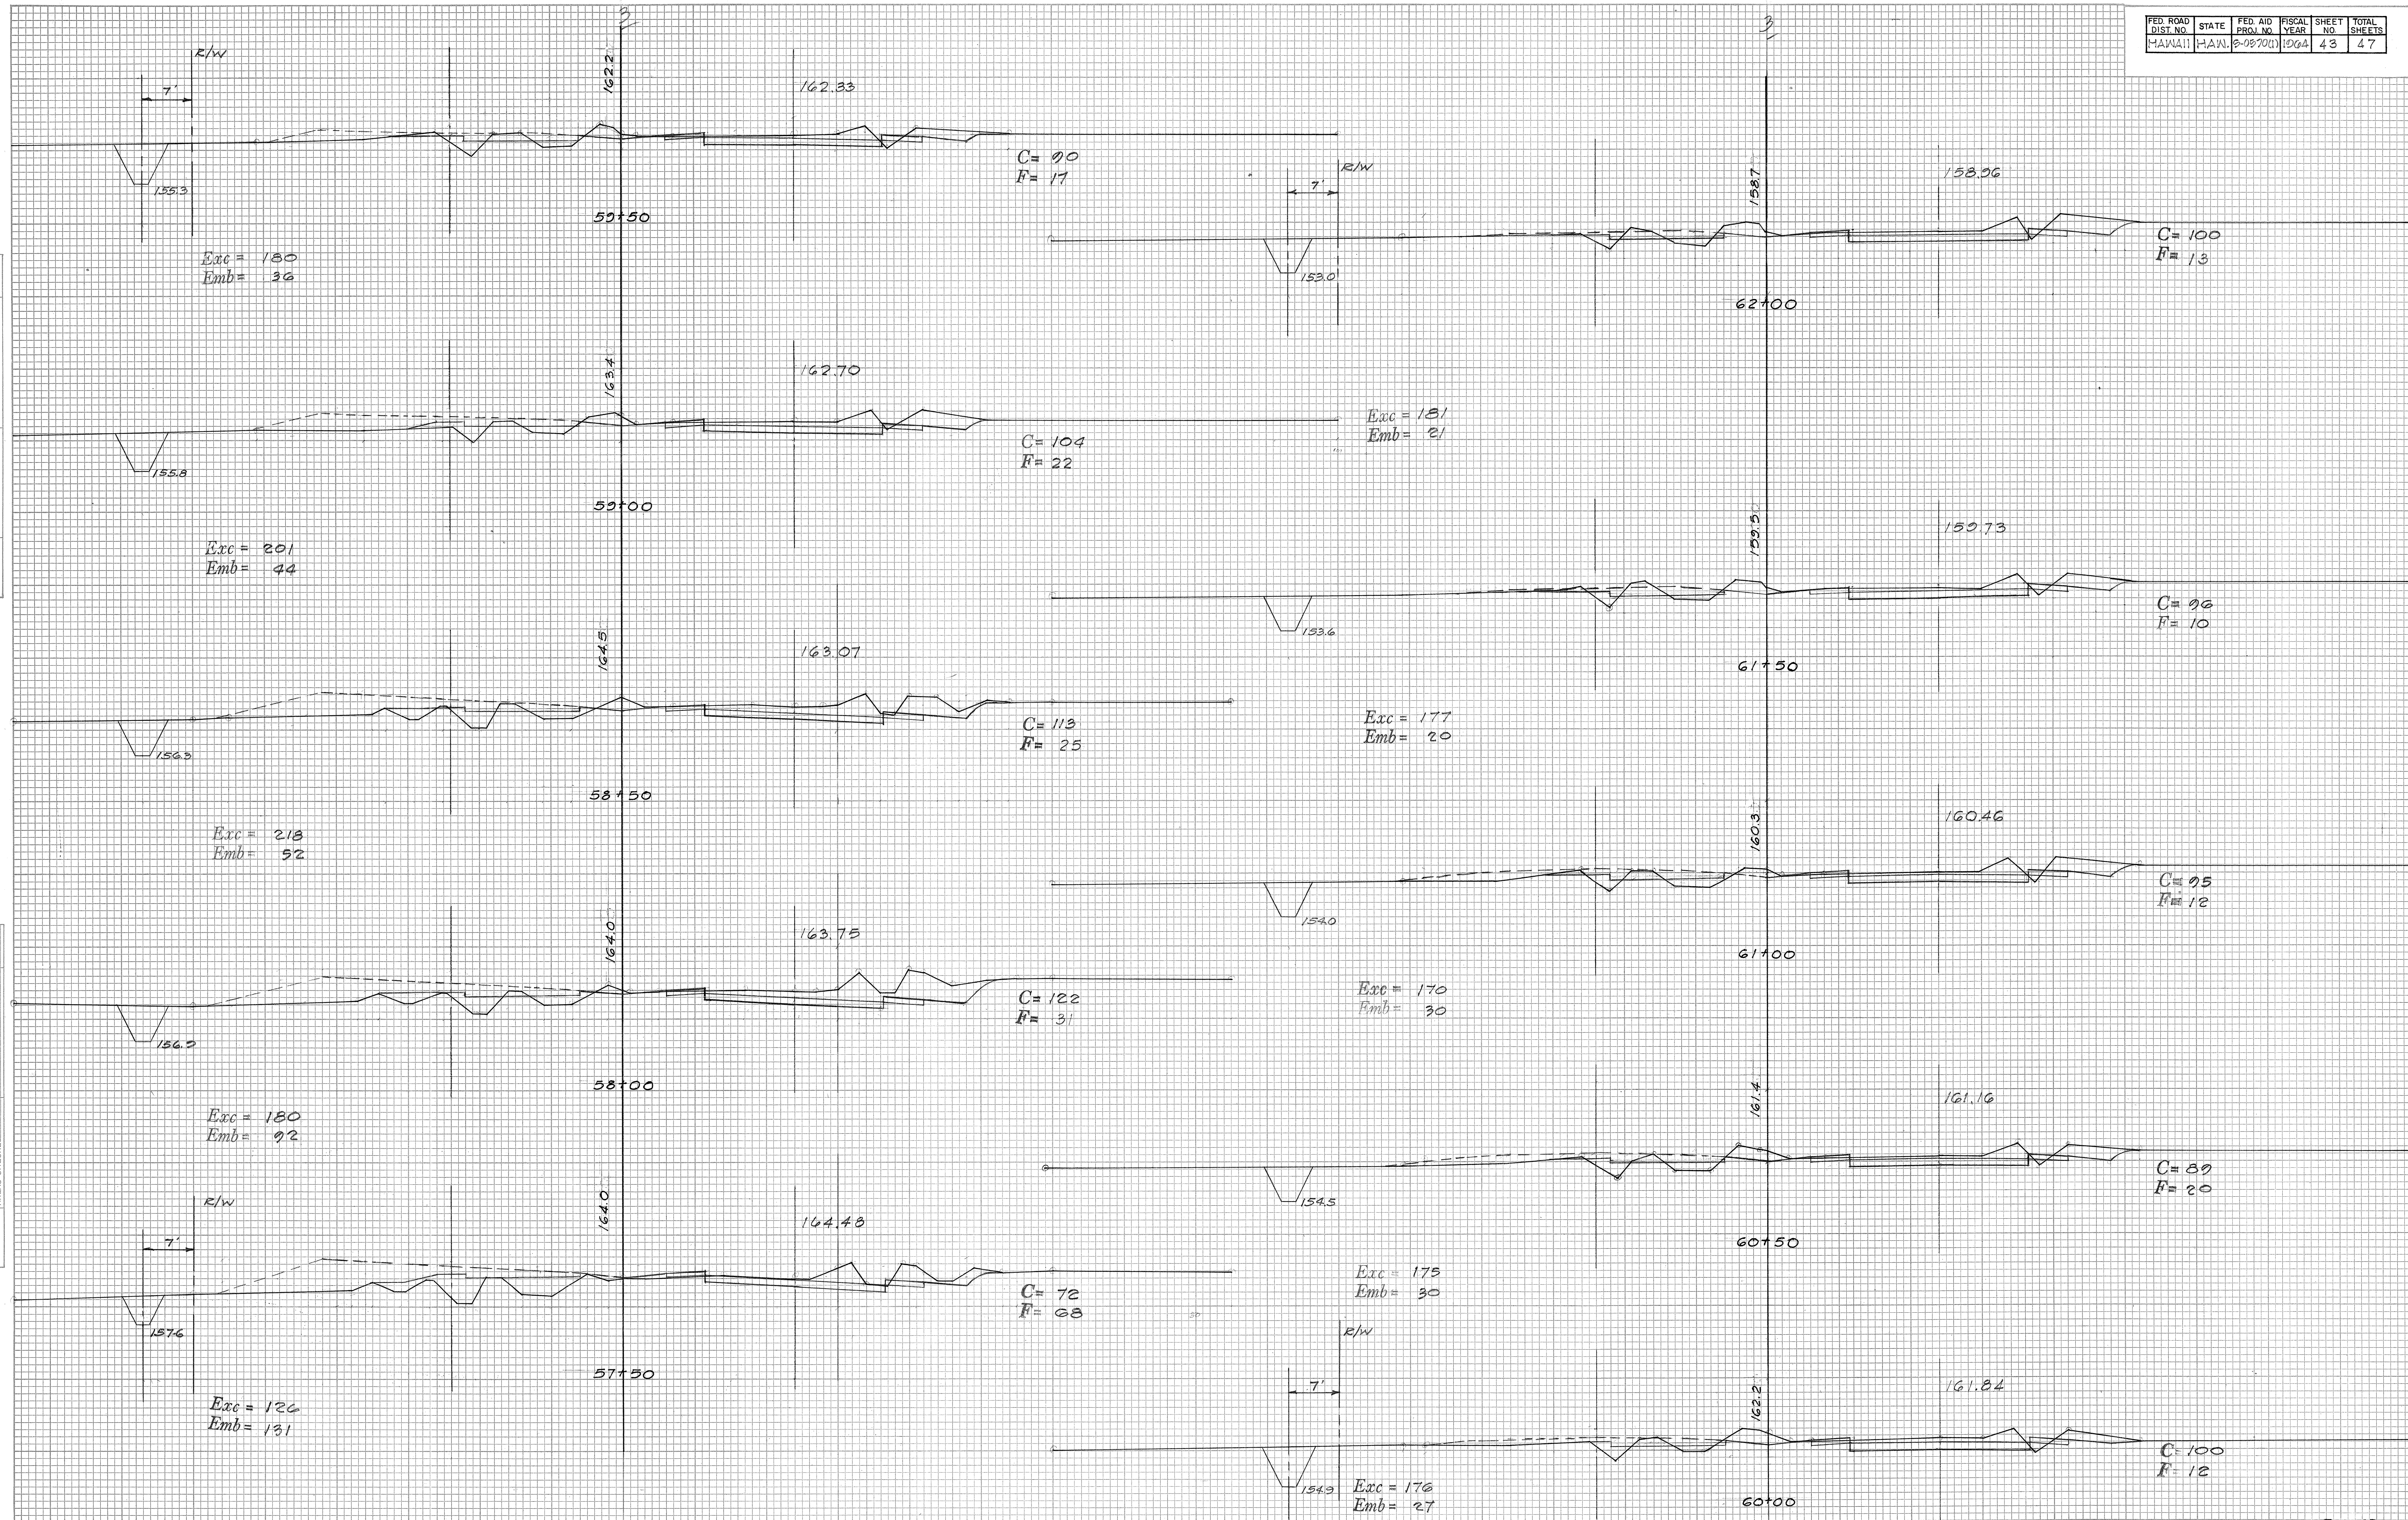

FED. ROAD DIST. NO.	STATE	FED. AID PROJ. NO.	FISCAL YEAR	SHEET NO.	TOTAL SHEETS
HAWAII	HAW.	9-0970(1)	1964	44	47


FINAL SURVEY	SURVEYED	BY	DATE
NOTE BOOK	PLOTTED		
	TEMPLATE		
	AREAS		
NO. _____	AREAS CHECKED		

ORIGINAL		BY	DATE
SURVEY			
PLOTTED			
TEMPLATE			
AREAS			
AREAS CHECKED			
NO.			

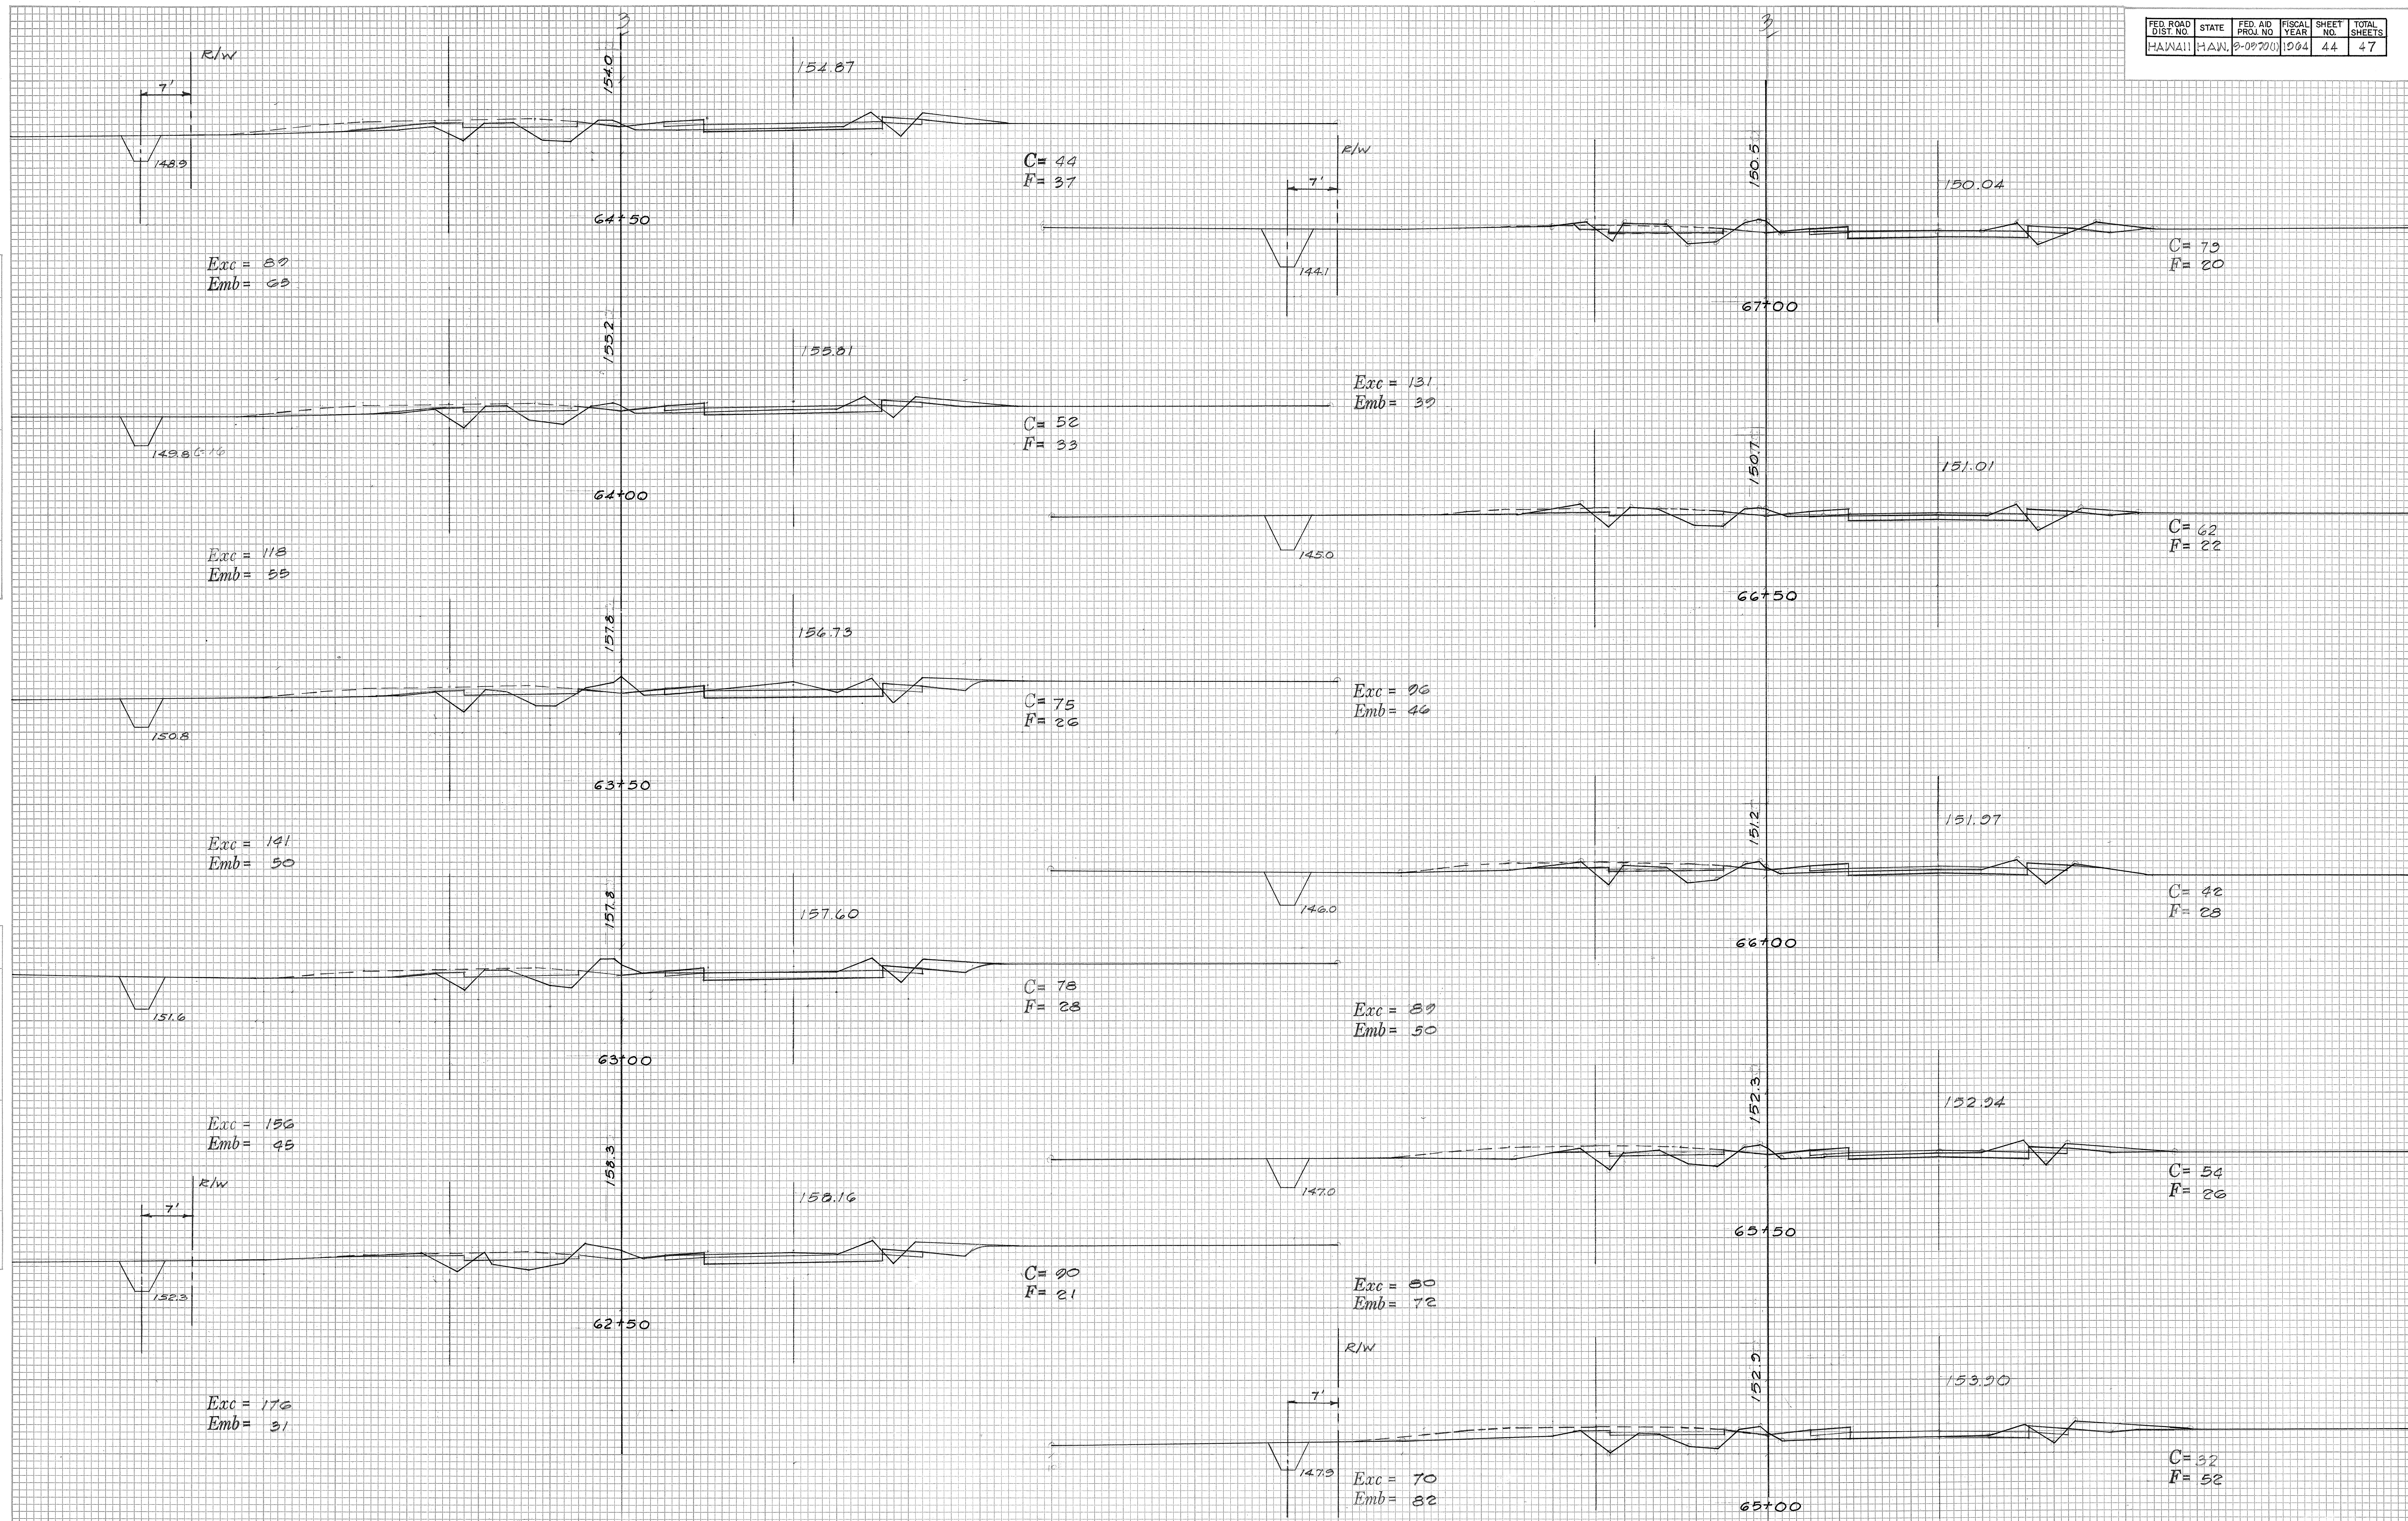

FINAL SURVEY	SURVEYED _____ PLOTTED _____ TEMPLATE _____ AREAS _____ AREAS CHECKED _____	BY _____	DATE _____
NOTE BOOK			
NO. _____			


ORIGINAL SURVEY				BY	DATE
				SURVEYED	
				PLOTTED	
				TEMPLATE	
				AREAS	
				AREAS CHECKED	
NO.					

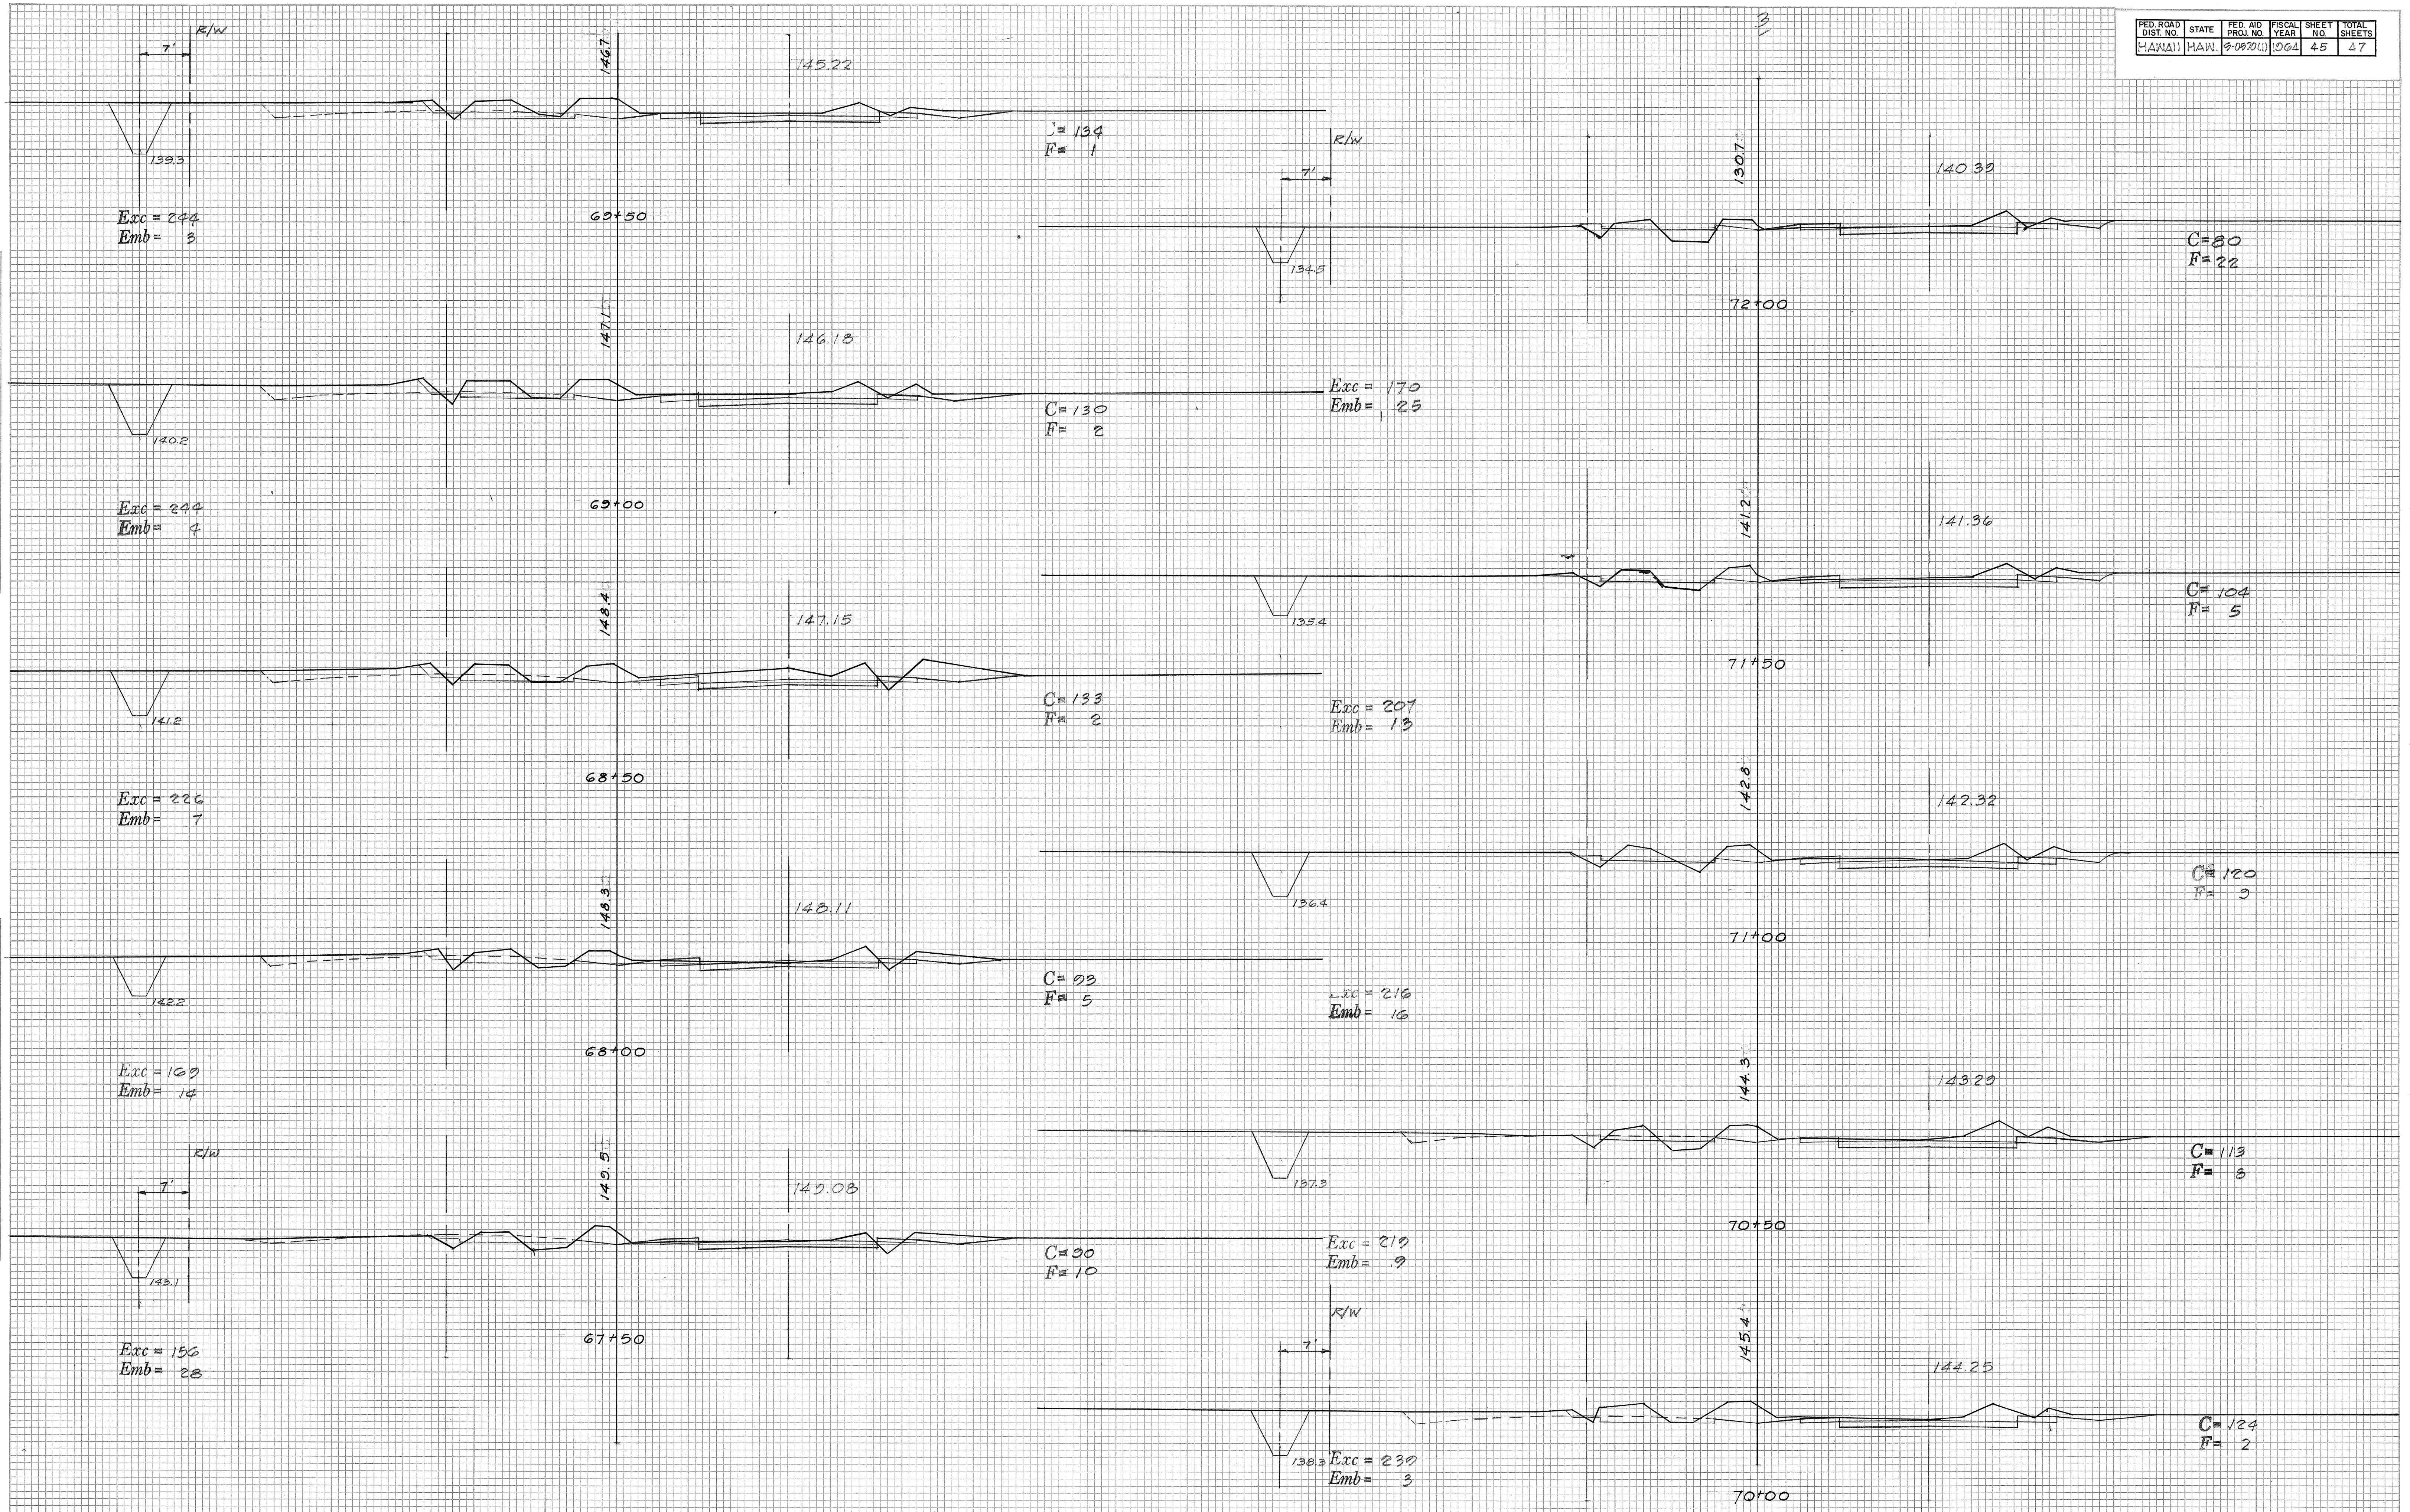

FED. ROAD DIST. NO.	STATE	FED. AID PROJ. NO.	FISCAL YEAR	SHEET NO.	TOTAL SHEETS
HAWAII	HAW.	9-0970(1)	1964	46	47

FINAL SURVEY		BY		DATE
NOTED				
NOTE BOOK				
AREAS				
NO.				
AREAS CHECKED				

ORIGINAL SURVEY		BY		DATE
NOTED				
PLOTTED				
TEMPLATE				
NOTE BOOK				
NO.				
AREAS CHECKED				

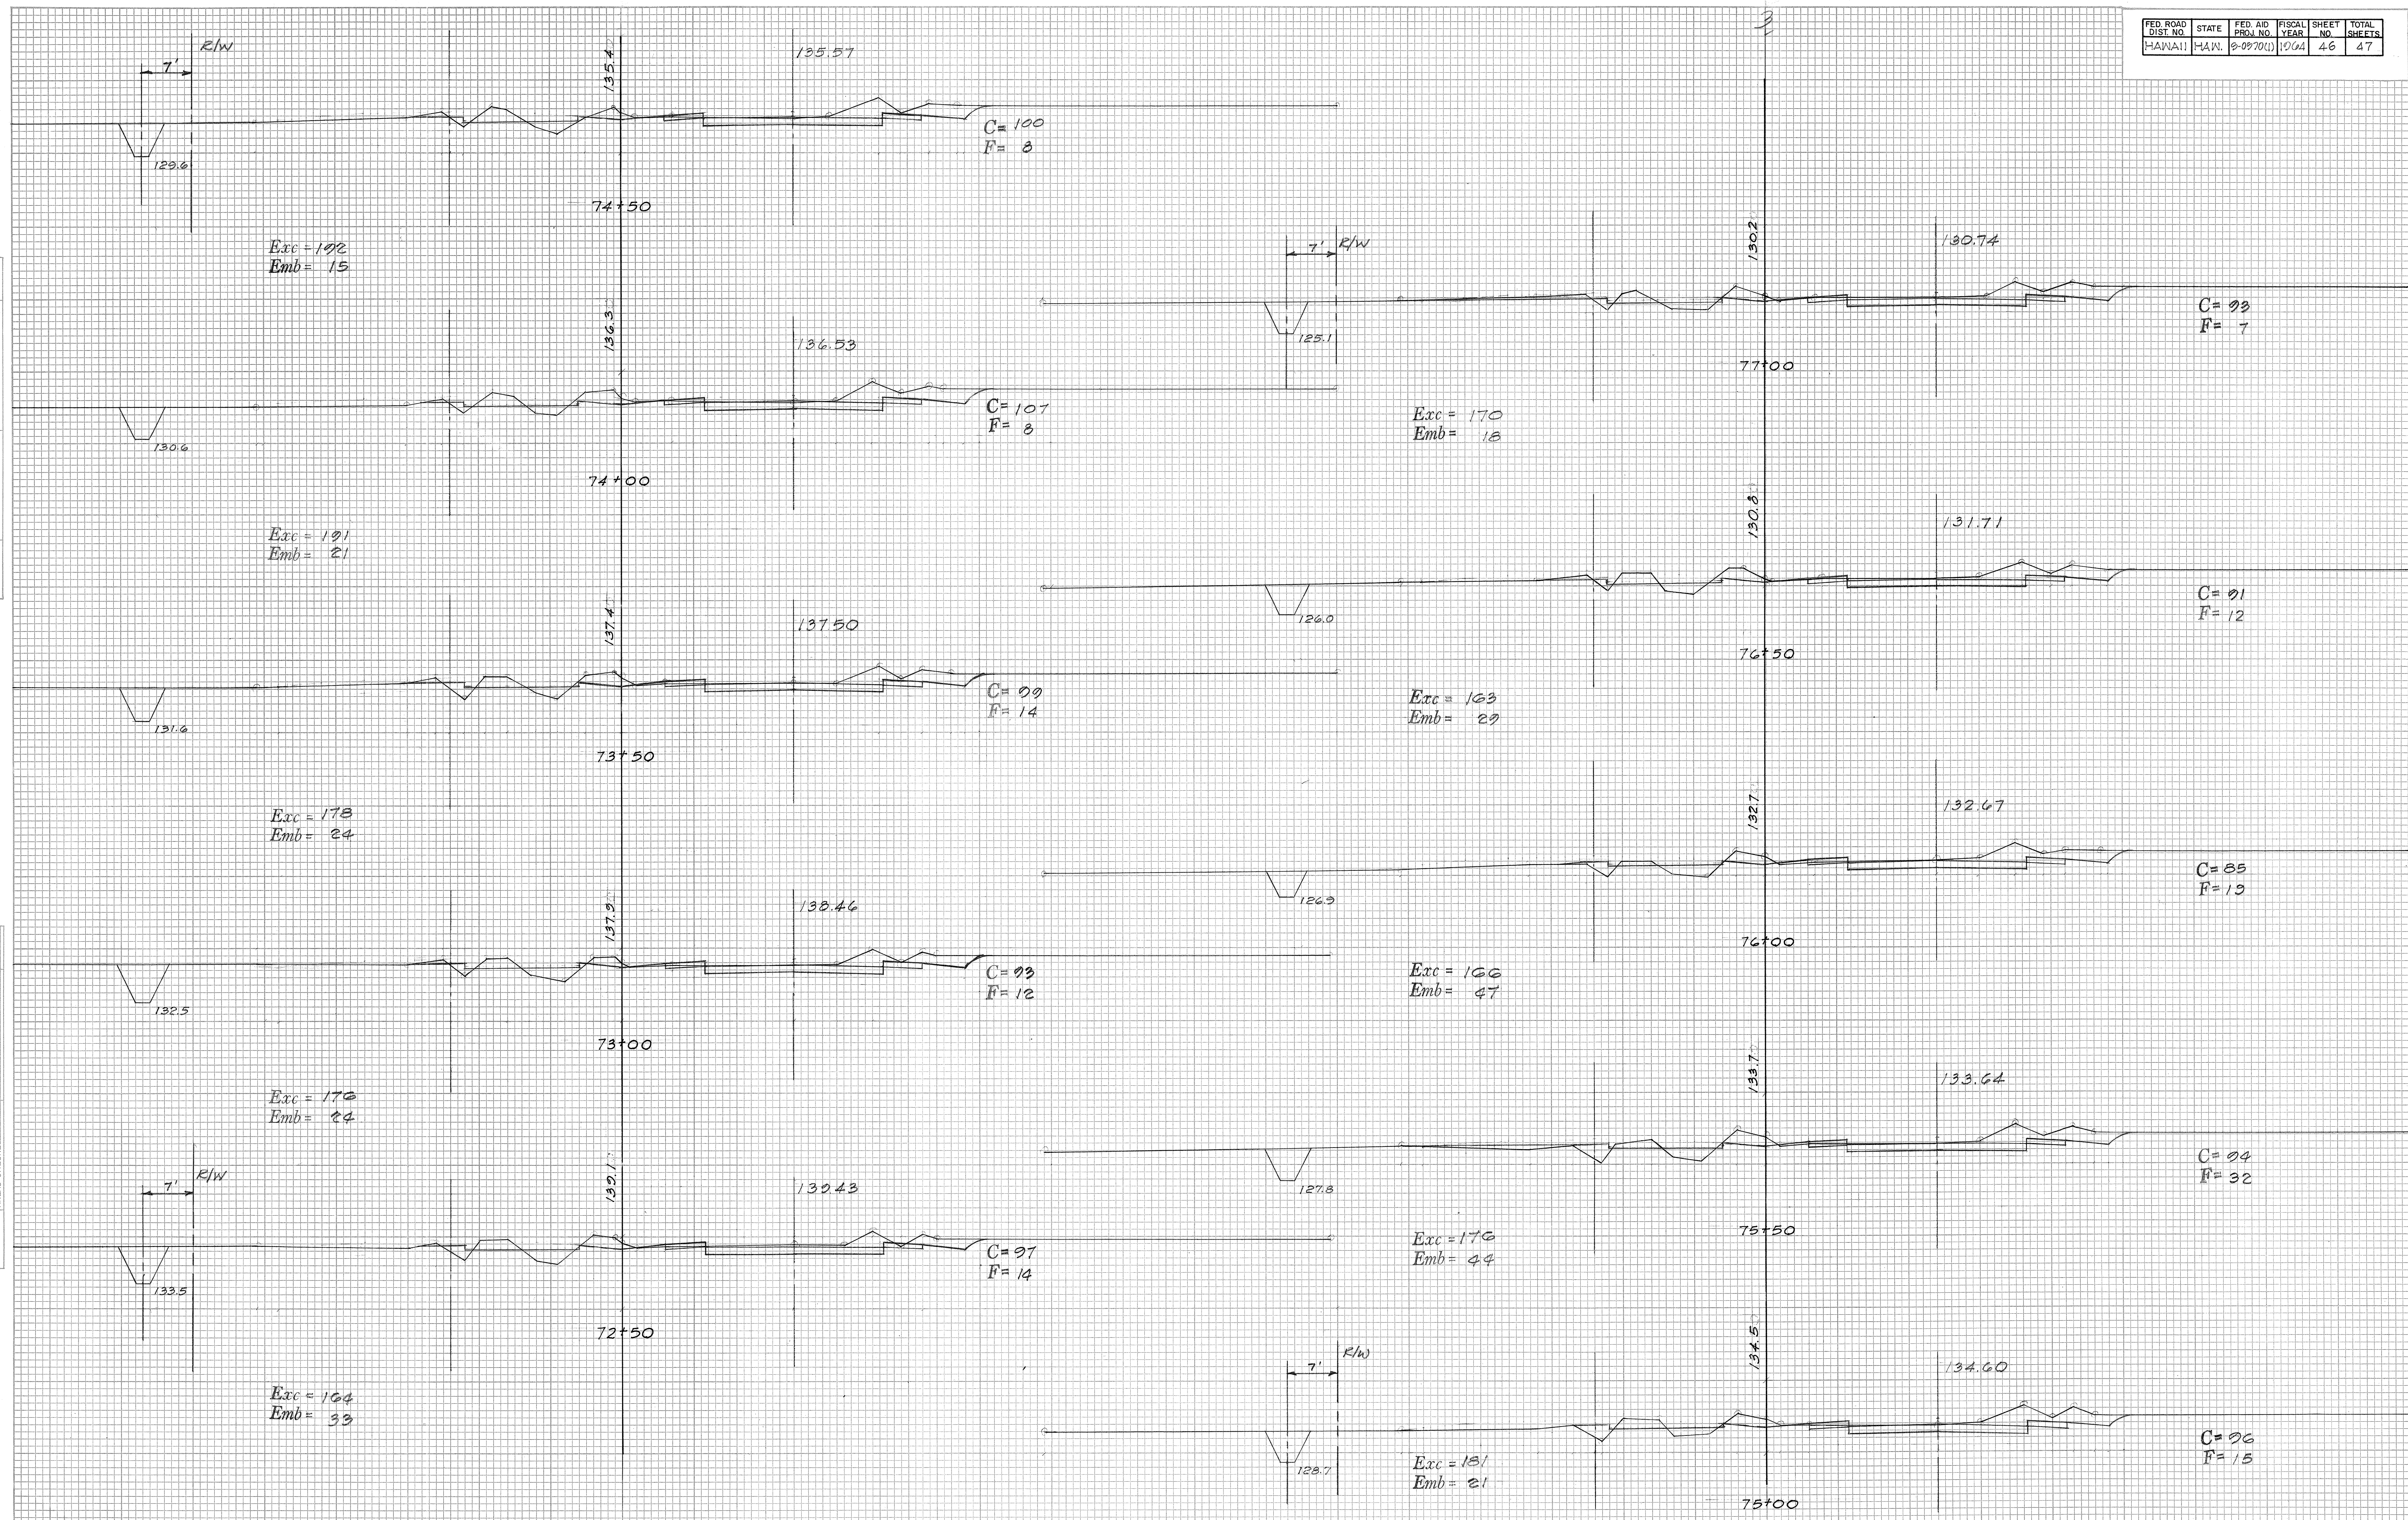

FED. ROAD DIST. NO.	STATE	FED. AID PROJ. NO.	FISCAL YEAR	SHEET NO.	TOTAL SHEETS

FINAL SURVEY NO.	SURVEYED BY	DATE

ORIGINAL SURVEY NO.	SURVEYED BY	DATE

