INDEX TO DRAWINGS	
SHEET NO.	DESCRIPTION
1	TITLE SHEET
2	STANDARD PLANS SUMMARY
3	GENERAL NOTES & LEGEND
4 – 6	WATER POLLUTION AND EROSION CONTROL NOTES
7 – 9	TYPICAL SECTIONS
10 – 12	ROADWAY PLANS
13	PAVEMENT MARKING LEGEND, DETAILS AND NOTES
14 – 16	PAVEMENT MARKING AND TRAFFIC SIGNING PLAN
17	LOOP DETECTOR PLAN
18	LOW SPEED UNDIVIDED HIGHWAY WORK ZONE SIGNING PLAN, NOTES & DETAILS

FED. ROAD DIST. NO.	STATE	PROJ. NO.	FISCAL YEAR	SHEET NO.	TOTAL SHEETS
HAWAII	HAW.	570A-01-15M	2016	1	18

570

STATE OF HAWAII

DEPARTMENT OF TRANSPORTATION

HIGHWAYS DIVISION

HONOLULU, HAWAII

"AS-BUILT"

PLANS FOR

AHUKINI ROAD RESURFACING VICINITY OF KAPULE HIGHWAY

PROJECT NO. 570A-01-15M

DISTRICT OF LIHUE

ISLAND OF KAUAI

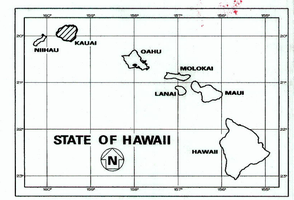

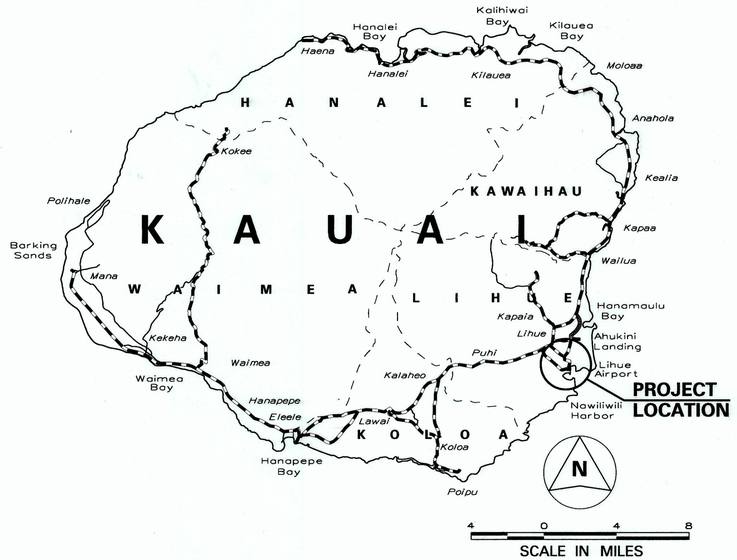

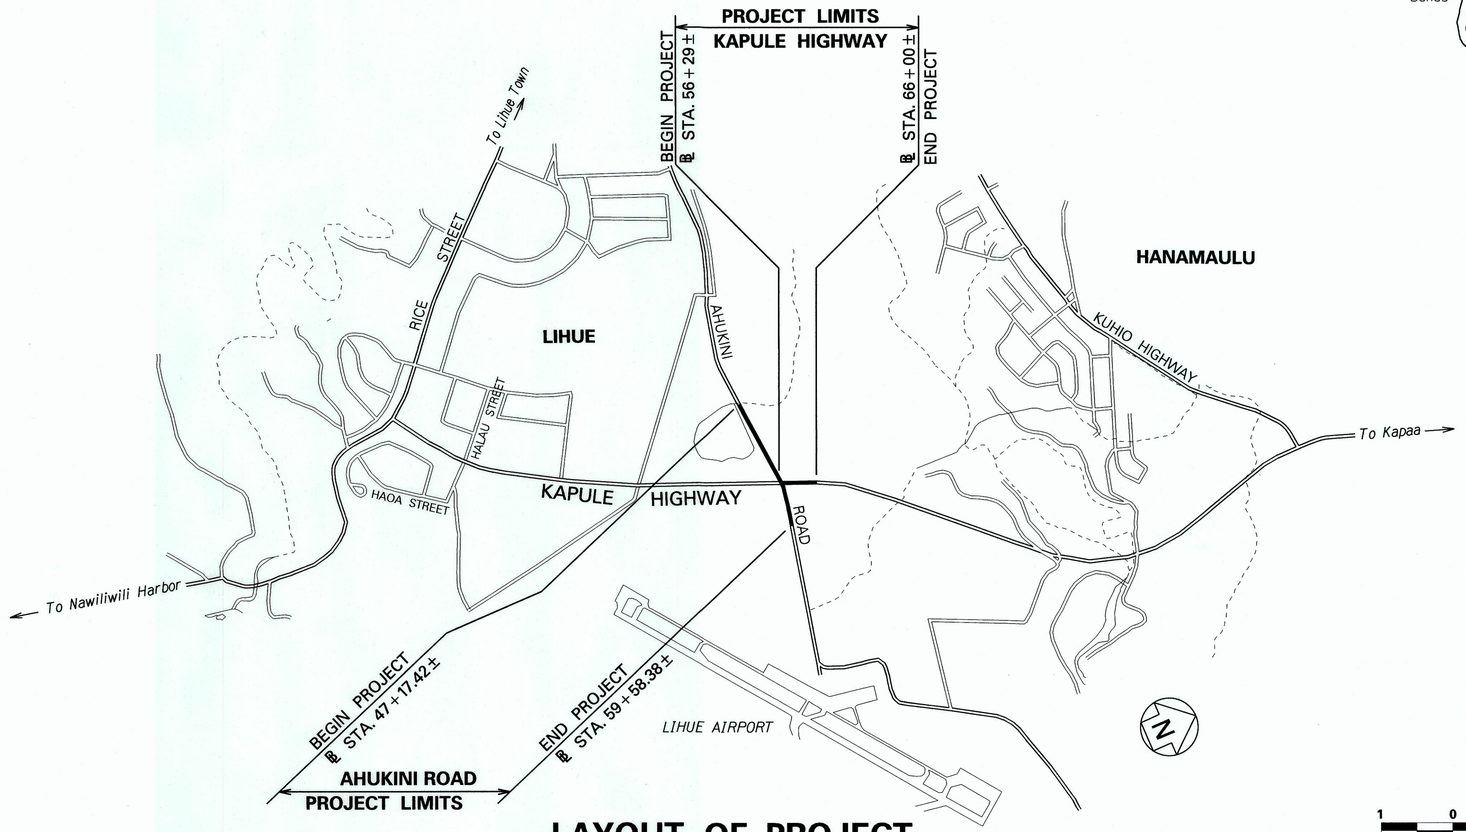

1 0 1 2 3
SCALE IN THOUSAND FEET

FEDERAL AID PROJECTS PREVIOUSLY CONSTRUCTED OR UNDER CONSTRUCTION

ROUTE 570: MILE POST 0.91 TO MILE POST 1.12
ROUTE 51: MILE POST 1.95 TO MILE POST 2.12

LAYOUT OF PROJECT

GROSS LENGTH OF PROJECT..... 0.38 MILES
NET LENGTH OF PROJECT..... 0.38 MILES

HWY-K DESIGNED BY

HWY-KE MANAGED BY

241-3000 PHONE

NOV. 2016 DATE

CHANGES MADE DURING CONSTRUCTION HAVE BEEN INCORPORATED ON THESE PLANS EXCEPT CHANGES IN THE ORIGINAL THEORETICAL QUANTITIES. FOR ACTUAL QUANTITIES, REFER TO PROJECT LEDGER AND/OR COMPUTATION BOOK.

RESIDENT ENGINEER — DATE 02/08/2018

DEPARTMENT OF TRANSPORTATION
STATE OF HAWAII

APPROVED:

DIR. OF TRANSPORTATION — DATE 10/19/17