FED. ROAD DIST. NO.	STATE	FED. AID PROJ. NO.	FISCAL YEAR	SHEET NO.	TOTAL SHEETS
HAWAII	HAW.	F.A.S. 4-A(1)	1938	1	7

INDEX TO DRAWINGS

SHEET NO.	DESCRIPTION
1	TITLE SHEET
2	TYPICAL SECTIONS
3-5	PLAN & PROFILE
6-7	CROSS SECTIONS

TERRITORY OF HAWAII
TERRITORIAL HIGHWAY DEPARTMENT
HONOLULU T. H.

PLANS OF
POLIAHU ROAD
FEDERAL AID SECONDARY PROJECT NO. F.A.S. 4-A (1)
DISTRICT OF LIHUE
ISLAND OF KAUAI

SCALES

PLAN		1 INCH = 100 FEET
PROFILE	HOR.	1 INCH = 100 FEET
	VERT.	1 INCH = 10 FEET

CONVENTIONAL SIGNS

Edge of existing road
Existing Fences
Boundary Line
Railroad
Center Line

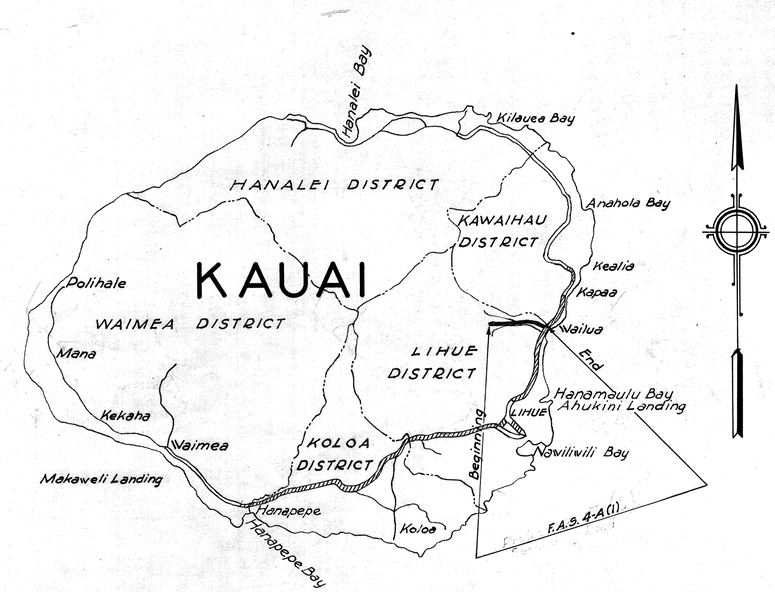

Federal Aid Projects Previously constructed or under construction.

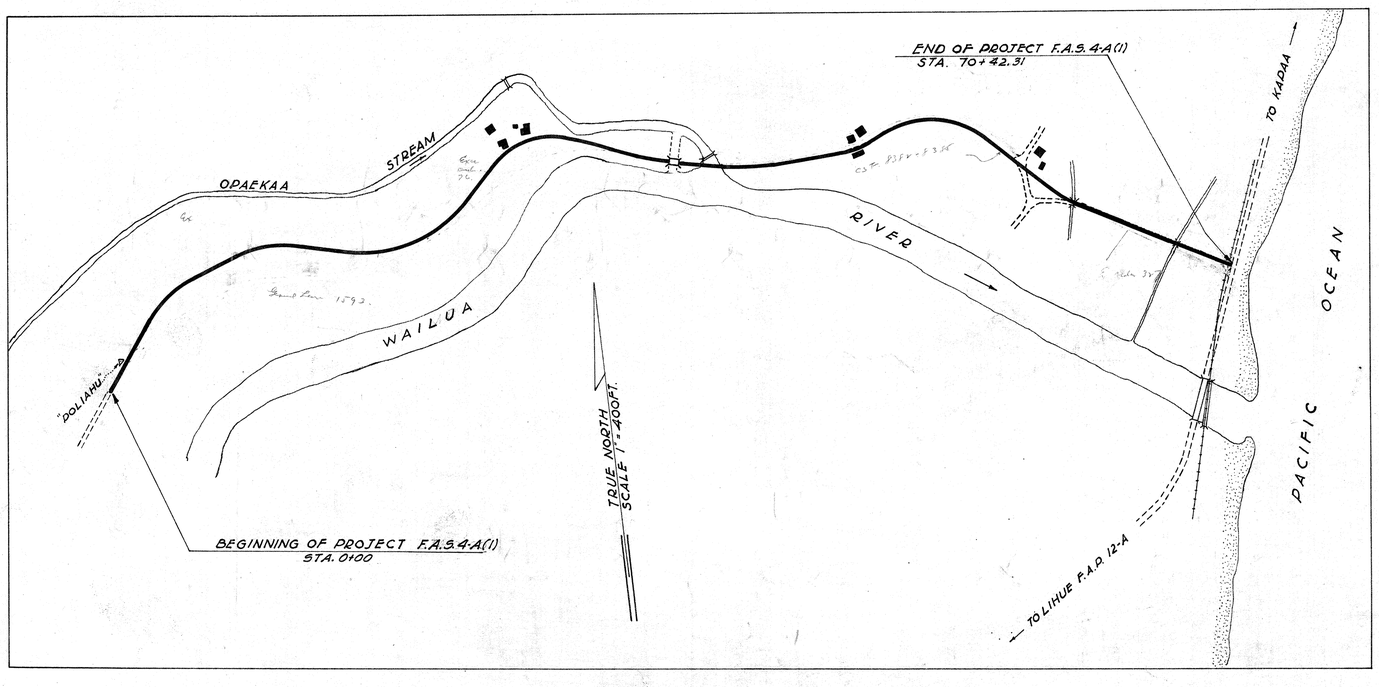

LAYOUT OF PROJECT

GROSS LENGTH = 1.335 MILES
BRIDGE = 0.010 "
NET LENGTH ROADWAY = 1.325 "

ORIGINAL PLAN		DATE
	SURVEY PLOTTED BY	
	TRACED BY	"
	DESIGN BY	"
	NOTE BOOK TRACED BY	"
No.	CHECKED BY	"
	CHECKED BY	"

RECOMMENDED FOR APPROVAL
[redacted]
PRINCIPAL HWY. ENGR. BUREAU OF PUB. RDS.

RECOMMENDED FOR APPROVAL
[redacted]
CHIEF ENGR. BUREAU OF PUBLIC ROADS

APPROVED
Louis E. Cain
TERRITORIAL HIGHWAY ENGR.

APPROVED
[redacted]
CHIEF BUREAU OF PUBLIC ROADS

4474.1