STATE	PROJ. NO.	FISCAL YEAR	SHEET NO.	TOTAL SHEETS
HAW.	A-580-01-64	1965	1	10

INDEX TO DRAWINGS

SHT. NO.	DESCRIPTION
1	TITLE SHEET
2	TYPICAL SECTIONS AND CHAIN LINK FENCE DETAILS
3-4	PLANS
5-6	ROADWAY STANDARD DETAILS
7-10	CROSS SECTIONS

STATE OF HAWAII
DEPARTMENT OF TRANSPORTATION
HIGHWAYS DIVISION
AS-BUILT
PLANS FOR

REALIGNING, WIDENING, AND RESURFACING OF KUAMOO ROAD PHASE I

PROJECT NO. A-580-01-64

DISTRICT OF KAWAIHAU
ISLAND OF KAUAI

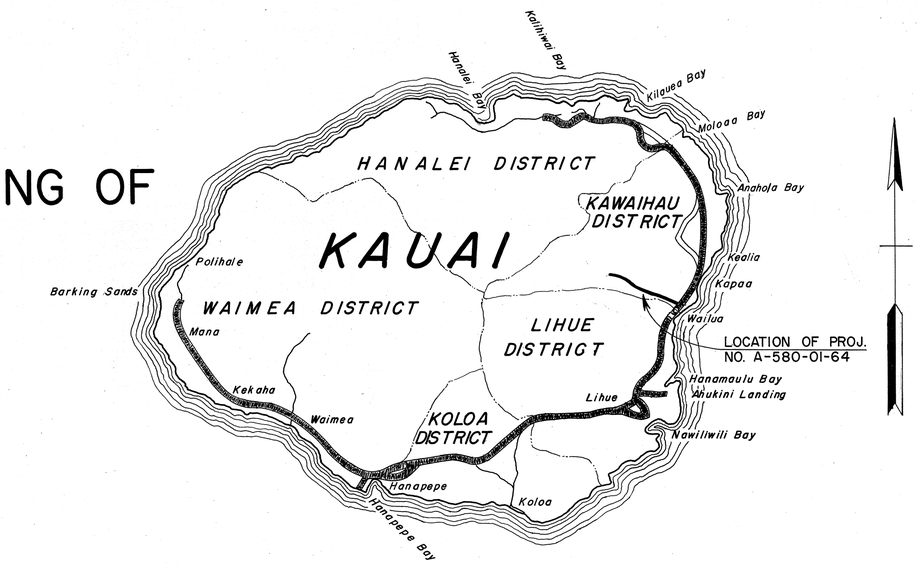

FEDERAL AID PROJECTS PREVIOUSLY CONSTRUCTED OR UNDER CONSTRUCTION

CONVENTIONAL SIGNS

Baseline
Boundary Line
Fences (Named)
Existing Roadway
Pipe Culvert
Box Culvert
Telephone Line & Pole
Electric Line & Pole
Water Main

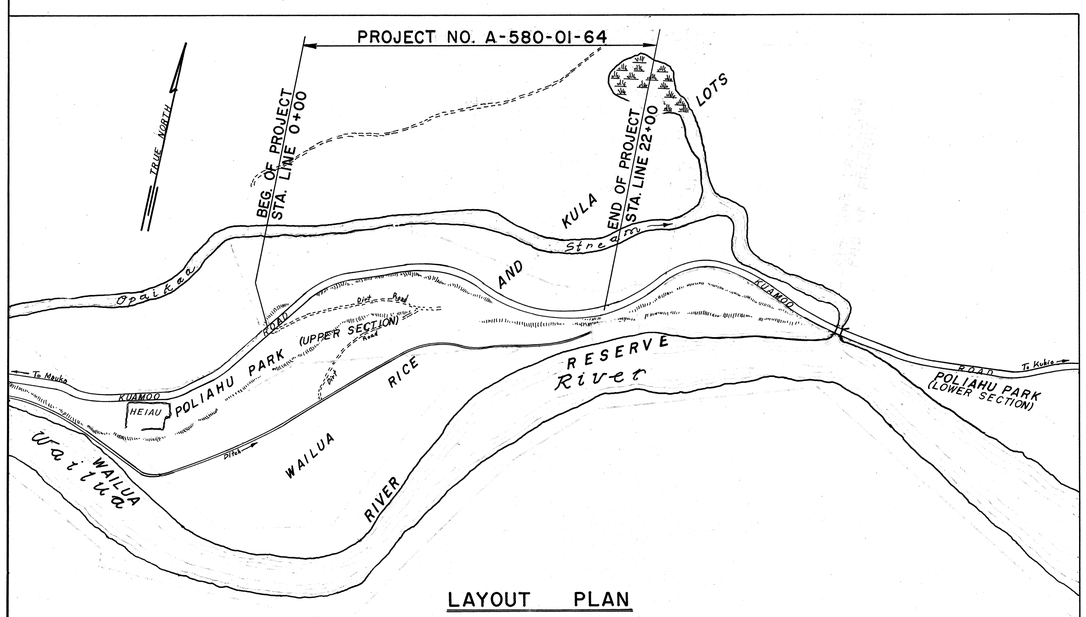

LAYOUT PLAN

LENGTH OF PROJECT..... 0.417 mi.

NOTE: ALL CHANGES MADE DURING CONSTRUCTION ARE SHOWN IN RED ON THESE TRACINGS AND CHECKED BY:

Masami Murakami — 6/16/67
PROJECT ENGINEER — DATE

APPROVED: DATE 7 April 65
Luis Ulatendon
DIRECTOR OF TRANSPORTATION