FED. ROAD DIST. NO.	STATE	PROJ. NO.	FISCAL YEAR	SHEET NO.	TOTAL SHEETS
HAWAII	HAW.	580A-01-88M	1988	1	6

580

INDEX TO DRAWINGS

SHEET NO.	DESCRIPTION
1	TITLE SHEET
2	STANDARD PLAN SUMMARY
3	GENERAL NOTES AND TYPICAL SECTIONS
4 & 5	PLAN
6	STRIPING AND PAVEMENT MARKERS DETAILS, PAVEMENT MARKING SUMMARY & PAVED SHOULDER DETAILS

STATE OF HAWAII

DEPARTMENT OF TRANSPORTATION
HIGHWAYS DIVISION

"AS-BUILT"

PLAN FOR KUAMOO ROAD RESURFACING, KAMALU ROAD TO U. OF H. AGRICULTURE EXPERIMENT STATION

PROJECT NO. 580A-01-88M

DISTRICT OF KAWAIHAU

ISLAND OF KAUAI

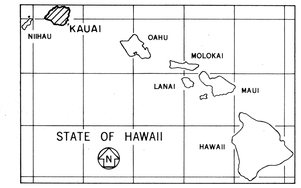

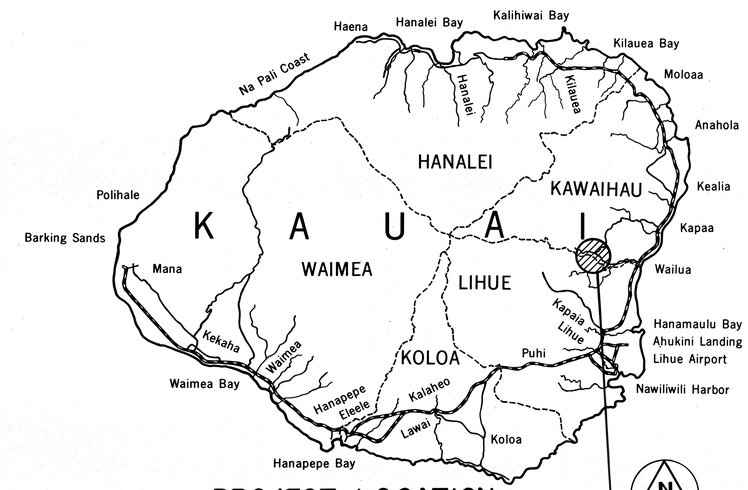

PROJECT LOCATION

N

4 0 4 8
SCALE IN MILES

FEDERAL AID PROJECTS PREVIOUSLY CONSTRUCTED OR UNDER CONSTRUCTION

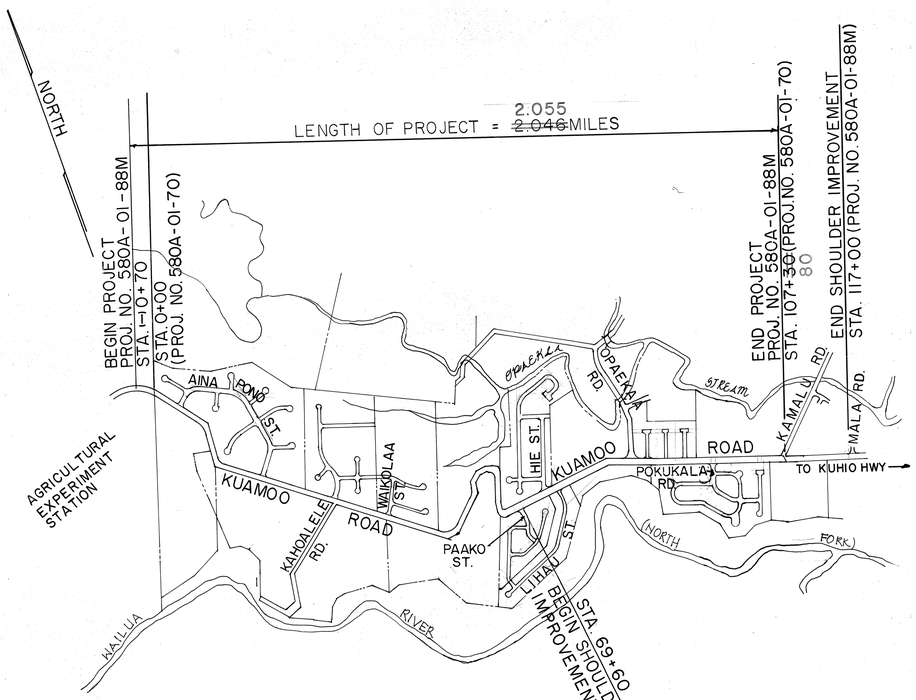

LAYOUT OF PROJECT
NOT TO SCALE

KAUAI DISTRICT — DESIGNED BY
A. YAMAGUCHI — P. S. & E. BY
548-7534 — PHONE
APRIL, 1988 — DATE

CHANGES MADE DURING CONSTRUCTION HAVE BEEN INCORPORATED ON THESE PLANS EXCEPT CHANGES IN THE ORIGINAL THEORETICAL QUANTITIES. FOR ACTUAL QUANTITIES, REFER TO PROJECT LEDGER AND/OR COMPUTATION BOOK.

Darryl H. Maeda — RESIDENT ENGINEER
10/25/88 — DATE

DEPARTMENT OF TRANSPORTATION
STATE OF HAWAII

APPROVED:
Edward Sakai — DIR. OF TRANSPORTATION
5/4/88 — DATE

DD-D-10-6