FED. ROAD DIST. NO.	STATE	PROJ. NO.	FISCAL YEAR	SHEET NO.	TOTAL SHEETS
HAWAII	HAW.	580A-01-07M	2007	1	17

580

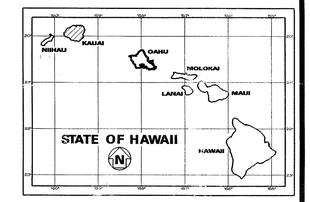

INDEX TO DRAWINGS	
SHEET NO.	DESCRIPTION
1	TITLE SHEET
2	STANDARD PLANS SUMMARY
3	GENERAL NOTES & LEGEND
4 – 5	WATER POLLUTION AND EROSION CONTROL NOTES
6	TYPICAL SECTIONS
7 – 11	ROADWAY PLANS
12 – 17	PAVEMENT STRIPING, MARKING, LEGEND, DETAILS AND NOTES

TOTAL SHEET COUNT AFTER "AS BUILT" POSTINGS.
18 SHEETS.

STATE OF HAWAII

DEPARTMENT OF TRANSPORTATION

HIGHWAYS DIVISION
HONOLULU, HAWAII

"AS-BUILT" PLANS FOR

KUAMOO ROAD RESURFACING
KUHIO HIGHWAY TO LILIA PLACE

PROJECT NO. 580A-01-07M

DISTRICT OF KAWAIHAU
ISLAND OF KAUAI

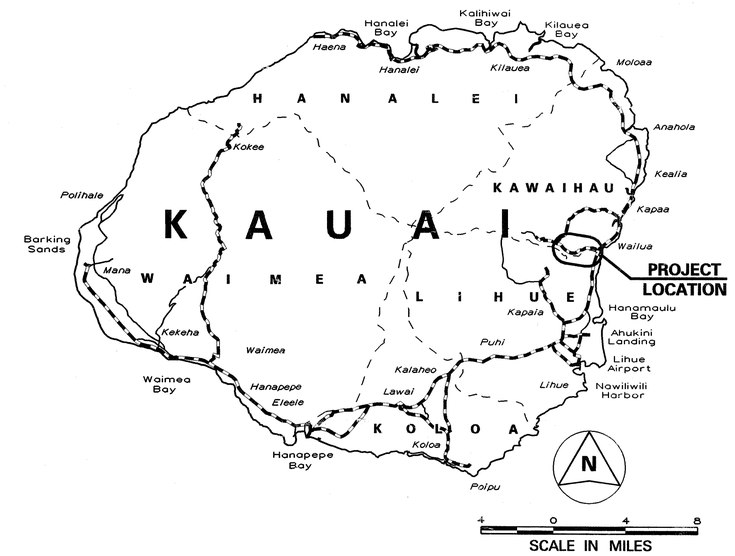

MILE POST 0.06 TO MILE POST 2.10

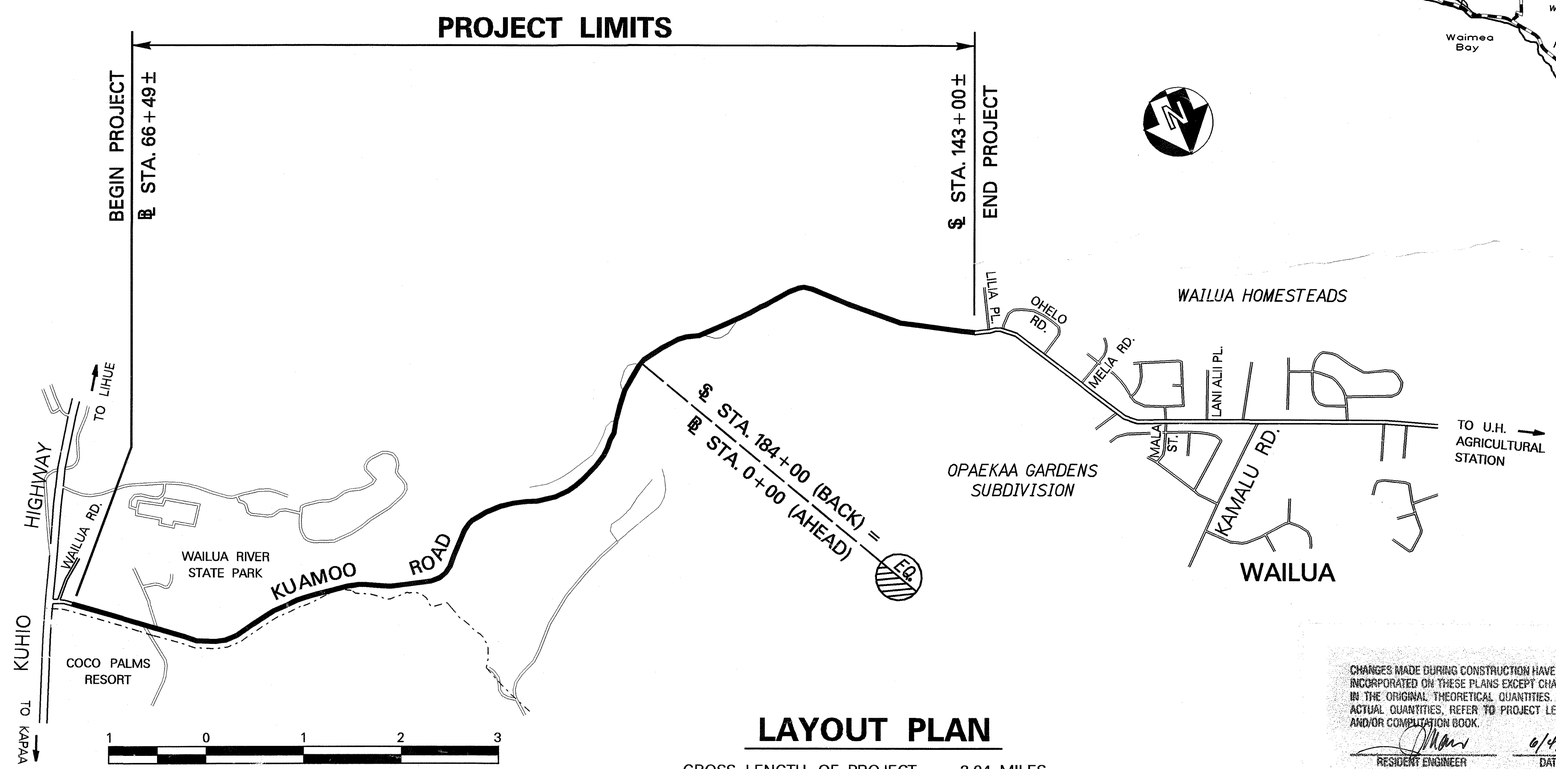

LAYOUT PLAN

GROSS LENGTH OF PROJECT. . . . . 2.04 MILES
NET LENGTH OF PROJECT . . . . . 2.04 MILES

CHANGES MADE DURING CONSTRUCTION HAVE BEEN INCORPORATED ON THESE PLANS EXCEPT CHANGES IN THE ORIGINAL THEORETICAL QUANTITIES. FOR ACTUAL QUANTITIES, REFER TO PROJECT LEDGER AND/OR COMPUTATION BOOK.

RESIDENT ENGINEER — DATE 6/4/09

DEPARTMENT OF TRANSPORTATION
STATE OF HAWAII
APPROVED:
DIR. OF TRANSPORTATION — DATE 5/11/07

HWY-DD DESIGNED BY	HWY-DD MANAGED BY	692-7570 PHONE	APRIL 2007 DATE