FED. ROAD DIST. NO.	STATE	PROJ. NO.	FISCAL YEAR	SHEET NO.	TOTAL SHEETS
HAWAII	HAW.	HWY-M-ART18-01	2022	10	80

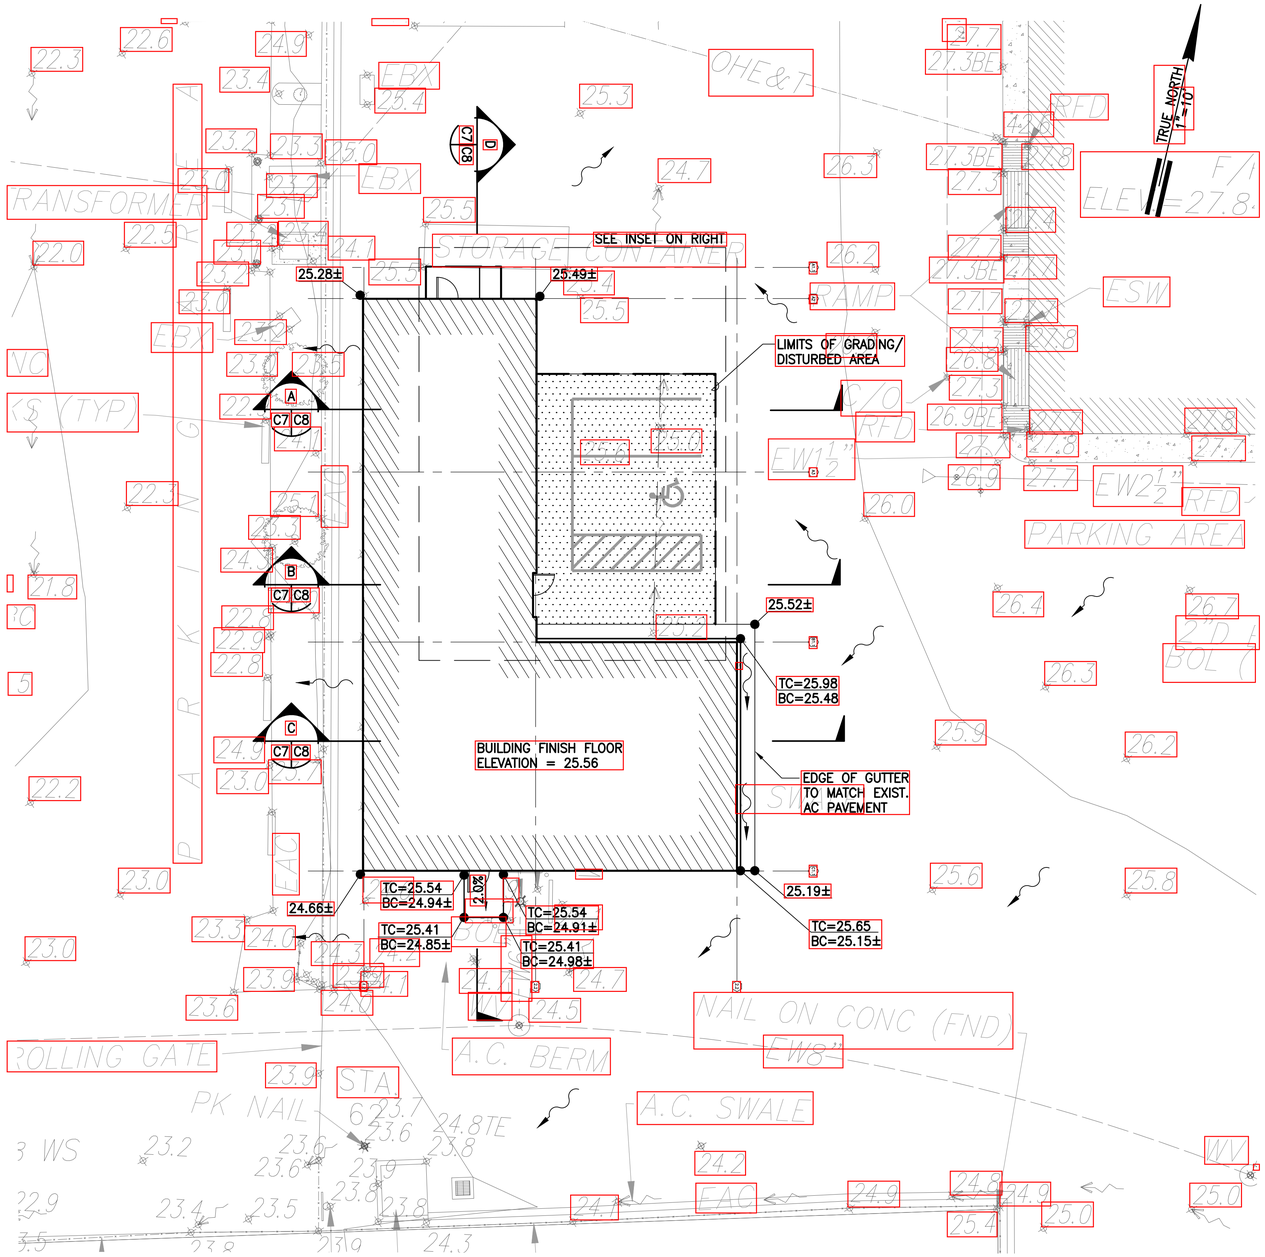

GRADING PLAN

SCALE: 1" = 10'

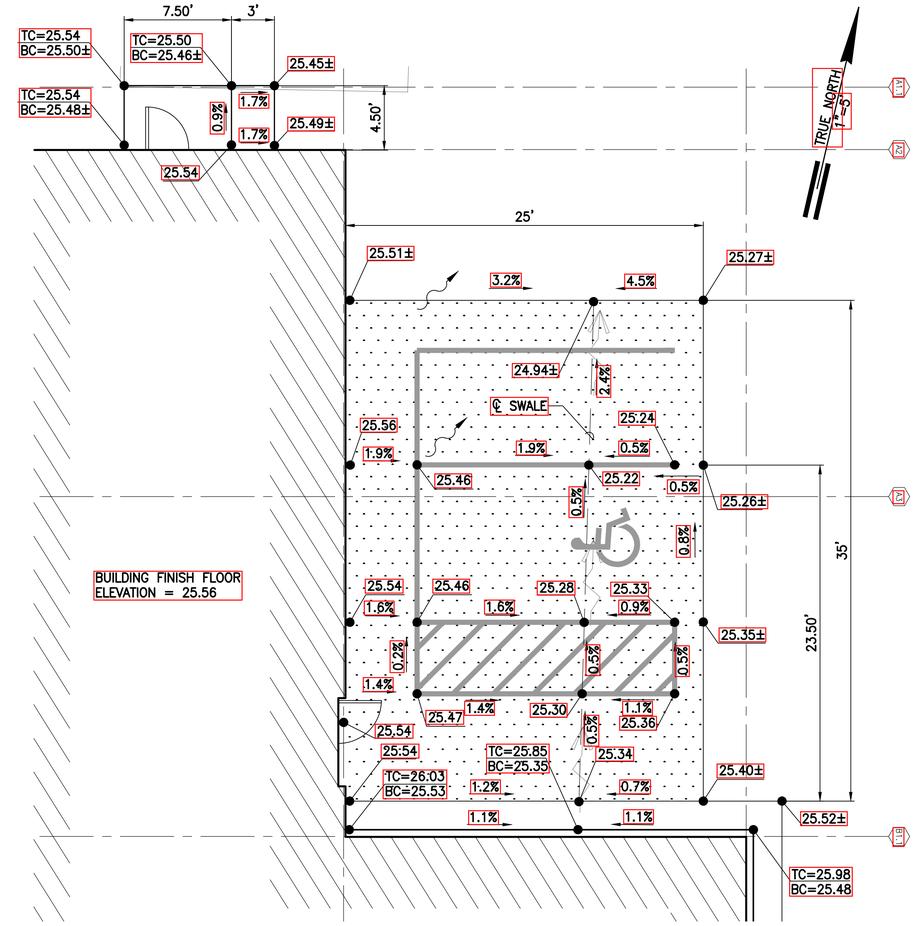

INSET

SCALE: 1" = 5'

GRAPHIC SCALES:

1" = 10' 10' 5' 0 10' 20'

1" = 5' 5' 2.5' 0 5' 10'

BRENT W.B. NAKAOKA LICENSED PROFESSIONAL ENGINEER No. 11106-C HAWAII, U.S.A.

LICENSE EXPIRATION DATE: 04/30/2024

STATE OF HAWAII
DEPARTMENT OF TRANSPORTATION
HIGHWAYS DIVISION

GRADING PLAN

MAUI DISTRICT BASEYARD
Project No. HWY-M-ART18.01

Scale: AS SHOWN Date: MAY 2022

SHEET No. C7 OF 80 SHEETS

ORIGINAL PLAN — DATE
SURVEY PLOTTED BY
DRAWN BY
TRACED BY
DESIGNED BY
QUANTITIES BY
CHECKED BY
NOTE BOOK
No.