
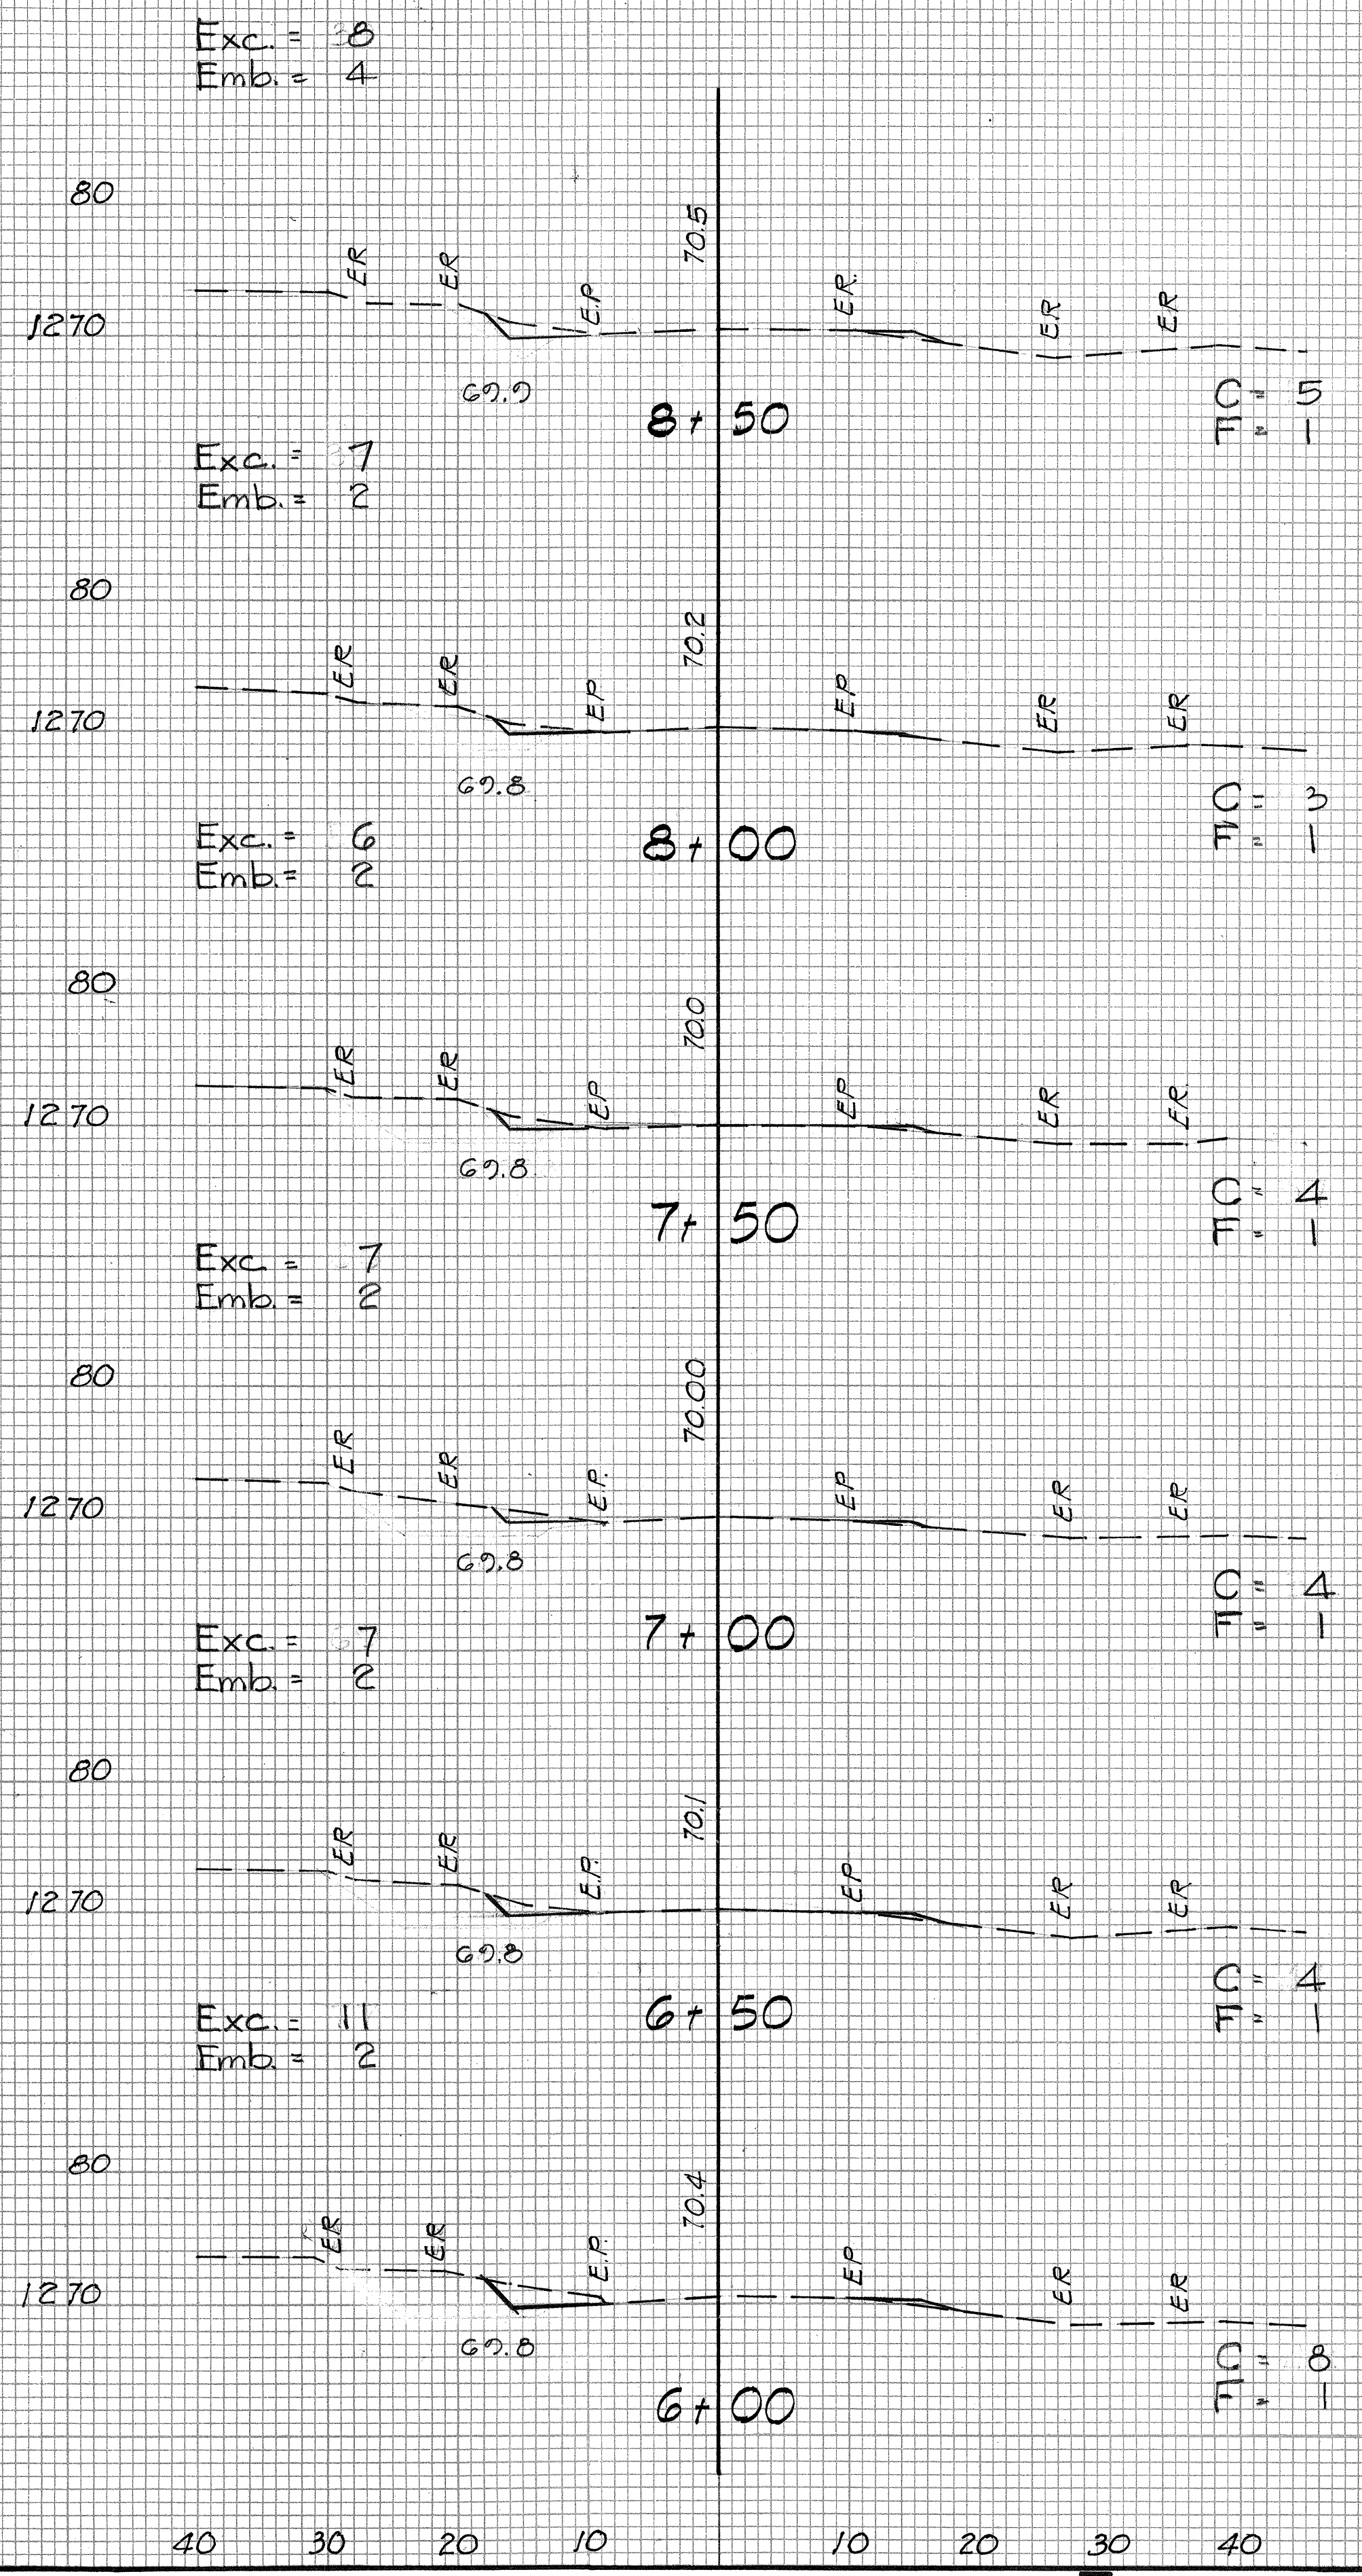
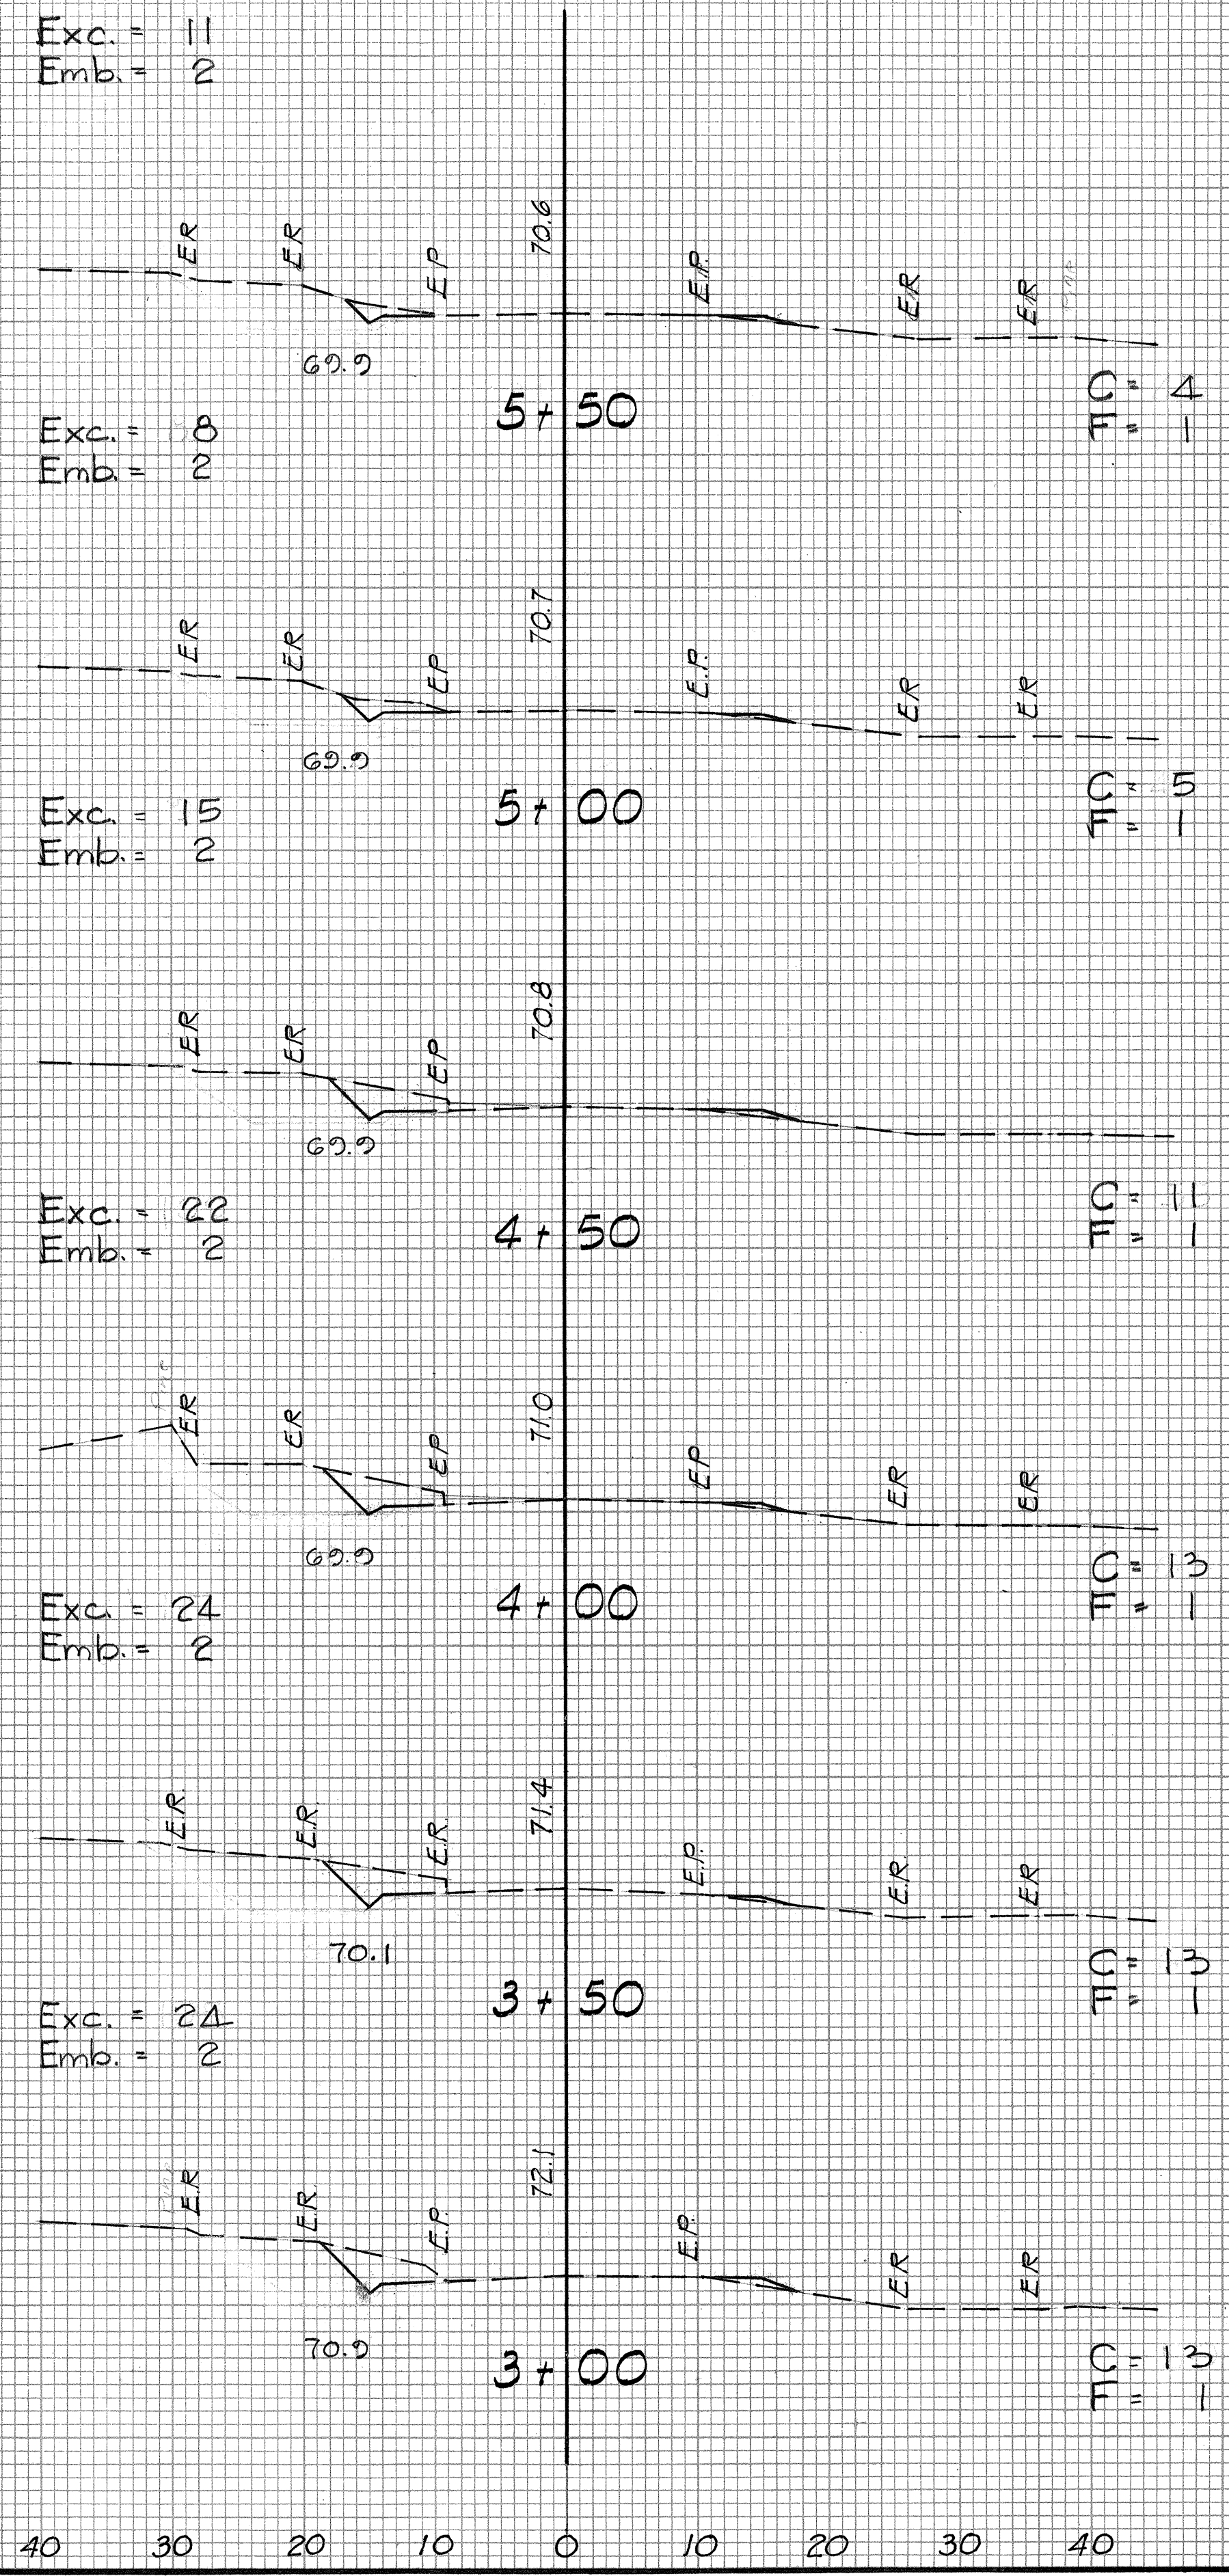


FED. ROAD DIST. NO.	STATE	PROJ. NO.	FISCAL YEAR	SHEET NO.	TOTAL SHEETS
HAWAII	HAW.	440A-02-72	1974	3	10

FINAL SURVEY	DATE	BY
NOTE BOOK		
NO.		

ORIGINAL SURVEY	DATE	BY
NOTE BOOK		
NO.		

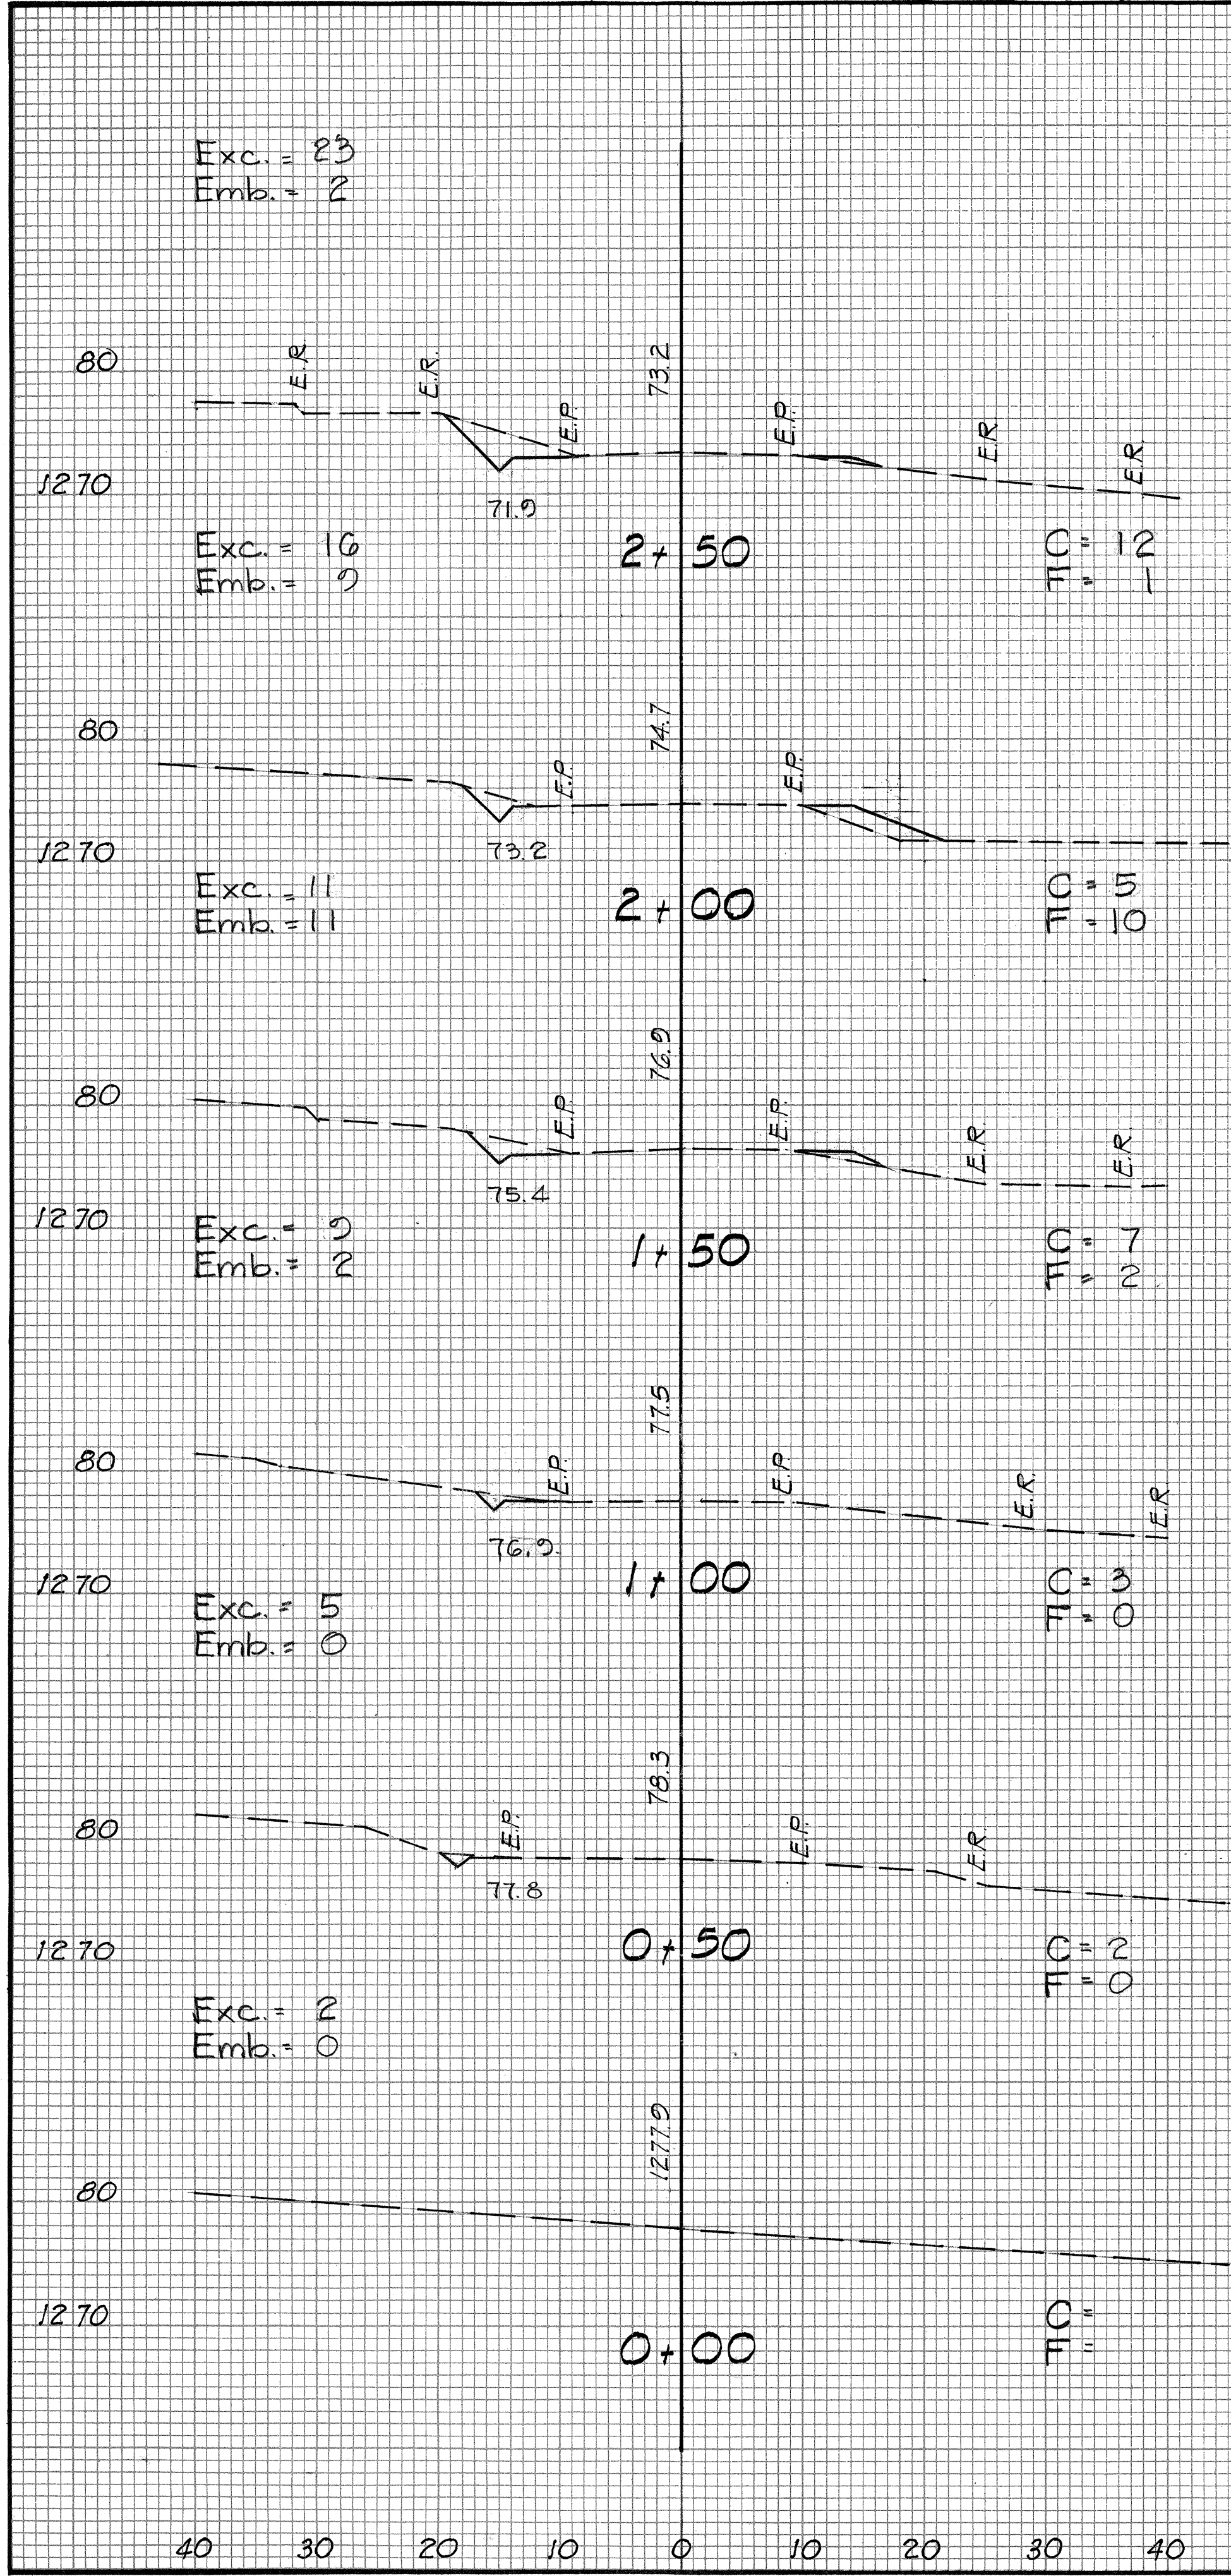


ORIGINAL			
SURVEY	SURVEYED	BY	DATE
	PLOTTED		
NOTE BOOK	TEMPLATE		
	AREAS		
NO.	AREAS CHECKED		

[illegible]

FED. ROAD DIST. NO.	STATE	PROJ. NO.	FISCAL YEAR	SHEET NO.	TOTAL SHEETS
HAWAII	HAW.	440A-02-72	1974	5	10

FINAL SURVEY	DATE	
	BY	
	SURVEYED	
	NOTED	

ORIGINAL SURVEY	DATE	
	BY	
	SURVEYED	
	NOTED	

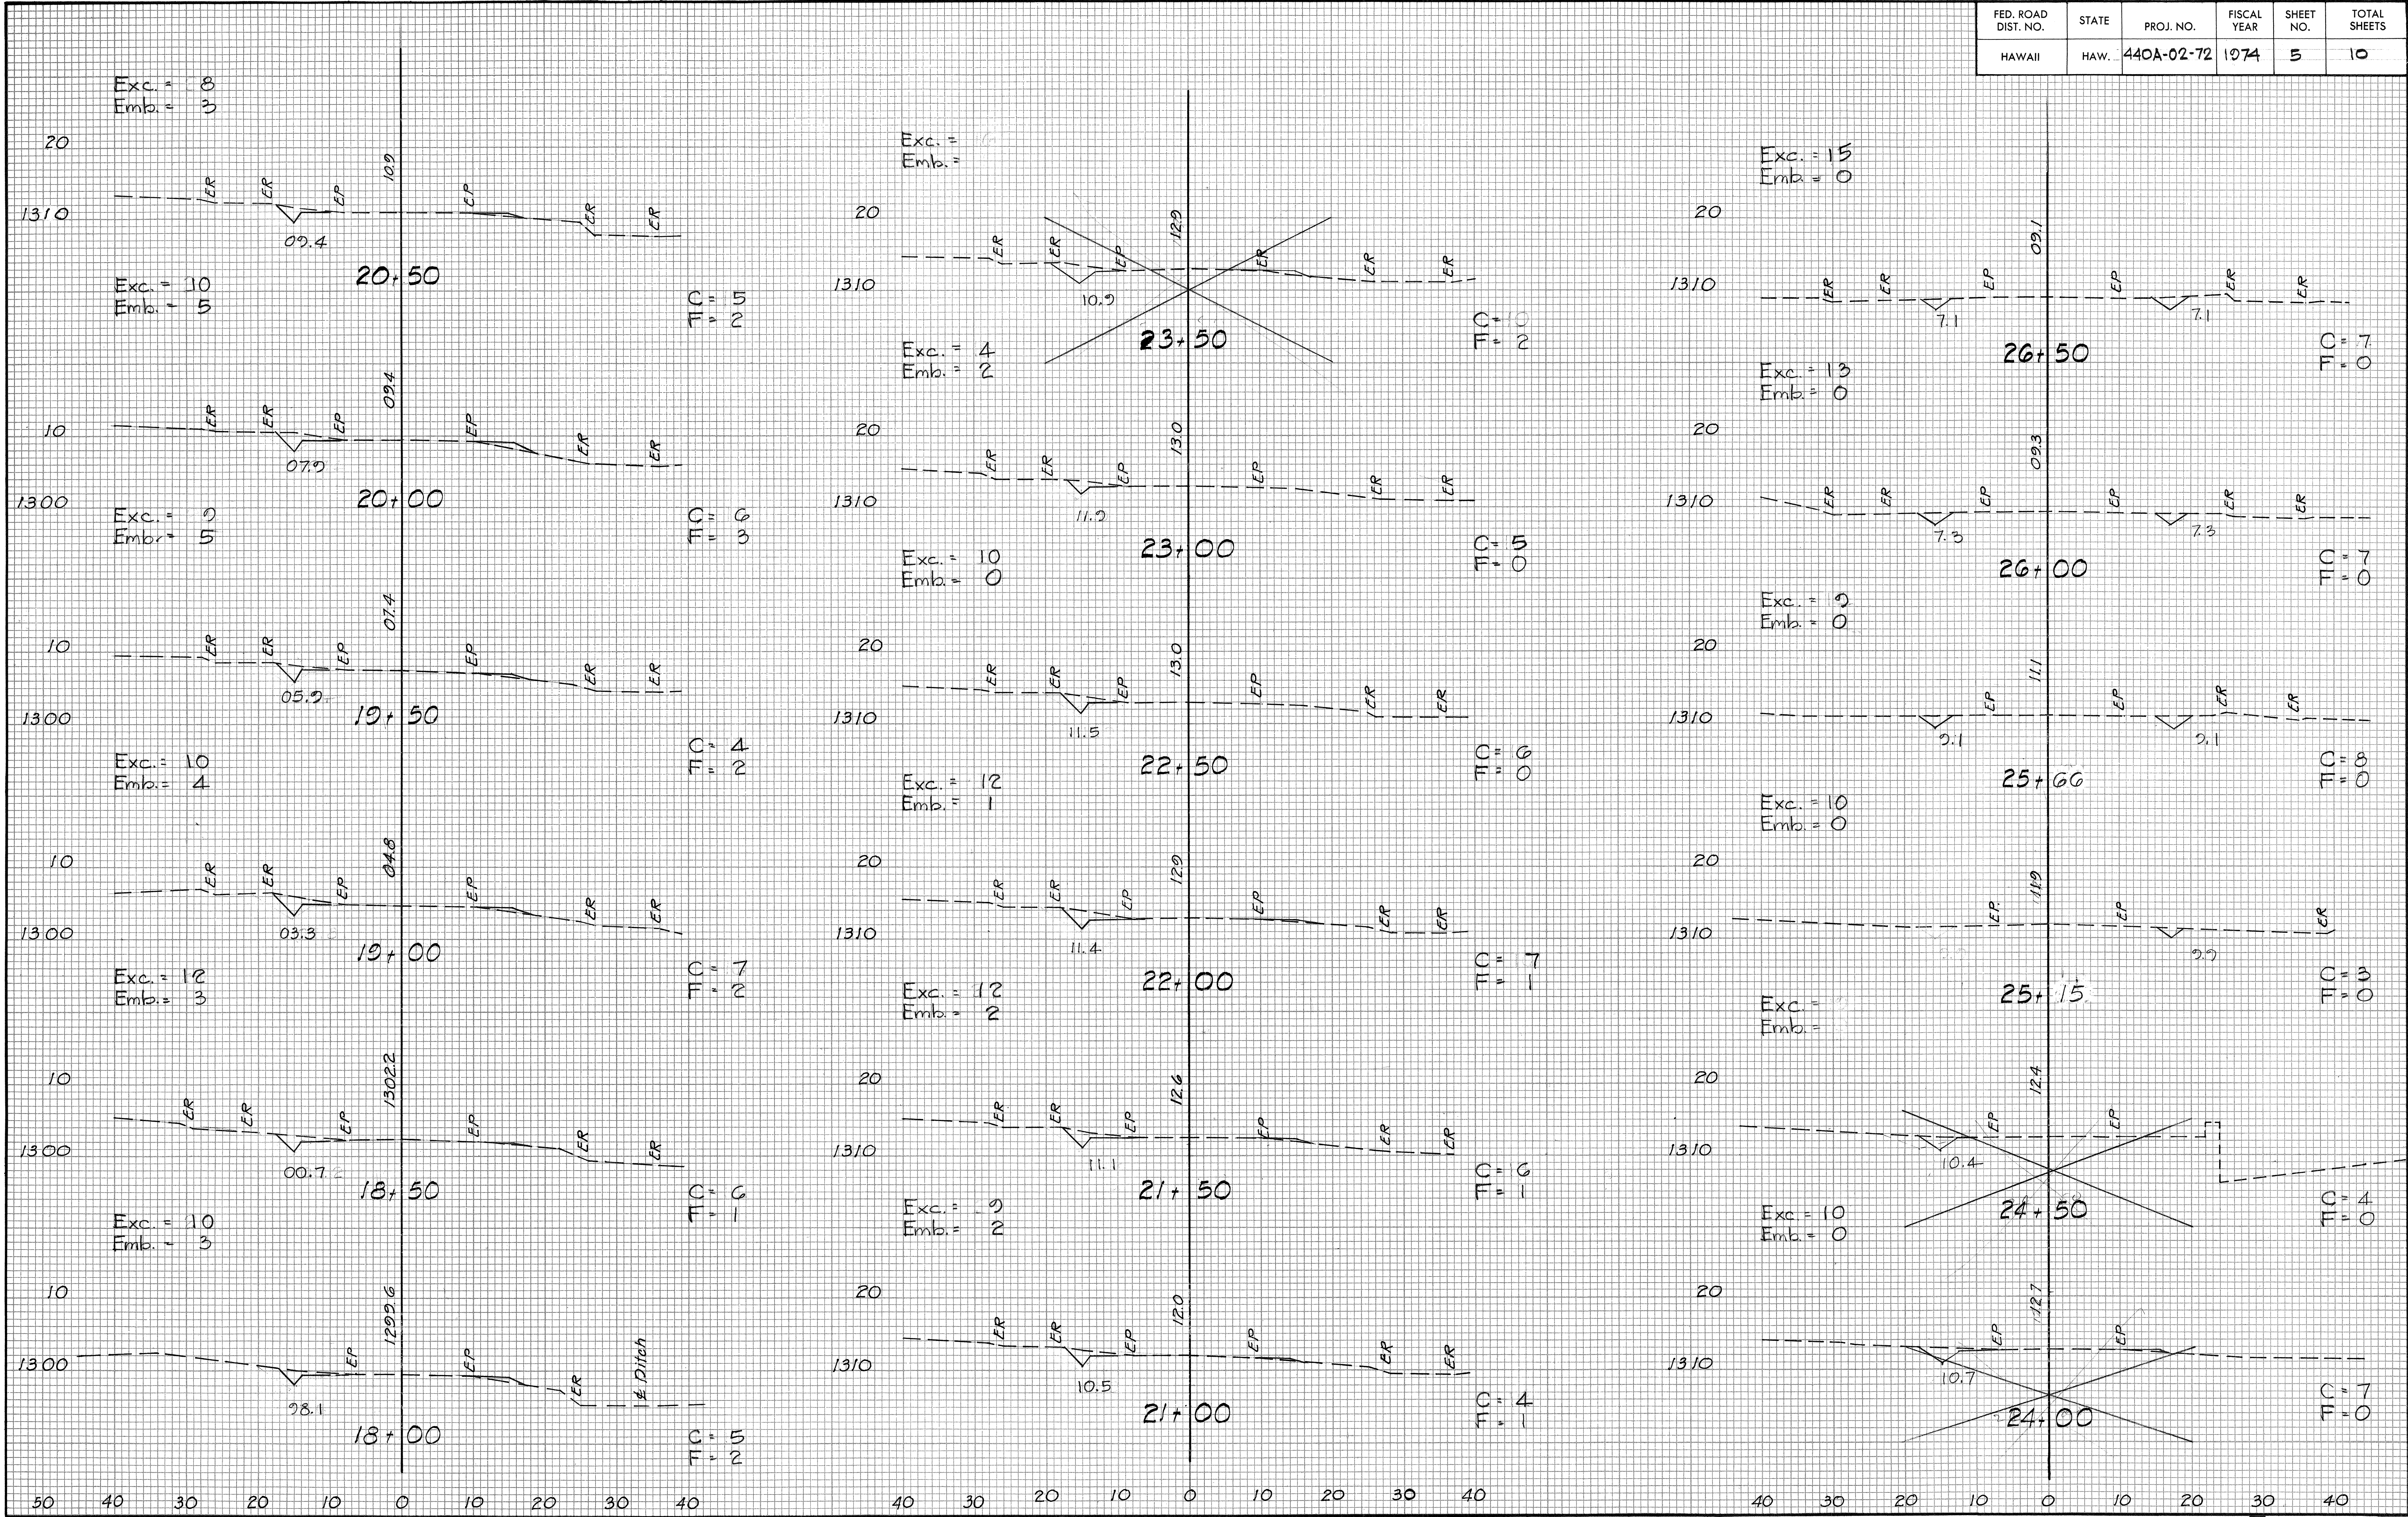

FED. ROAD DIST. NO.	STATE	PROJ. NO.	FISCAL YEAR	SHEET NO.	TOTAL SHEETS
HAWAII	HAW.	440A-02-72	1974	6	10

FINAL				
SURVEY	SURVED		BY	DATE
	PLOTTED			
NOTE BOOK	TEMPLATE			
	AREAS			
NO.	AREAS CHECKED			

ORIGINAL	SURVEYED _____	BY _____	DATE _____
SURVEY	PLOTTED _____		
NOTE BOOK	TEMPLATE _____		
NO.	AREAS _____		
	AREAS CHECKED _____		

